


| Parcel | Kind of Instrument | Date of Instrument | Grantor | Grantee | Recorded | Remarks |
|---------|--------------------|--------------------|--------------------------------|----------------|-----------|---------|
| A-B-C-D | W.D. | 12-19-32 | Francis Gardner | St. J. H. | 75 406 89 | 4-11-33 |
| A' | O.C.D. | 12-2-33 | Ruth Clayton | Bertell Lohnes | 85 62 | 12-1-33 |
| A'' | O.C.D. | 12-28-32 | American Agricultural Line Co. | " | 85 490 82 | 1-11-33 |
| B-C-D | O.C.D. | 11-11-33 | " | " | 86 67 | 12-1-33 |

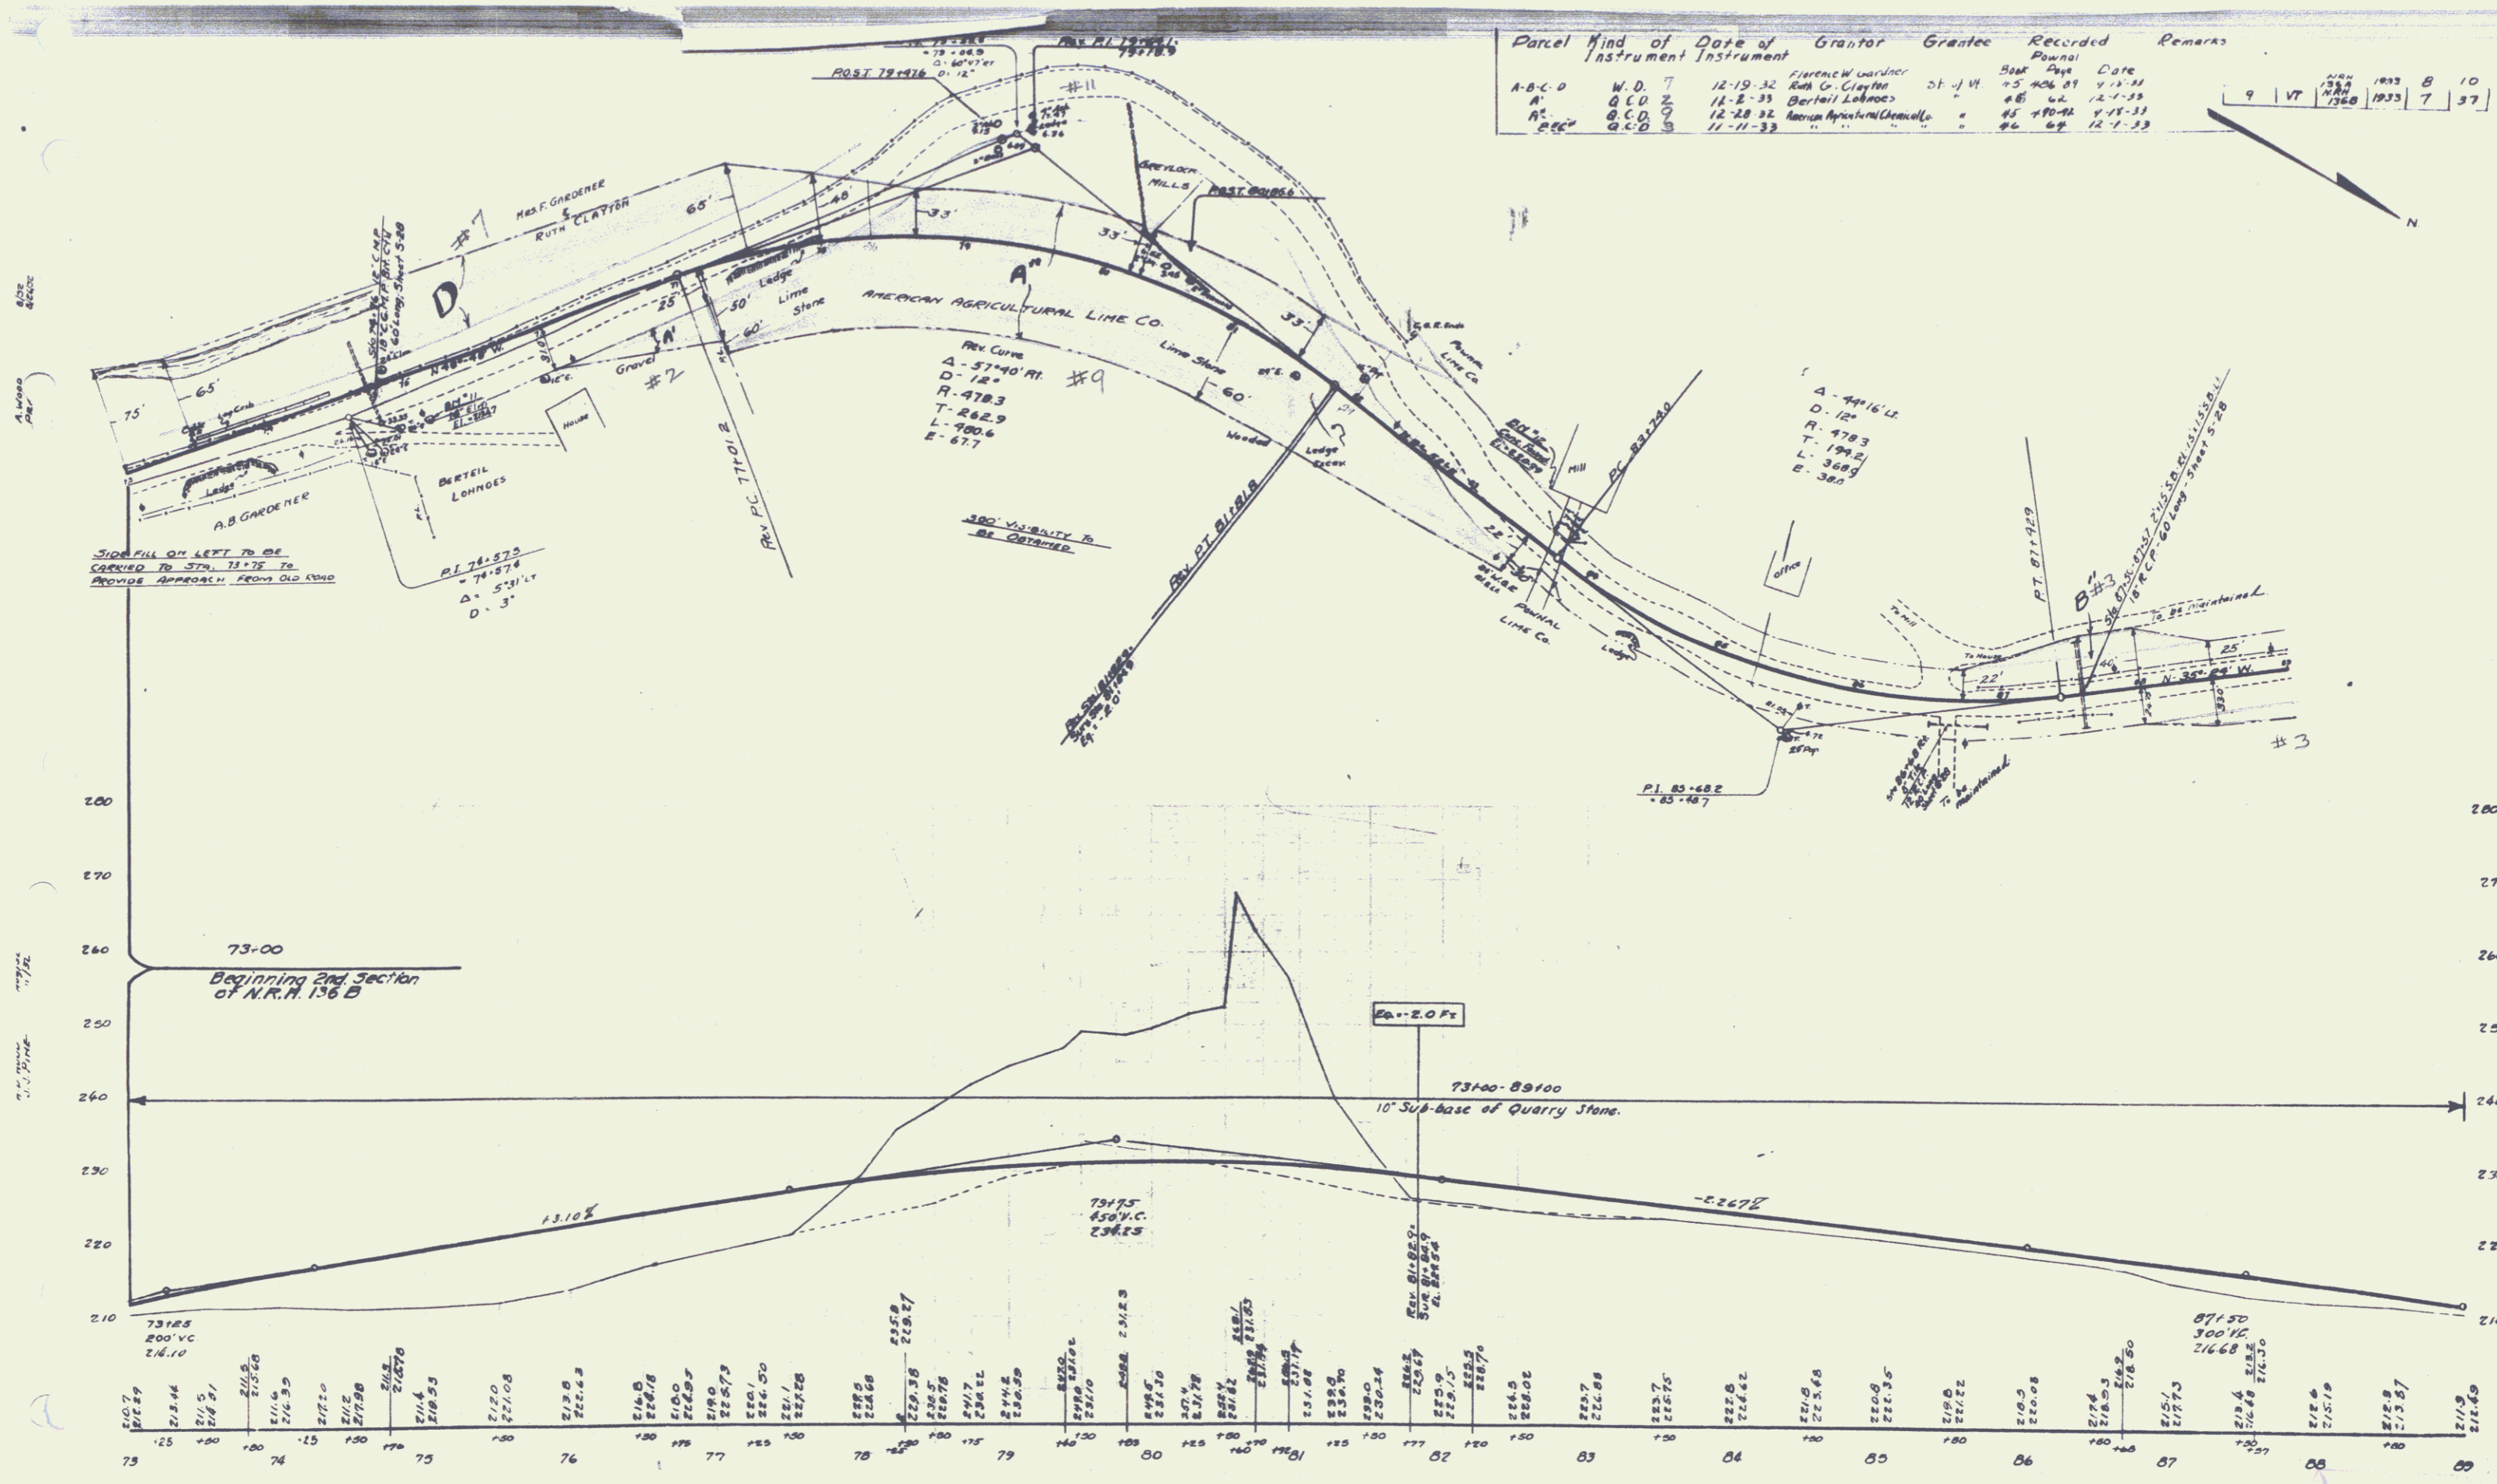

B.M. # 11 Spike in Root 16' Elm 21' E of Sta. 75+00 Elev. 213.47
 B.M. # 12 Pine 9' Post on Conc. Corner Post of Mill - 35' E of Sta. 83+45 Elev. 220.29