


LINE CA
 CURVE #14
 Δ 4°-20' R
 D 8'
 R 1910.1
 T 80.6
 L 101.1
 E 1.7

Parcel	Kind of Instrument	Date of Instrument	Grantor	Grantee	Recorded	Remarks
A-B-C	G.C.D. 3	11-1-33	Edward Jepson	Edward Jepson	46 65	11-1-33
A'	G.C.D. 5	11-1-33	Edward Jepson	Edward Jepson	46 60	12-1-33
A'-B'-C'	W.D. 4	9-20-33	"	"	46 34+24	9-20-33

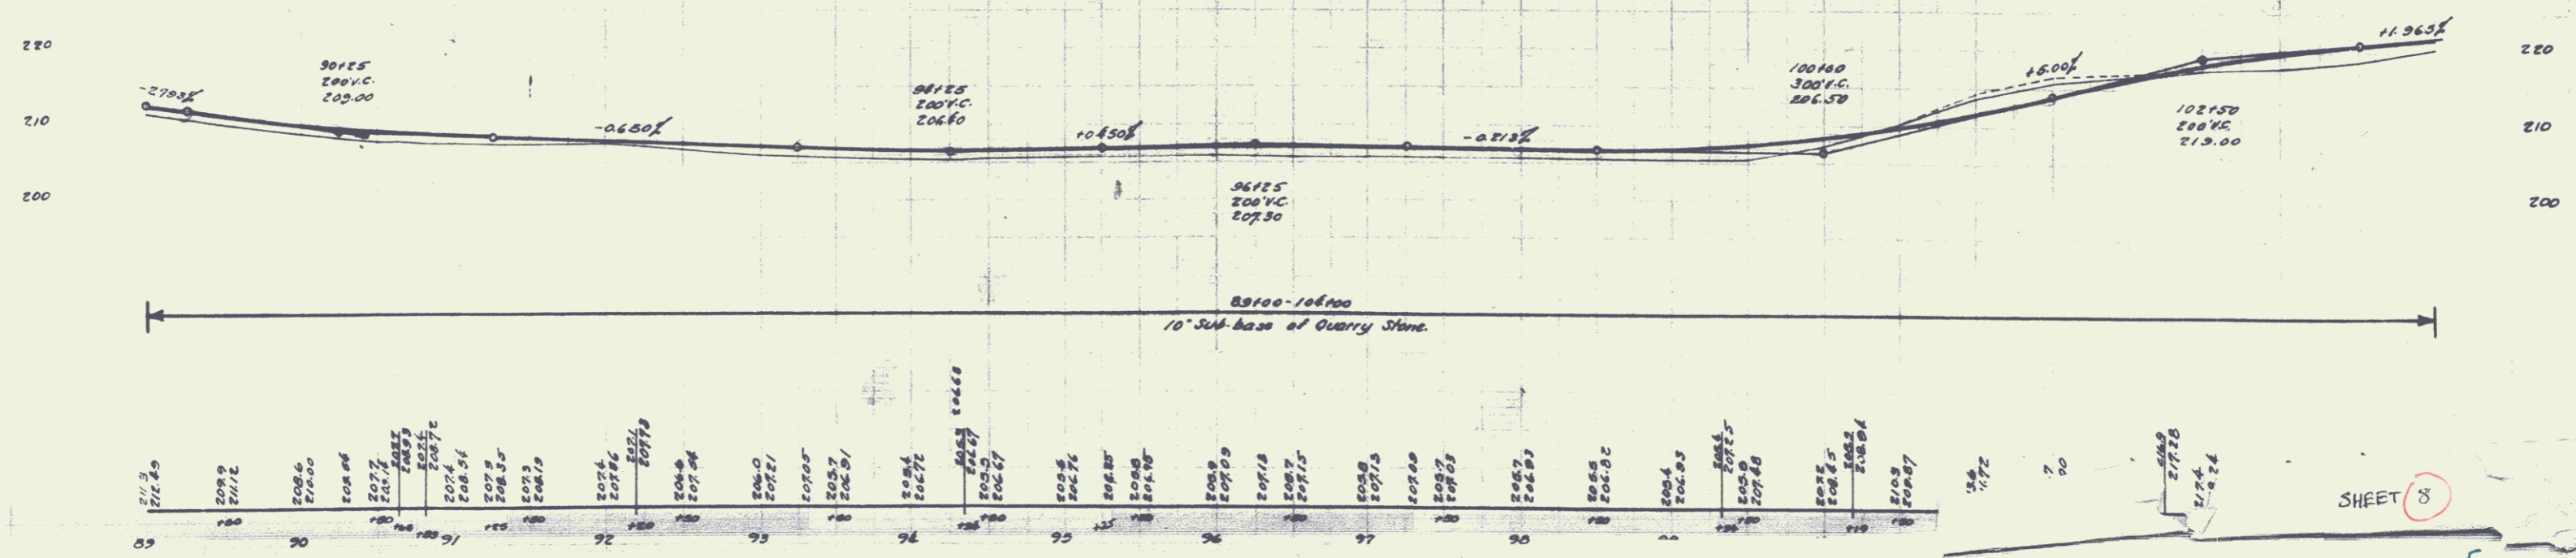

D.M. #13 - Spike in Trunk 10' from Elm - 22' LT. STA 89+71 Elev 205.82