


PLAN
 DATE 12/86
 PROJECT L'Plat
 DRAWN BY [illegible]
 CHECKED BY [illegible]
 NO. OF SHEETS 1

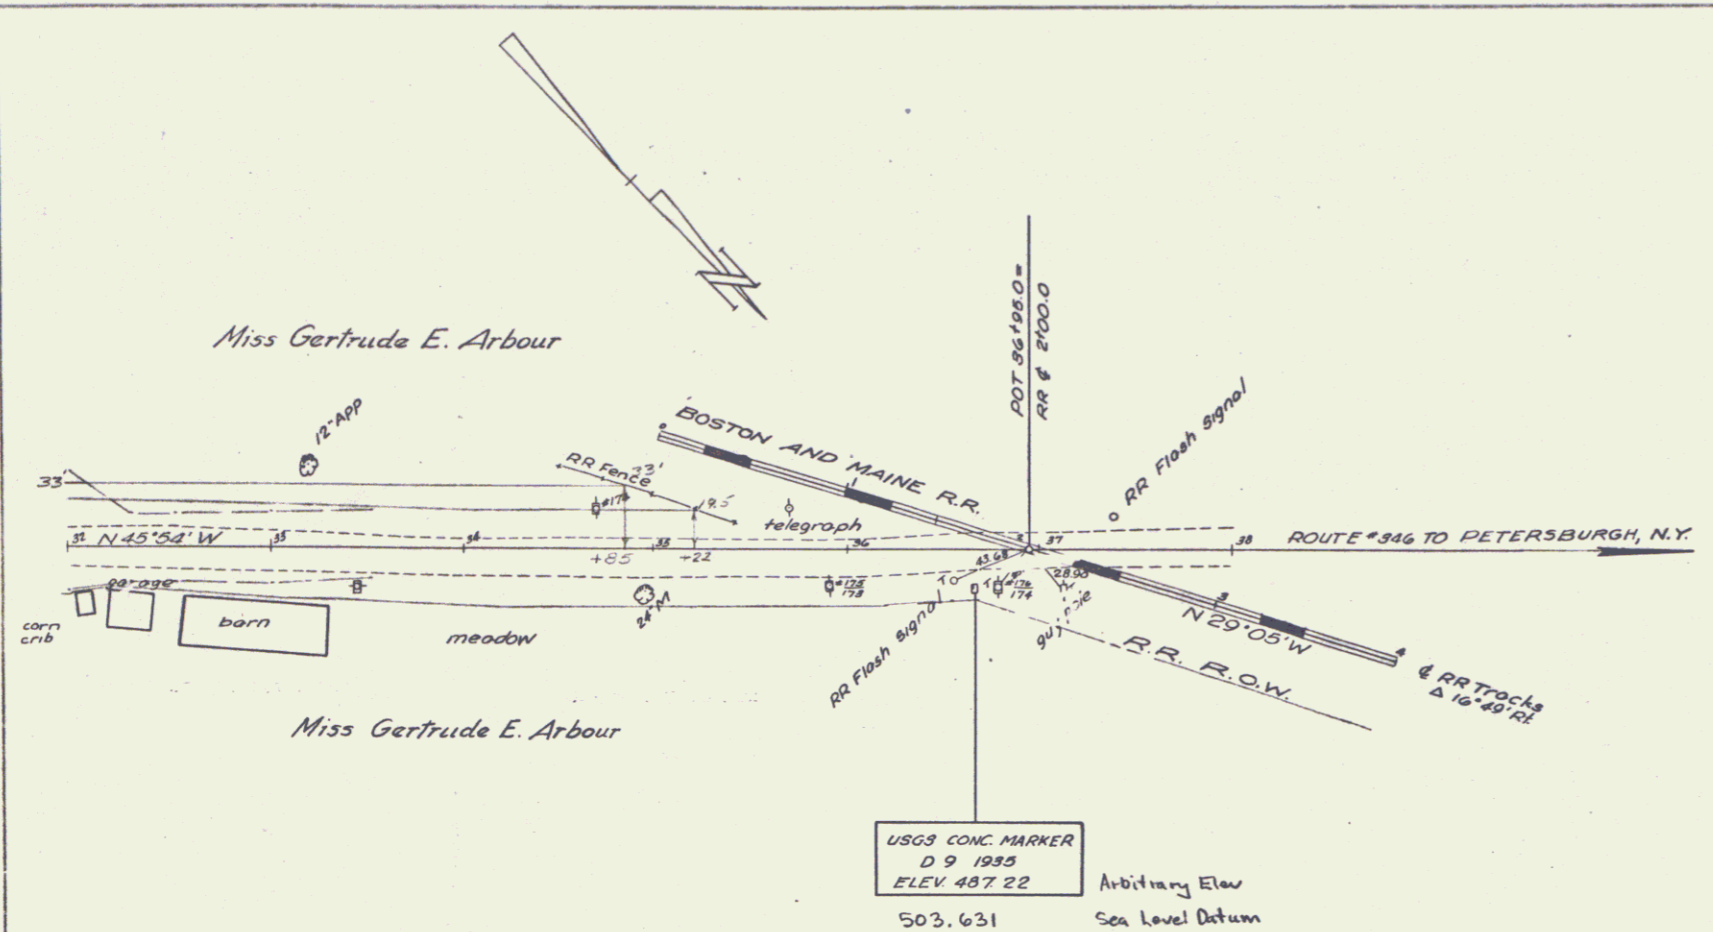

PROFILE
 DATE 1/86
 PROJECT L'Plat
 DRAWN BY [illegible]
 CHECKED BY [illegible]
 NO. OF SHEETS 1



USGS Marker D 9 1935 Conc. Post with Bronze Plate
 22° 21' Sta. 36+67 Elev 487.22

PLATE 11 - PLAN PROFILE 5" = 1" & 1" = 10'
 BEARING & ELEV. TO 0.01'
 DATE 12/86

DOWNAL
 Proj. F. NO. 136(2)
 Sheet 6 of 7