


EXCAVATION & REMOVAL OF EXISTING CEMENT CONCRETE PAVEMENT  
80+00 - 88+00

THREE CABLE GUARD RAIL WITH STEEL POSTS  
 LT. RT.  
 80+25 - 81+25 80+24 - 80+25  
 83+54 - 86+00 83+54 - 86+00  
 90+36 - 90+68 90+36 - 90+68  
 94+37 - 94+69 94+31 - 94+63  
 STEEL GUIDE POSTS  
 92+00 Rt. (Side Road) 6 ea.

UNCLASSIFIED CHANNEL EXCAVATION  
 95+00 ft - 96+00 ft  
 STONE FILL FOR SLOPE PROTECTION  
 93+80 ft - 94+35 ft  
 94+65 ft - 96+00 ft  
 92+00 ft - 93+75 ft  
 93+75 ft  
 95+35 ft - 96+00 ft  
 95+50 ft - 96+00 ft  
 RIPRAP FOR BANK PROTECTION  
 80+45 ft RT.

CONSTRUCT DRIVE  
 84+00 ft - 92+00 ft

CONSTRUCT APPROACH  
 92+00 ft

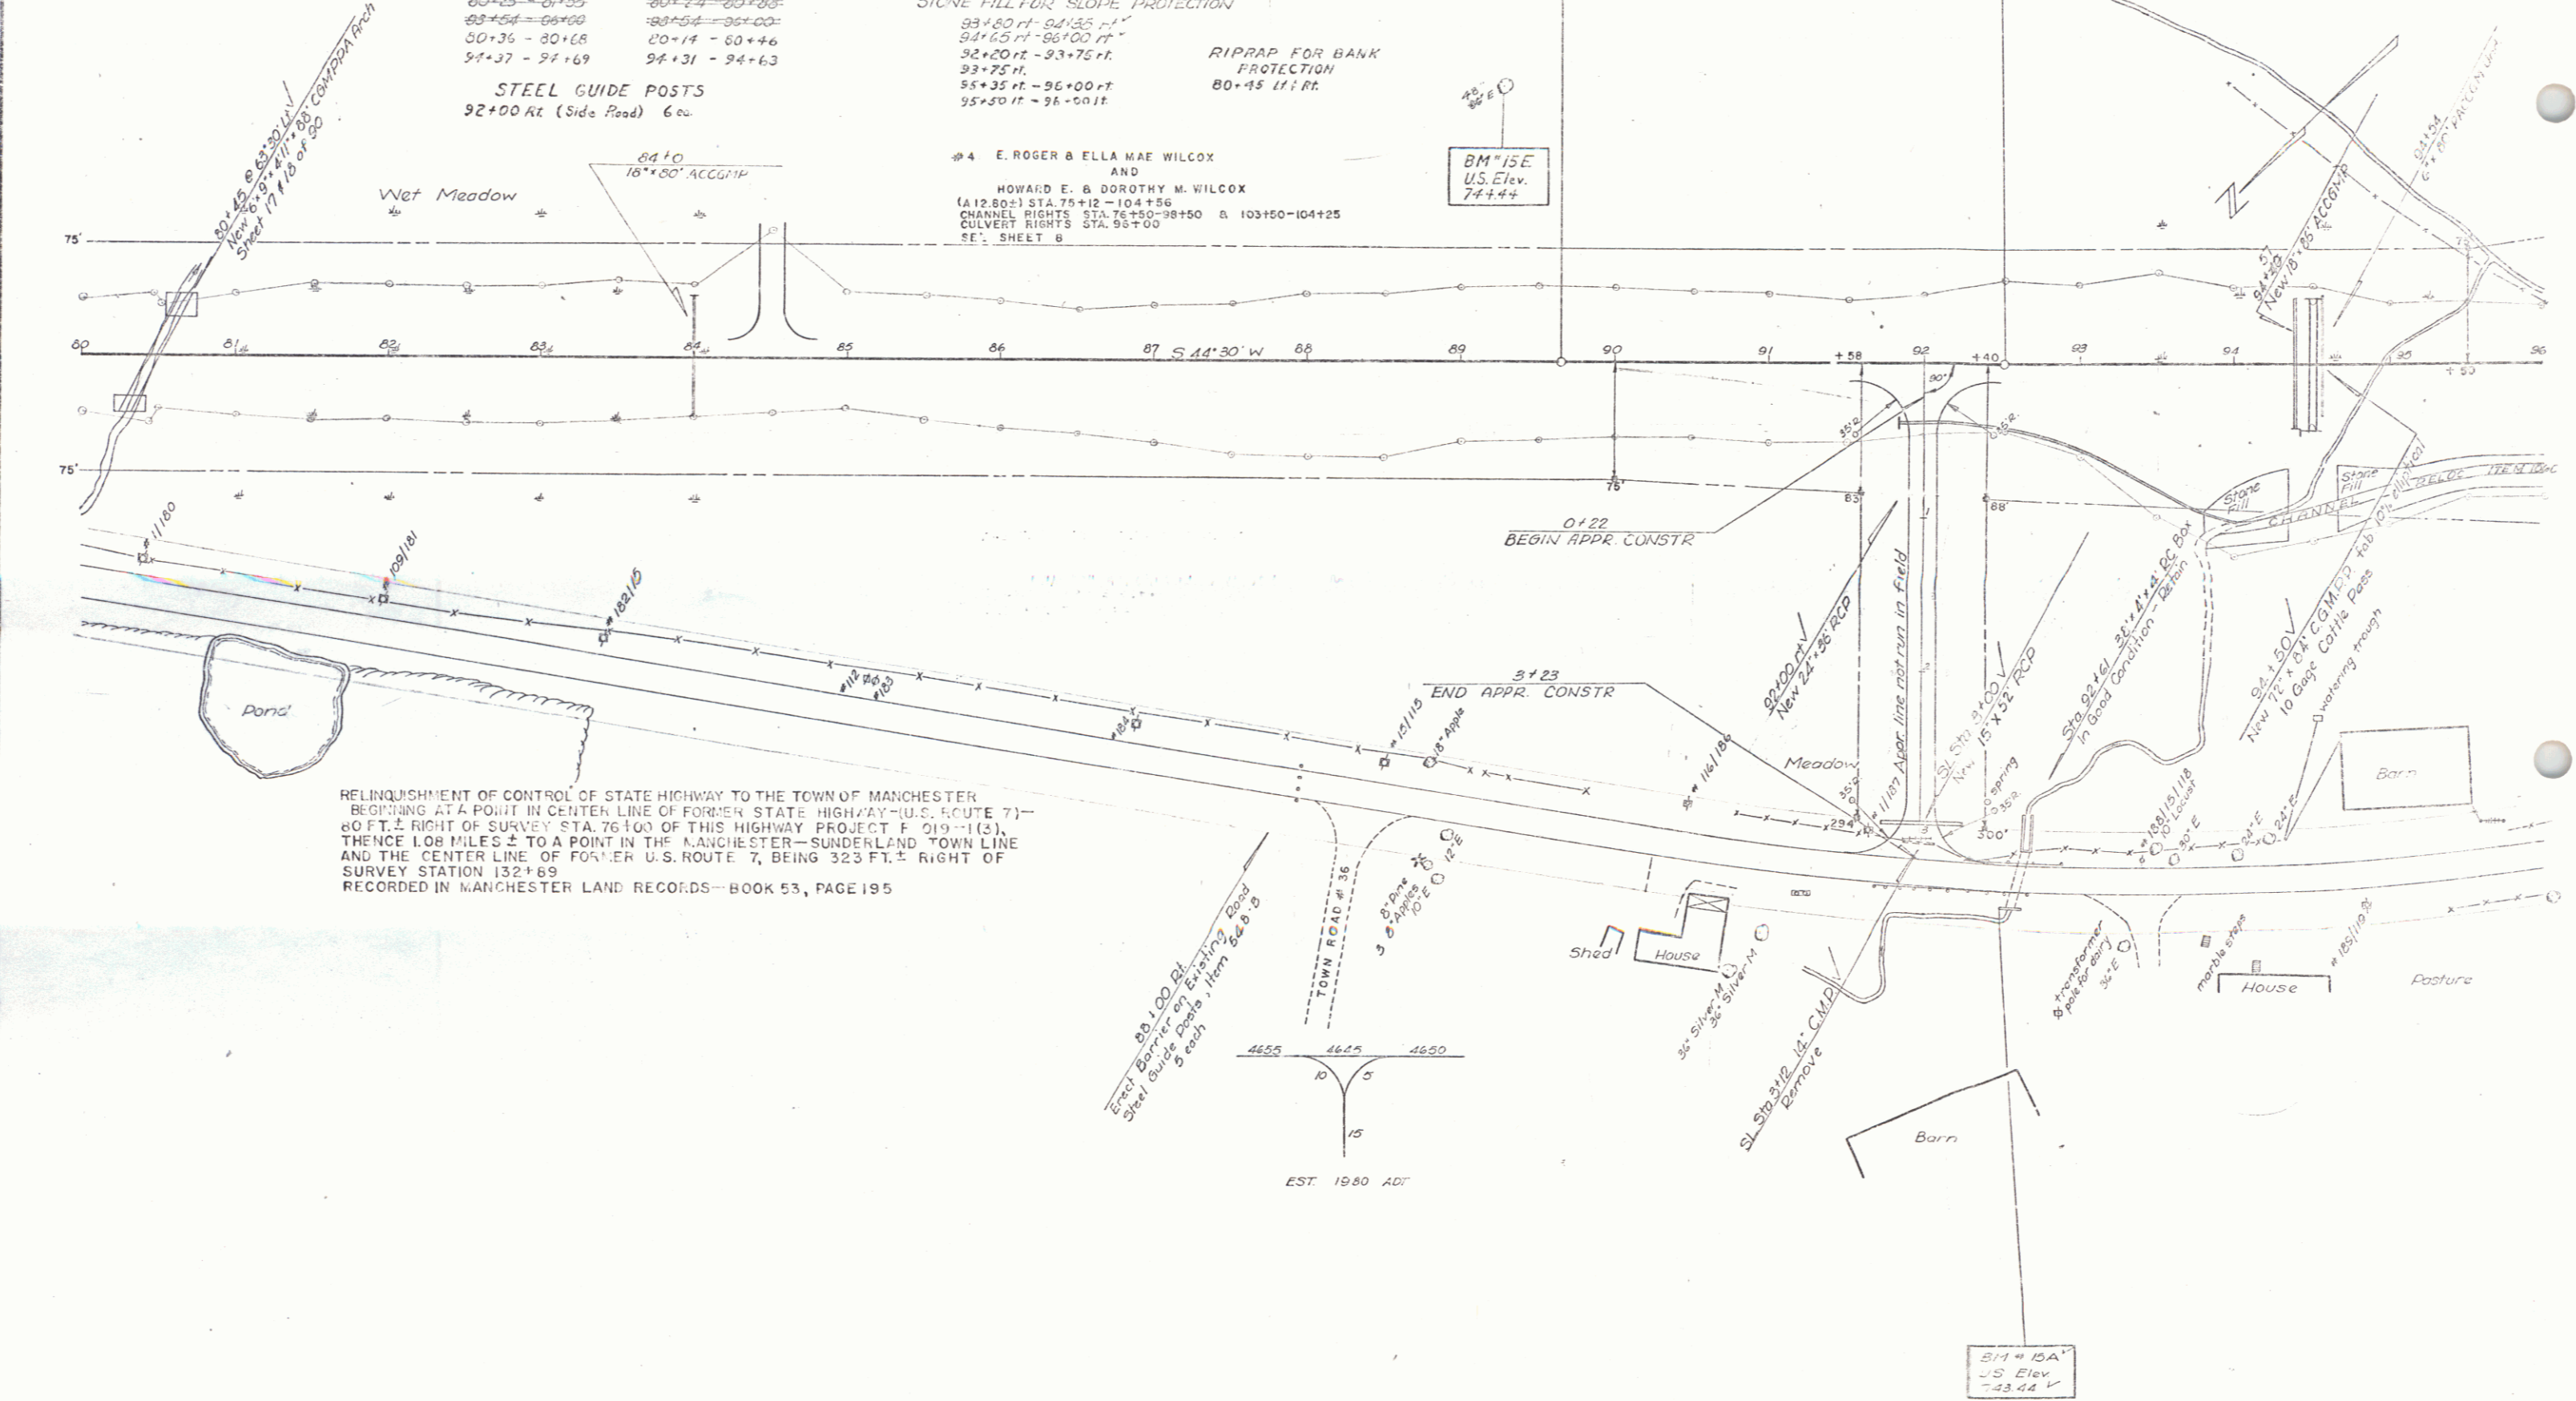

MANCHESTER-SUNDERLAND  
 Proj No F 019-1(3)  
 Sheet 9 of 90