


THIS IS PART OF THE SAME LAND CONVEYED TO THE STATE OF VERMONT BY WARRANTY DEED OF EASEMENT FROM ETHEL M. BOWEN DATED JULY 30, 1959 AND RECORDED AUGUST 5, 1959, IN BOOK 30, PAGES 4, 5, & 6 OF THE SUNDERLAND LAND RECORDS

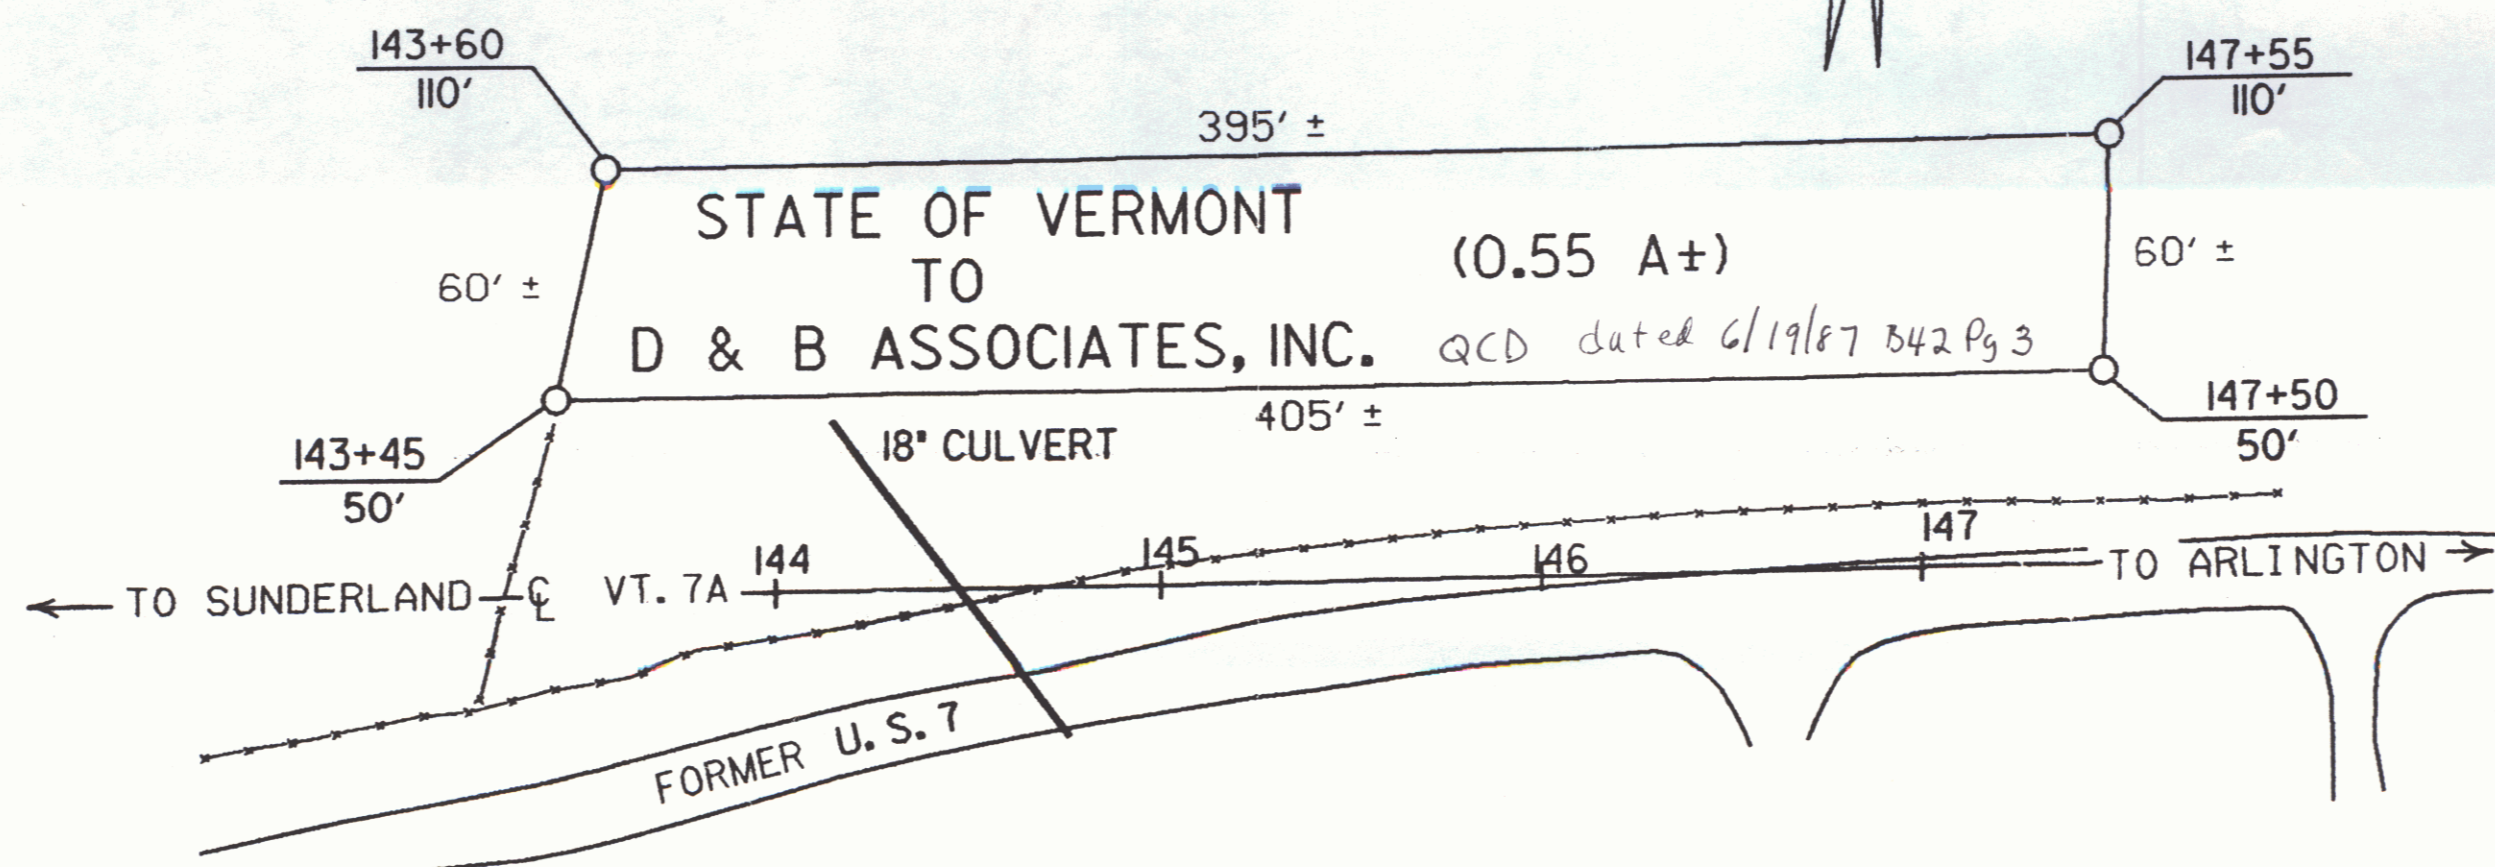

RIGHT-OF-WAY DIVISION
TOWN FILE

PERPETUAL

Town of Sunderland
VT. 7A
(To Be Returned To R.O.W. Division)
mm 1.878

RF: SUNDERLAND-MANCHESTER F 019-1(3)
SHEET 15 OF 90

STATE OF VERMONT
AGENCY OF TRANSPORTATION

TOWN OF SUNDERLAND

APPROX. SCALE P = 50' DATE 6-8-87 DRAWN BY M.J.R.

