

WOOD GUARD RAIL REQUIRED

CULVERT STATION	LEFT	RIGHT
166+25	24'	26'

CABLE GUARD RAIL REQUIRED

STATIONS	LEN	CONC	WIRE
167+50 - 167+75	25'	40"	4#5
167+75 - 167+90	15'	40"	4#5
167+90 - 168+10	20'	40"	4#5
168+10 - 168+40	30'	40"	4#5
168+40 - 168+80	40'	40"	4#5

CULVERT REPAIRS REQUIRED



STATION	NATURE OF REPAIR	CONC. A	STEEL
163+00	Patching concrete - 4' x 4' x 4"	2.4 cy	106#

OUTER ROLLS MACADAM GUTTER REQUIRED

STATIONS	LEN	R	LENGTH	BROKEN STONE	SURFACE COURSE
155+50 - 157+00	150'	27'	144'	8 cy	4 cy
162+100 - 163+144	144'	27'	144'	8 cy	4 cy
162+173 - 164+163	190'	27'	184'	8 cy	4 cy

FED. ROAD DIST. NO. STATE PROJ. NO. SHEET NO. TOTAL SHEETS

2-26 1931 14 37

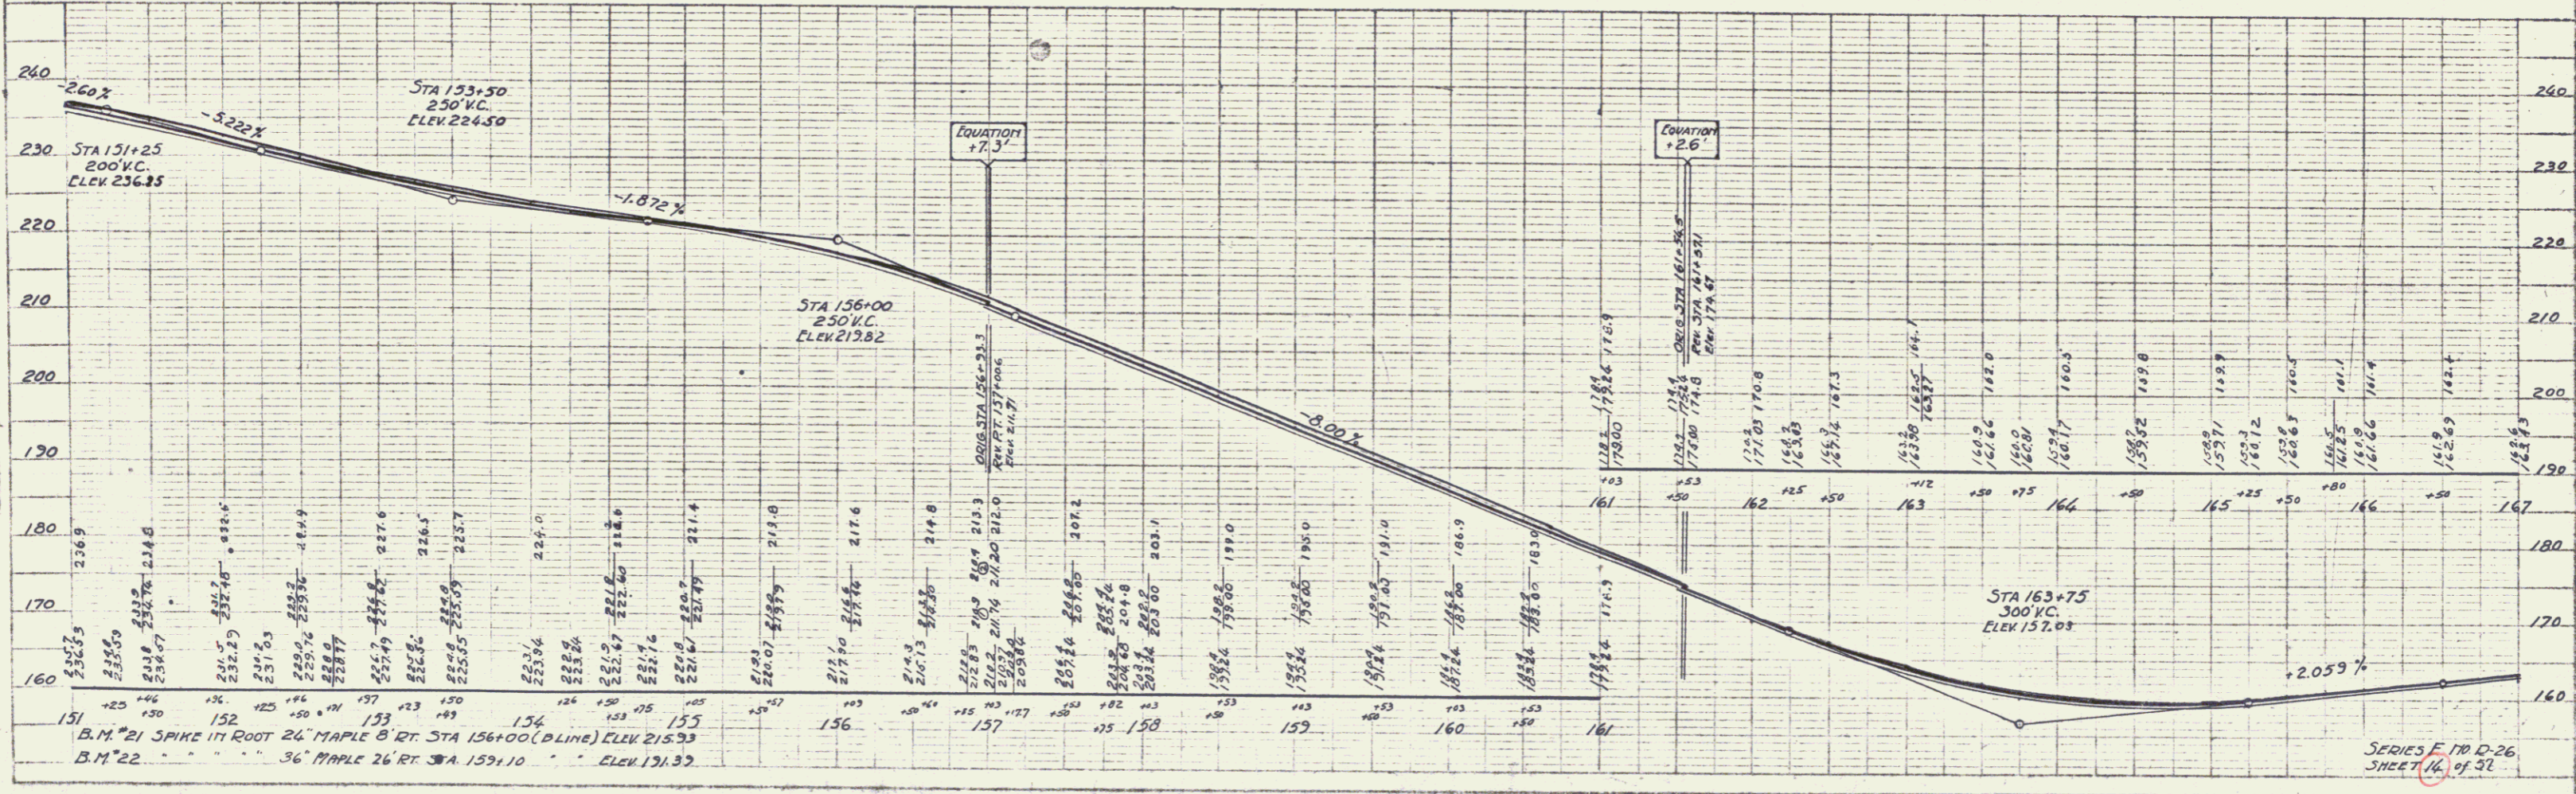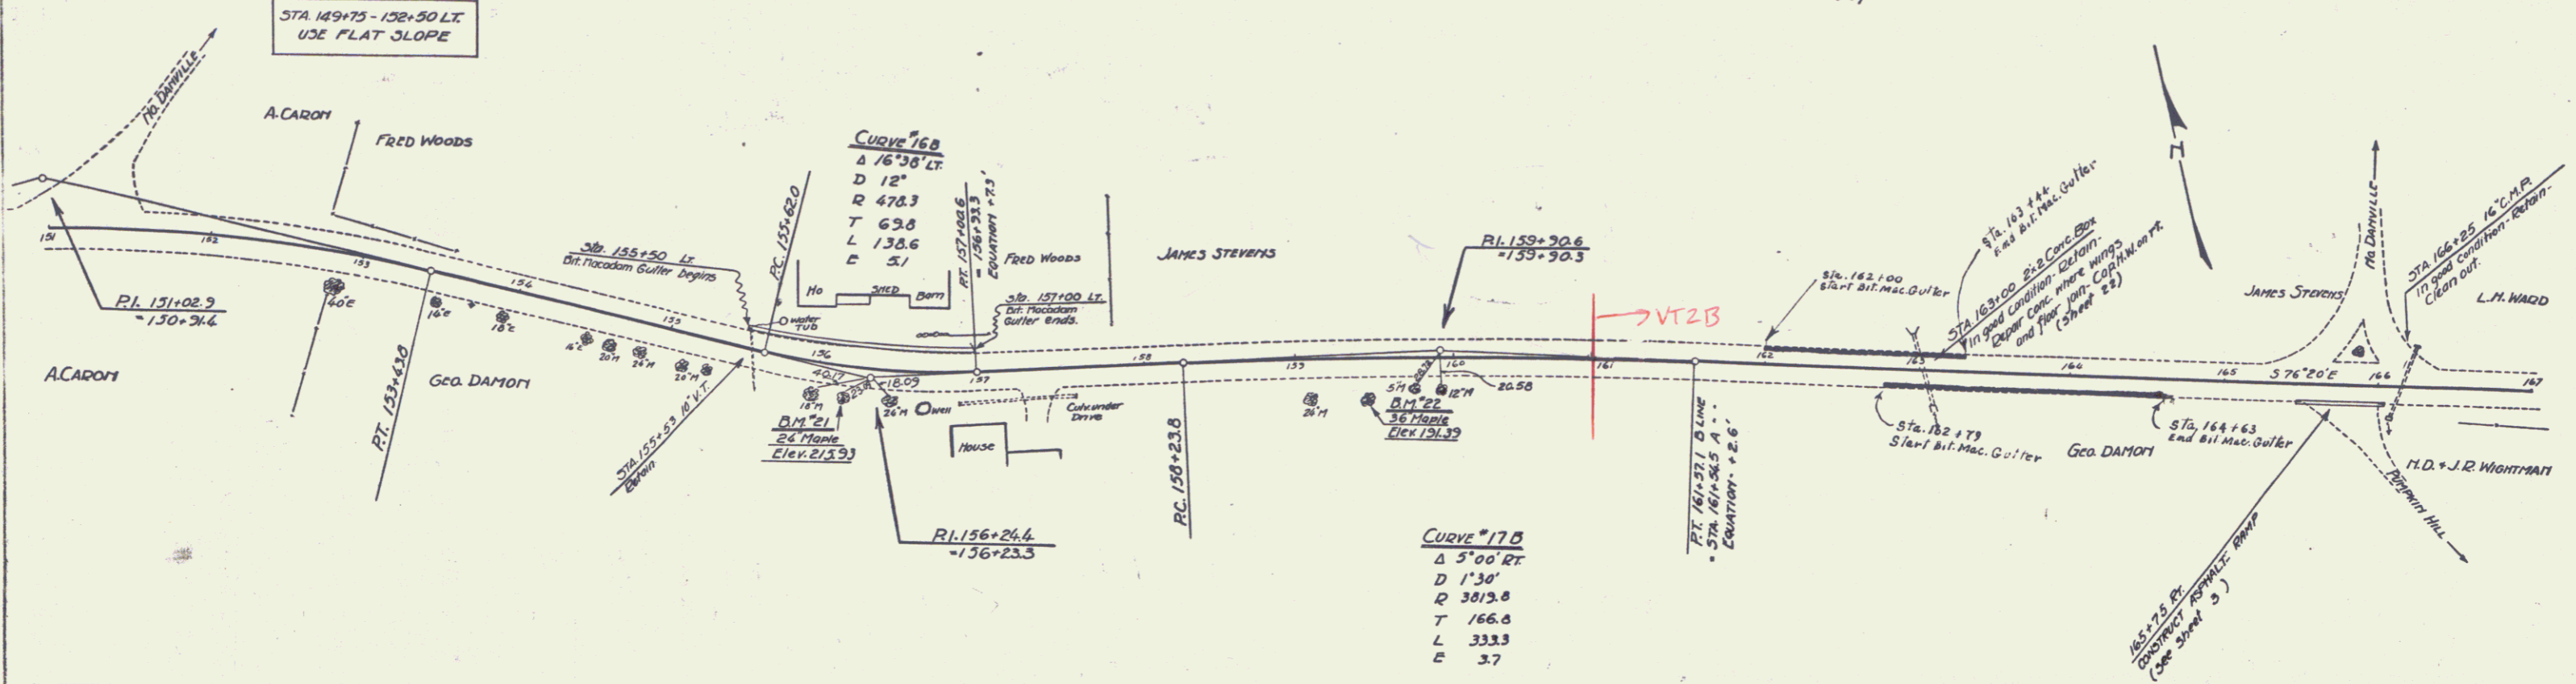

SERIES E 170 D-26  
SHEET 16 of 37