


PLANNED  
ADJUSTED  
FRAMED

W/100  
ADJUSTED

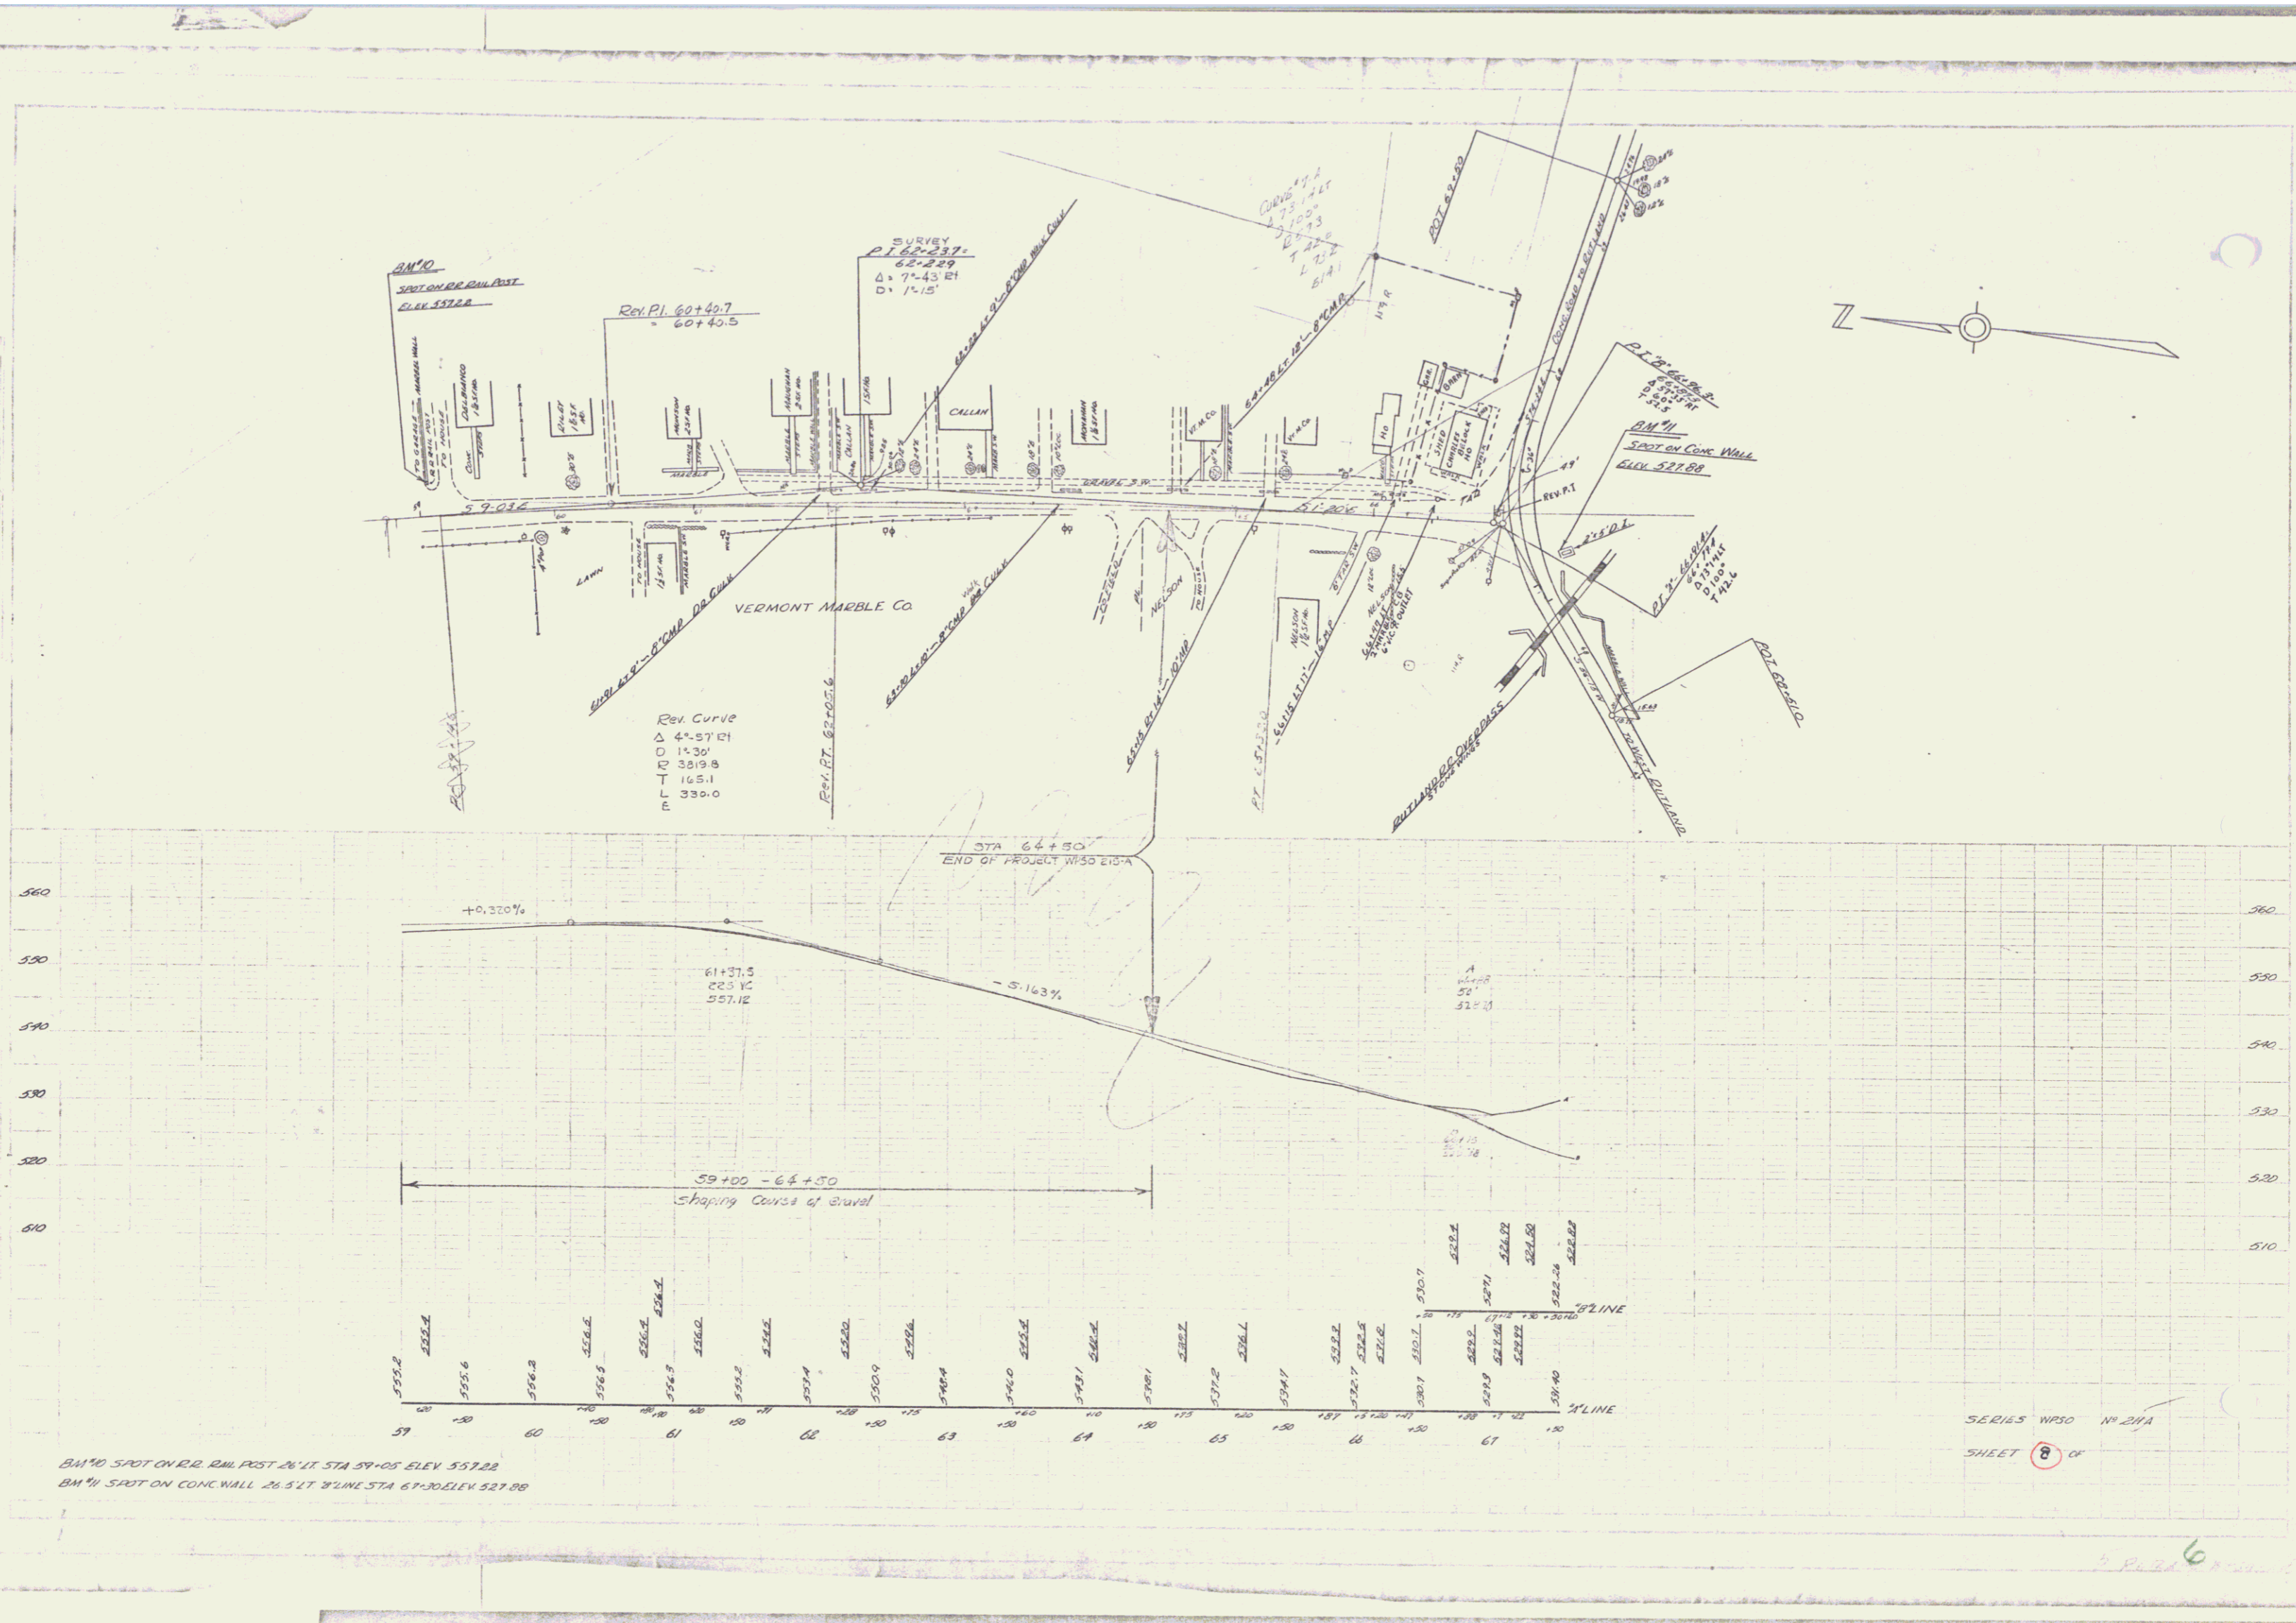

BM #10 SPOT ON RR. RAIL POST 26' LT STA 59+05 ELEV 557.22  
BM #11 SPOT ON CONC WALL 26.5' LT W/LINE STA 67+30 ELEV 527.88

SERIES WPSO N° 21A  
SHEET 8 OF

6