

INDEX OF SHEETS

| | |
|---------|---|
| 1 | TITLE |
| 2-4 | TYPICALS (2-1/2" BITUMINOUS CONCRETE PAVEMENT - ITEM 361 MODIFIED) |
| 5-7 | SUMMARY OF QUANTITIES |
| 8-10 | ITEM DETAIL DRAINAGE SHEETS |
| 11-15 | EARTHWORK SHEETS |
| 16-17 | MUCK EXC. GROUT EXC. ROCK FILL, UNCL. CHANNEL EXCAVATION & STONE FILL |
| 18 | EARTHWORK SUMMARY BY 500 |
| 19-22D | R.O.W. DETAIL SHEETS |
| 23 | PLAN DETAIL AT INTERSECTION W/US RTE.#4 |
| 24 | DETAILS OF DIVISIONAL ISLANDS |
| 25 | RAMP TERMINAL DETAILS |
| 26-47 | PLAN AND PROFILE SHEETS |
| 48 | STANDARDS-HIGHWAY STANDARD CROSSING FLASHING LIGHT SIGNAL ASSEMBLY (SURV STA. 22+65') |
| 49 | METAL PLATE ARCH CATTLEPASS (REV. STA. 63+50) |
| 50 | A-61 (DRILLING & BLASTING OF SOLID ROCK SUB-GRADE) - MARCH 10, 1965 |
| 51 | B-1 (BANKING TABLES) - MARCH 10, 1965 |
| 52 | B-5 (TYPICAL SLOPE GRADINGS) - MARCH 10, 1965 |
| 53 | B-6 (MUCK EXCAVATION) - MARCH 10, 1965 |
| 54 | B-10 (SLOPE EMBANKMENT) - MARCH 10, 1965 |
| 55 | B-11 (SLOPE STABILIZATION) - MARCH 10, 1965 |
| 56 | B-12 (APPROACH INTERSECTION-DEPRESSED RAMP) - MARCH 10, 1965 |
| 57 | B-13 (DRIVE INTERSECTION-DEPRESSED RAMP) - MARCH 10, 1965 |
| 58 | B-15 (ENTRANCE & EXIT TERMINALS) - MARCH 10, 1965 |
| 59 | B-16 (DIVISIONAL ISLAND & TRIANGULAR ISLAND DESIGN) - MARCH 10, 1965 |
| 60 | C-1 (CURB ENDS, SLOPE EDGINGS) - MARCH 10, 1965 |
| 61 | C-1A (PRECAST CONCRETE CURBS) - MARCH 10, 1965 |
| 62 | C-2A (DRIVE ENTRANCES-CONCRETE CURBS) - MARCH 10, 1965 |
| 63 | C-2B (ONE COURSE CEMENT CONC. SIDEWALK-ITEM 560, DRIVE ENTRANCES, GRANITE CURB) - MARCH 10, 1965 |
| 64 | D-2 (C.R.M. HEADWALLS - STANDARD UNDERDRAIN) - MAR 23, 1967 |
| 65 | D-3 (BITUMINOUS GUTTER) - MAY 12, 1967 |
| 66 | D-4 (EXTENSION SERVICE BOX & CURB STOP, SP. ACCOMP. ELBOW, UNDERDRAIN FLUSHING BASIN & COVER) - AUG 1, 1966 |
| 67 | D-8 (REINF. CONC. D.I. WITH GRATE - BOTTOM SECTION) - MARCH 10, 1965 |
| 68 | D-9 (REINF. CONC. D.I. TOP WITH CURB) - MAR 10, 1965 |
| 69 | D-11 (DETAILS OF GRATES) - MARCH 10, 1965 |
| 70 | D-16 (PRECAST REINF. CONC. CURB D.I. W/C. GRATE & FRAME) (CAST IRON GRATE-TYPE B) - NOV. 4, 1966 |
| 71 | E-31 (FEDERAL-AID CONSTRUCTION IDENTIFICATION SIGNS)-APR 21, 1967 |
| 72 | E-32 (ROAD CONSTRUCTION APPROACH SIGN) - JAN 6, 1967 |
| 72A | E-34 (ON PROJECT CONSTRUCTION SIGNS) - JAN 13, 1967 |
| 73 | F-1 (PROPERTY LINE FENCE W/STEEL POSTS, STEEL BRACES, DRIVE GATE) - MAR 23, 1967 |
| 74 | G-8 (THREE CABLE GUARD RAIL W/LIGHT STEEL POSTS) (ANCHORS FOR THREE CABLE GUARD RAIL W/LIGHT STEEL POSTS) - AUG 31, 1967 |
| 74A | G-7 (THREE CABLE GUARD RAIL W/LIGHT STEEL POSTS) (ANCHORS FOR THREE CABLE GUARD RAIL W/LIGHT STEEL POSTS AT DRIVEWAYS) - AUG 31, 1967 |
| 75 | G-4 (STEEL MARKER POSTS, WOOD & STEEL GUIDE POSTS) - DEC 30, 1965 |
| 76 | J-1 (PROJECT MARKERS - BOUNDARY MARKERS) - MAR 10, 1965 |
| 77-80 | CROSS SECTIONS SHOWING CURB & ISLAND CONSTRUCTION ON US RTE #4 (STA. 99+00 - 103+00) |
| 81-136 | MAIN LINE CROSS SECTIONS |
| 137-139 | APPROACH CROSS SECTIONS (STA. 29+00 RT) |
| 140-141 | APPROACH CROSS SECTIONS (STA. 184+00 RT) |
| 142-143 | BANKING TRANSITIONS |

**STATE OF VERMONT
DEPARTMENT OF HIGHWAYS**

**PROPOSED IMPROVEMENT
FEDERAL AID SECONDARY PROJECT**

TOWNS OF RUTLAND-PROCTOR

COUNTY OF RUTLAND

**VERMONT ROUTE 3
CENTER RUTLAND-PROCTOR ROAD**


BEGINNING AT A POINT 1.690 MILES SOUTHERLY FROM THE RUTLAND-PROCTOR TOWN LINE, AND EXTENDING NORTHERLY 3.703 MILES

LENGTH OF PROJECT: 19,550 FEET = 3.703 MILES.

| | | | | |
|---------------------|-------|-------------|-----------|--------------|
| FED. ROAD DIST. NO. | STATE | PROJECT NO. | SHEET NO. | TOTAL SHEETS |
| VT 5 01630 | VT | 01630 | 1 | 143 |



NOTE:
FOR RIGHT-OF-WAY DETAILS, SEE RIGHT-OF-WAY PLANS FOR THIS PROJECT.

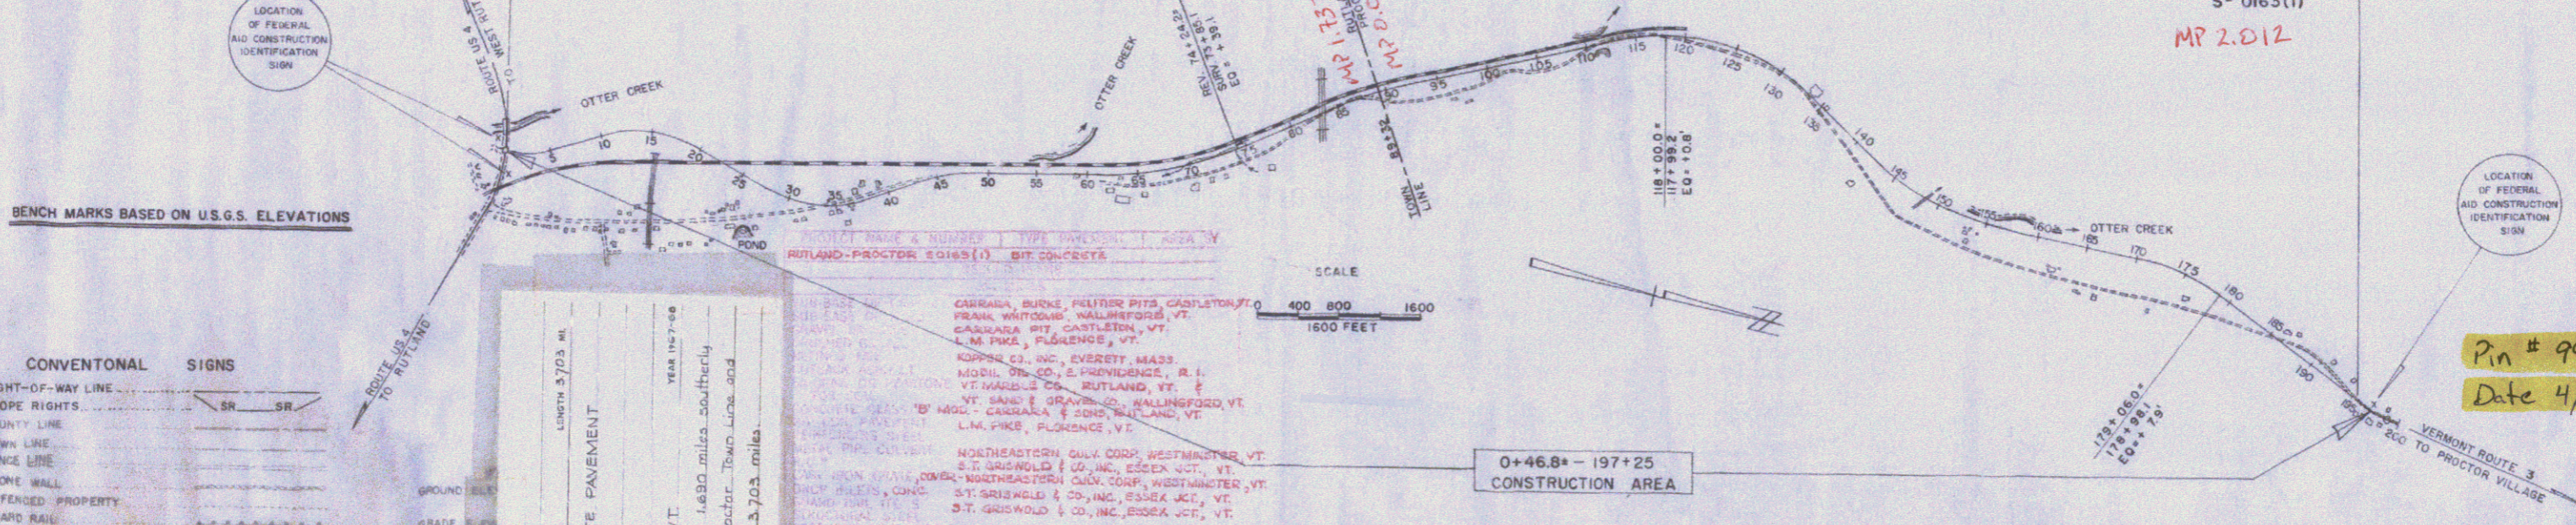

CONVENTIONAL SIGNS

| | |
|-------------------|----|
| RIGHT-OF-WAY LINE | SR |
| SLOPE RIGHTS | SR |
| TOWN LINE | |
| FENCE LINE | |
| STONE WALL | |
| DIFFERED PROPERTY | |
| GUARD RAIL | |
| TRAVELED WAY | |
| RAILROAD | |
| RETAINING WALL | |
| CENTER LINE | |
| SURVEY LINE | |
| CULVERT | |
| DROP INLET | |
| TROLLEY POLE | |
| POWER POLE | |
| TELEPHONE POLE | |
| TREES | |
| HEDGE | |

| | |
|------------|--|
| PROJECT | RUTLAND-PROCTOR |
| NUMBER | 3-0163(1) |
| TYPE | BITUMINOUS CONCRETE PAVEMENT |
| CONTRACTOR | ROGERS BROS. |
| LOCATION | BATTLEBORO, VT |
| LOCATION | Beginning at a point 1.690 miles southerly from the Rutland-Proctor Town Line and extending northerly 3.703 miles. |

CONTRACTORS

CARRARA, BURKE, PELLETIER PITS, CASTLETON, VT.
FRANK WATKINS, WALLINGFORD, VT.
CARRARA PIT, CASTLETON, VT.
L.M. PARK, FLORENCE, VT.
KOPPEL CO. INC., EVERETT MASS.
MODIL OR CO., FRENCHBURG, R.I.
VT. MARBLE CO., RUTLAND, VT.
VT. SAND & GRAVEL CO., WALLINGFORD, VT.
L.M. PARK, FLORENCE, VT.
NORTHEASTERN CIV. CORP., WESTMINSTER, VT.
S.T. GRISWOLD & CO., INC., ESSEX, VT.
NORTHWESTERN CIV. CORP., WESTMINSTER, VT.
S.T. GRISWOLD & CO., INC., ESSEX, VT.
S.T. GRISWOLD & CO., INC., ESSEX, VT.
S.T. GRISWOLD & CO., INC., ESSEX, VT.

CONTRACTOR: ROGERS BROS. CO. BATTLEBORO, VT.
SUPERVISOR: R. L. DUNN
E. A. DAVIS, 8 DUNBAR, ESSEX, VT.
R.F. NO.

CONSTRUCTION IS TO BE CARRIED ON IN ACCORDANCE WITH THESE PLANS AND THE STANDARD SPECIFICATIONS FOR HIGHWAY AND BRIDGE CONSTRUCTION, DATED APRIL 1964, AS APPROVED BY THE BUREAU OF PUBLIC ROADS ON OCTOBER 12, 1964, INCLUDING ALL SUBSEQUENT APPROVED REVISIONS AND SUCH REVISED SPECIFICATIONS AND SPECIAL PROVISIONS AS ARE INCORPORATED IN THESE PLANS.

DEPARTMENT OF TRANSPORTATION
BUREAU OF PUBLIC ROADS

| | | | | | | | |
|--------------------|--------------------|--------------------|--------------------|--------------------|--------------------|--------------------|--------------------|
| APPROVED | APPROVED | APPROVED | APPROVED | APPROVED | APPROVED | APPROVED | APPROVED |
| <i>[Signature]</i> | <i>[Signature]</i> | <i>[Signature]</i> | <i>[Signature]</i> | <i>[Signature]</i> | <i>[Signature]</i> | <i>[Signature]</i> | <i>[Signature]</i> |
| DATE 4/23/65 | DATE 4/1/65 | DATE 4/1/65 | DATE 4/1/65 | DATE 4/1/65 | DATE 4/1/65 | DATE 4/1/65 | DATE 4/1/65 |

Pin # 992700
Date 4/1/1965

| | | | |
|---------|---|--------------|---------|
| PROJECT | S | NO. | 0163(1) |
| SHEET | 1 | TOTAL SHEETS | 143 |