


ST. OF VT LESSOR - VT RR, INC. LESSEE

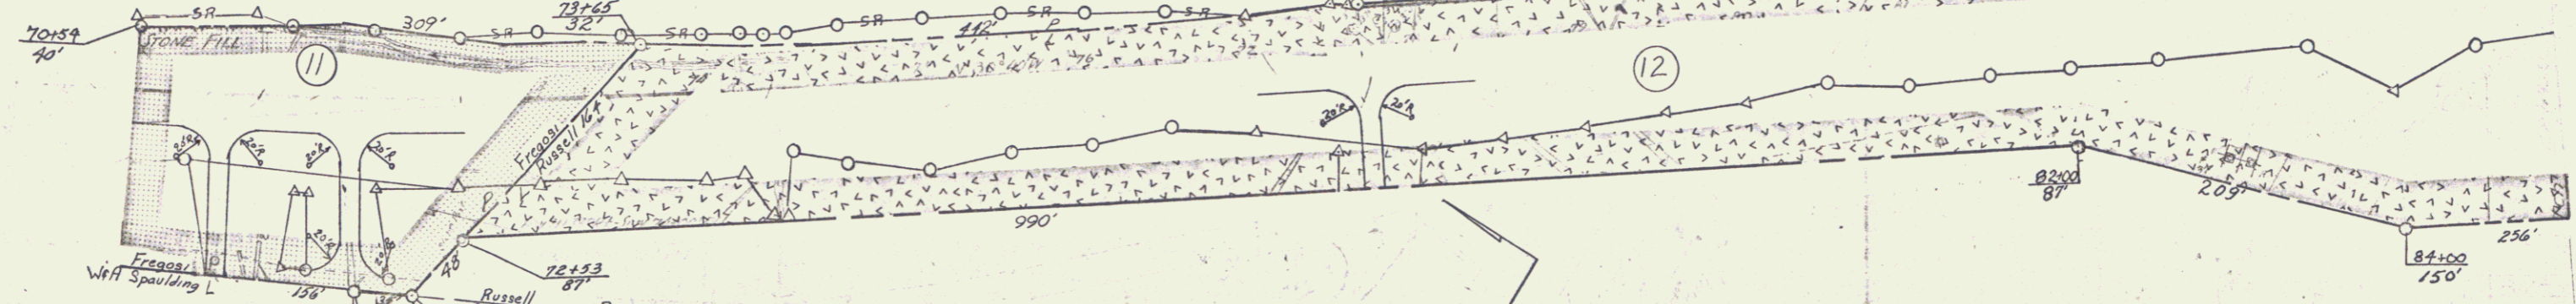

REMOVE
 Rev 7/15/12 P.P.
 New C&M.P. (M&S)
 or C.A.M.C.P. (M&S)
 Rev 7/15/12 P.P.
 New C&M.P. (M&S)
 or C.A.M.C.P. (M&S)
 or R.C.P. Class III
 Break Reinforcement #3
 Sta. 70+59.40 to 72+33.87

WELLS
 O

Rev 7/15/12 P.P.
 New C&M.P. (M&S)
 or C.A.M.C.P. (M&S)
 Rev 7/15/12 P.P.
 New C&M.P. (M&S)
 or C.A.M.C.P. (M&S)
 or R.C.P. Class III
 Break Reinforcement #3
 Sta. 70+59.40 to 72+33.87

VERMONT DEPARTMENT OF HIGHWAYS
 RIGHT-OF-WAY PLANS
 PROJECT - RUTLAND-PROCTOR
 NO - 50163(C)
 SHEET - 22 OF 45