


PLAN

DATE	BY
10-14	W. J. [unclear]
8-11	[unclear]
10-14	[unclear]
10-14	[unclear]

PROFILE

DATE	BY
10-14	W. J. [unclear]
8-11	[unclear]
10-14	[unclear]
10-14	[unclear]

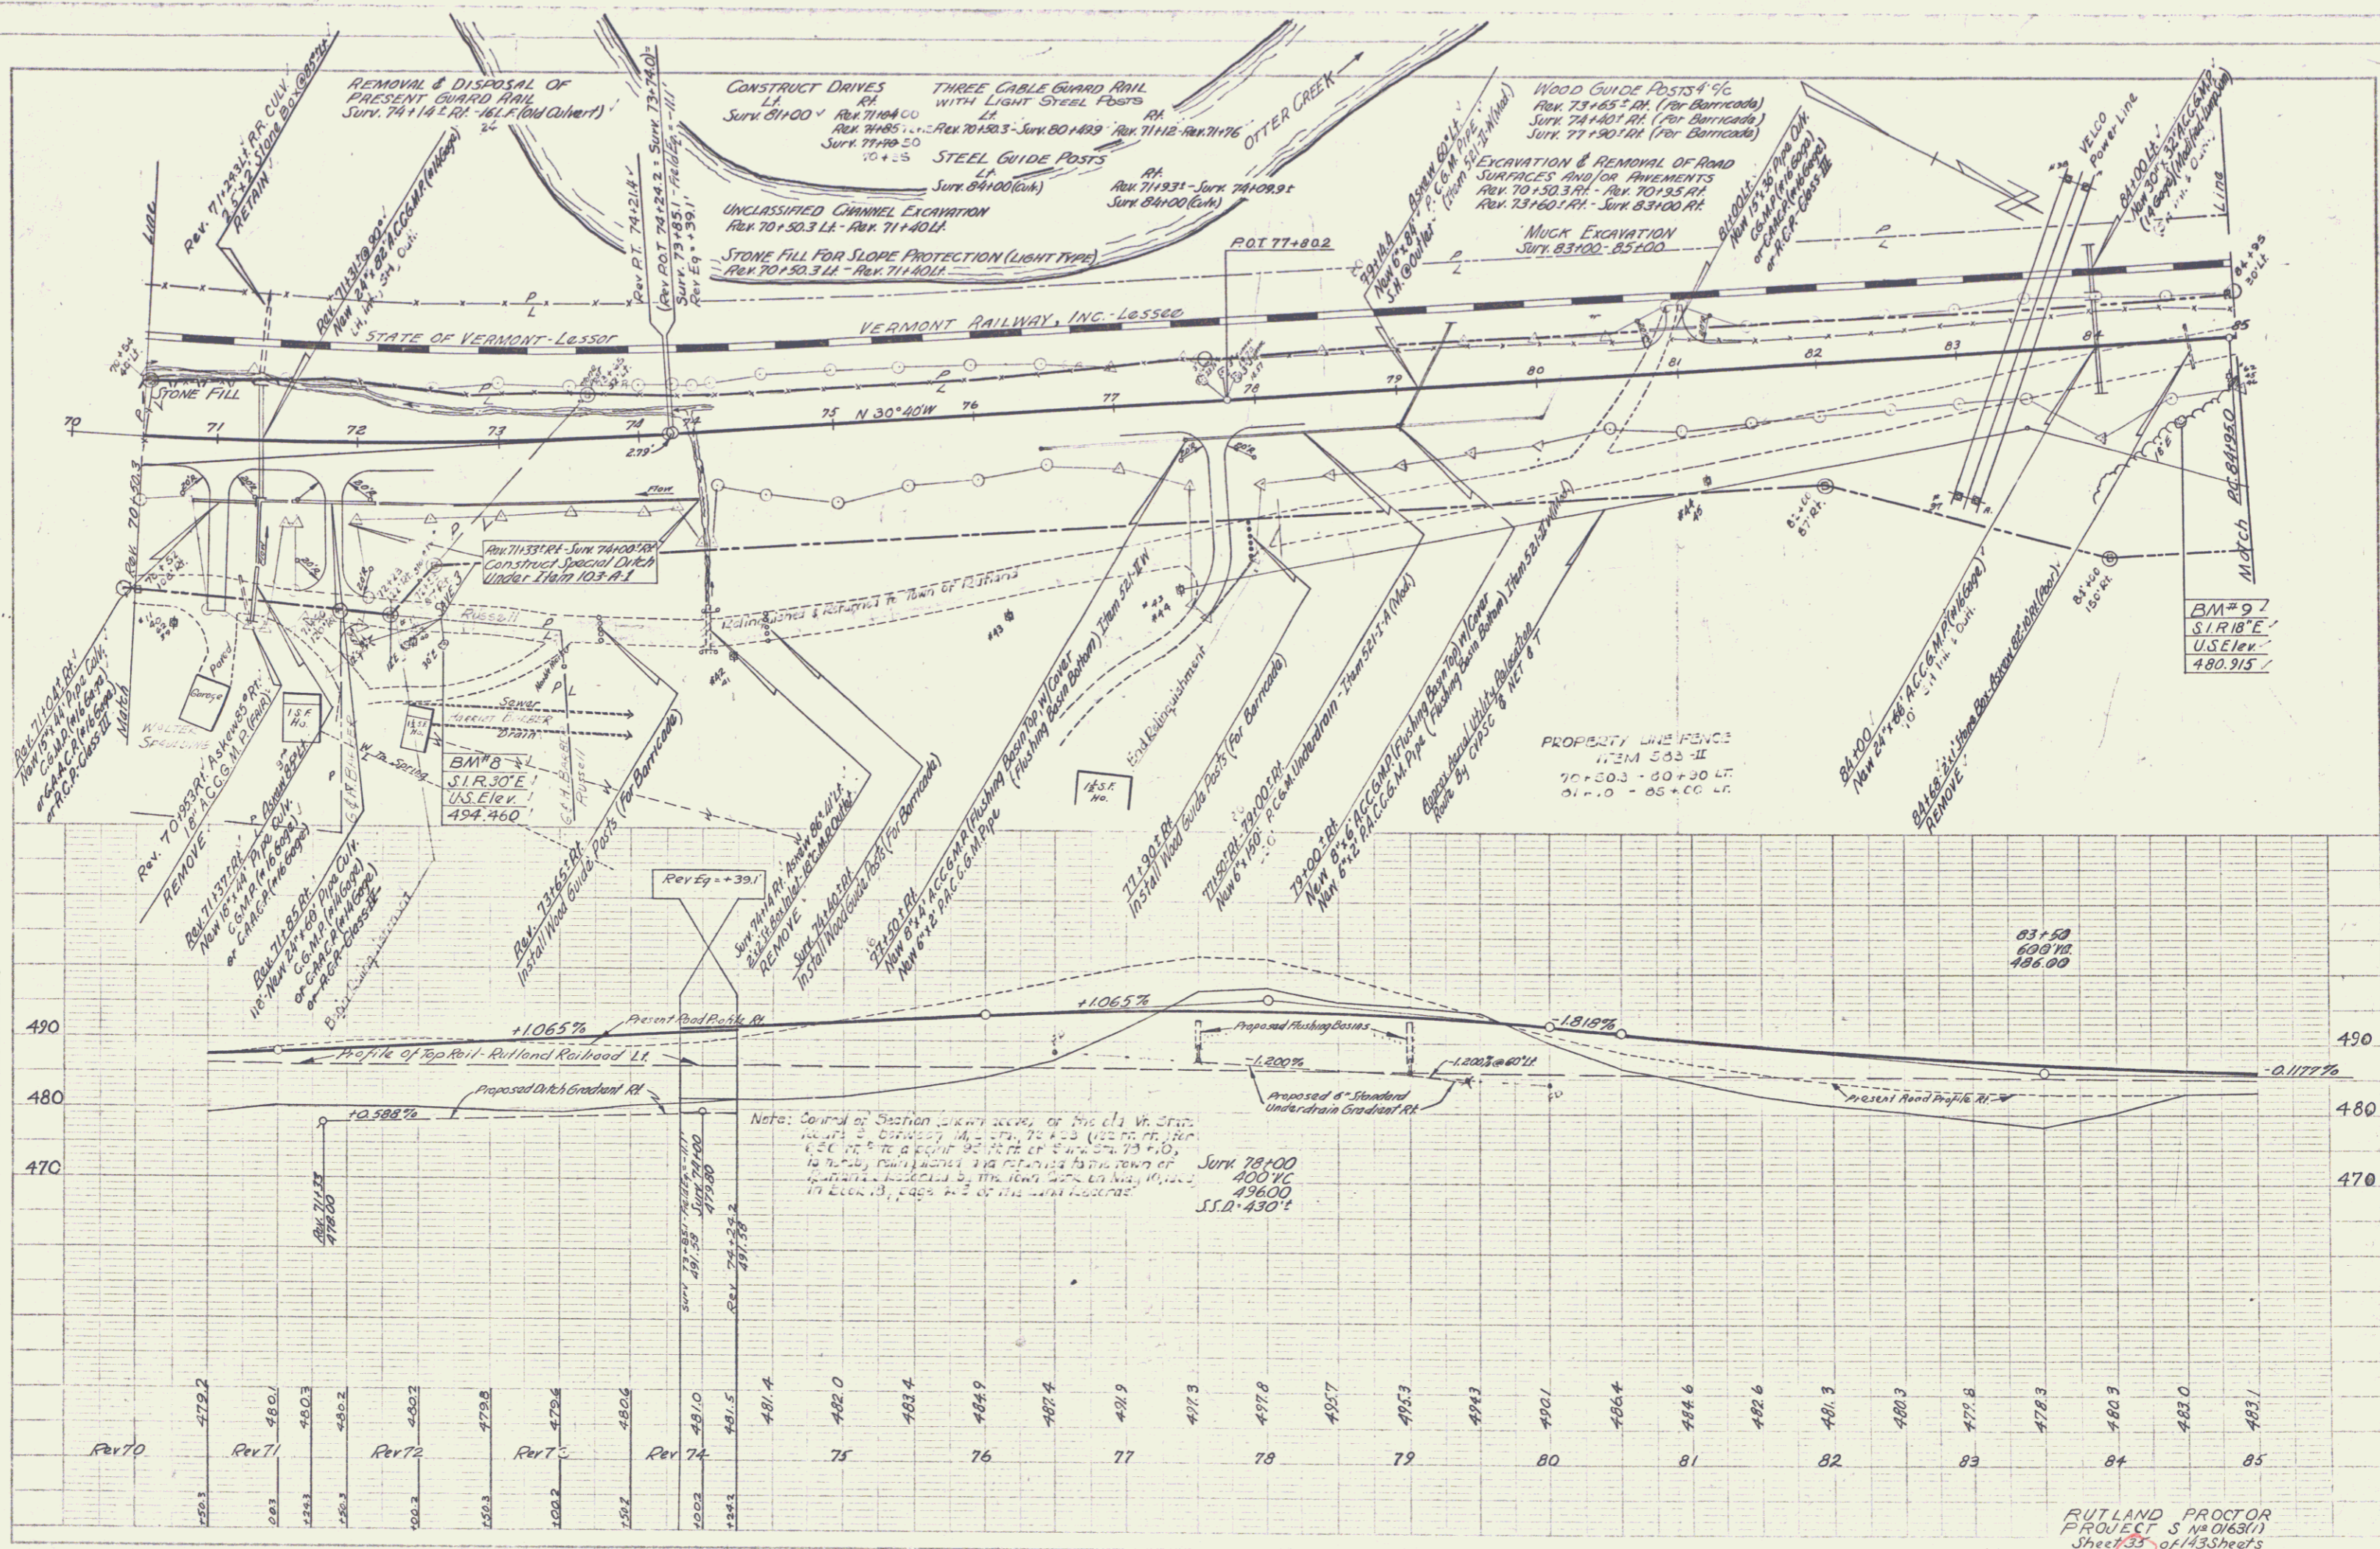

RUTLAND PROCTOR
PROJECT S No 0163(1)
Sheet 33 of 143 Sheets