


PLAN
 DATE 6-42
 DRAWN BY J. J. [unclear]
 CHECKED BY [unclear]
 NO. 10-42

PROFILE
 DATE 6-42
 DRAWN BY J. J. [unclear]
 CHECKED BY [unclear]
 NO. 10-42

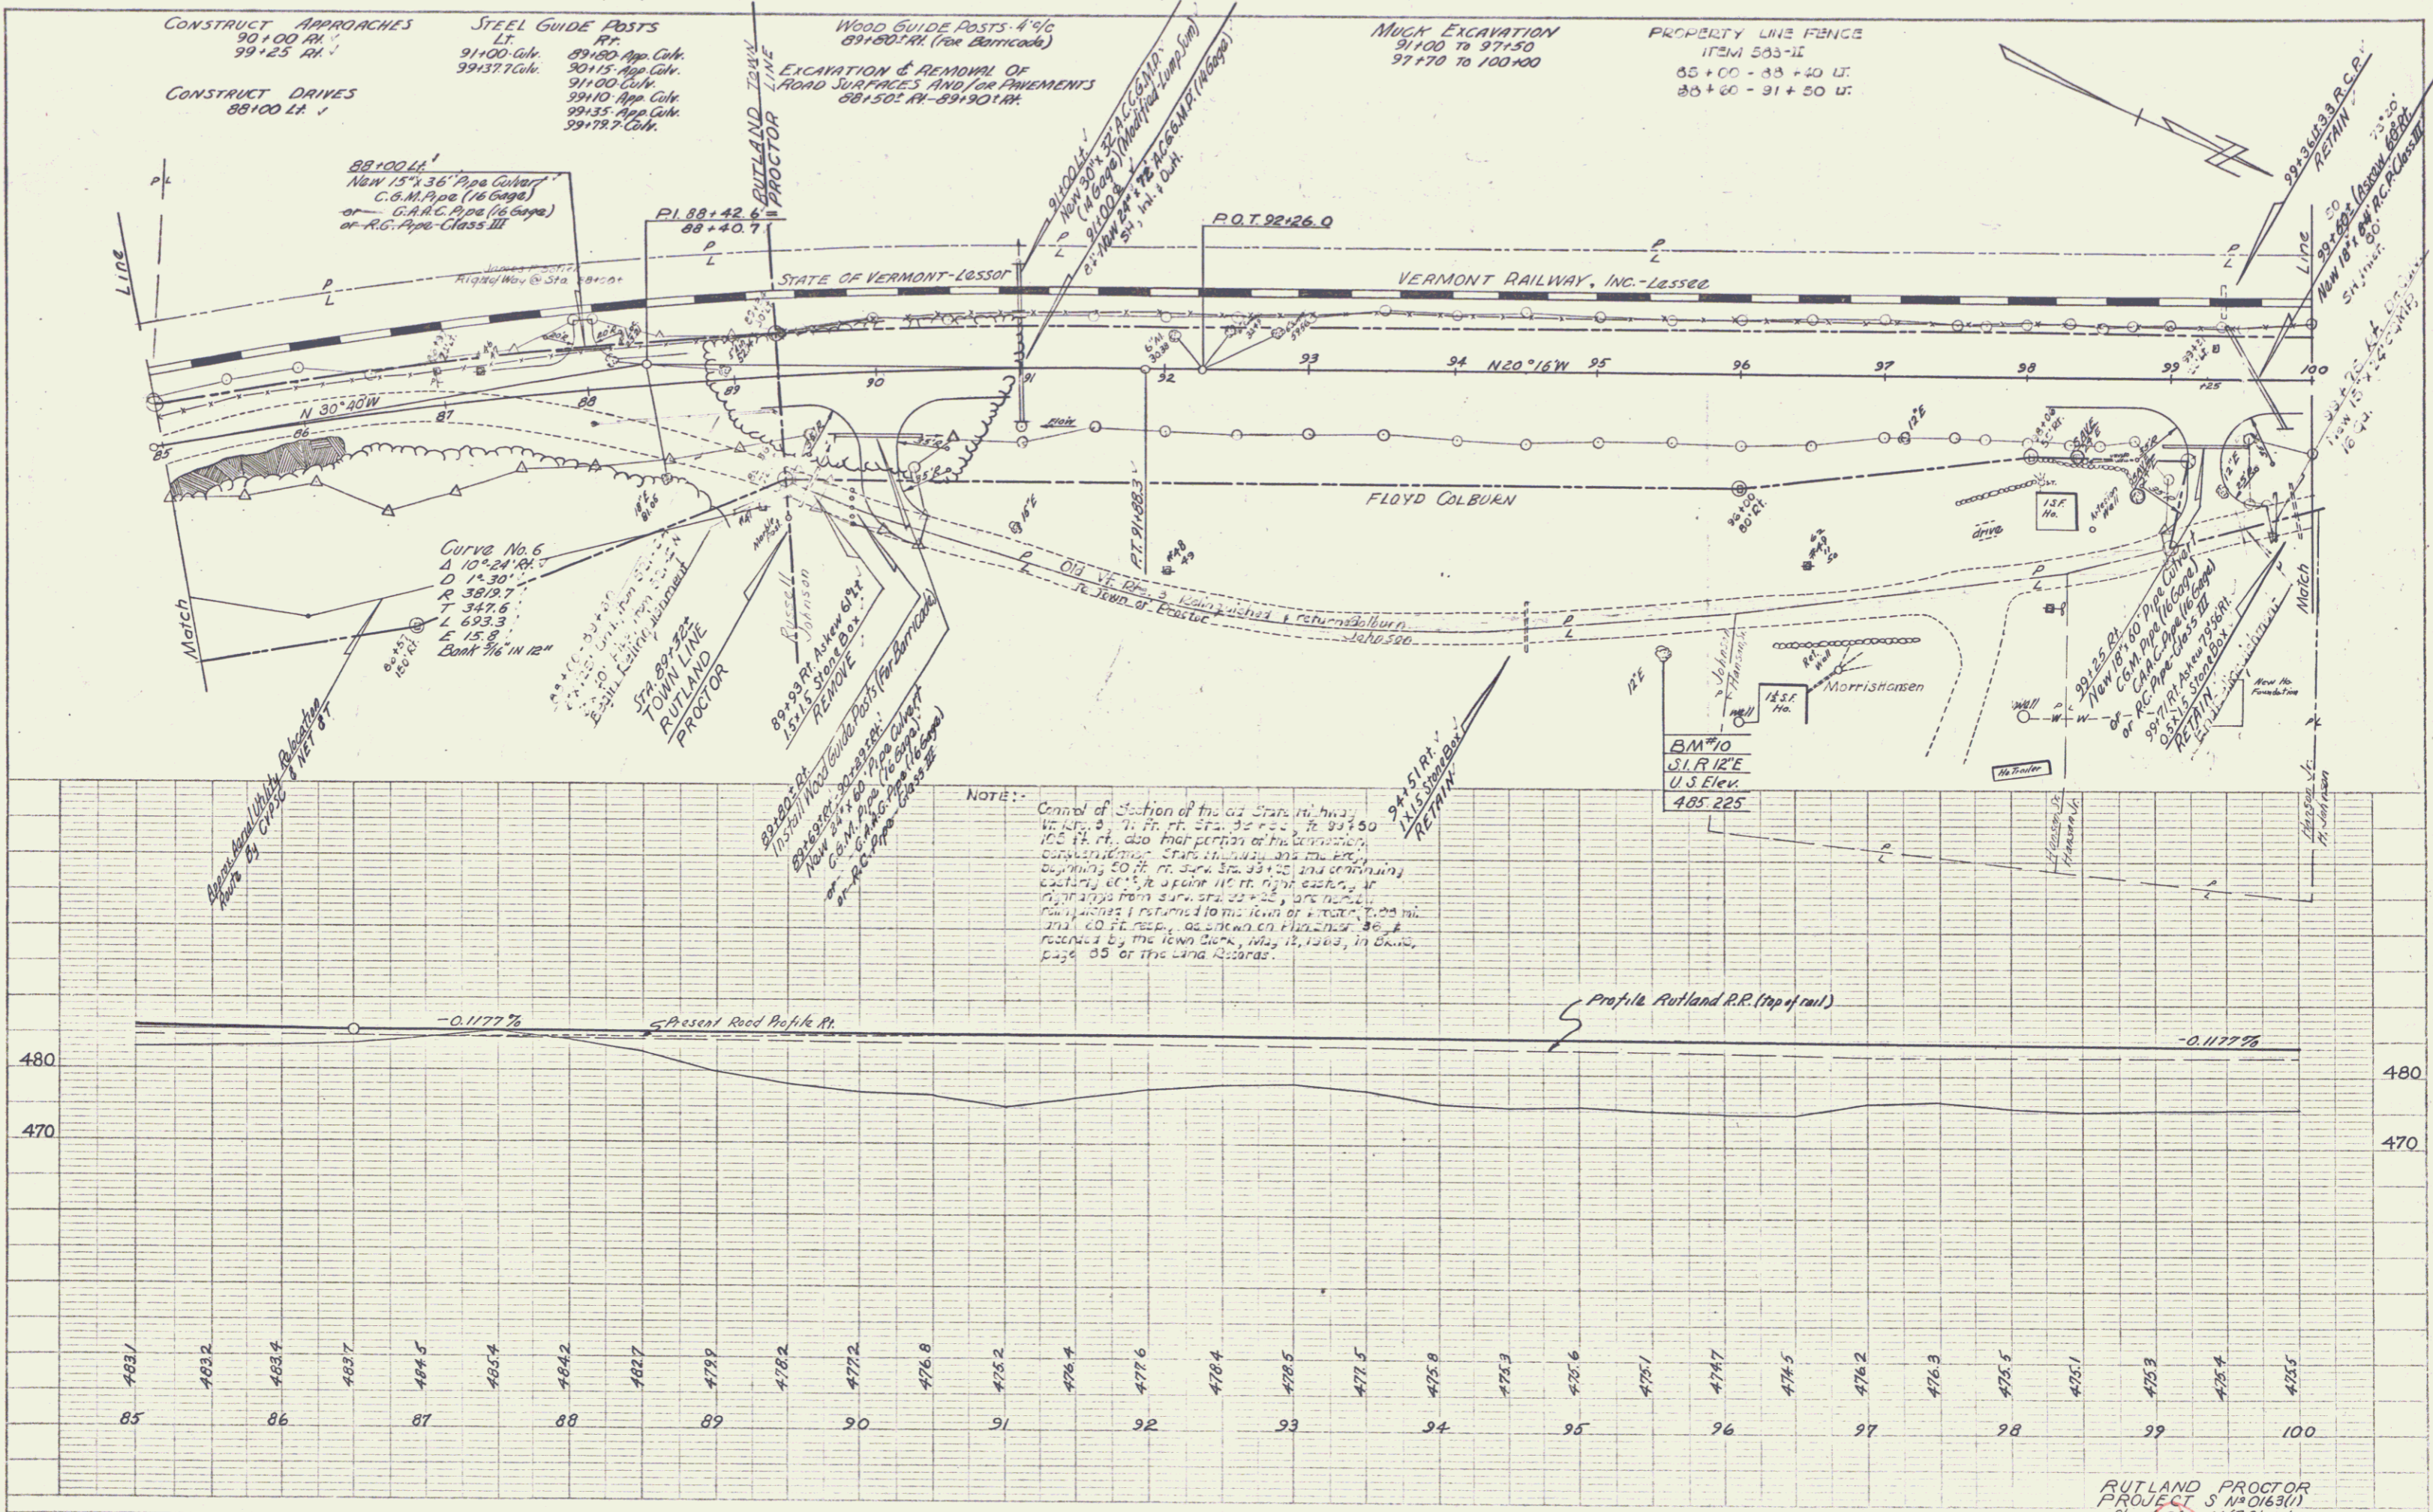

NOTE: Ground line of this section of the Rutland R.R. ... is from a 100 ft. ... section ...

RUTLAND PROCTOR
 PROJECT S No 0163(1)
 Sheet 36 of 143 Sheets