

PLAN
 DATE: 6-14
 DRAWN BY: E. J. Proctor
 CHECKED BY: E. J. Proctor
 PROJECT NO. 11433

PROFILE
 DATE: 6-14
 DRAWN BY: E. J. Proctor
 CHECKED BY: E. J. Proctor
 PROJECT NO. 11433

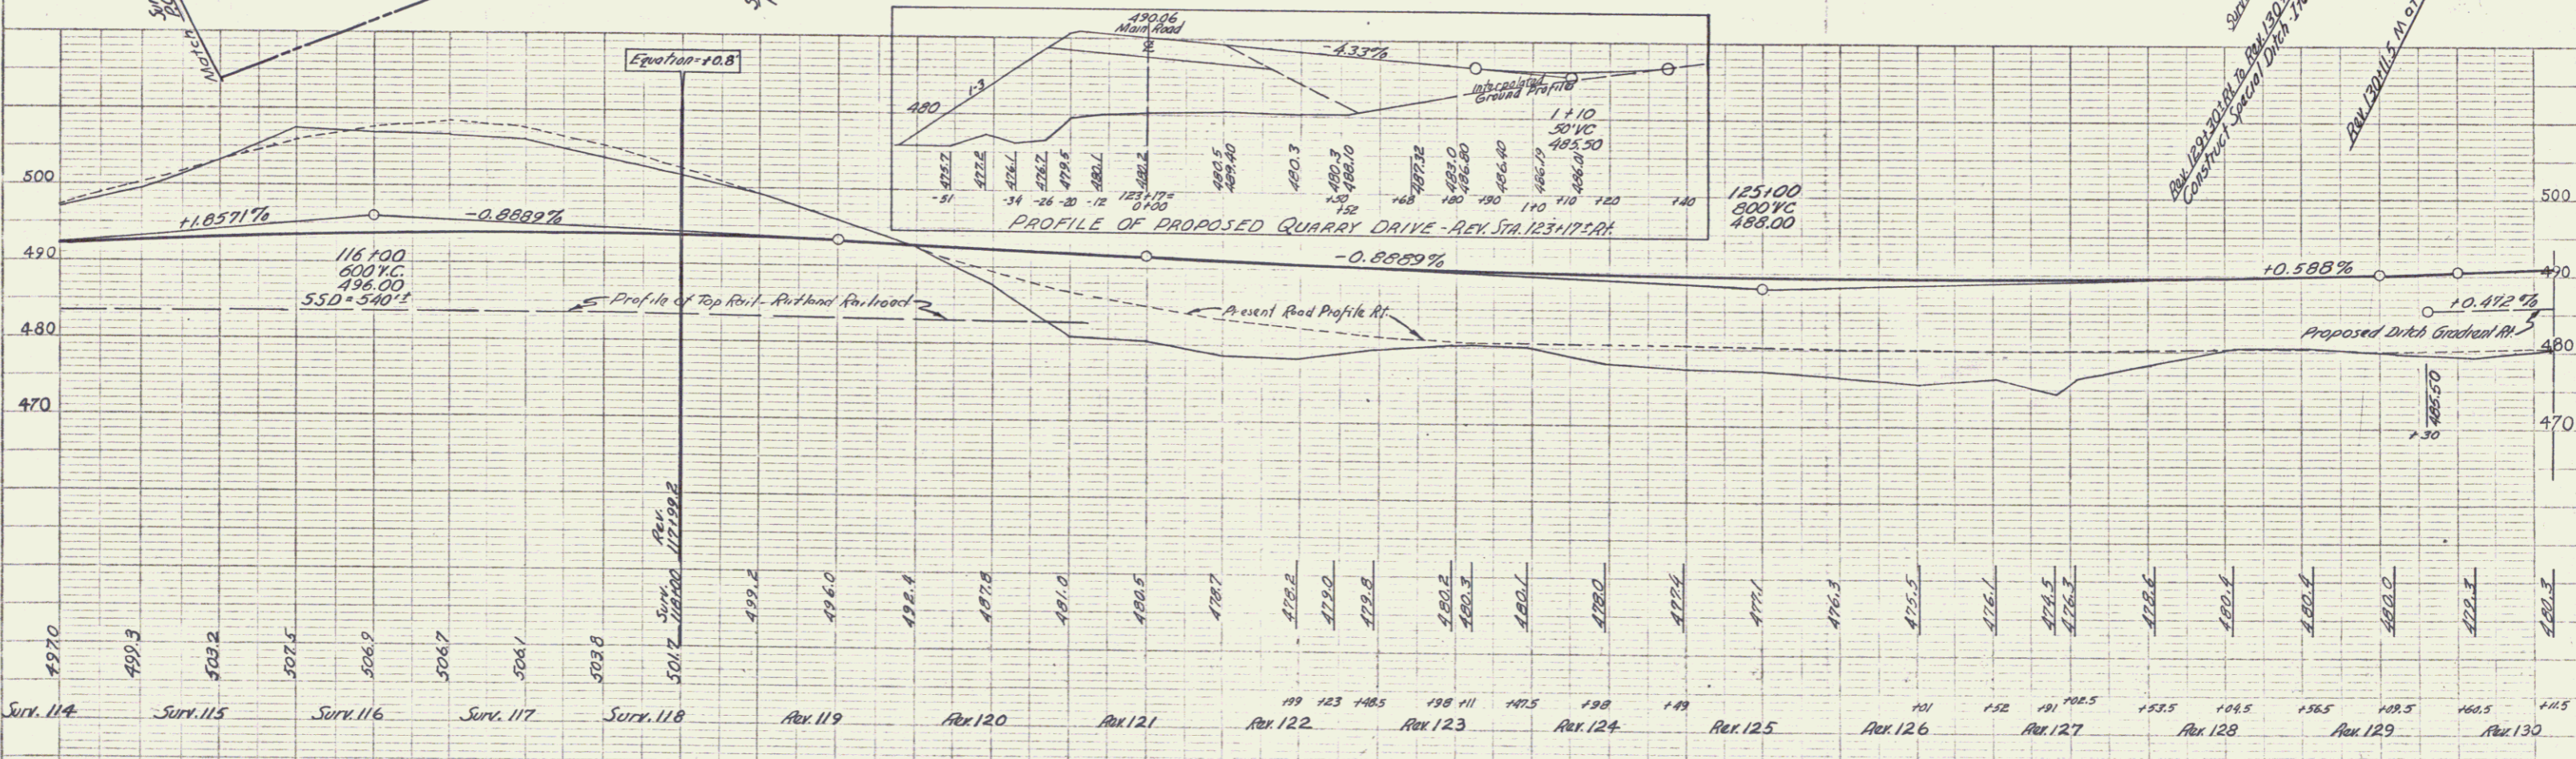


PLATE 1 PLAN 11433 OF R.R. & T. TRACKS
 6-14-14 E. J. PROCTOR

RUTLAND PROCTOR
 PROJECT NO. 11433
 Sheet 38 of 143 Sheets