
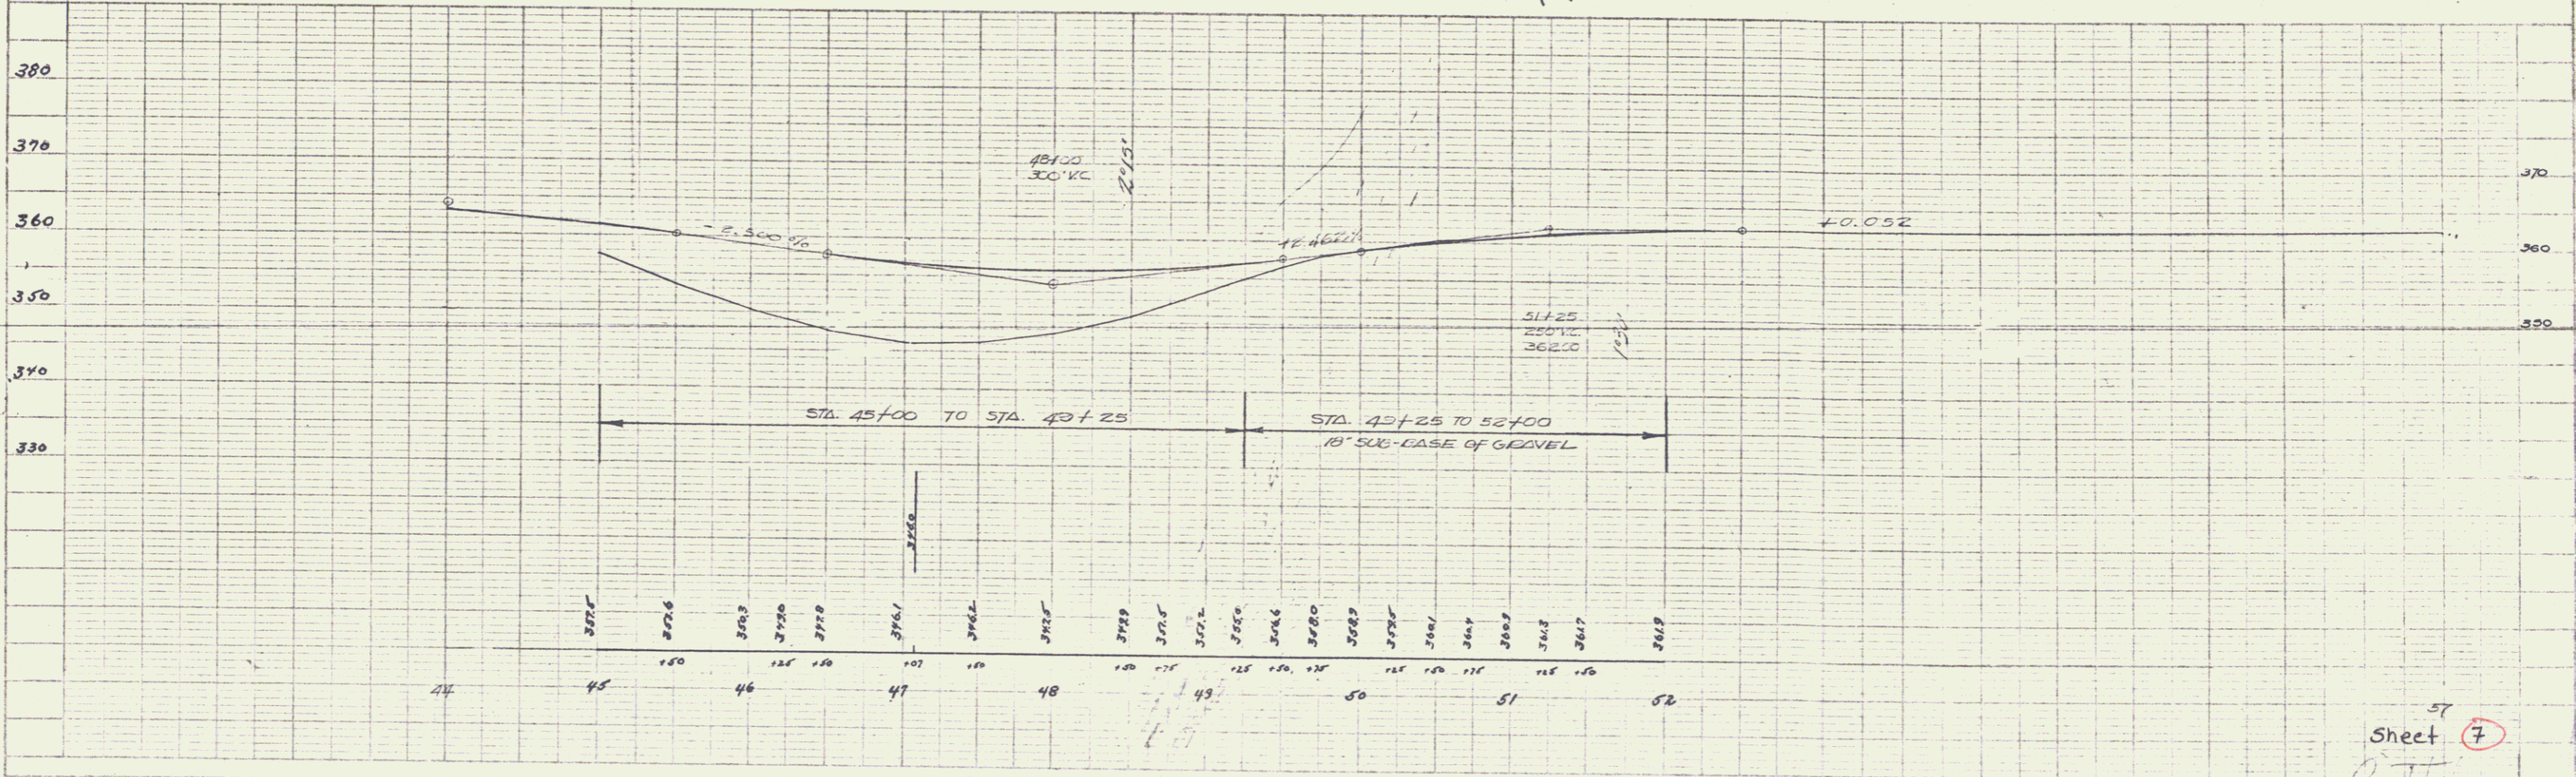


PLAN  
 DRAWN BY: P. J. THOMAS  
 CHECKED BY: P. J. THOMAS  
 DATE: 10/1/57  
 PROJECT: 10' WIDE DRIVEWAY

PLAN  
 DRAWN BY: P. J. THOMAS  
 CHECKED BY: P. J. THOMAS  
 DATE: 10/1/57  
 PROJECT: 10' WIDE DRIVEWAY

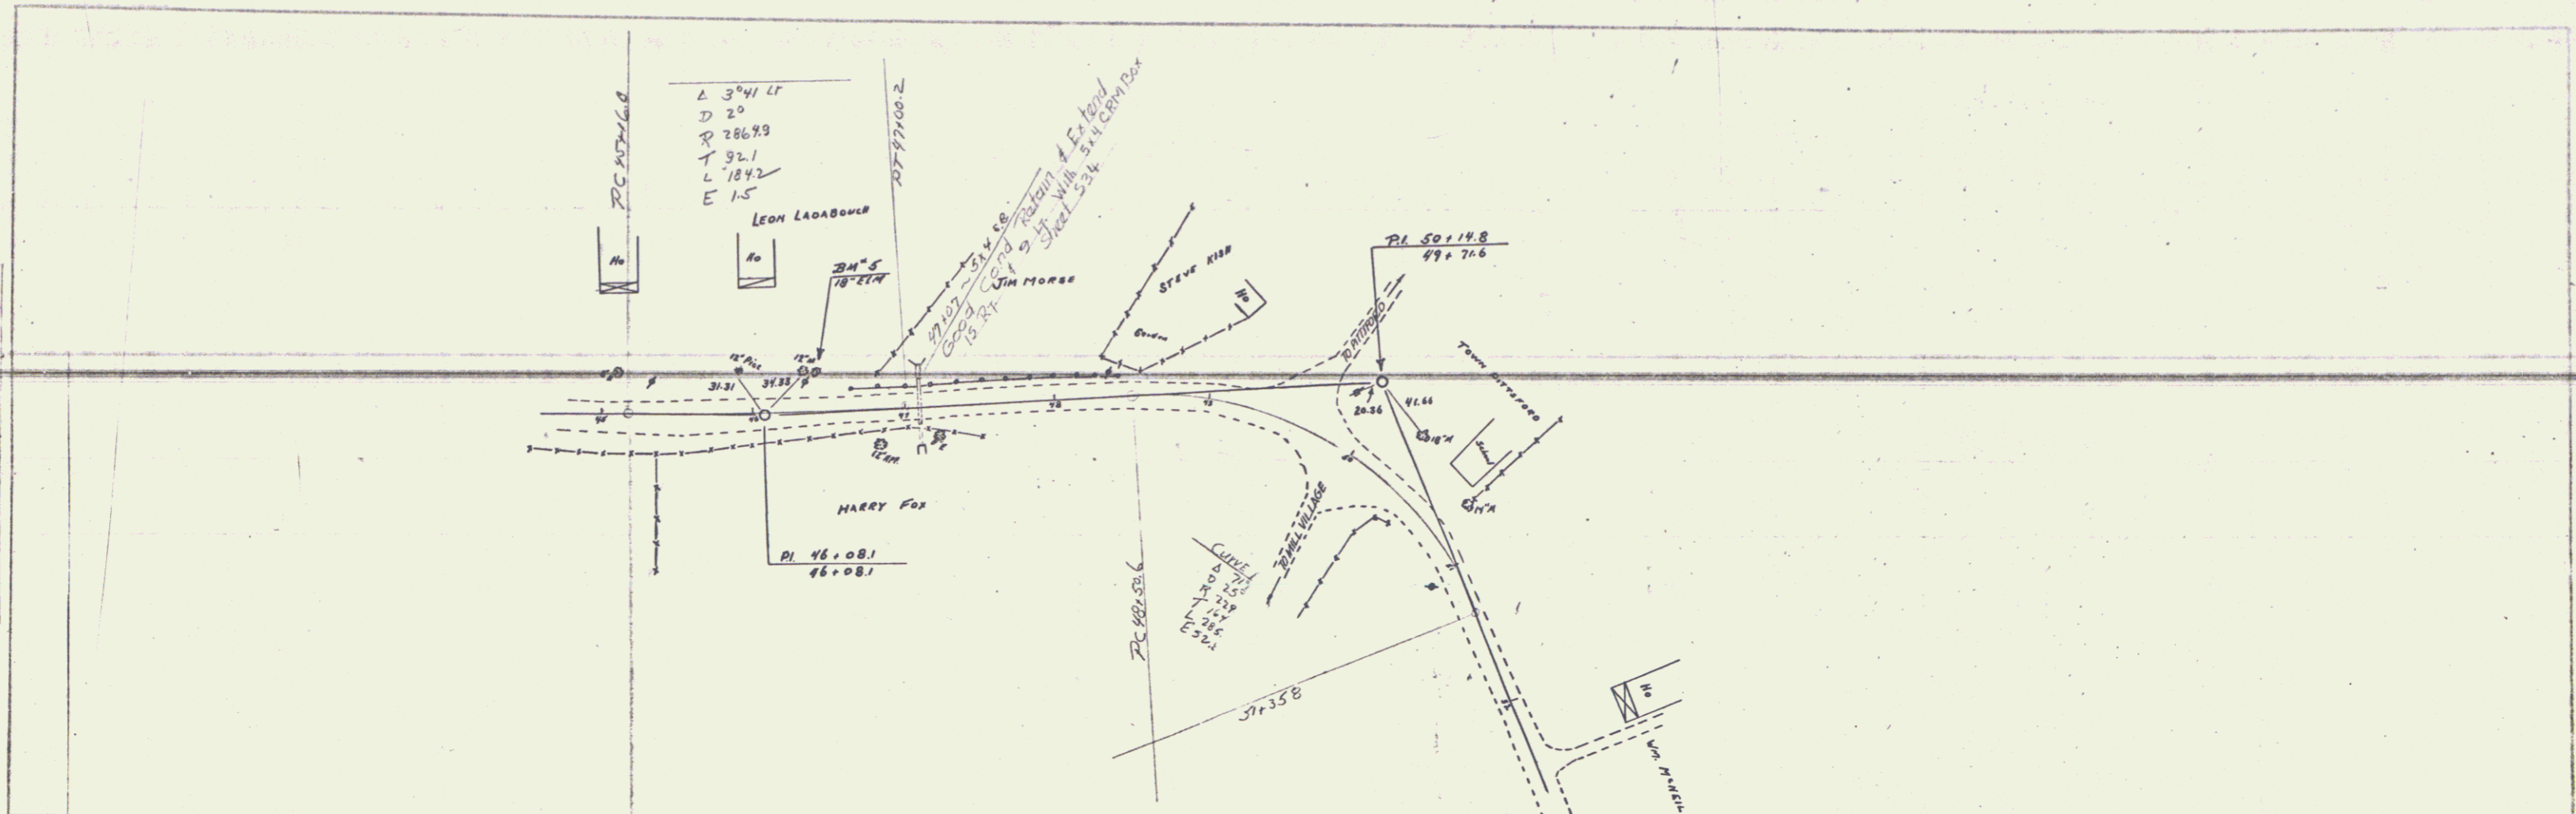

Sheet 7  
 P. J. Thomas  
 5