
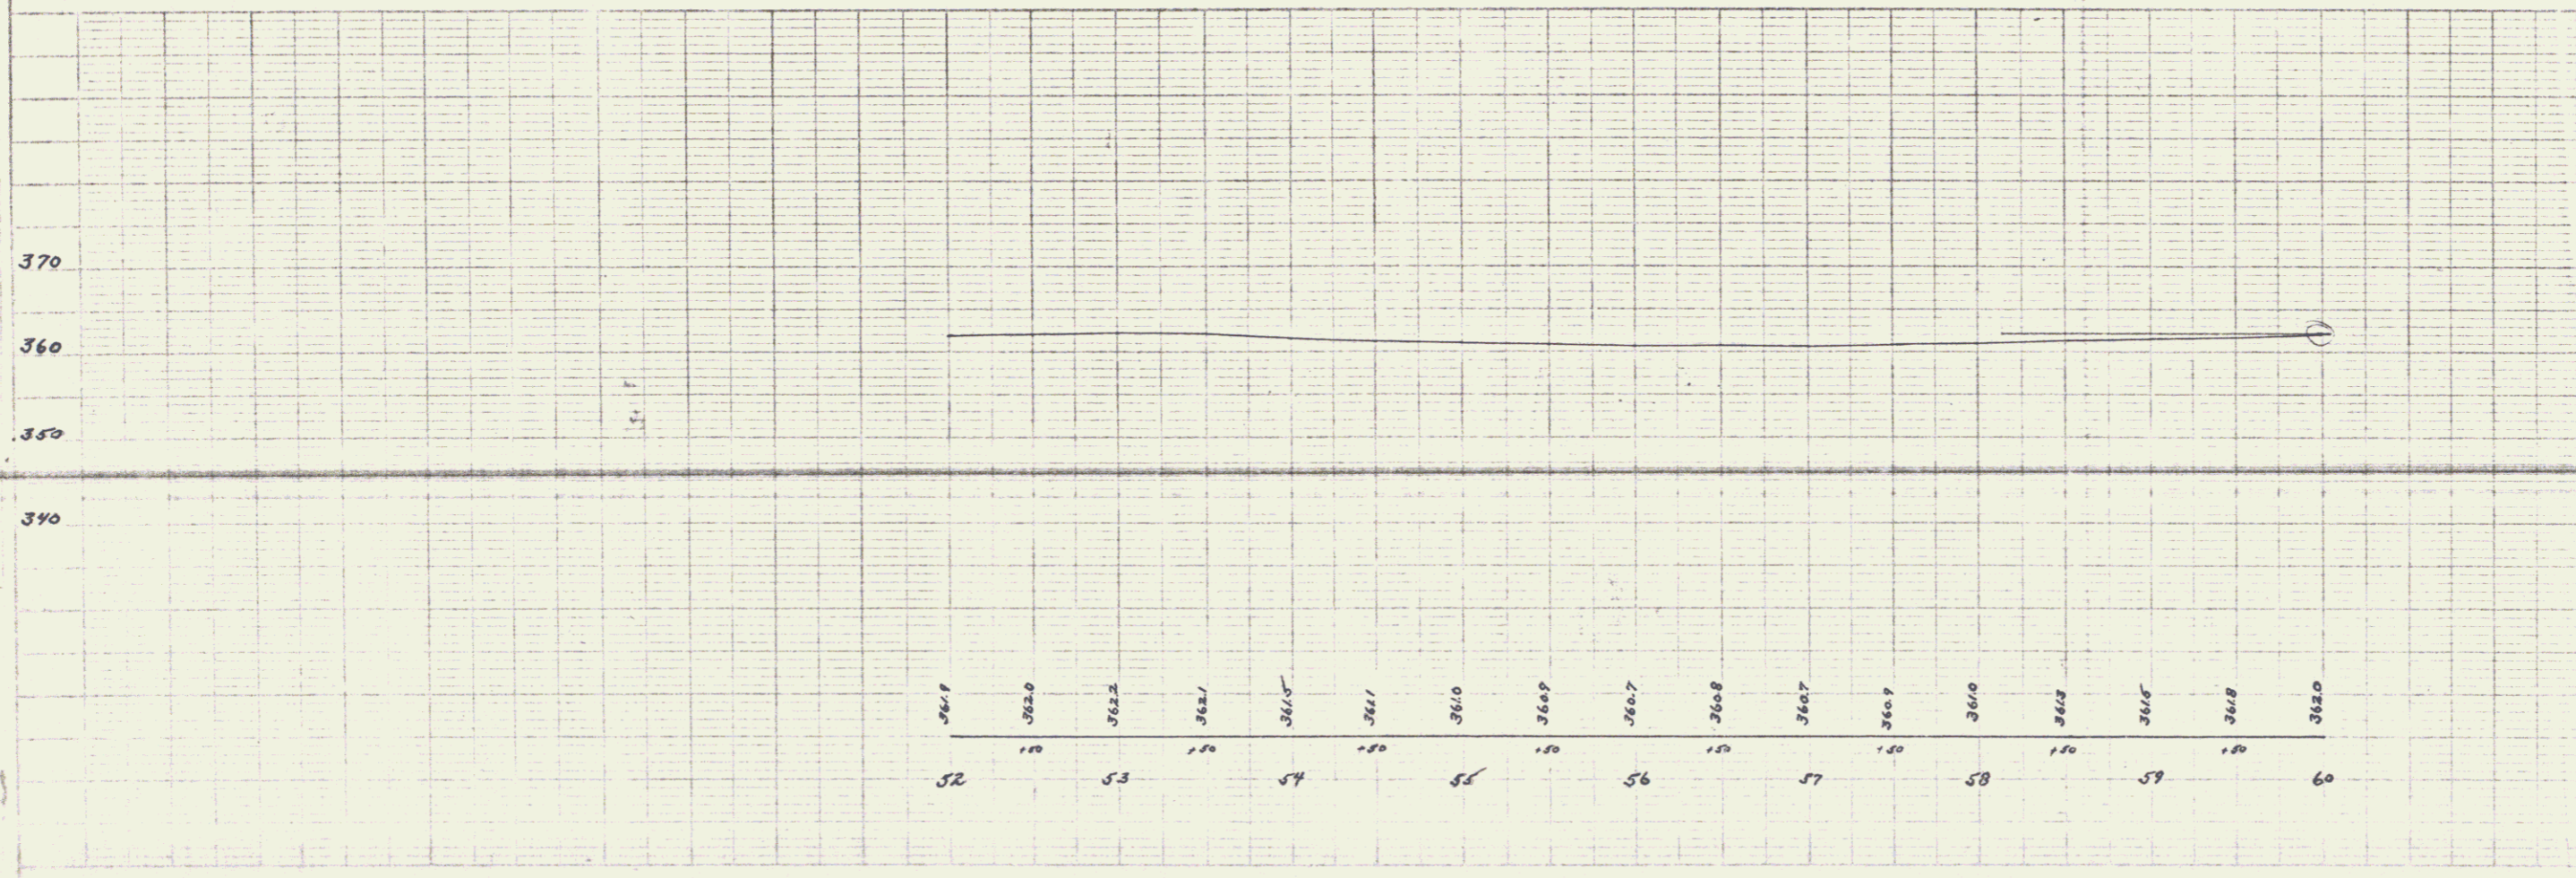


PLAN
 1/4" = 100'
 DATE 1952
 BY J. H. HARRIS

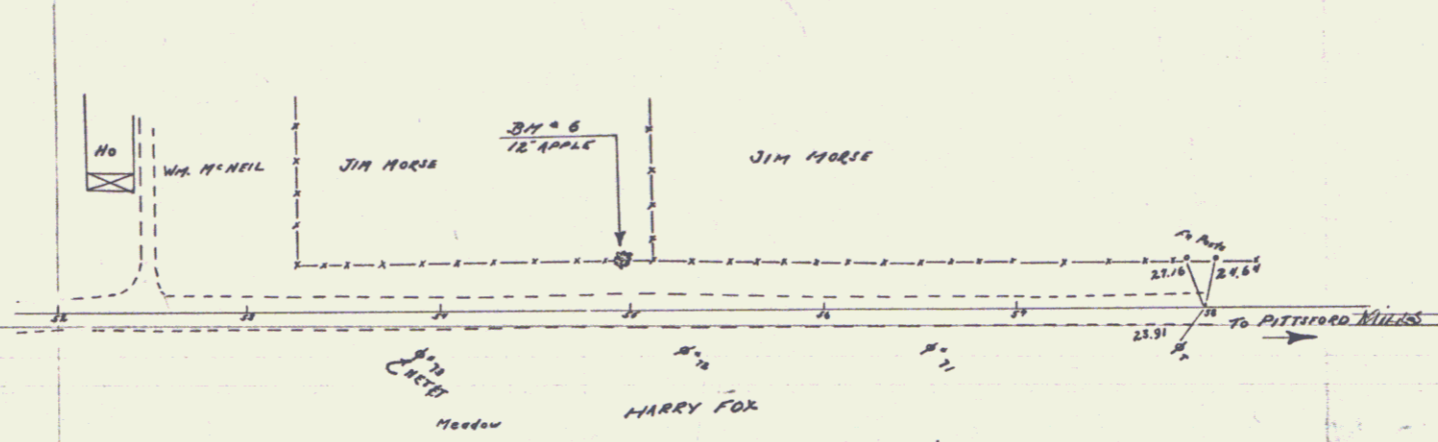

Sheet 8
 Pittsburg
 60