

Sta.	GRANITE CURB	Pos.	Length
13+00	13+00	LT	72'
13+00	13+00	RT	72'
13+00	13+00	LT	72'
13+00	13+00	RT	72'
REMOVAL & DISPOSAL OF EXISTING GUARD RAIL
 15+36 - 15+74 RT
 15+45 - 15+54 LT
 24+02 - 32+17 RT

REMOVAL OF EXISTING CONCRETE PAVEMENT
 13+00 - 29+00

TOP SOIL & SEED
 21+80 - 22+00
 22+00 - 28+50 LT


CONSTRUCT APPROACH
 Sta. 21+35, LT

CONSTRUCT DRIVES
 Sta. Pos.
 22+25 4' LT
 25+25 4' LT
 25+25 7' LT
 25+25 7' LT
 27+00 6' LT

Sta.	STEEL GUIDE POSTS	LT	RT
15+45	15+45	1'	1'
15+55	15+55	1'	1'
22+25	22+25	1'	1'
23+25	23+25	1'	1'
23+25	23+25	1'	1'
23+90	23+90	1'	1'
25+25	25+25	1'	1'
25+25	25+25	1'	1'

RIGHT OF WAY NOTE
PRESENT RIGHT OF WAY
 ONE AND ONE-HALF (1 1/2) RODS DISTANT FROM THE E. OF THE EXISTING HIGHWAY BETWEEN SURVEY STATIONS 13+00 AND 18+00

NEW RIGHT OF WAY
 BACK OF PROPOSED SIDEWALK FROM SURVEY STATION 13+00 EASTERLY TO SURVEY STATION 18+00 WHICH IS FURTHER DESCRIBED AS 31'6" FROM THE ESTABLISHED E. OF HWY. PROJ. F65(11)

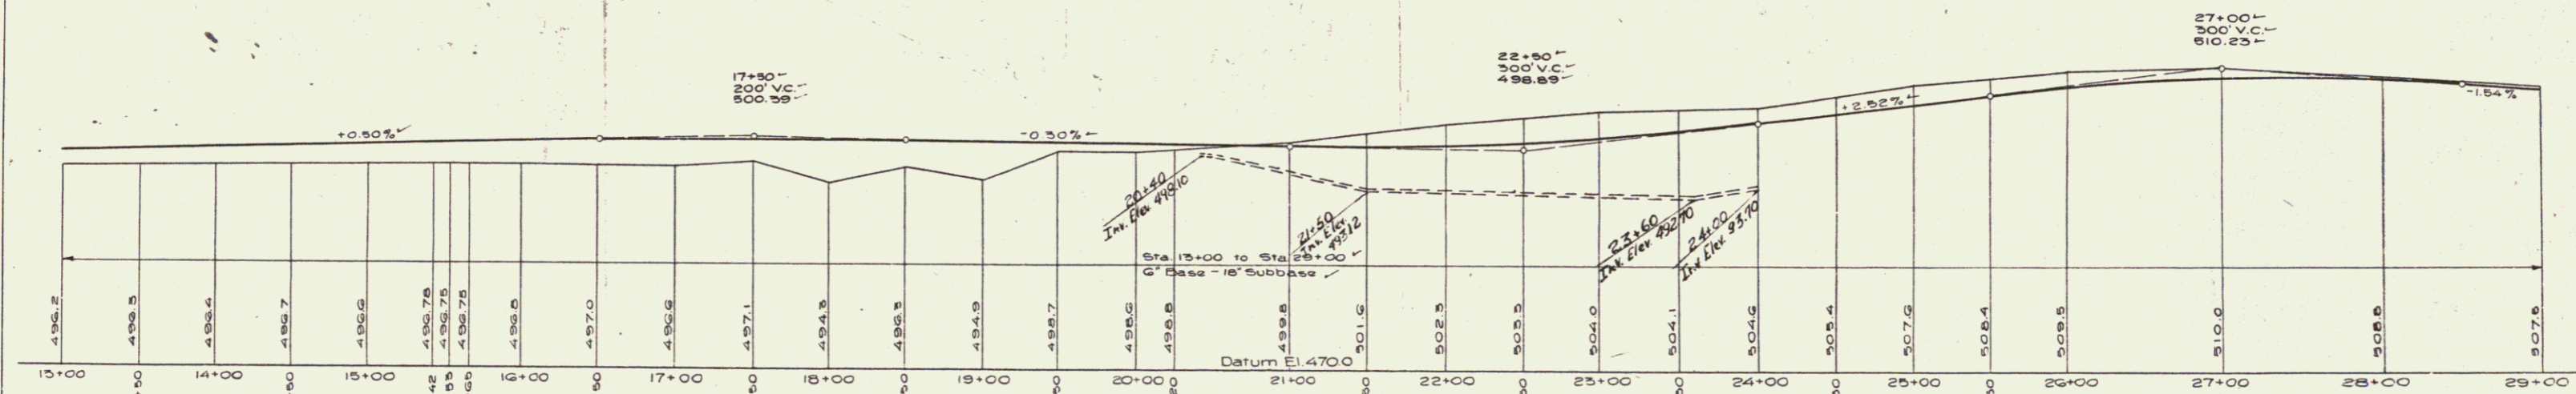

BM # 9
 EL 501.679
 10' Elm. 130' LT Sta. 15+87 El. 501.679
 10' Elm. 130' LT Sta. 22+50 El. 505.669

WEST RUTLAND - RUTLAND
 PROJECT NO. 57478-65-L
 SHEET 12 OF 141 SHEETS