

SHEET NO. INDEX OF SHEETS

# BR US 4

## STATE OF VERMONT DEPARTMENT OF HIGHWAYS

### PROPOSED IMPROVEMENT


#### TOWNS OF WEST RUTLAND & RUTLAND

#### COUNTY OF RUTLAND BR U.S. ROUTE 4 WEST RUTLAND - RUTLAND ROAD

BEGINNING AT A POINT 175 FEET WESTERLY OF THE INTERSECTION OF VERMONT ROUTE 3 AND U.S. ROUTE 4 AND EXTENDING EASTERLY 11,076 FEET TO A POINT 352 FEET EASTERLY OF THE INTERSECTION OF VERMONT ROUTE 3 AND U.S. ROUTE 4.

LENGTH OF ROADWAY 10737.90 FEET = 2.037 MILES  
(DEDUCTING RR CROSSINGS)


LENGTH OF BRIDGES 263.16 FEET = 0.050 MILES  
LENGTH OF PROJECT 11020.96 FEET = 2.087 MILES

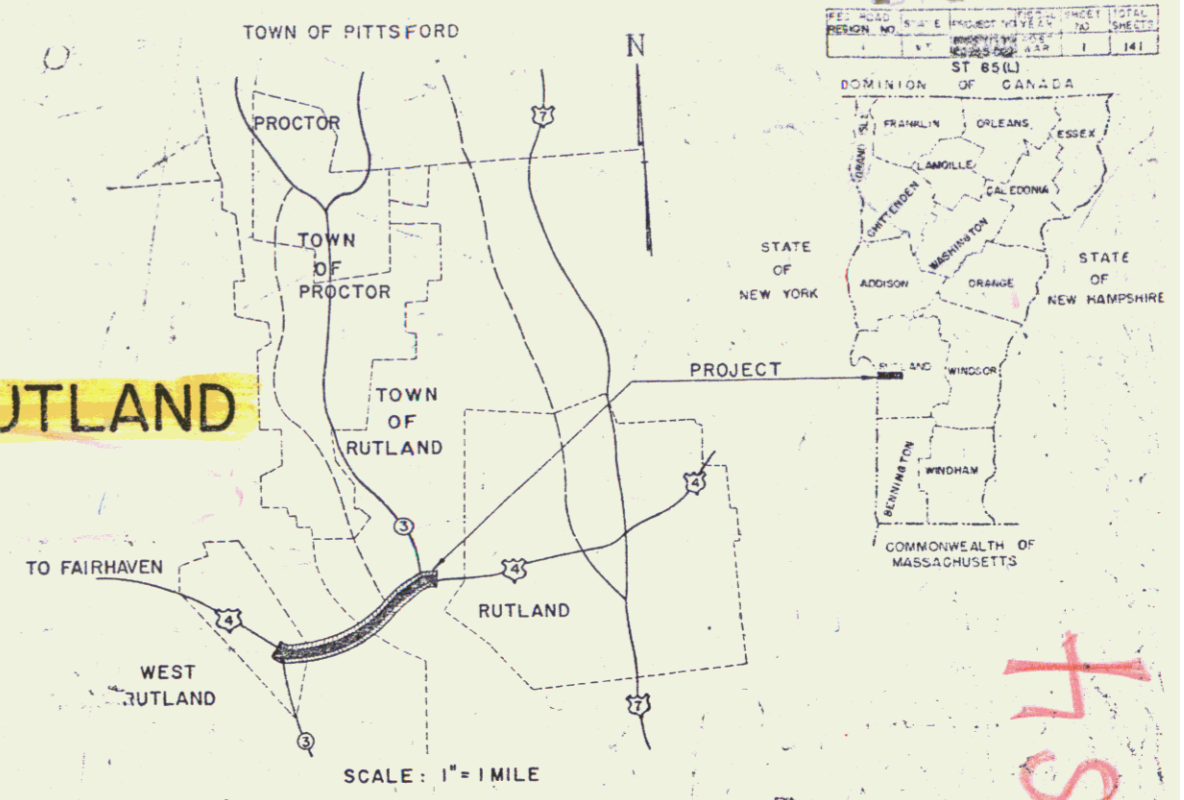

- 1 - TITLE PAGE
- 2 - PROPERTY PLAN
- 3 - TYPICAL CROSS-SECTION OF IMPROVEMENT (2 1/2" BITUMINOUS CONCRETE PAVEMENT-ITEM-361B)
- 4-5 - QUANTITY SHEET (ITEMS)
- 6 - QUANTITY SHEET (DRAINAGE)
- 7-10 - EARTHWORK SHEETS
- 11-19 - PLAN AND PROFILE SHEETS
- 20 - CONSTRUCTION DETAILS (MEDIAN STRIP, MOUNTABLE CURB, METAL END SECTIONS)
- 21-32 - BRIDGE SHEETS (RIVER AND CREEK)
- 32-A & 32-B - PRELIMINARY INFORMATION SHEETS FOR BRIDGES
- 33 - ROADWAY STANDARD SHEET RS 56-1 (BANKING TABLES)
- 34 - ROADWAY STANDARD SHEET RS 56-2 (DROP INLETS)
- 35 - ROADWAY STANDARD SHEET RS 56-3 (MARKERS)
- 36 - ROADWAY STANDARD SHEET RS 56-4 (DRAINAGE)
- 37 - ROADWAY STANDARD SHEET RS 56-5 (CONC. CURB, GRAN. CURB, CONC. S.W.)
- 38 - ROADWAY STANDARD SHEET RS 56-6 (TYPICAL GRADING & TURNOUTS)
- 39 - ROADWAY STANDARD SHEET RS 56-7 (CONC. CATCH BASINS OR M.H.)
- 39-A - 39-B - FLASHING LIGHT SIGNALS STA. 20+79.4 & 89+34
- 40 - TYPICAL SECTION AND PLAN (CLARENDON AND PITTSFORD R.R. CROSSING)
- 40-A - WIRING DIAGRAMS CLARENDON AND PITTSFORD R.R. CROSSING
- 40-B - TYPICAL SECTION AND PLAN (DELAWARE AND HUDSON R.R. CROSSING)
- 40-C - WIRING DIAGRAMS DELAWARE AND HUDSON R.R. CROSSING
- 41 - ROADWAY STANDARD SHEET RS 56-11 (THREE RAIL GUARD RAIL WITH STEEL POSTS)
- 42 - ROADWAY STANDARD SHEET RS 56-12 (BARRICADES, SIGNS, & LIGHTS)
- 43-117 - CROSS SECTIONS
- 118-122 - CHANNEL SECTIONS

#### RAILROAD OVERPASS

- 123 - LOCATION PLAN & BORING LOG
- 124 - FRAMING PLAN
- 125-126 - SUPERSTRUCTURE DETAILS
- 127 - PILING PLAN
- 128 - NORTH ABUTMENT
- 129 - SOUTH ABUTMENT
- 130-134 - FALSEWORK PLANS & DETAILS
- 135-141 - CROSS SECTIONS

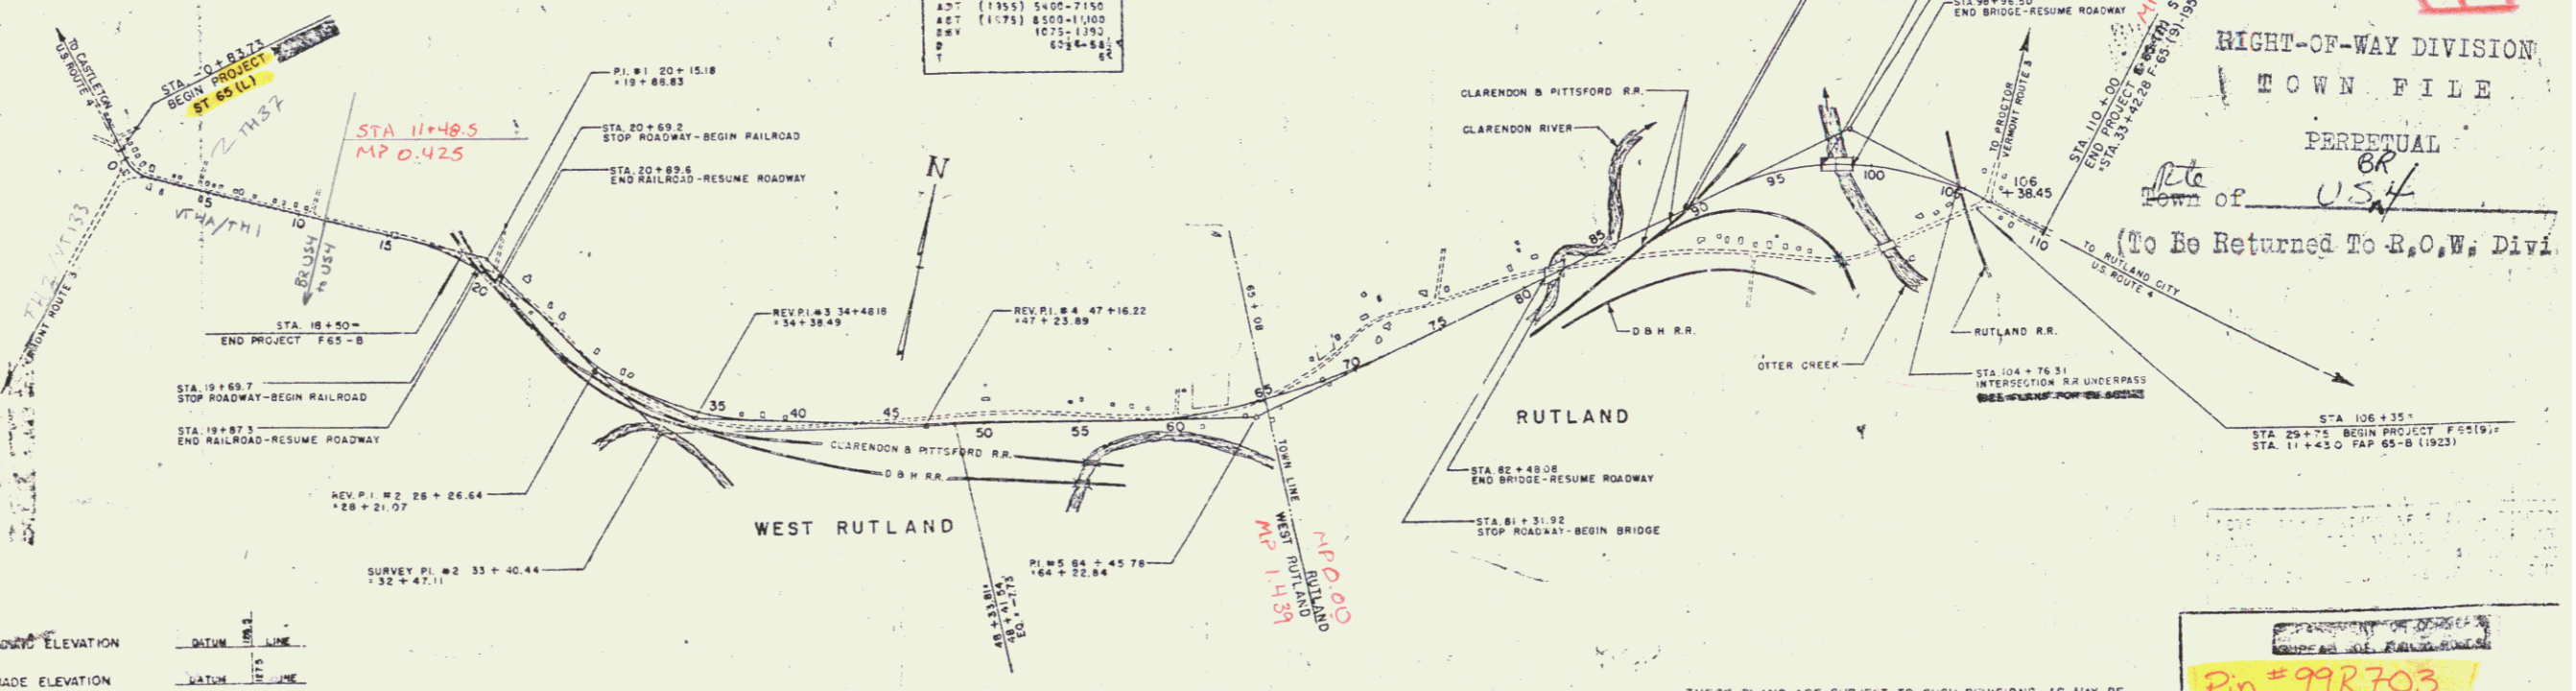

DESIGN DESIGNATION	
A-1	(135) 5400-7150
A-2	(175) 8500-1100
B-1	(175) 1075-1190
P	424-434

COUNTY OF RUTLAND  
TOWN LINE  
TOWN OF WEST RUTLAND  
TOWN OF RUTLAND  
STATE OF VERMONT  
DEPARTMENT OF HIGHWAYS  
PROJECT: WEST RUTLAND - RUTLAND ROAD  
DATE: OCTOBER 15, 1957

GRADE ELEVATION	DRAW	DATE
11+48.5	11/15/57	MP 0.425
18+50	11/15/57	MP 0.425
18+71	11/15/57	MP 0.425
20+79.4	11/15/57	MP 0.425
89+34	11/15/57	MP 0.425
106+35	11/15/57	MP 0.425

CURVE DATA	
DEFLECTION OF ANGLE	D
DEGREE OF CURVE	D
RADIUS OF CURVE	R
TANGENT DISTANCE	T
LENGTH OF CURVE	L
EXTERNAL DISTANCE	E
POINT OF INTERSECTION	PI
POINT OF CURVE	PC
POINT OF TANGENT	PT
POINT ON TANGENT	POT
POINT ON SUB-TANGENT	POT
POINT OF COMMENCEMENT	PC

SCALES	
TITLE	1" = 500'
TYPICAL	1" = 4'
PLAN	1" = 50' & 20'
PROFILE	HORIZONTAL 1" = 10'
CROSS-SECTIONS	1" = 5' & 10'

PREPARED AND RECOMMENDED:  
WILLIAM H. McFARLAND CONSULTING ENGINEER  
STATE OF VERMONT, LICENSE NO. 422  
DATE: OCTOBER 15, 1957

APPROVED: [Signatures] DATE: OCTOBER 15, 1957


THESE PLANS ARE SUBJECT TO SUCH REVISIONS AS MAY BE REQUIRED BY THE COMMISSIONER OF HIGHWAYS.  
CONSTRUCTION IS TO BE CARRIED ON IN ACCORDANCE WITH THE PLANS AND THE STANDARD SPECIFICATIONS FOR HIGHWAY AND BRIDGE CONSTRUCTION OF JANUARY 1955, WITH THE EXCEPTION OF THE SPECIFICATIONS FOR BRIDGES AS SUPERSEDED BY THIS ORDER, INCLUDING ALL SUBSEQUENT APPROVED REVISIONS AND SUCH REVISED SPECIFICATIONS AND SPECIAL PROVISIONS AS ARE SUBMITTED WITH THE PLANS.

Pin # 99R703

APPROVED: [Signatures] DATE: OCTOBER 15, 1957


Sheet 1



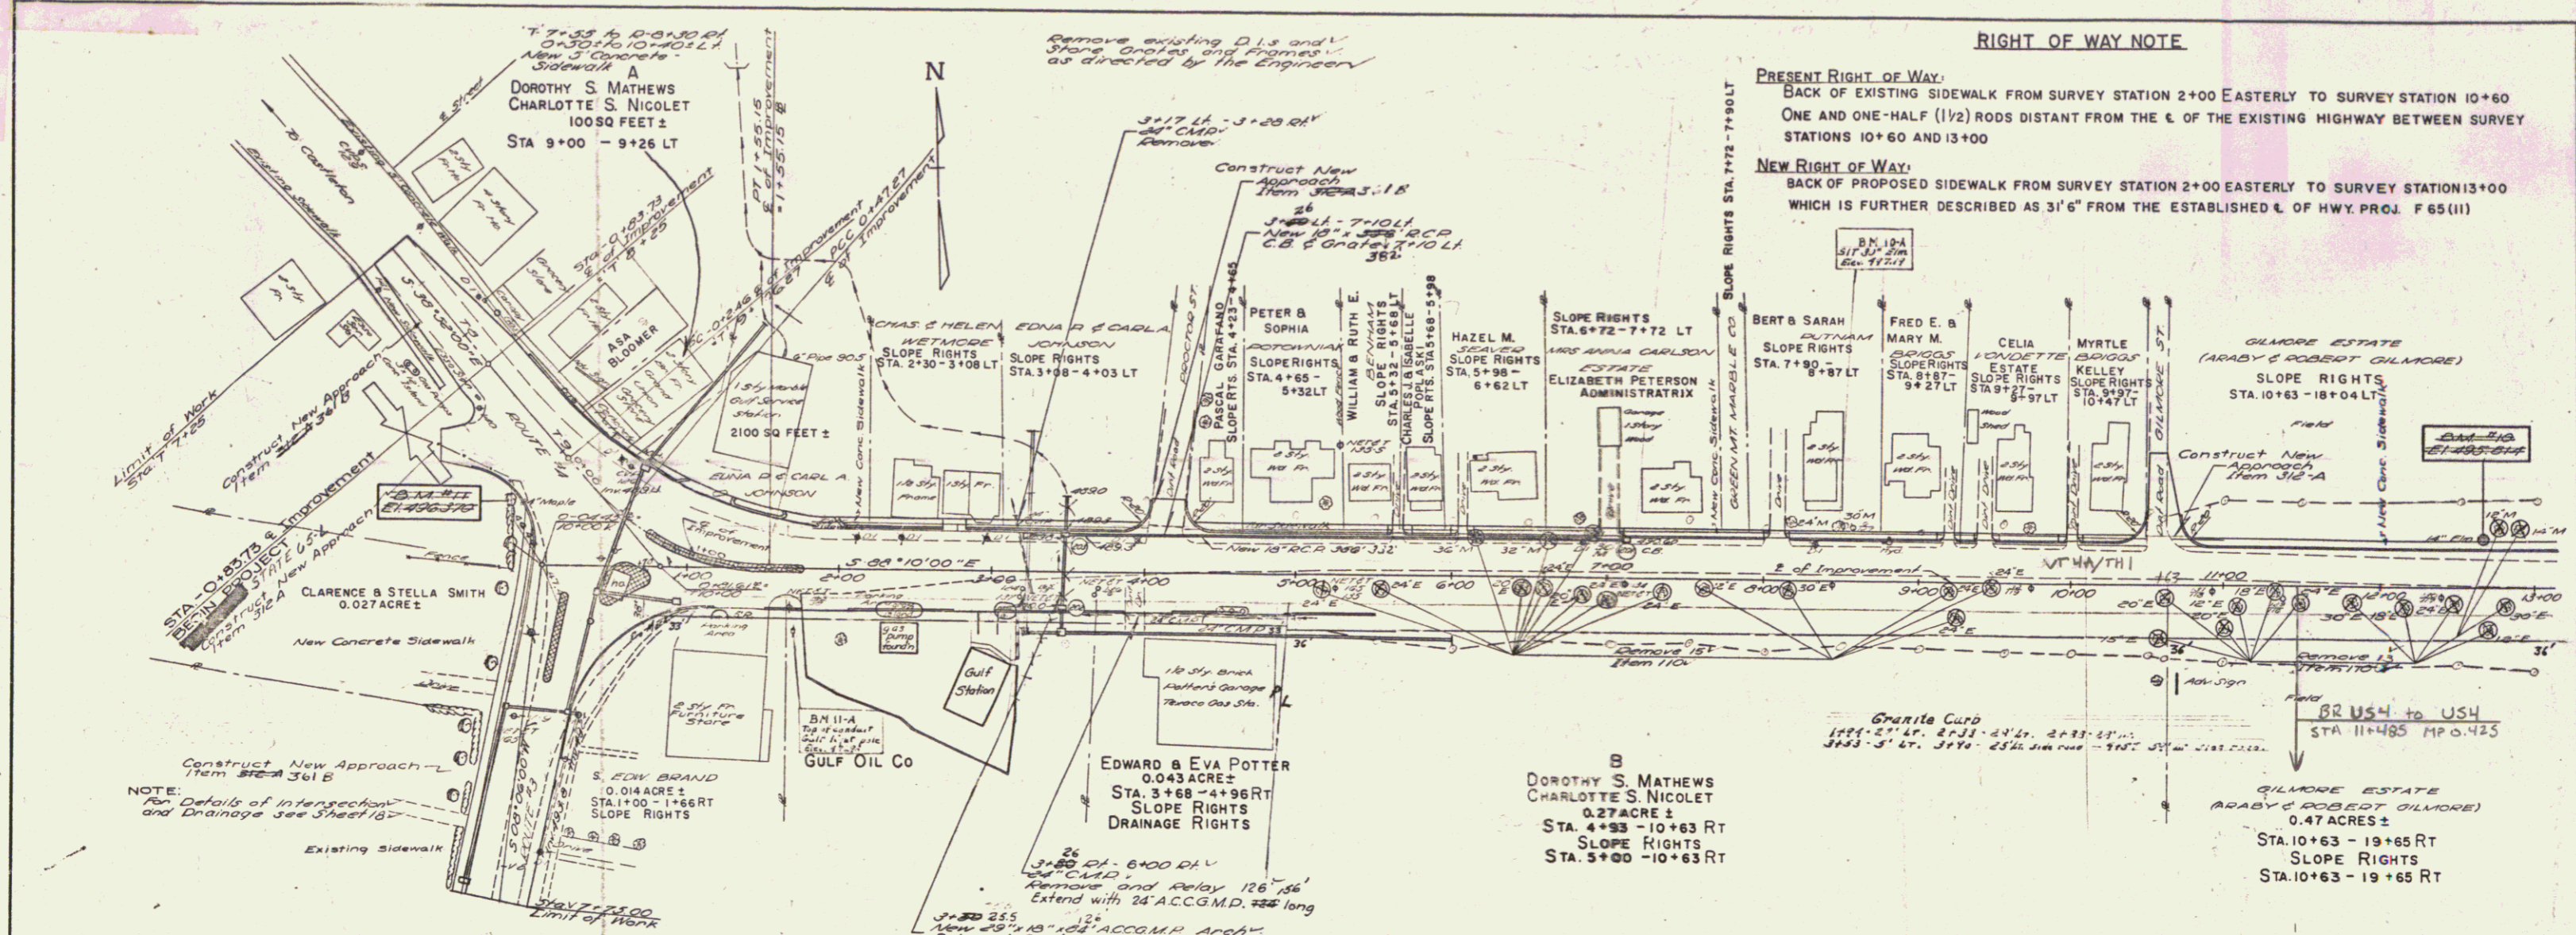

NOTE: For Details of Intersection and Drainage see Sheet 18


OF IMPROVEMENT	See
D	10
T	18
L	18
N	18

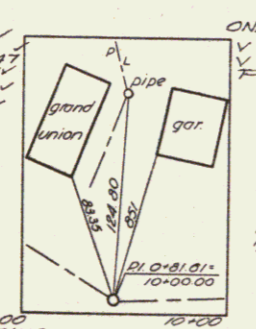



ONE COURSE CEMENT CONCRETE SIDEWALK - 5"	DRIVE RAMP
9+48.07	10+23.51
10+48.65	11+53.80
11+48.24	12+23.81
12+48.70	13+23.58
13+48.24	14+23.51
14+48.70	15+23.51
15+48.24	16+23.51
16+48.70	17+23.51
17+48.24	18+23.51
18+48.70	19+23.51
19+48.24	20+23.51
20+48.70	21+23.51
21+48.24	22+23.51
22+48.70	23+23.51
23+48.24	24+23.51
24+48.70	25+23.51
25+48.24	26+23.51
26+48.70	27+23.51
27+48.24	28+23.51
28+48.70	29+23.51
29+48.24	30+23.51
30+48.70	31+23.51
31+48.24	32+23.51
32+48.70	33+23.51
33+48.24	34+23.51
34+48.70	35+23.51
35+48.24	36+23.51
36+48.70	37+23.51
37+48.24	38+23.51
38+48.70	39+23.51
39+48.24	40+23.51
40+48.70	41+23.51
41+48.24	42+23.51
42+48.70	43+23.51
43+48.24	44+23.51
44+48.70	45+23.51
45+48.24	46+23.51
46+48.70	47+23.51
47+48.24	48+23.51
48+48.70	49+23.51
49+48.24	50+23.51
50+48.70	51+23.51
51+48.24	52+23.51
52+48.70	53+23.51
53+48.24	54+23.51
54+48.70	55+23.51
55+48.24	56+23.51
56+48.70	57+23.51
57+48.24	58+23.51
58+48.70	59+23.51
59+48.24	60+23.51
60+48.70	61+23.51
61+48.24	62+23.51
62+48.70	63+23.51
63+48.24	64+23.51
64+48.70	65+23.51
65+48.24	66+23.51
66+48.70	67+23.51
67+48.24	68+23.51
68+48.70	69+23.51
69+48.24	70+23.51
70+48.70	71+23.51
71+48.24	72+23.51
72+48.70	73+23.51
73+48.24	74+23.51
74+48.70	75+23.51
75+48.24	76+23.51
76+48.70	77+23.51
77+48.24	78+23.51
78+48.70	79+23.51
79+48.24	80+23.51
80+48.70	81+23.51
81+48.24	82+23.51
82+48.70	83+23.51
83+48.24	84+23.51
84+48.70	85+23.51
85+48.24	86+23.51
86+48.70	87+23.51
87+48.24	88+23.51
88+48.70	89+23.51
89+48.24	90+23.51
90+48.70	91+23.51
91+48.24	92+23.51
92+48.70	93+23.51
93+48.24	94+23.51
94+48.70	95+23.51
95+48.24	96+23.51
96+48.70	97+23.51
97+48.24	98+23.51
98+48.70	99+23.51
99+48.24	100+23.51

CONSTRUCT APPROACHES	STEEL GUIDE POST	CONSTRUCT DRIVES	GRANITE CURB
Sta. 7+75 to Sta. 10+00	3+25.5	Sta. 10+00 to Sta. 13+00	Sta. 10+63 to Sta. 19+65 RT
Sta. 10+00 to Sta. 13+00	4+24	Sta. 13+00 to Sta. 16+00	Sta. 10+63 to Sta. 19+65 RT
Sta. 13+00 to Sta. 16+00	5+23	Sta. 16+00 to Sta. 19+00	Sta. 10+63 to Sta. 19+65 RT
Sta. 16+00 to Sta. 19+00	6+22	Sta. 19+00 to Sta. 22+00	Sta. 10+63 to Sta. 19+65 RT
Sta. 19+00 to Sta. 22+00	7+21	Sta. 22+00 to Sta. 25+00	Sta. 10+63 to Sta. 19+65 RT
Sta. 22+00 to Sta. 25+00	8+20	Sta. 25+00 to Sta. 28+00	Sta. 10+63 to Sta. 19+65 RT
Sta. 25+00 to Sta. 28+00	9+19	Sta. 28+00 to Sta. 31+00	Sta. 10+63 to Sta. 19+65 RT
Sta. 28+00 to Sta. 31+00	10+18	Sta. 31+00 to Sta. 34+00	Sta. 10+63 to Sta. 19+65 RT
Sta. 31+00 to Sta. 34+00	11+17	Sta. 34+00 to Sta. 37+00	Sta. 10+63 to Sta. 19+65 RT
Sta. 34+00 to Sta. 37+00	12+16	Sta. 37+00 to Sta. 40+00	Sta. 10+63 to Sta. 19+65 RT
Sta. 37+00 to Sta. 40+00	13+15	Sta. 40+00 to Sta. 43+00	Sta. 10+63 to Sta. 19+65 RT
Sta. 40+00 to Sta. 43+00	14+14	Sta. 43+00 to Sta. 46+00	Sta. 10+63 to Sta. 19+65 RT
Sta. 43+00 to Sta. 46+00	15+13	Sta. 46+00 to Sta. 49+00	Sta. 10+63 to Sta. 19+65 RT
Sta. 46+00 to Sta. 49+00	16+12	Sta. 49+00 to Sta. 52+00	Sta. 10+63 to Sta. 19+65 RT
Sta. 49+00 to Sta. 52+00	17+11	Sta. 52+00 to Sta. 55+00	Sta. 10+63 to Sta. 19+65 RT
Sta. 52+00 to Sta. 55+00	18+10	Sta. 55+00 to Sta. 58+00	Sta. 10+63 to Sta. 19+65 RT
Sta. 55+00 to Sta. 58+00	19+09	Sta. 58+00 to Sta. 61+00	Sta. 10+63 to Sta. 19+65 RT
Sta. 58+00 to Sta. 61+00	20+08	Sta. 61+00 to Sta. 64+00	Sta. 10+63 to Sta. 19+65 RT
Sta. 91+00 to Sta. 94+00	31+97	Sta. 94+00 to Sta. 97+00	Sta. 10+63 to Sta. 19+65 RT
Sta. 94+00 to Sta. 97+00	32+96	Sta. 97+00 to Sta. 100+00	Sta. 10+63 to Sta. 19+65 RT
Sta. 97+00 to Sta. 100+00	33+95		
Sta. 100+00 to Sta. 103+00	34+94		
Sta. 103+00 to Sta. 106+00	35+93		
Sta. 298+00 to Sta. 301+00	100+28		


REMOVAL OF EXISTING CONCRETE PAVEMENT
0+33.73 - 13+00

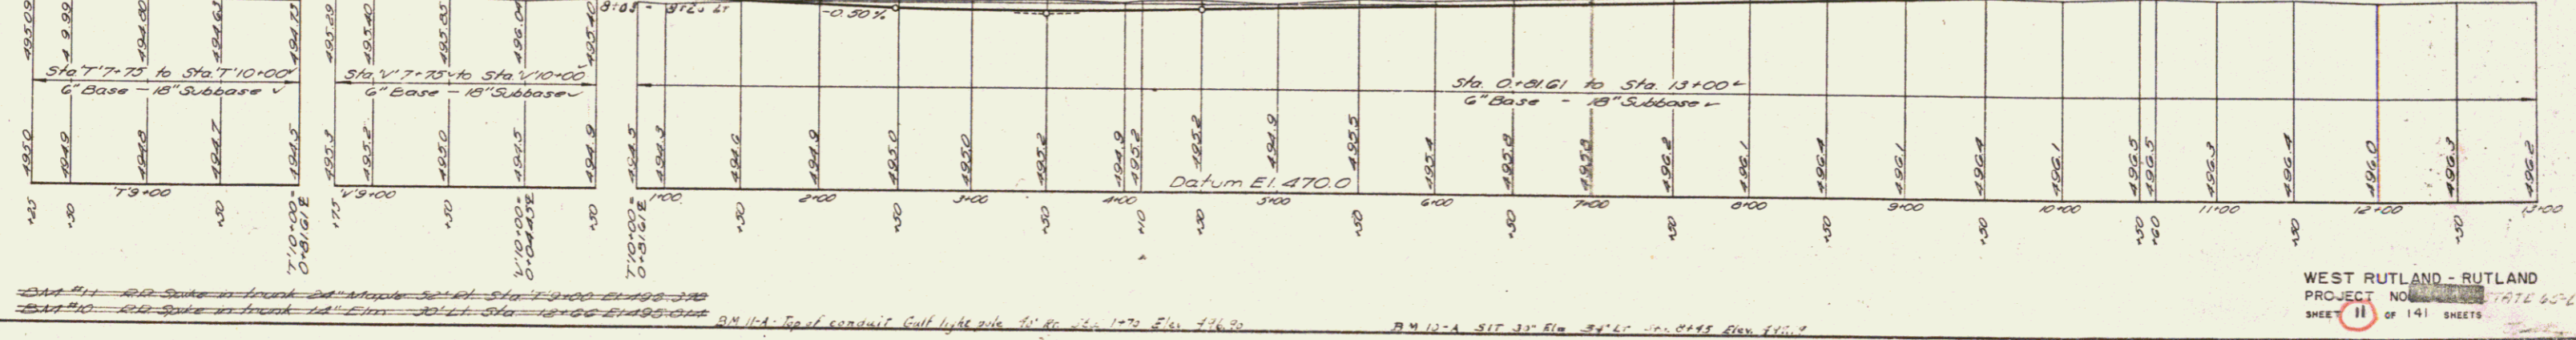



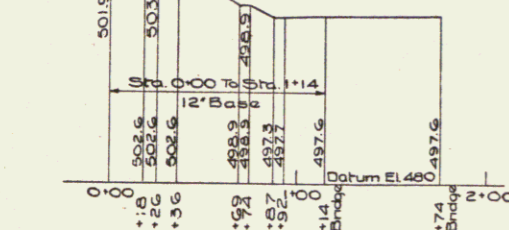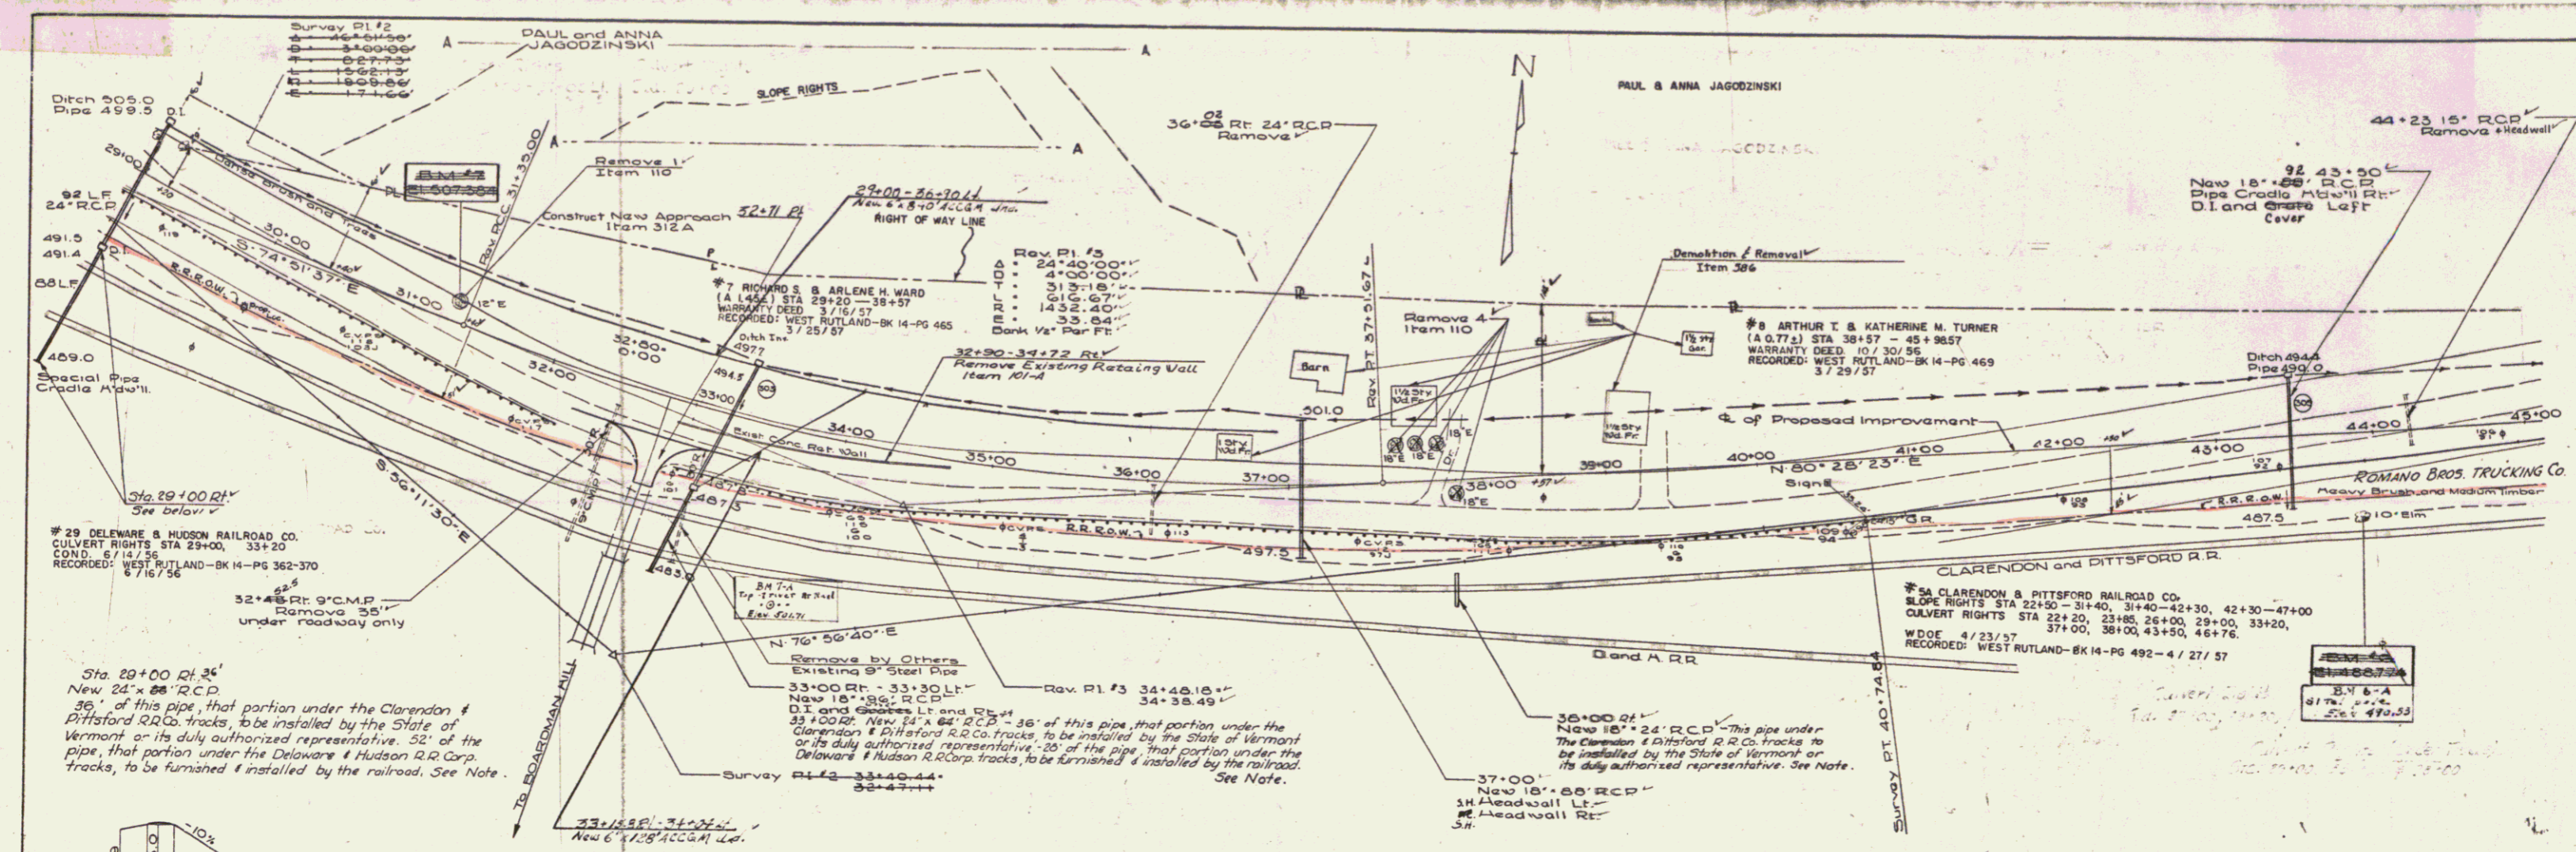

PROFILE OF NEW INTERSECTION  
STA. 32+80=0+00 ON RT.

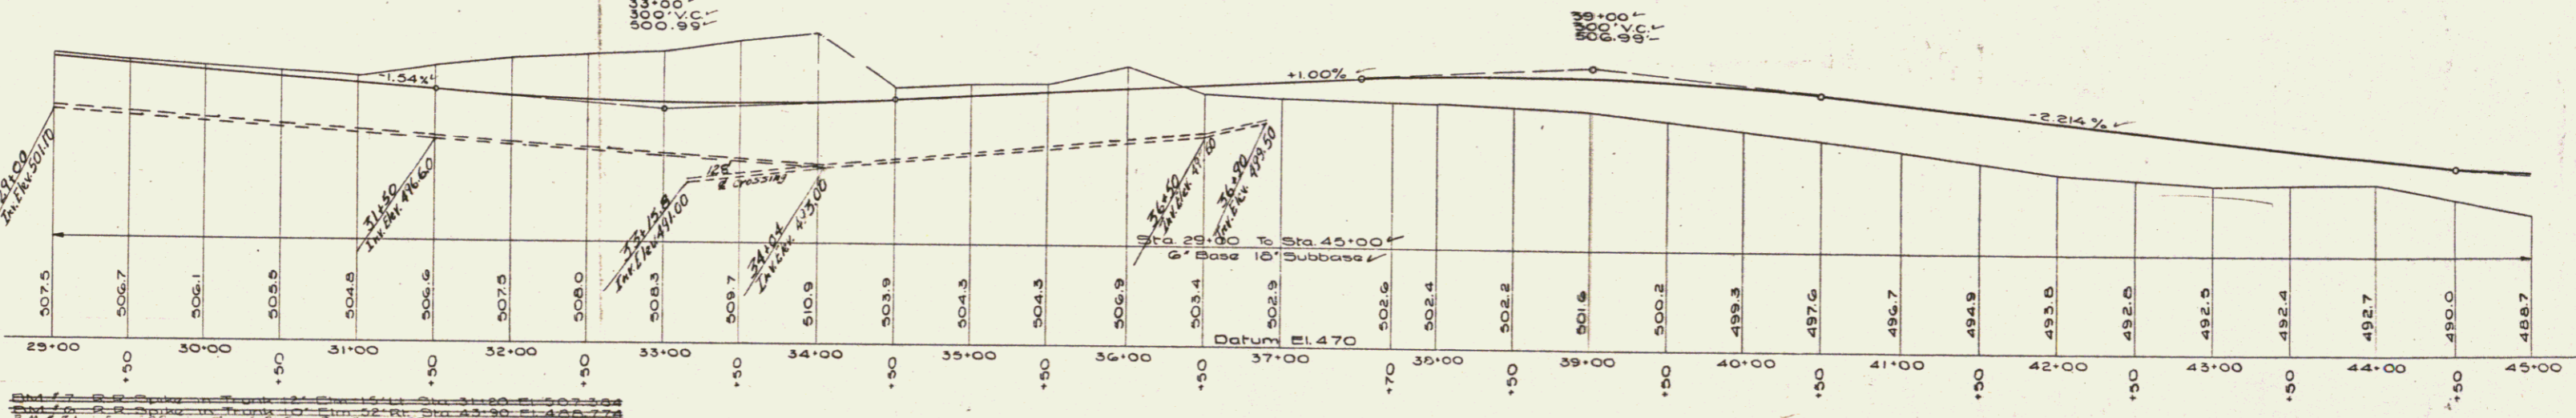

Removal of Existing Concrete Pavement  
29+00-38+00  
44+00-45+00

THREE CABLE GUARD RAIL WITH STEEL POSTS  
35+95 - 46+83 Right


CONSTRUCT APPROACH  
32+80 Right

STEEL GUIDE POSTS  
Sta. Lt. Rt.  
33+25 1 7  
37+08 1 7  
41+08 1 7

REMOVAL AND DISPOSAL OF EXISTING GUARD RAIL  
33+00 - 41+00 Right

NOTE:

Part of agreement between State of Vermont and Clarendon and Pittsford Railroad Company dated 5 Sept, 1936. That for the work of installing culverts under the Railroad tracks, the Railroad shall have full responsibility for removing the rails and ties and for replacing rails, ties and ballast, such work shall be done by force account by the railroad, that the State or its duly authorized representative shall excavate for the culverts, lay culvert and backfill to sub-grade line. That all work for each culvert shall be performed during such hours as may be determined at a later date.

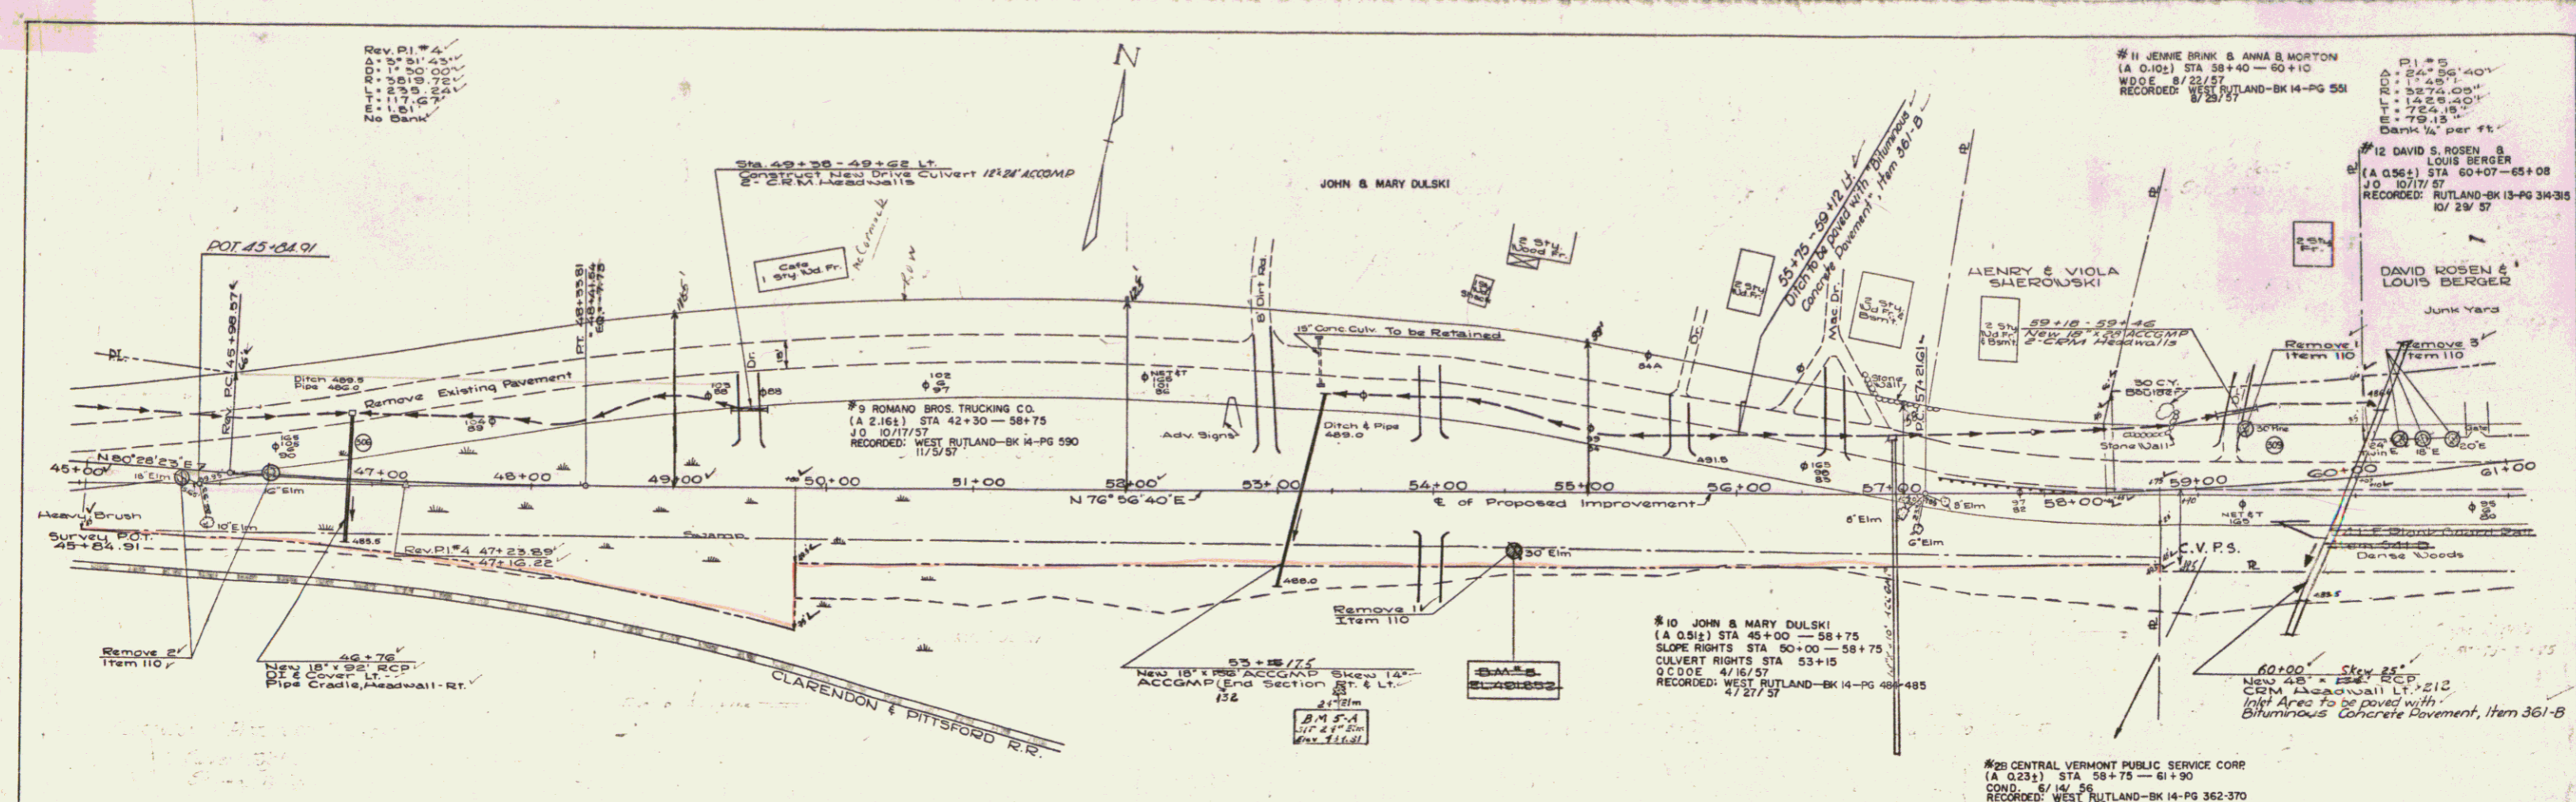

Rev. P1 #4  
 Δ: 5' 31" 43'  
 D: 1' 50" 00"  
 R: 5819.75'  
 L: 239.24'  
 T: 117.57'  
 E: 1.81'  
 No Bank

#11 JENNE BRINK & ANNA B. MORTON  
 (A 0.10) STA 58+40 - 60+10  
 W.D.E. 8/23/57  
 RECORDED: WEST RUTLAND-BK 14-PG 551  
 8/29/57

#12 DAVID S. ROSEN & LOUIS BERGER  
 (A 0.56) STA 50+07 - 65+08  
 JO 10/17/57  
 RECORDED: RUTLAND-BK 13-PG 34-35  
 10/29/57

DAVID ROSEN & LOUIS BERGER  
 Junk Yard

#10 JOHN & MARY DULSKI  
 (A 0.91) STA 45+00 - 58+75  
 SLOPE RIGHTS STA 50+00 - 58+75  
 CULVERT RIGHTS STA 53+15  
 R.C.O.D.E. 4/16/57  
 RECORDED: WEST RUTLAND-BK 14-PG 489-485  
 4/27/57

#25 CENTRAL VERMONT PUBLIC SERVICE CORP  
 (A 0.23) STA 58+75 - 61+90  
 COND. 6/14/56  
 RECORDED: WEST RUTLAND-BK 14-PG 362-370  
 8/16/56

#28 JOHN & JULIA WILK  
 SLOPE RIGHTS STA 58+75 - 61+75  
 CULVERT RIGHTS STA 50+20  
 GRADE CHANGE STA 61+00 - 62+50  
 W.D.E. 4/16/57  
 RECORDED: WEST RUTLAND-BK 14-PG 488-  
 4/27/57

CONSTRUCT APPROACH  
 52+25 &

REMOVAL & DISPOSAL OF  
 EXISTING GUARD RAIL  
 57+28 - 58+20 RT. L.  
 REMOVAL OF EXISTING CONCRETE PAVEMENT  
 43+00 - 38+00 -  
 58+00 - 61+00 -


Top Soil  
 55+10 - 61+00

CONSTRUCT DRIVES


Sta	From	LT	RT
49+80.87	50+00	1	1
53+28.00	53+00	1	1
59+28.00	57+00	1	1
60+79	59+00	1	1
61+00	61+00	1	1
58+70	58+70	1	1
58+30	58+30	1	1
61+00	61+00	1	1

STEEL GUIDE POSTS


Sta	LT	RT
46+00	1	1
53+28	1	1
57+00	1	1
59+00	1	1
53+17	6	6

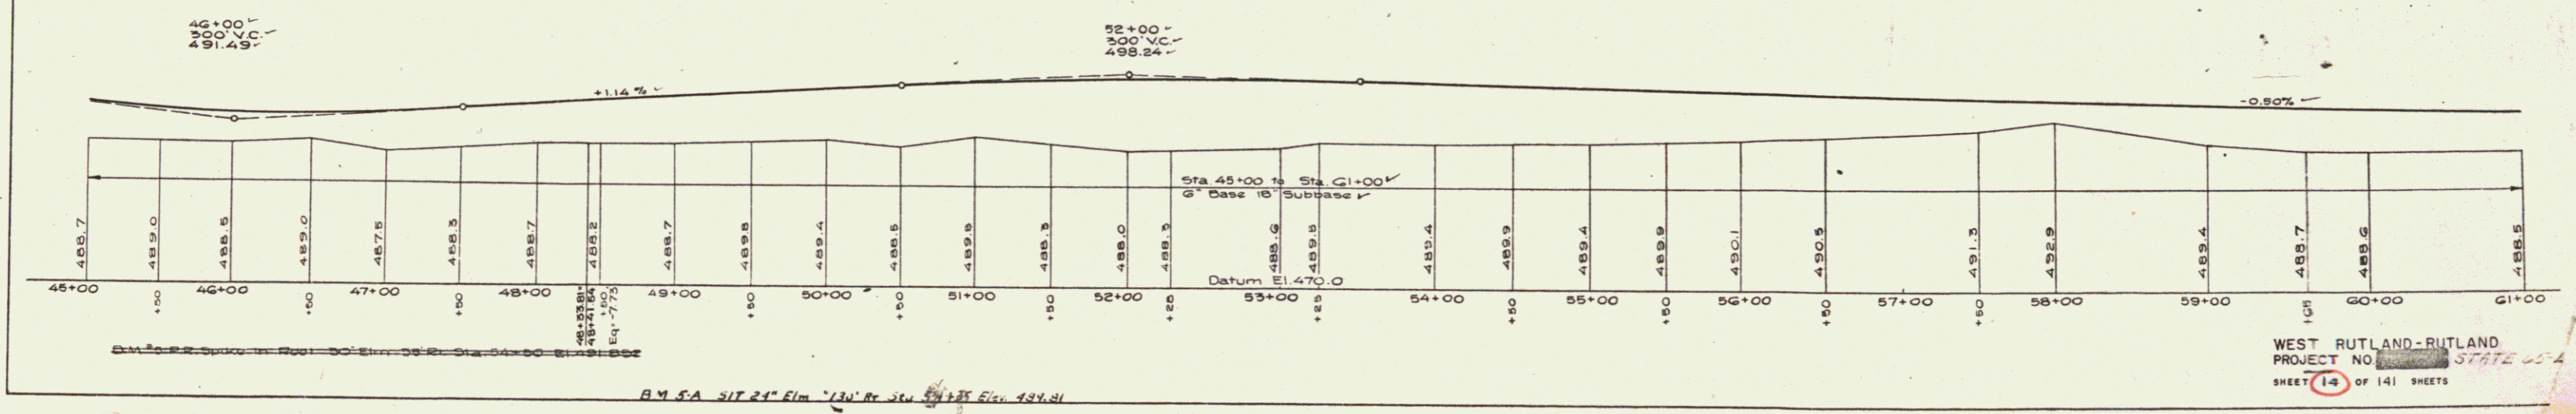


THIS IS PART OF THE SAME LAND ACQUIRED BY THE STATE OF VERMONT AS PART OF THE ORIGINAL US RTE. 4 TAKEN INTO THE STATE HIGHWAY SYSTEM ON APRIL 1, 1931, BY ORDER OF THE STATE HIGHWAY BOARD PURSUANT TO LEGISLATIVE ACT 61 OF 1931

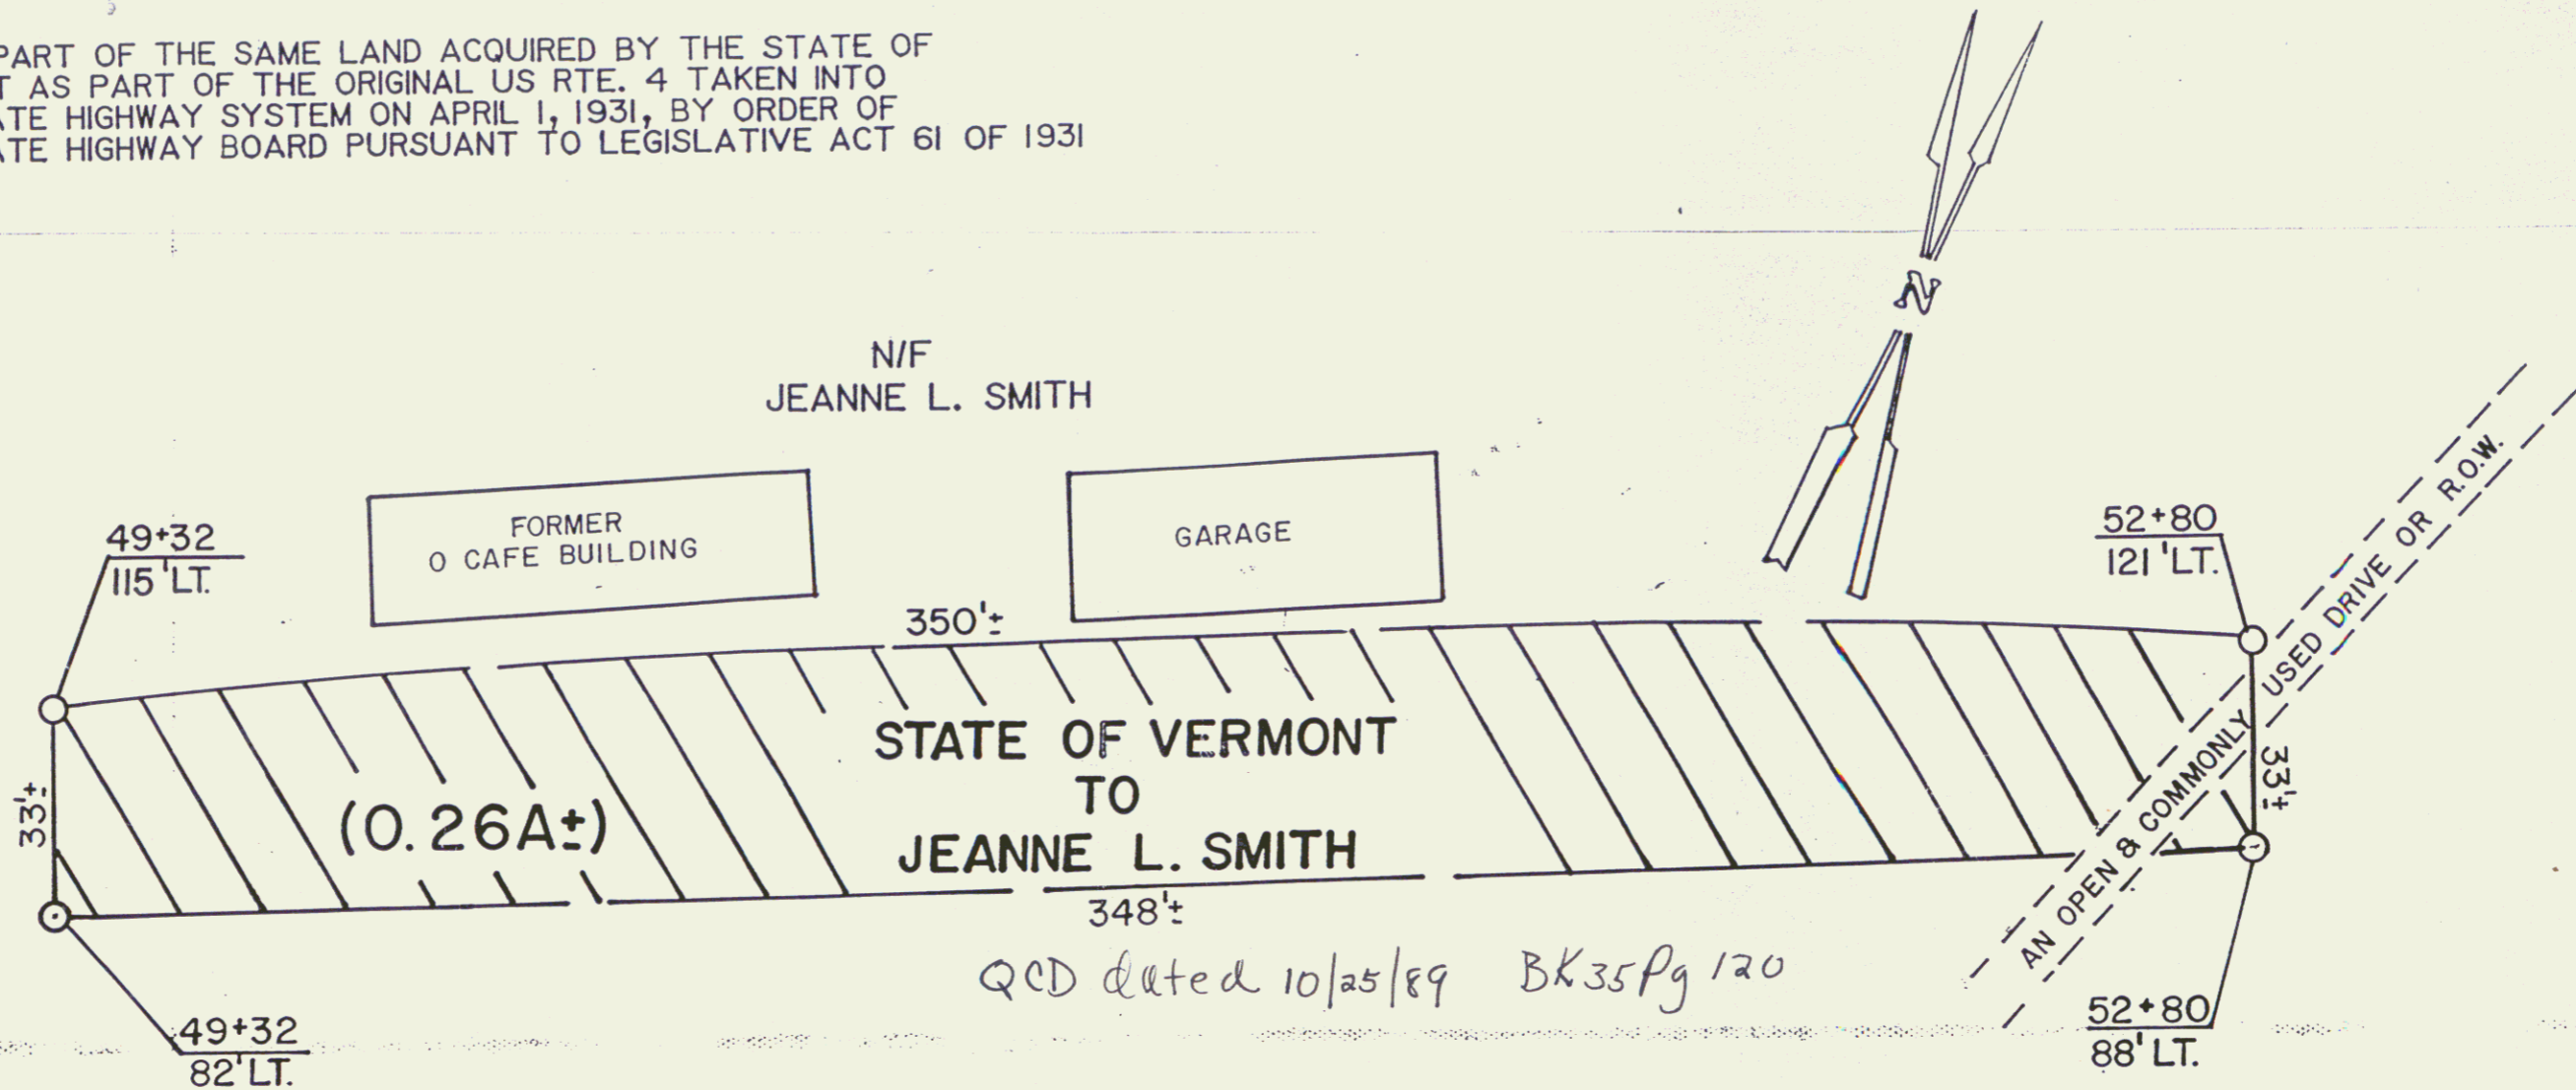

RIGHT-OF-WAY DIVISION  
TOWN FILE  
PERPETUAL  
Town of West Rutland BRUS4  
(To Be Returned To R.O.W. Division)

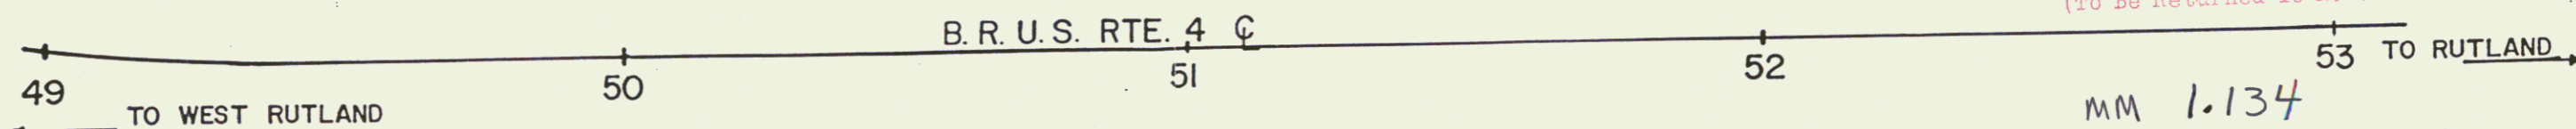

SCALE 1" = 30'

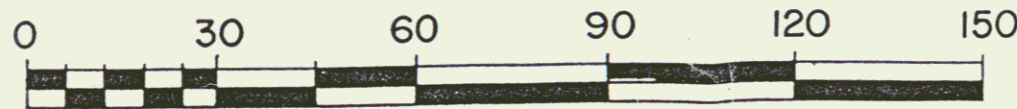

REF SHEET 14 OF 141

STATE OF VERMONT  
AGENCY OF TRANSPORTATION






WEST RUTLAND

PROJECT: ST 65L

14A

APPROX. SCALE 1" = 30' DRAWN BY A.S.J. DATE 9/12/89

THIS IS PART OF THE SAME LAND ACQUIRED BY THE STATE OF VERMONT AS PART OF THE ORIGINAL US RTE. 4 TAKEN INTO THE STATE HIGHWAY SYSTEM ON APRIL 1, 1931, BY ORDER OF THE STATE HIGHWAY BOARD PURSUANT TO LEGISLATIVE ACT 61 OF 1931.

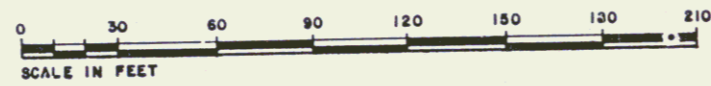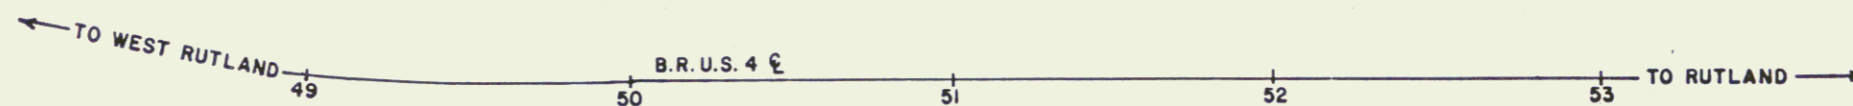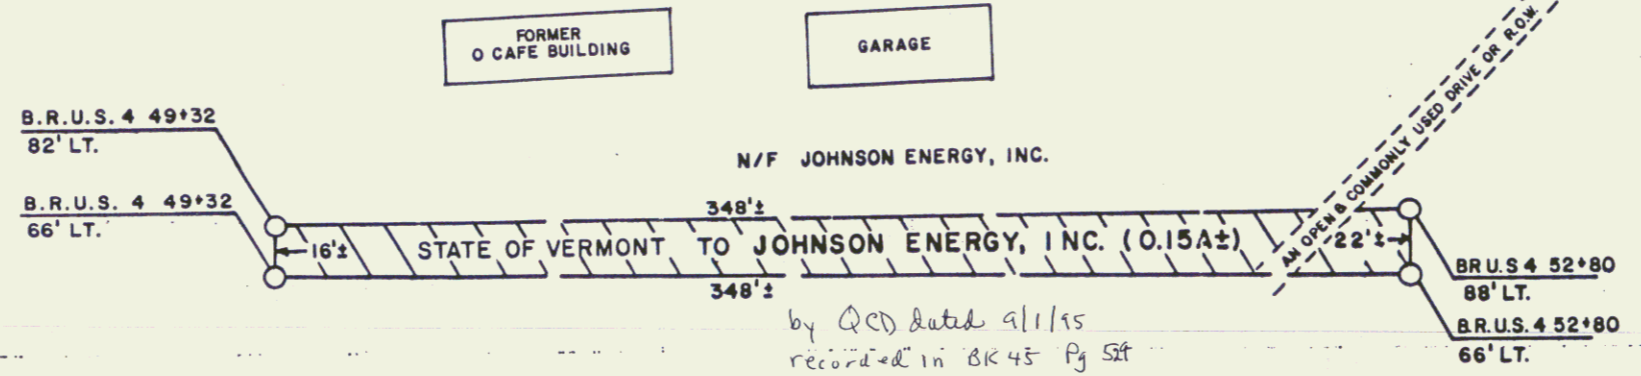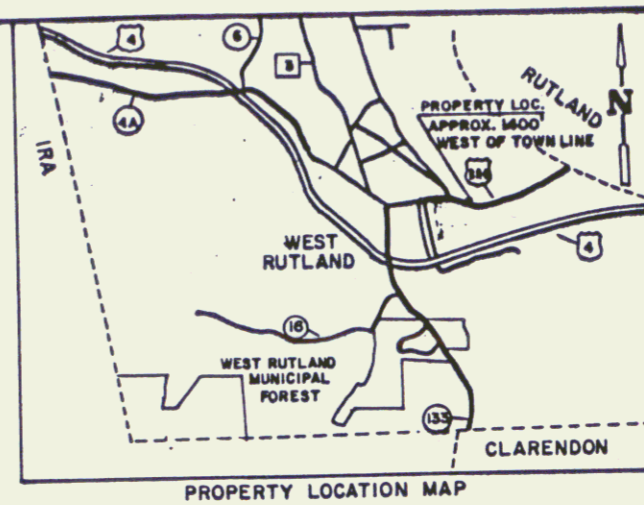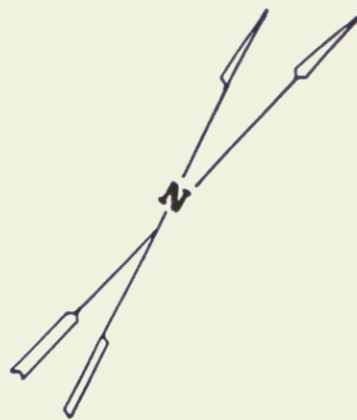

RIGHT-OF-WAY DIVISION  
TOWN FILE  
PERPETUAL  
Form of \_\_\_\_\_  
(To Be Returned To R.O.W. Division)

SHEET 14 OF 141  
REF. PROJ.: WEST RUTLAND-RUTLAND ST. 65 L

STATE OF VERMONT  
AGENCY OF TRANSPORTATION


TOWN OF WEST RUTLAND

SCALE: 1" = 30'    DATE: 8-29-95    DRAWN BY: PJH

THIS IS AN ORIGINAL MYLAR

14B

8

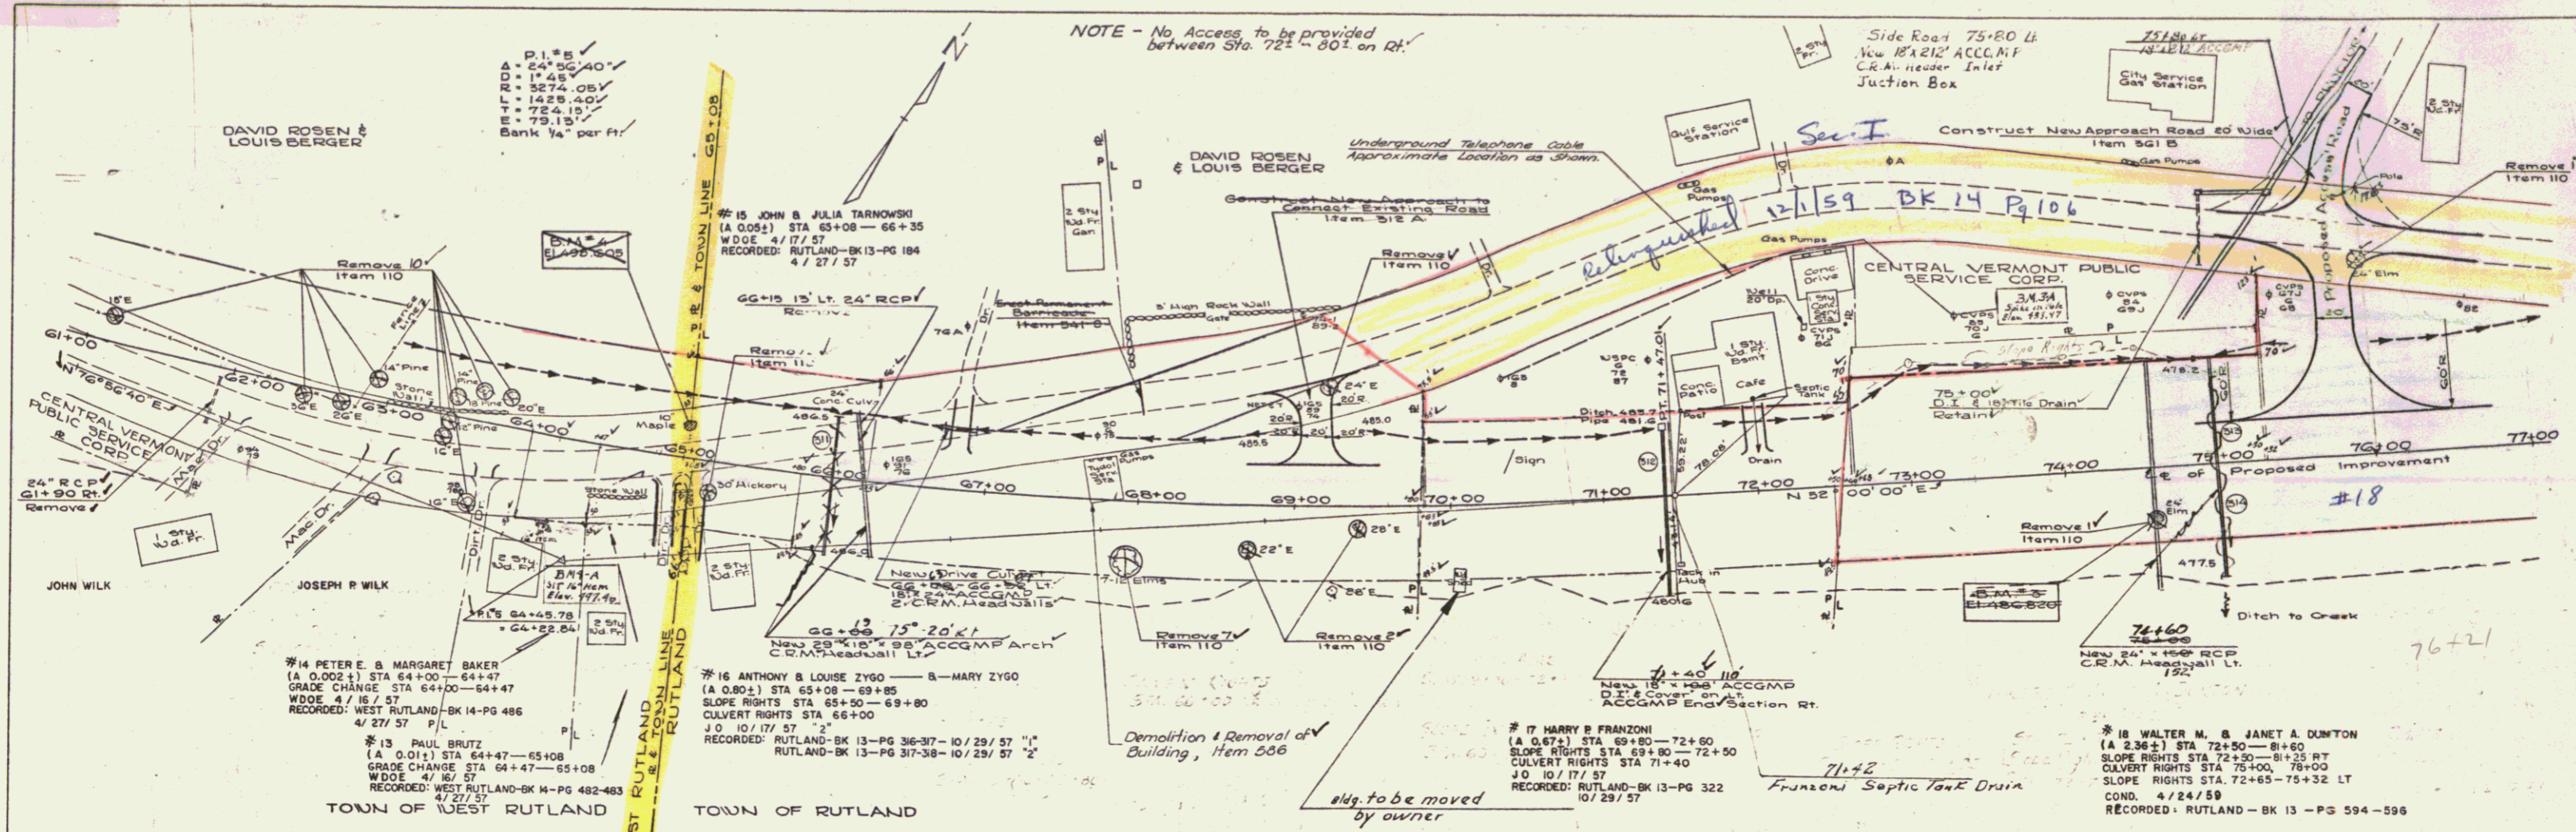

STEEL GUIDE POSTS

Sta	LT	RT
65+00		
66+00		
67+00		
68+00		
69+00		
70+00		
71+00		
72+00		
73+00		

CONSTRUCT DRIVES

Sta	Pos.
61+00	RT
61+25	LT
62+10	RT
62+25	LT
63+10	RT
63+25	LT
64+10	RT
64+25	LT



CONSTRUCT APPROACH

Sta	Pos.
68+00	RT
68+15	LT
67+85	LT


REMOVAL OF EXISTING CONCRETE PAVEMENT  
 62+77 - 63+00  
 69+00 - 71+50

GRANITE CURB  
 70+00 Ft. 56'  
 TOP SOIL  
 61+50 - 66+00 Rt.  
 66+00 - 67+10 Lt.

Note: - Sta. 64+11 - 64+01 Rt.  
 Stone Wall to be removed by Grantor and rebuilt on taking line after construction of proposed highway.

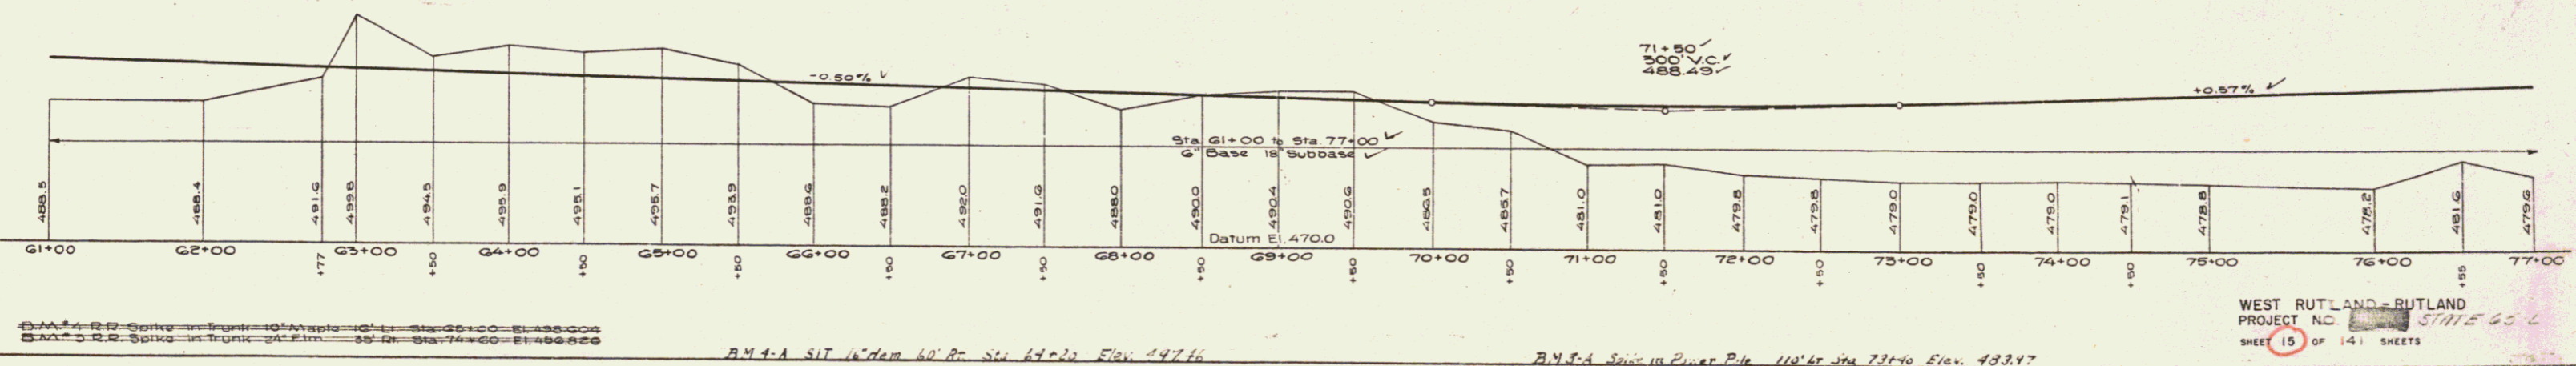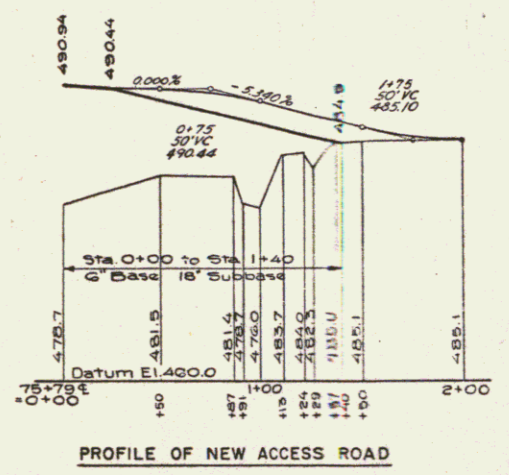



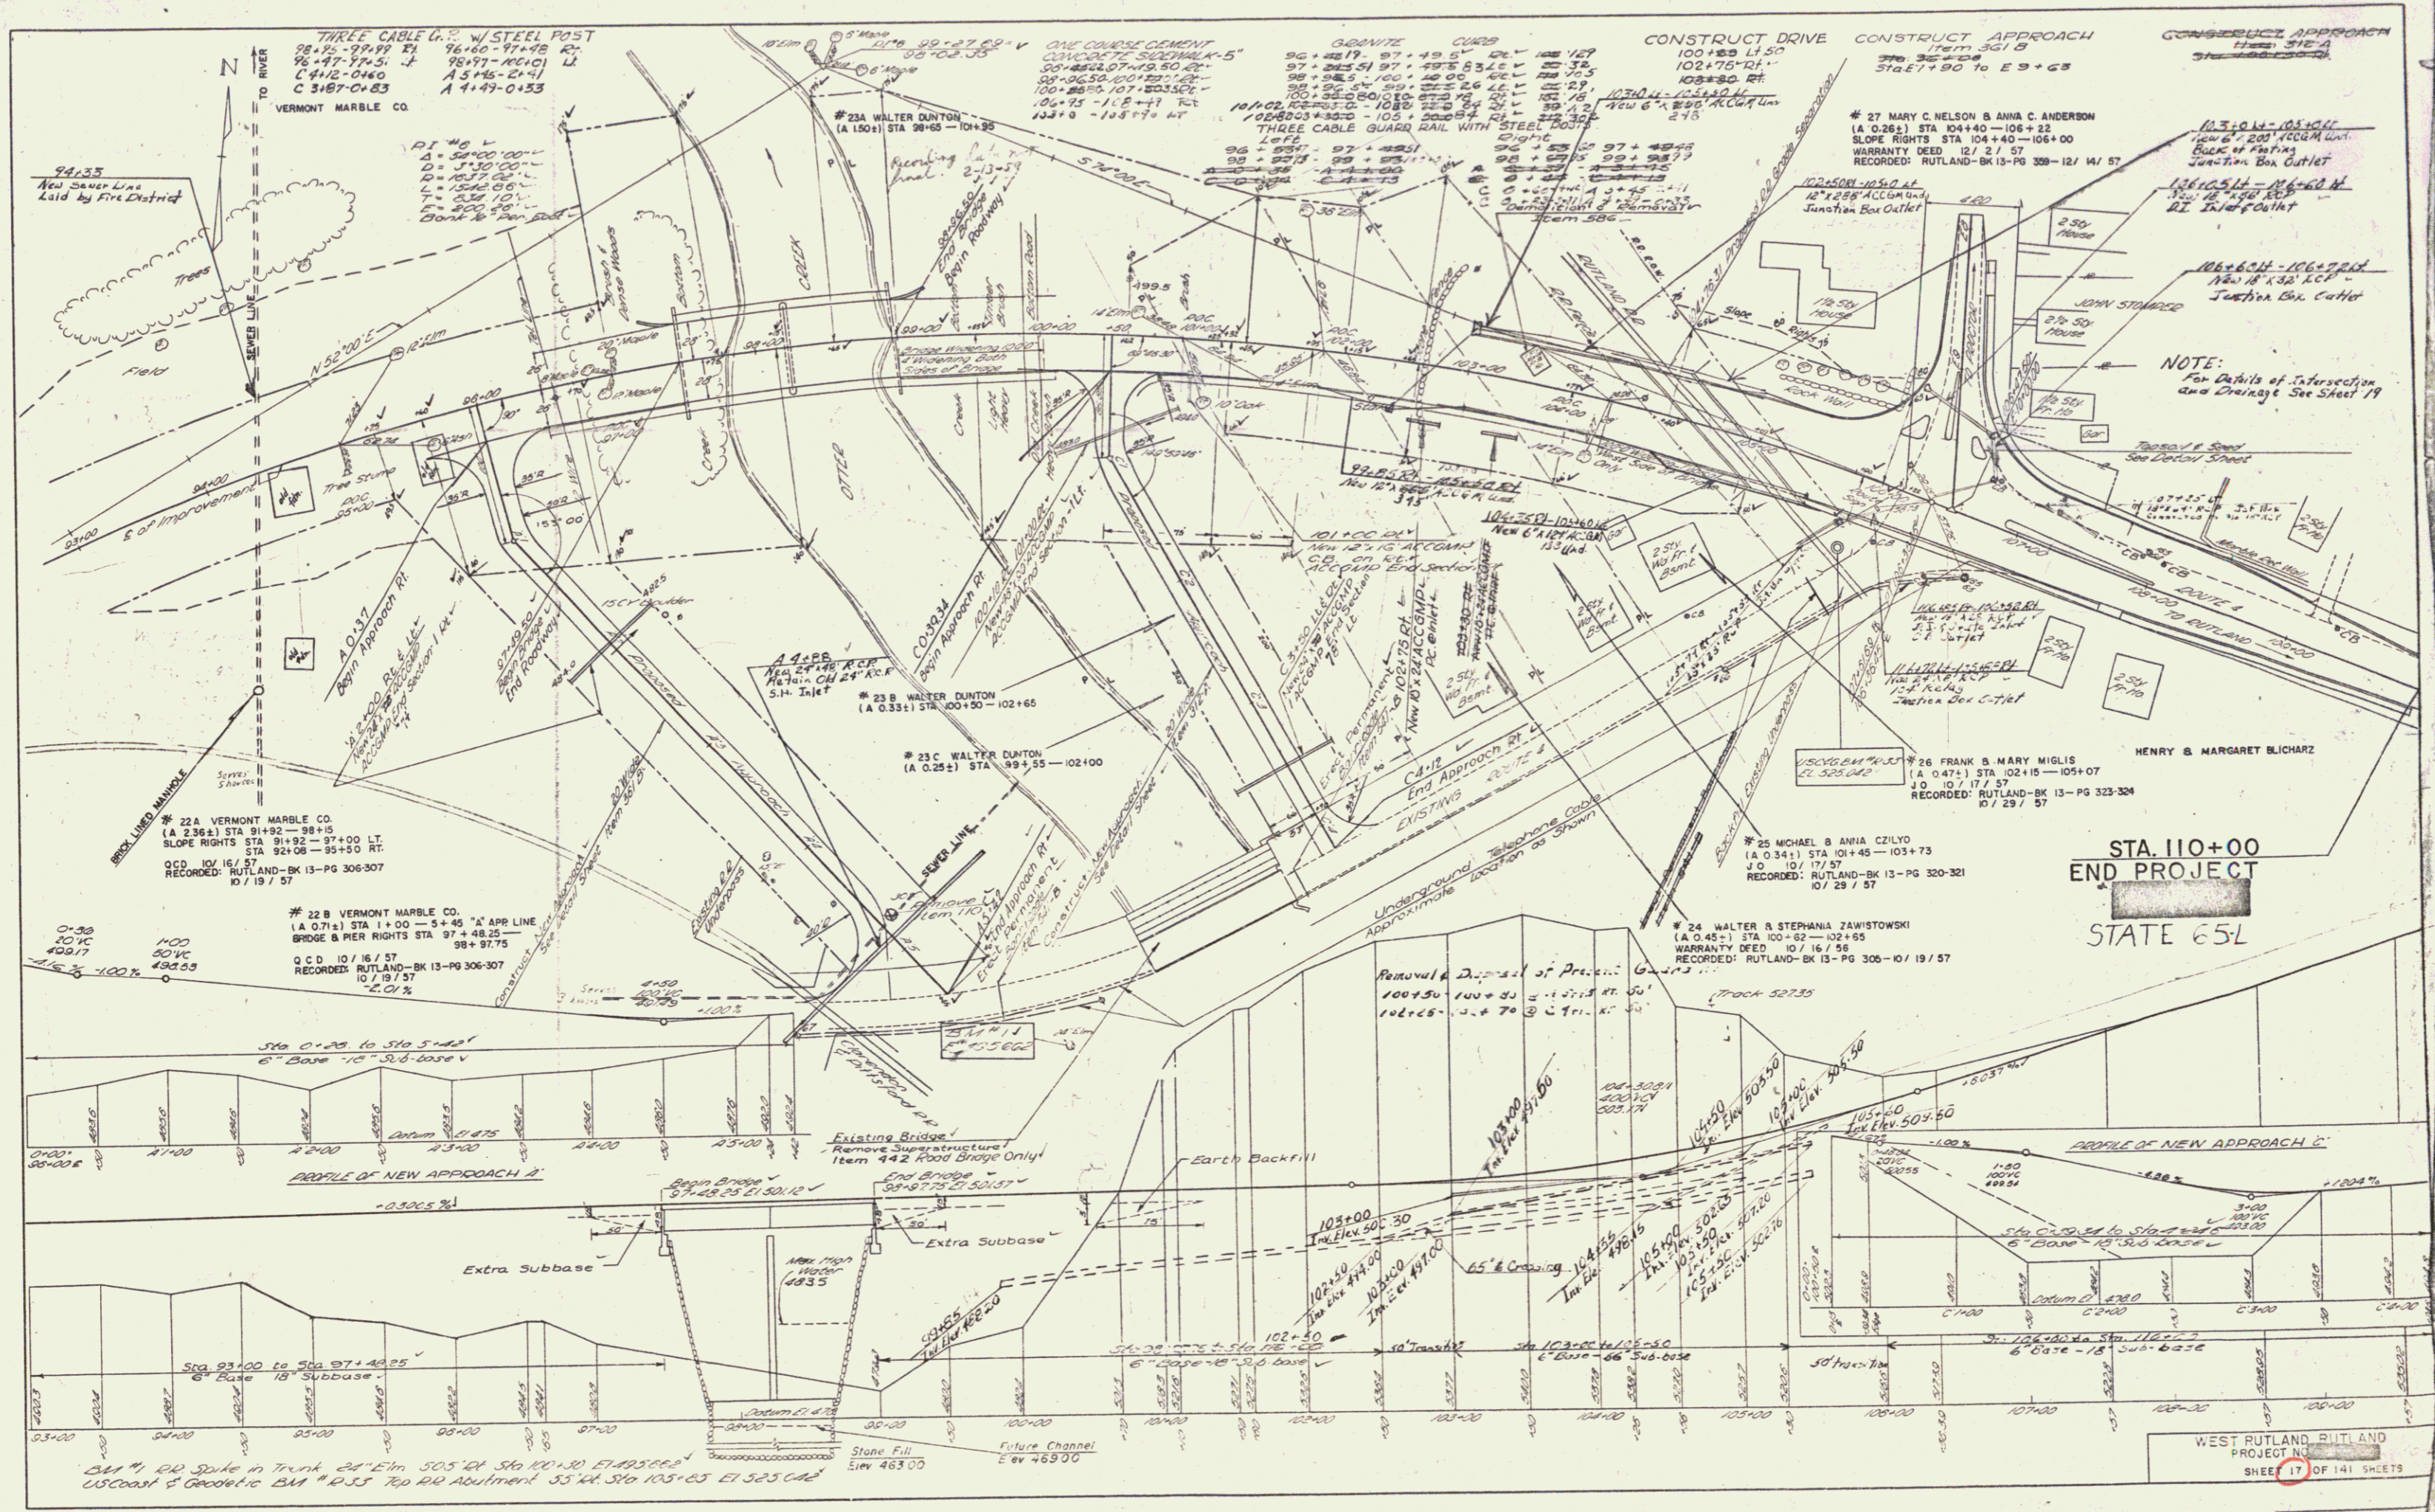


NOTE:  
For Details of Intersection  
and Drainage See Sheet 19

STA. 110+00  
END PROJECT  
STATE 65-L

WEST RUTLAND, RUTLAND  
PROJECT NO. 11  
SHEET 17 OF 141 SHEETS

STATE OF VERMONT  
TO  
TOWN OF RUTLAND

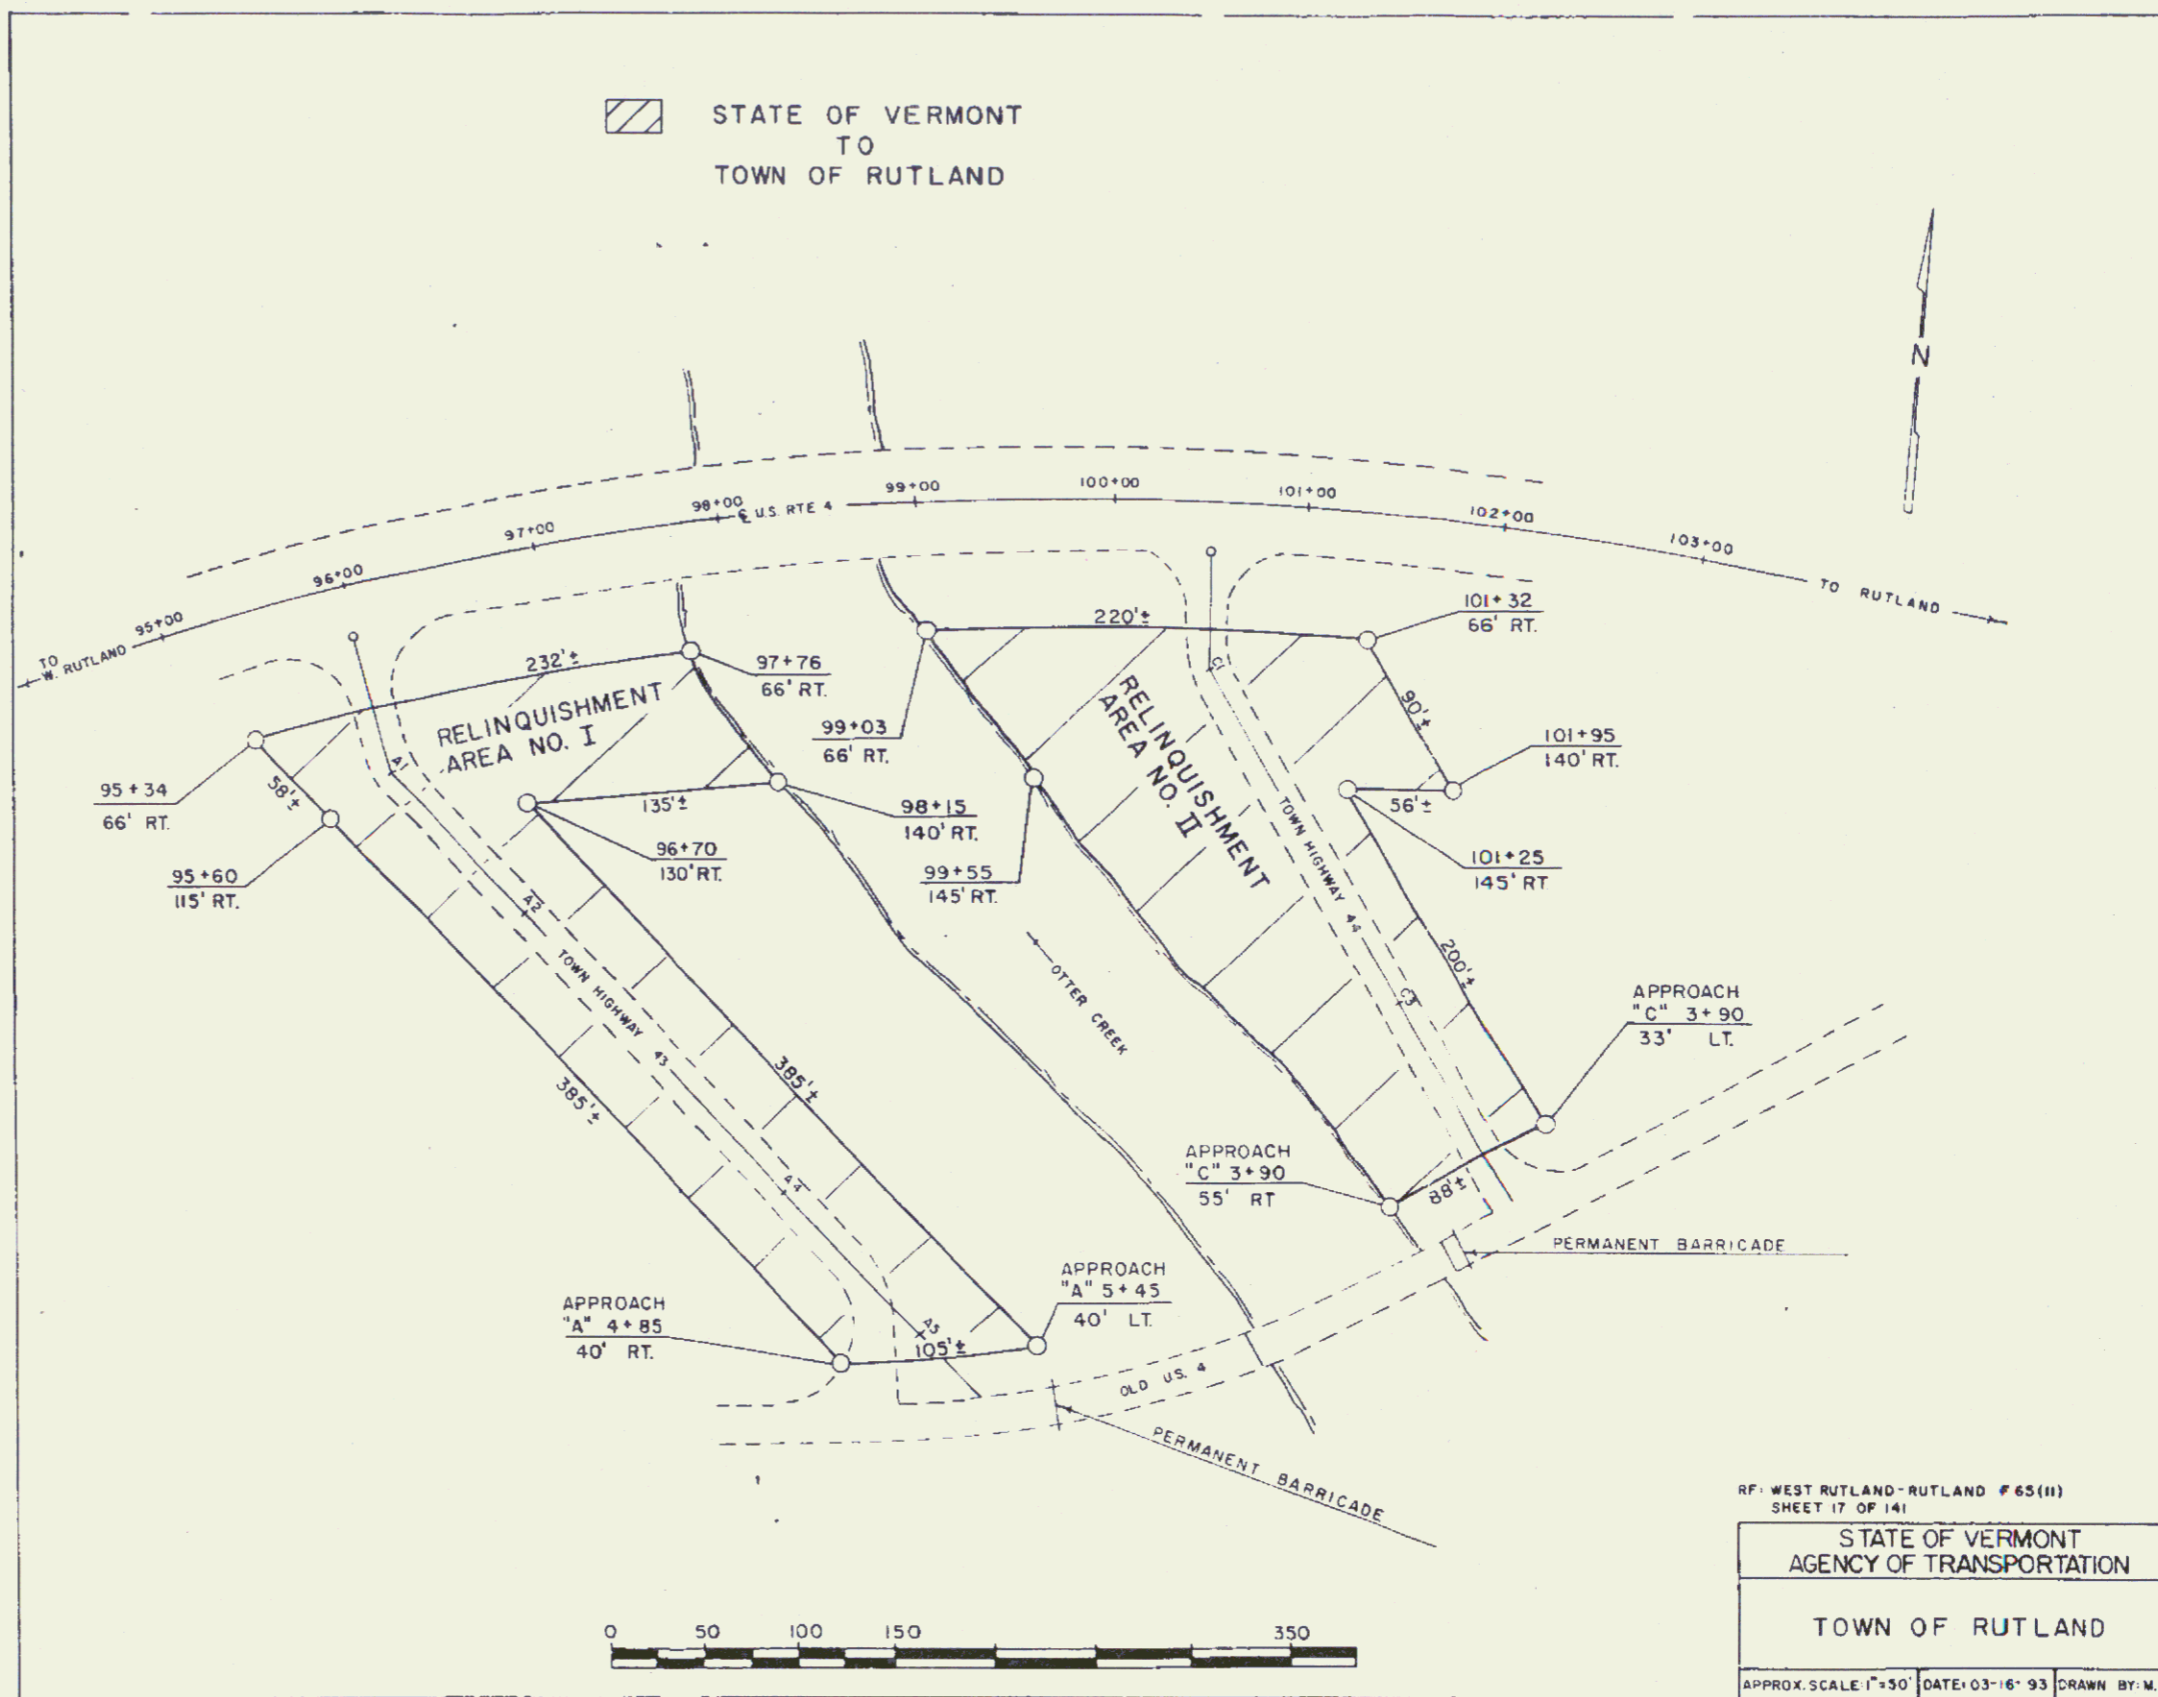


RF. WEST RUTLAND-RUTLAND #65(H)  
SHEET 17 OF 141  
STATE OF VERMONT  
AGENCY OF TRANSPORTATION  
TOWN OF RUTLAND  
APPROX. SCALE: 1"=50' DATE: 03-16-93 DRAWN BY: M.R.



17A



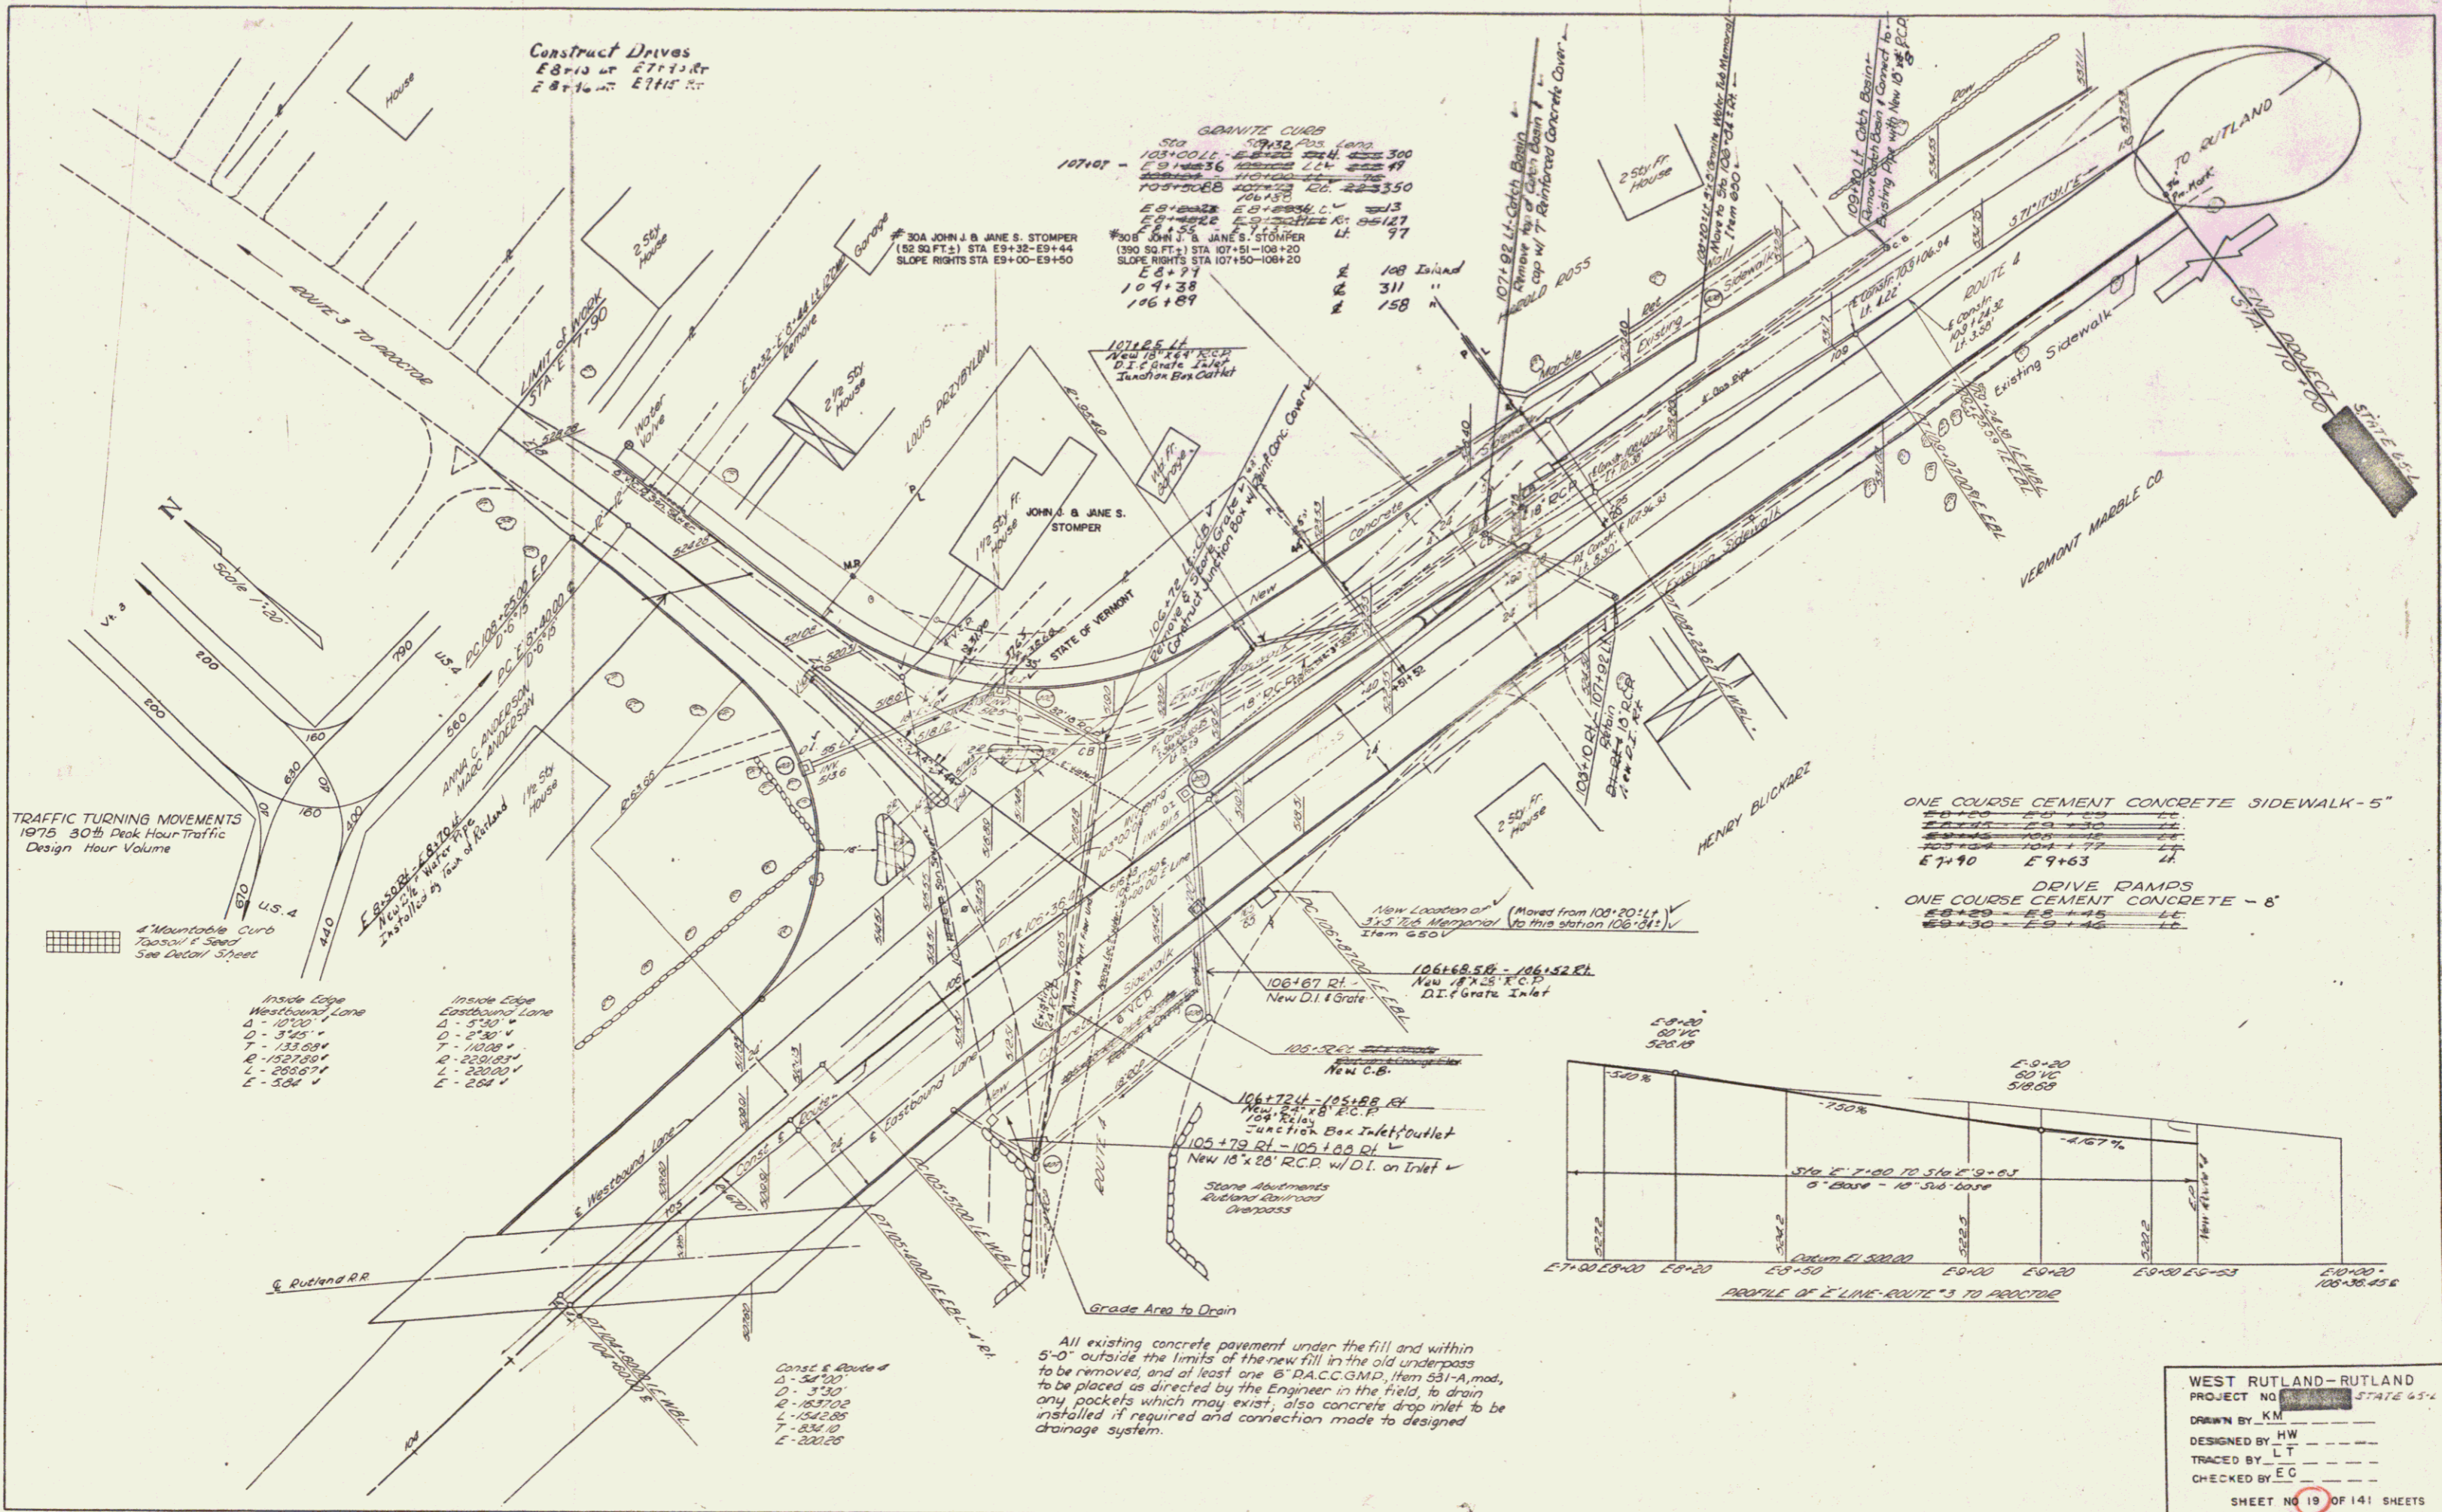

Construct Drives  
 E 8110 at E 7110 R  
 E 8110 at E 7110 R

GRANITE CURB  
 500' 5" 1/2  
 107107 - 107108  
 107108 - 107109  
 107109 - 107110  
 107299 - 107300

TRAFFIC TURNING MOVEMENTS  
 1975 30th Peak Hour Traffic  
 Design Hour Volume

4' Mountable Curb  
 Topsoil & Seed  
 See Detail Sheet

Inside Edge  
 Westbound Lane  
 A - 1020' +  
 B - 310' +  
 C - 133.08' +  
 D - 152.73' +  
 E - 255.97' +  
 F - 304' +


Inside Edge  
 Eastbound Lane  
 A - 330' +  
 B - 640' +  
 C - 1028' +  
 D - 230.08' +  
 E - 330.08' +  
 F - 284' +

Const. & Grade of  
 A - 347.50  
 B - 330  
 C - 102.70  
 D - 104.00  
 E - 220.25


All existing concrete pavement under the fill and within 5'-0" outside the limits of the new fill in the old underpass to be removed, and at least one 6" DACCGMP, Item 531-A, mat, to be placed as directed by the Engineer in the field, to drain any pockets which may exist, also concrete drop inlet to be installed if required and connection made to designed drainage system.

ONE COURSE CEMENT CONCRETE SIDEWALK - 5"  
 E 7+00 - E 7+10  
 E 7+10 - E 7+20  
 E 7+20 - E 7+30  
 E 7+30 - E 7+40  
 E 7+40 - E 7+50  
 E 7+50 - E 7+60  
 E 7+60 - E 7+70  
 E 7+70 - E 7+80  
 E 7+80 - E 7+90  
 E 7+90 - E 7+100

DRIVE RAMPS  
 ONE COURSE CEMENT CONCRETE - 8"  
 E 7+20 - E 7+30  
 E 7+30 - E 7+40  
 E 7+40 - E 7+50  
 E 7+50 - E 7+60  
 E 7+60 - E 7+70  
 E 7+70 - E 7+80  
 E 7+80 - E 7+90  
 E 7+90 - E 7+100

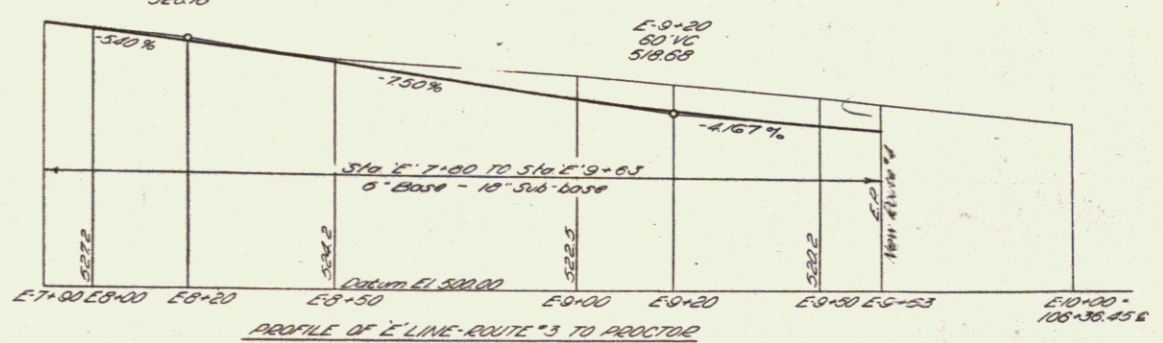

WEST RUTLAND - RUTLAND  
 PROJECT NO. [REDACTED] STATE 65-A  
 DRAWN BY: KM  
 DESIGNED BY: LT  
 TRACED BY: EC  
 CHECKED BY: EC  
 SHEET NO. 19 OF 141 SHEETS

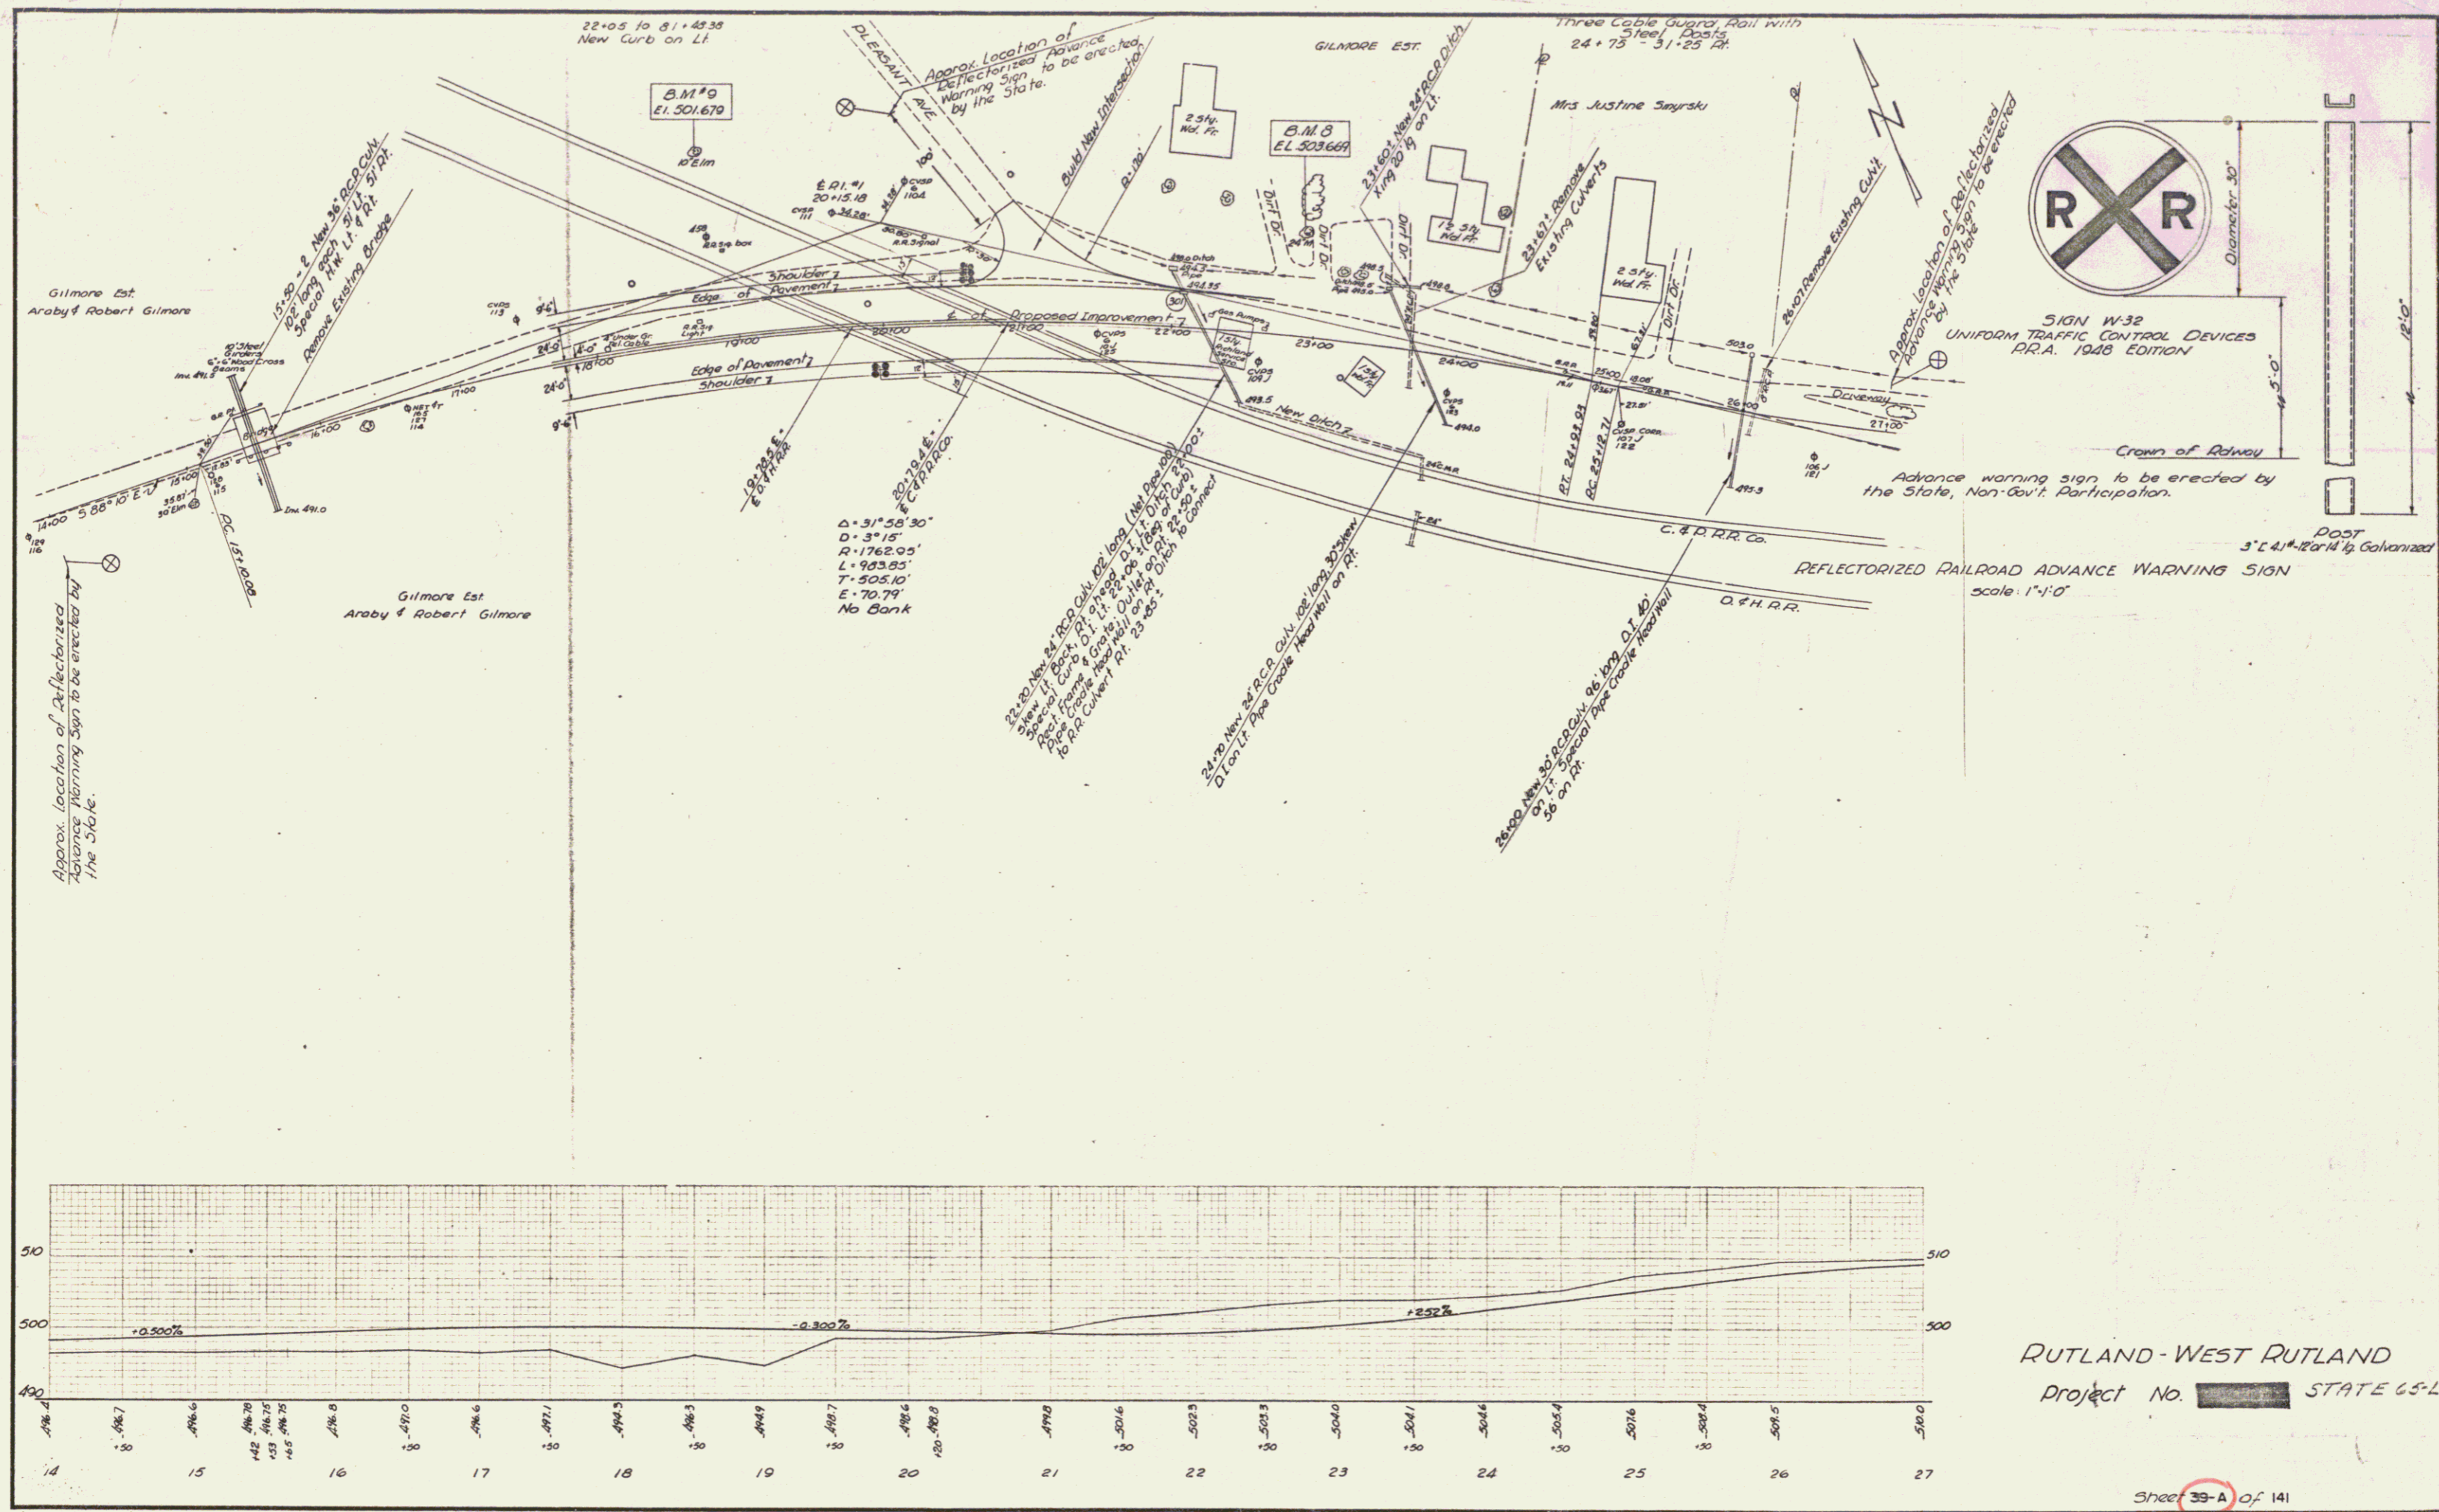

SIGN W-32  
UNIFORM TRAFFIC CONTROL DEVICES  
R.R.A. 1940 EDITION

Advance warning sign to be erected by the State, Non-Gov't. Participation.

REFLECTORIZED RAILROAD ADVANCE WARNING SIGN  
scale: 1"=10'

RUTLAND-WEST RUTLAND  
Project No. [redacted] STATE 65-L