


GUMBO PAIL REQUIRED
ON LEFT
 STA 489+88 TO STA. 489+12 LENGTH 24 FT.
 " 492+48 " " 492+12 " 24 "

ON RIGHT
 STA. 489+88 TO STA. 489+12 LENGTH 24 FT.
 " 492+48 " " 492+12 " 24 "

TOTAL THIS SHEET 96 FT.


NEW CULVERTS REQUIRED
 489+00 15" Conc Pipe 30 ft.
 Conc Class B (1-2-3) 18 cy.
 492+60 15" Conc Pipe 32
 Conc Class B (1-2-3) 18 cy.

FIELD BOOK STATE FED. AD. FISCA. SHEET
 DIST. NO. 11734 1142 12

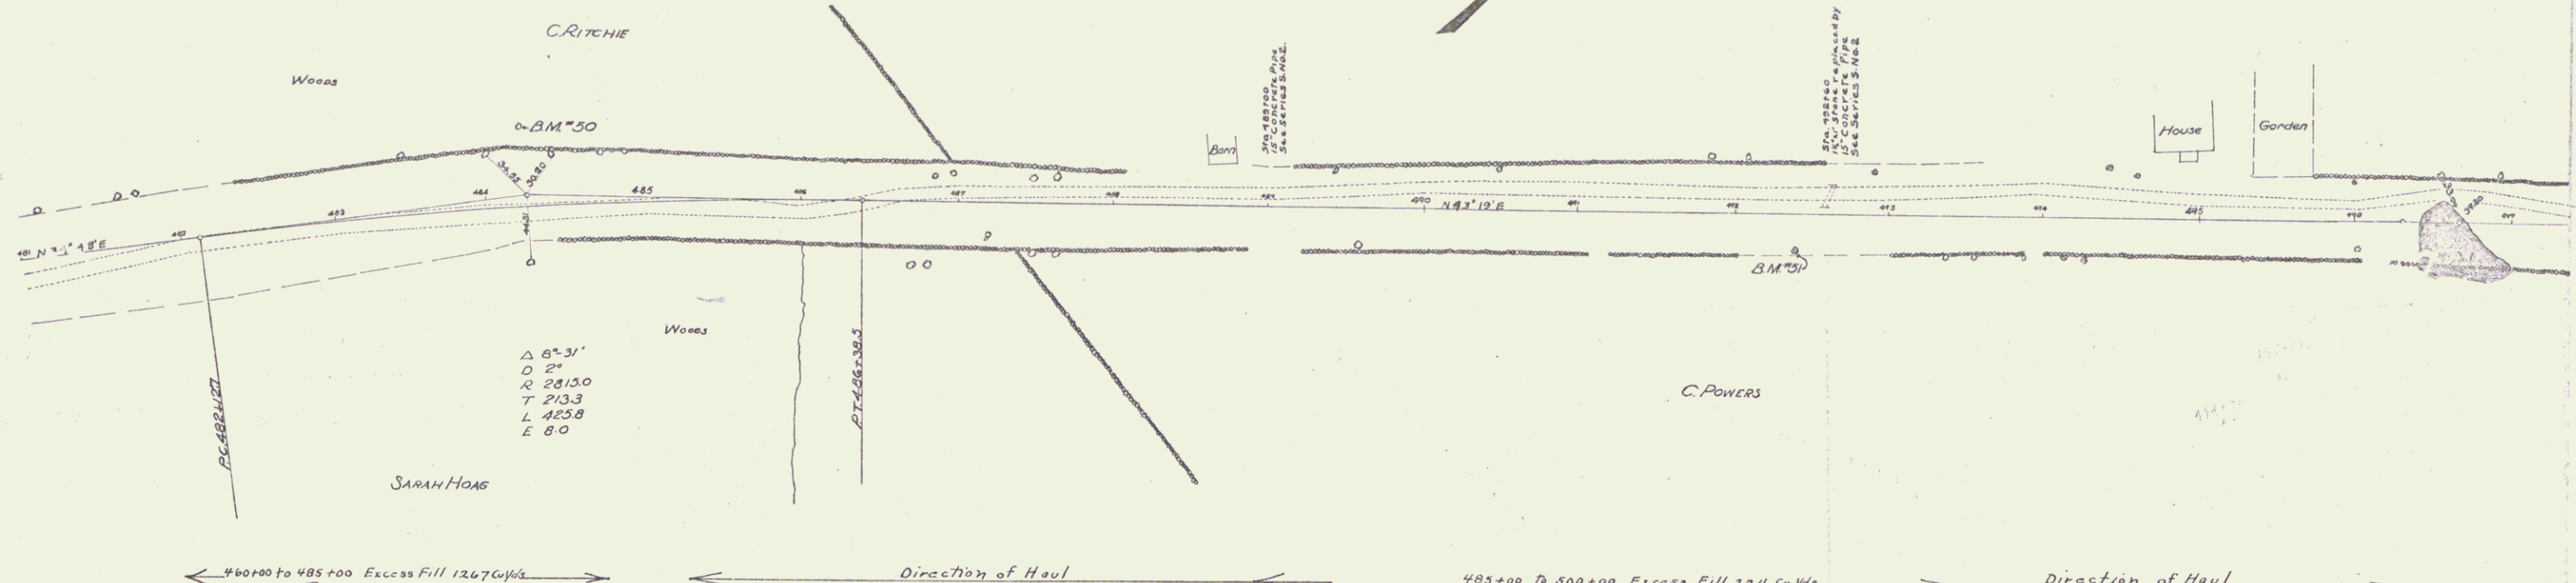

← 480+00 to 485+00 Excess Fill 12.67 Cu Yds. Borrow 12.67 Cu Yds. Direction of Haul 485+00 to 500+00 Excess Fill 12.24 Cu Yds. Borrow 22.4 Cu Yds. Direction of Haul →

329.6	322.76	325.27	325.76	327.03	328.16	329.14	329.86	330.06	331.18	331.83	331.83	331.94	331.95	331.99	332.02	332.03	332.03	332.08	332.12	332.17	332.20	332.26	332.30	332.30	332.35	332.44	332.48	332.53	332.62	332.63	332.64	332.67	332.68	332.76	333.04	333.16	333.67	333.98	334.54	335.33	335.52	336.30	336.57	337.20	337.47	338.47	338.59	338.87	338.96																														
482	+50	483	103	125	150	175	2000

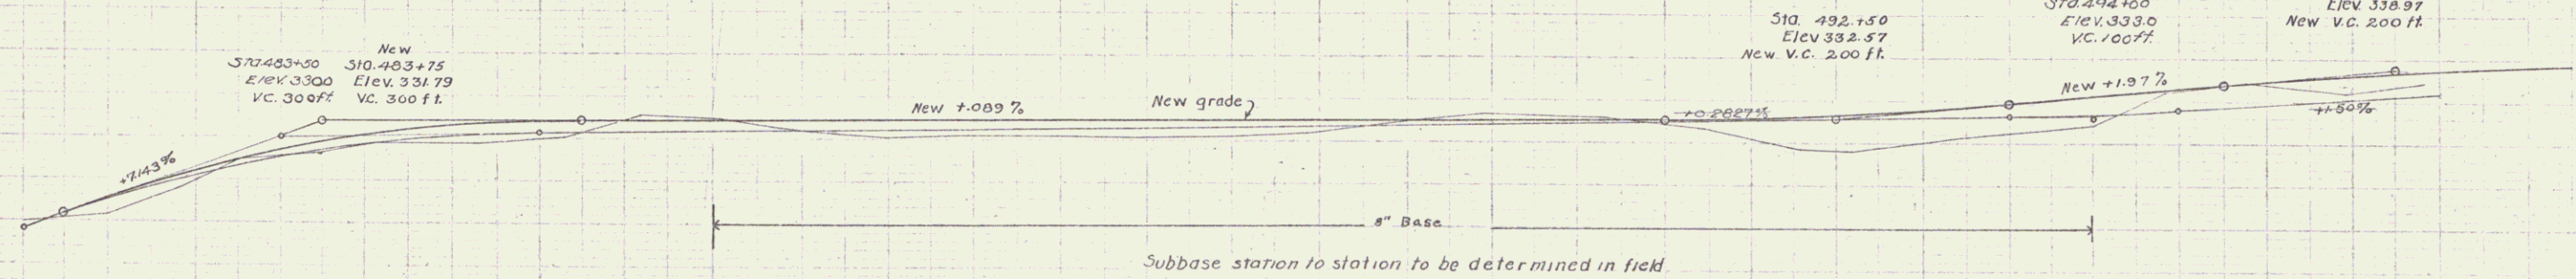

329.6	322.76	325.27	325.76	327.03	328.16	329.14	329.86	330.06	331.18	331.83	331.83	331.94	331.95	331.99	332.02	332.03	332.03	332.08	332.12	332.17	332.20	332.26	332.30	332.30	332.35	332.44	332.48	332.53	332.62	332.63	332.64	332.67	332.68	332.76	333.04	333.16	333.67	333.98	334.54	335.33	335.52	336.30	336.57	337.20	337.47	338.47	338.59	338.87	338.96																												
482	100	125	150	2000

BM #50 Spike in roots of 20' Maple 43' to left sta. 484+27 Elev. 321.50
 BM #51 Spike in roots of 12' Elm 24' to right sta. 412+38 Elev. 310.76