
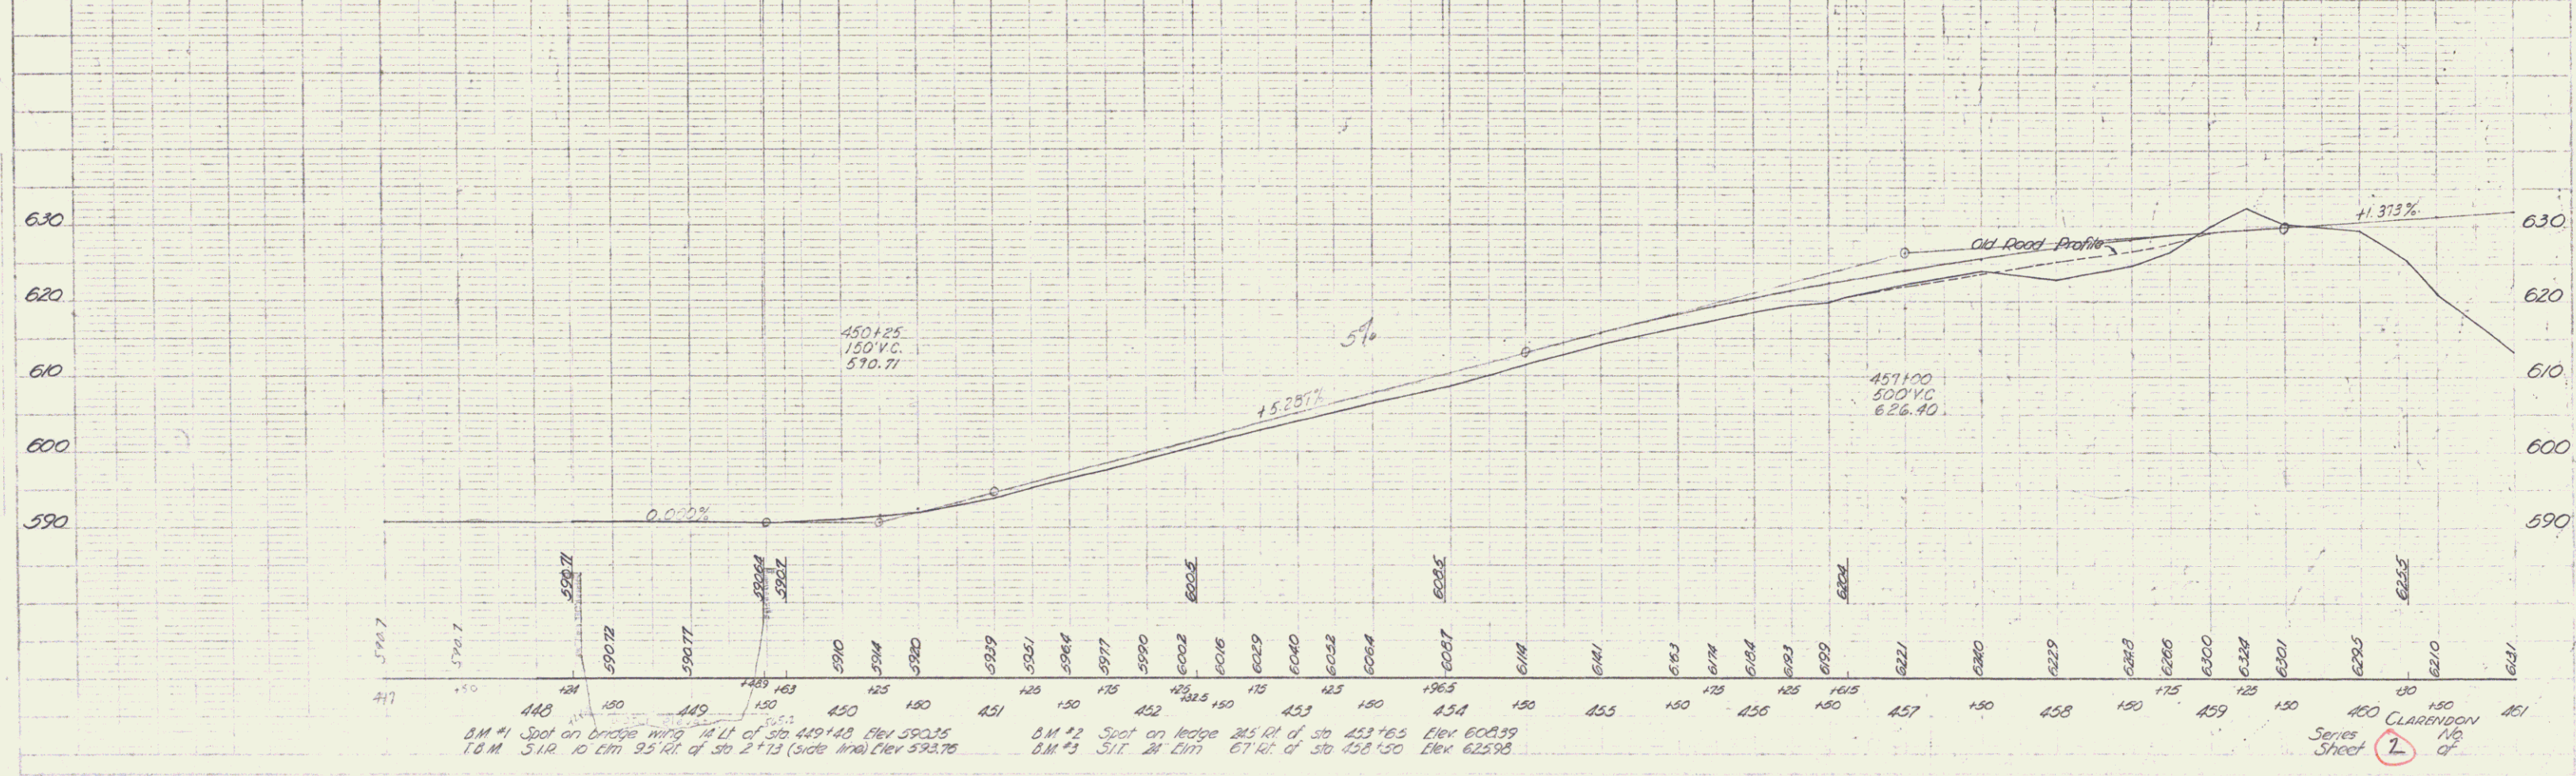


Scale	1" = 100'
Sheet No.	1152
Date	

Scale	1" = 100'
Sheet No.	1152
Date	

Scale	1" = 100'
Sheet No.	1152
Date	

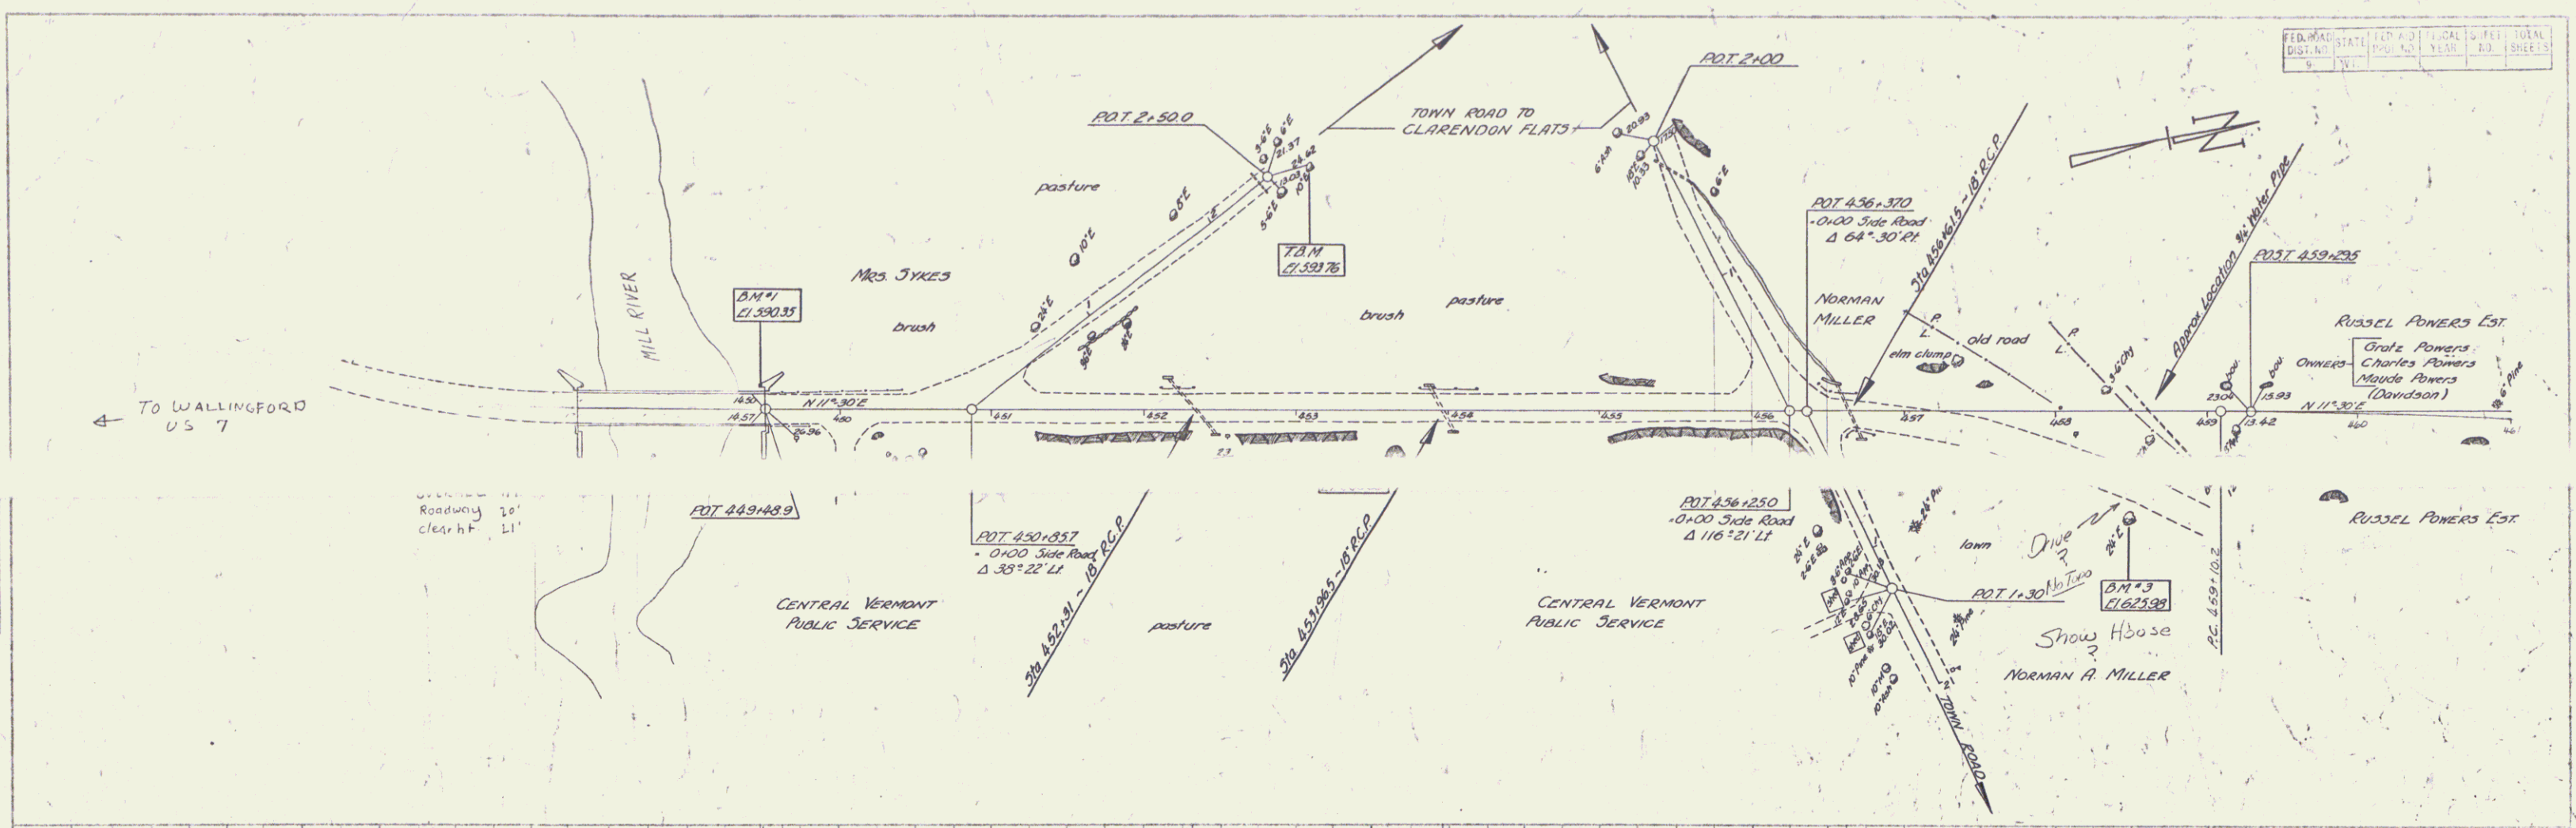

B.M. #1 Spot on bridge pier 14' LI of sta 449+48 Elev 590.25
 T.B.M. #1 10' dia 95' RI of sta 2+73 (side line) Elev 593.76
 B.M. #2 Spot on ledge 245' RI of sta 453+65 Elev 608.39
 B.M. #3 3" I.D. 24' dia 67' RI of sta 458+50 Elev 625.98

Series Sheet 2 of 2