

INDEX OF SHEETS

SHEET NO. 1	TITLE PAGE
2	TYPICAL CROSS-SECTION OF IMPROVEMENT
3	BANKING AND WIDENING TABLES
4	PLAN AND PROFILE

STATE OF VERMONT
STATE HIGHWAY DEPARTMENT

PLAN AND PROFILE OF PROPOSED
STATE HIGHWAY

FEDERAL AID PROJECT

TOWN OF CLARENDON



ROUTE U.S. 7

WALLINGFORD-RUTLAND ROAD

BEGINNING AT THE STEEL TRUSS BRIDGE OVER THE MILL RIVER AND EXTENDING NORTHERLY MILES

LENGTH OF PROJECT FEET = MILES


FED. ROAD DIST. NO.	STATE	FED. AID PROJ. NO.	FISCAL YEAR	SHEET NO.	TOTAL SHEETS
9	VT				

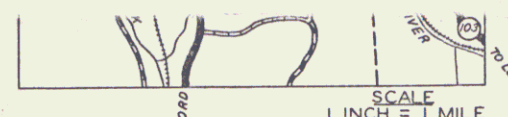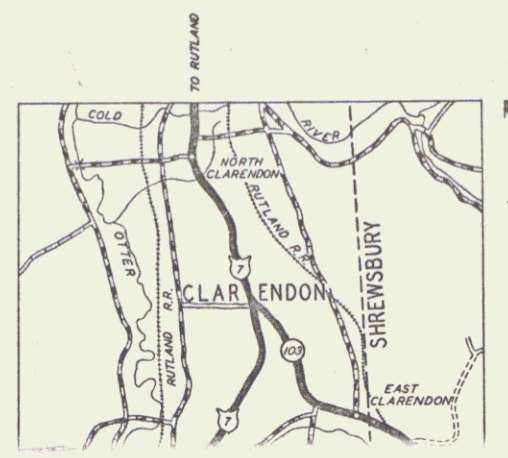

Pin # 99R706
Route VT 7B
Project 5775M

Historical
RIGHT-OF-WAY DIVISION
TOWN FILE

PERPETUAL
Town of *VT 7B*
(To Be Returned To R.O.W. Division)

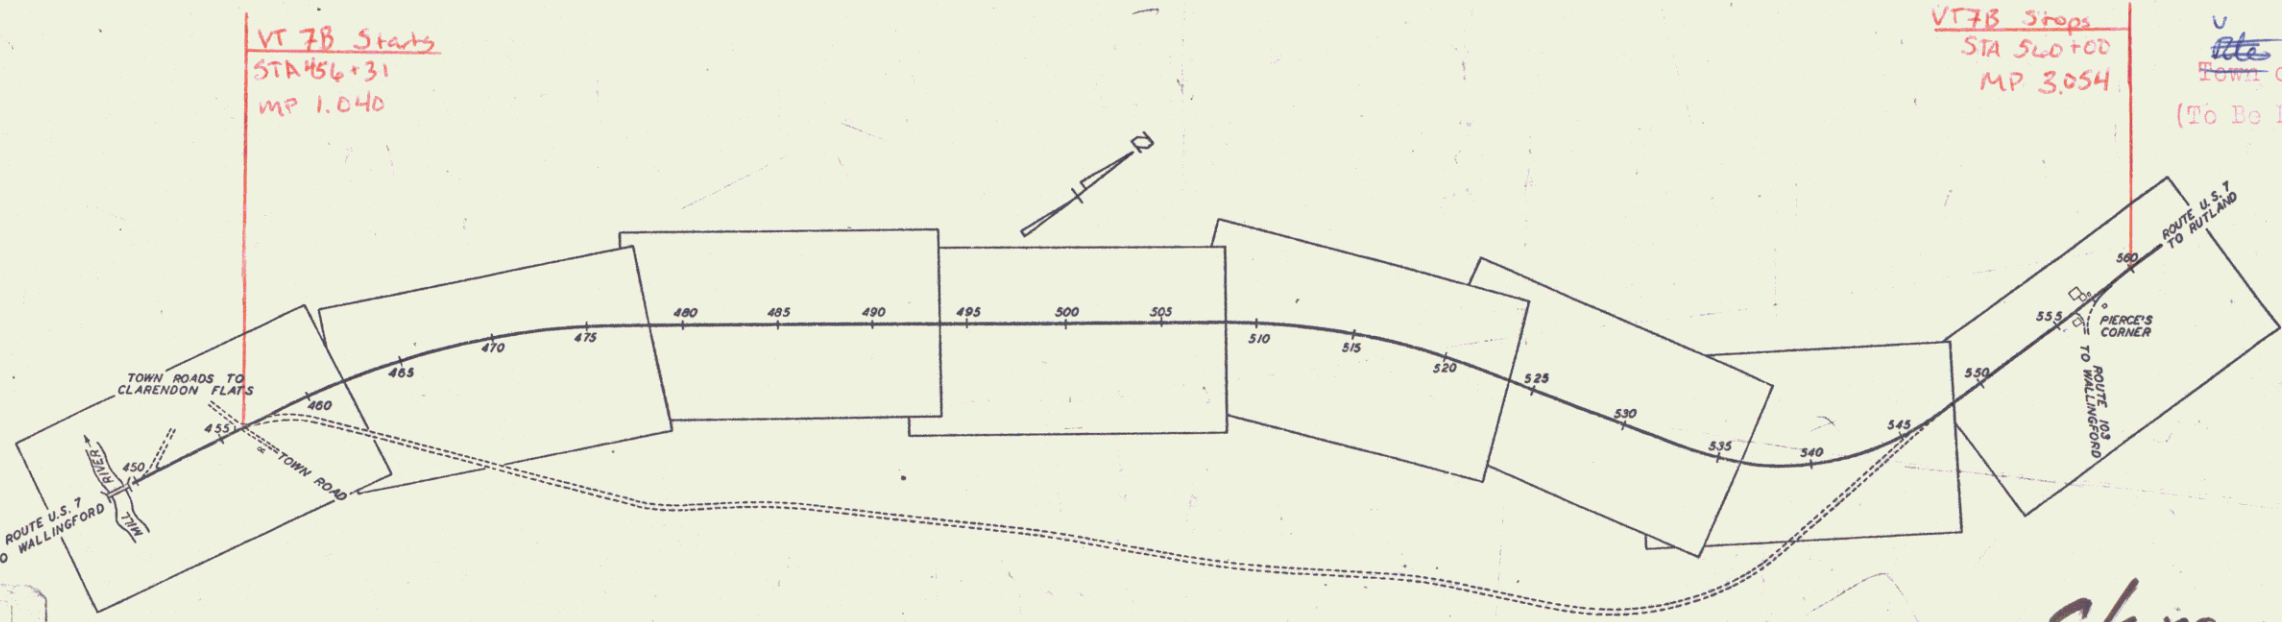

VT 7B Starts
STA 456+31
MP 1.040

VT 7B Stops
STA 540+00
MP 3.054

11/14

COUNTY LINE
TOWN LINE
FENCE LINE
STONE WALL
UNFENCED F
GUARD RAIL
TRAVELED W
RAILROAD
RETAINING W
CENTER LINE
SURVEY LINE
CULVERT
DROP INLET
TROLLEY PC
POWER POL
TELEPHONE
TREES
HEDGE

GROUND ELEVATION	DATUM	LINE
GRADE ELEVATION	DATUM	LINE

CURVE DATA	
DEFLECTION ANGLE Δ
DEGREE OF CURVE D
RADIUS OF CURVE R
TANGENT DISTANCE T
LENGTH OF CURVE L
EXTERNAL DISTANCE E
POINT OF INTERSECTION P. I.
POINT OF CURVE P. C.
POINT OF TANGENT P. T.
POINT ON TANGENT P. O. T.

SCALES	
TITLE	1" = 500'
TYPICAL	1" = 2'
PLAN	1" = 50'
HORIZONTAL	1" = 50'
PROFILE VERTICAL	1" = 10'
CROSS SECTIONS	1" = 5'

THESE PLANS ARE SUBJECT TO SUCH REVISIONS AS MAY BE REQUIRED BY THE PUBLIC ROADS ADMINISTRATION OR THE COMMISSIONER OF HIGHWAYS.

CONSTRUCTION IS TO BE CARRIED ON IN ACCORDANCE WITH THE PLANS AND THE STANDARD ROAD AND BRIDGE SPECIFICATIONS OF 1936, AS APPROVED DECEMBER 29TH, 1936 BY THE PUBLIC ROADS ADMINISTRATION, INCLUDING ALL SUBSEQUENT APPROVED REVISIONS AND SUCH REVISED SPECIFICATIONS AND SPECIAL PROVISIONS AS ARE SUBMITTED WITH THE PLANS.

Clarendon
sect II
Not Built



APPROVED	APPROVED	SERIES F No. FILED
ROAD ENGINEER	DISTRICT HIGHWAY COMMISSIONER	SHEET 1 OF

DIST. # 3 Plans

Scale	1" = 40'
Author	
Date	1/15/52

Scale	1" = 40'
Author	
Date	1/15/52



Scale	1" = 40'
Author	
Date	1/15/52

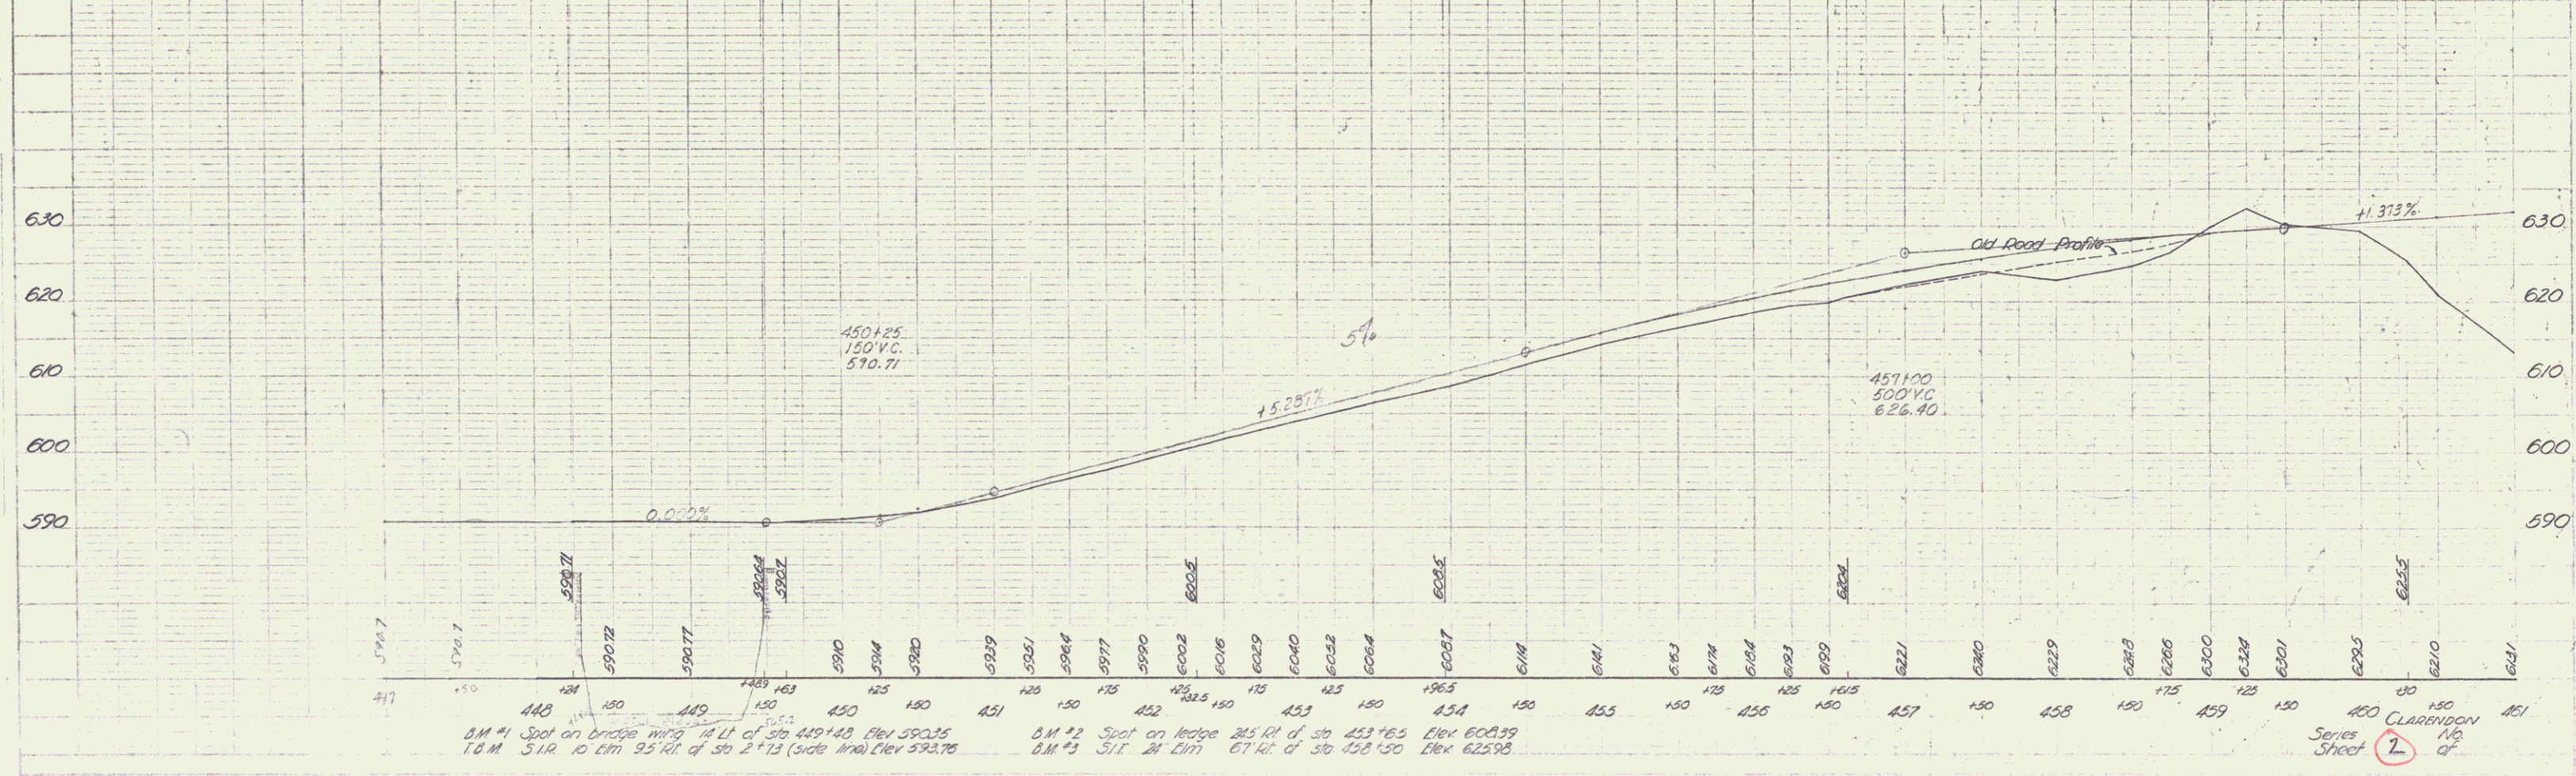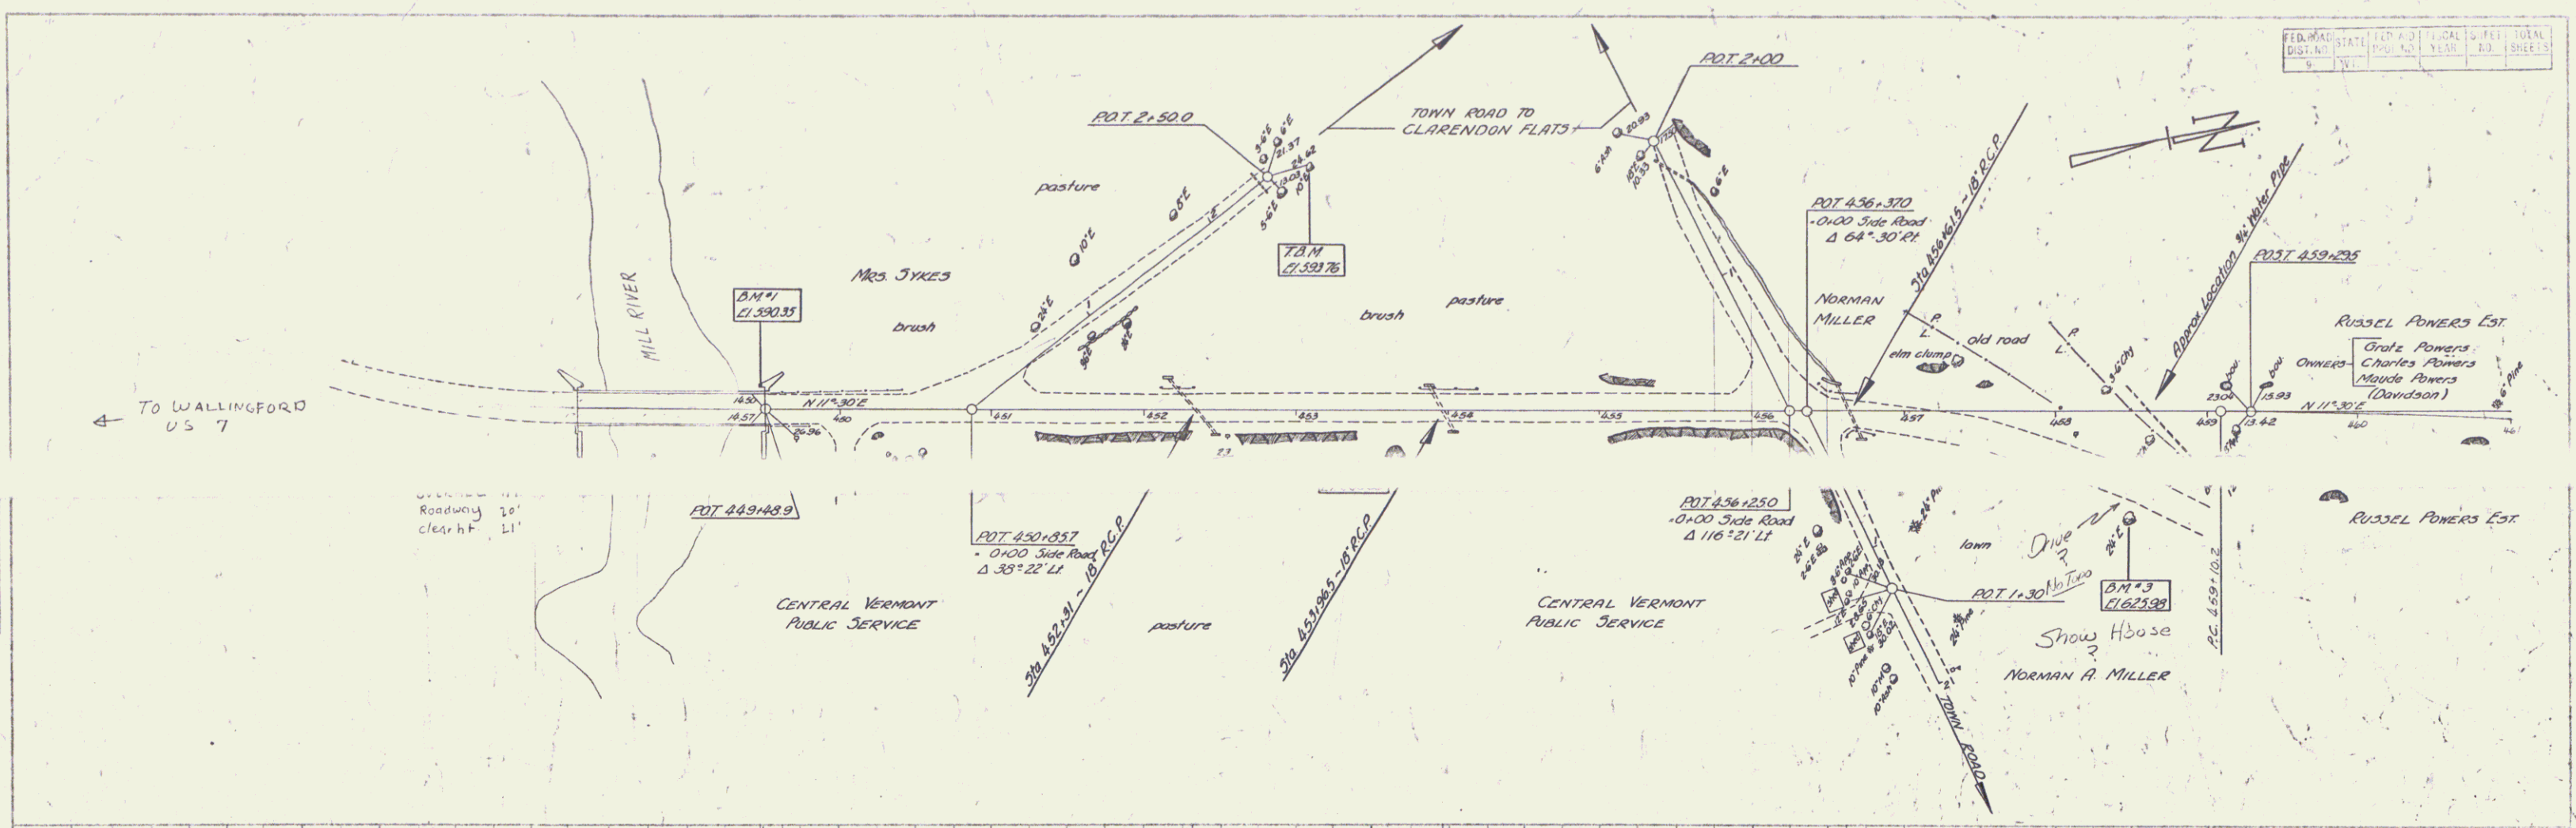

B.M. #1 Spot on bridge pier 14' LI of sta 449+48 Elev 590.25
 T.B.M. S.I.P. 10 cm 95' RI of sta 2+73 (side line) Elev 593.76
 B.M. #2 Spot on ledge 245' RI of sta 453+65 Elev 608.39
 B.M. #3 S.I.T. 24' Elm 67' RI of sta 458+50 Elev 625.98



Series Sheet 2 of 2
 CLARENDON Vt.

FED. ROAD DIST. NO.	STATE	CON. AD. PROJ. NO.	FISCAL YEAR	SHEET NO.	TOTAL SHEETS
9	VT.				

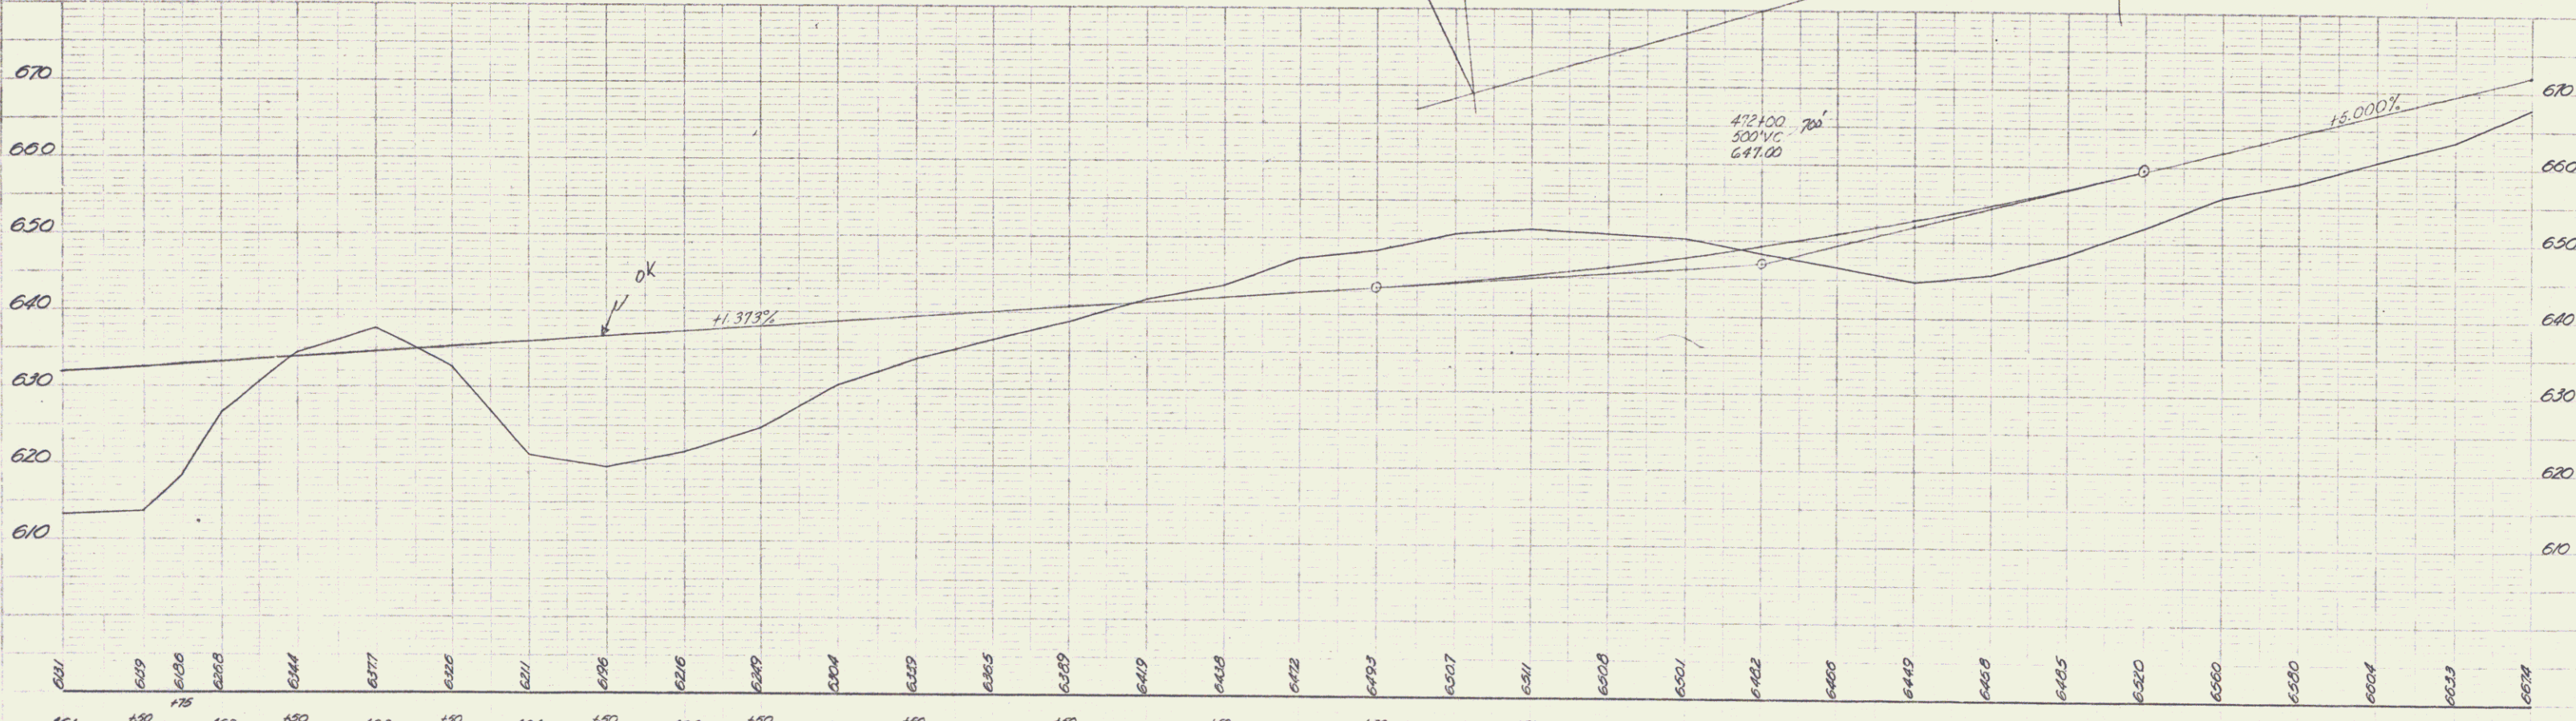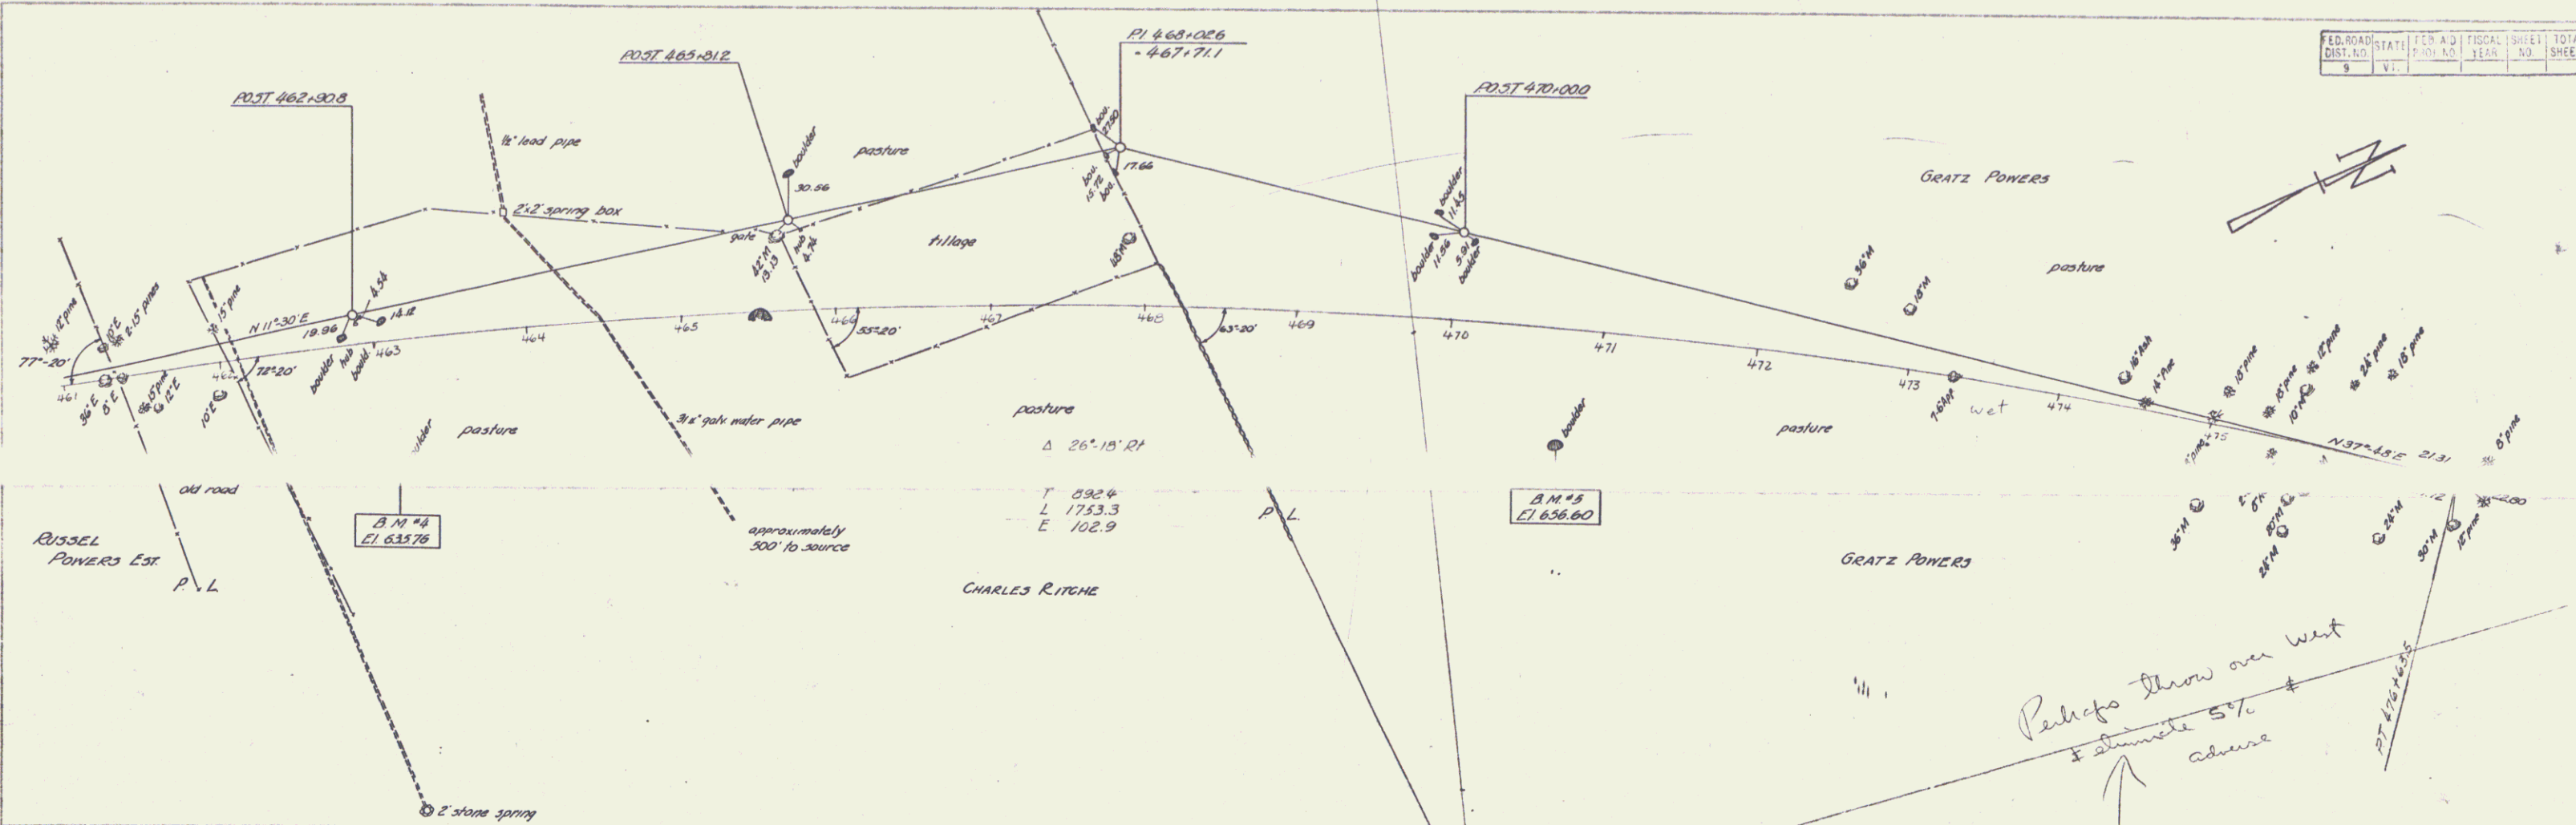

451 150 452 150 453 150 454 150 455 150 456 150 457 150 458 150 459 150 460 150 461 150 462 150 463 150 464 150 465 150 466 150 467 150 468 150 469 150 470 150 471 150 472 150 473 150 474 150 475 150 476 150 477
 0.M #4 Spot on 2nd boulder 274
 04 RI of site 463+04 Elev 635.76
 470+75 62680
 476 CLARENDON Series 16 Sheet 3 of 3

PROJECT	DATE	SCALE	SHEET NO.	TOTAL SHEETS
			14	

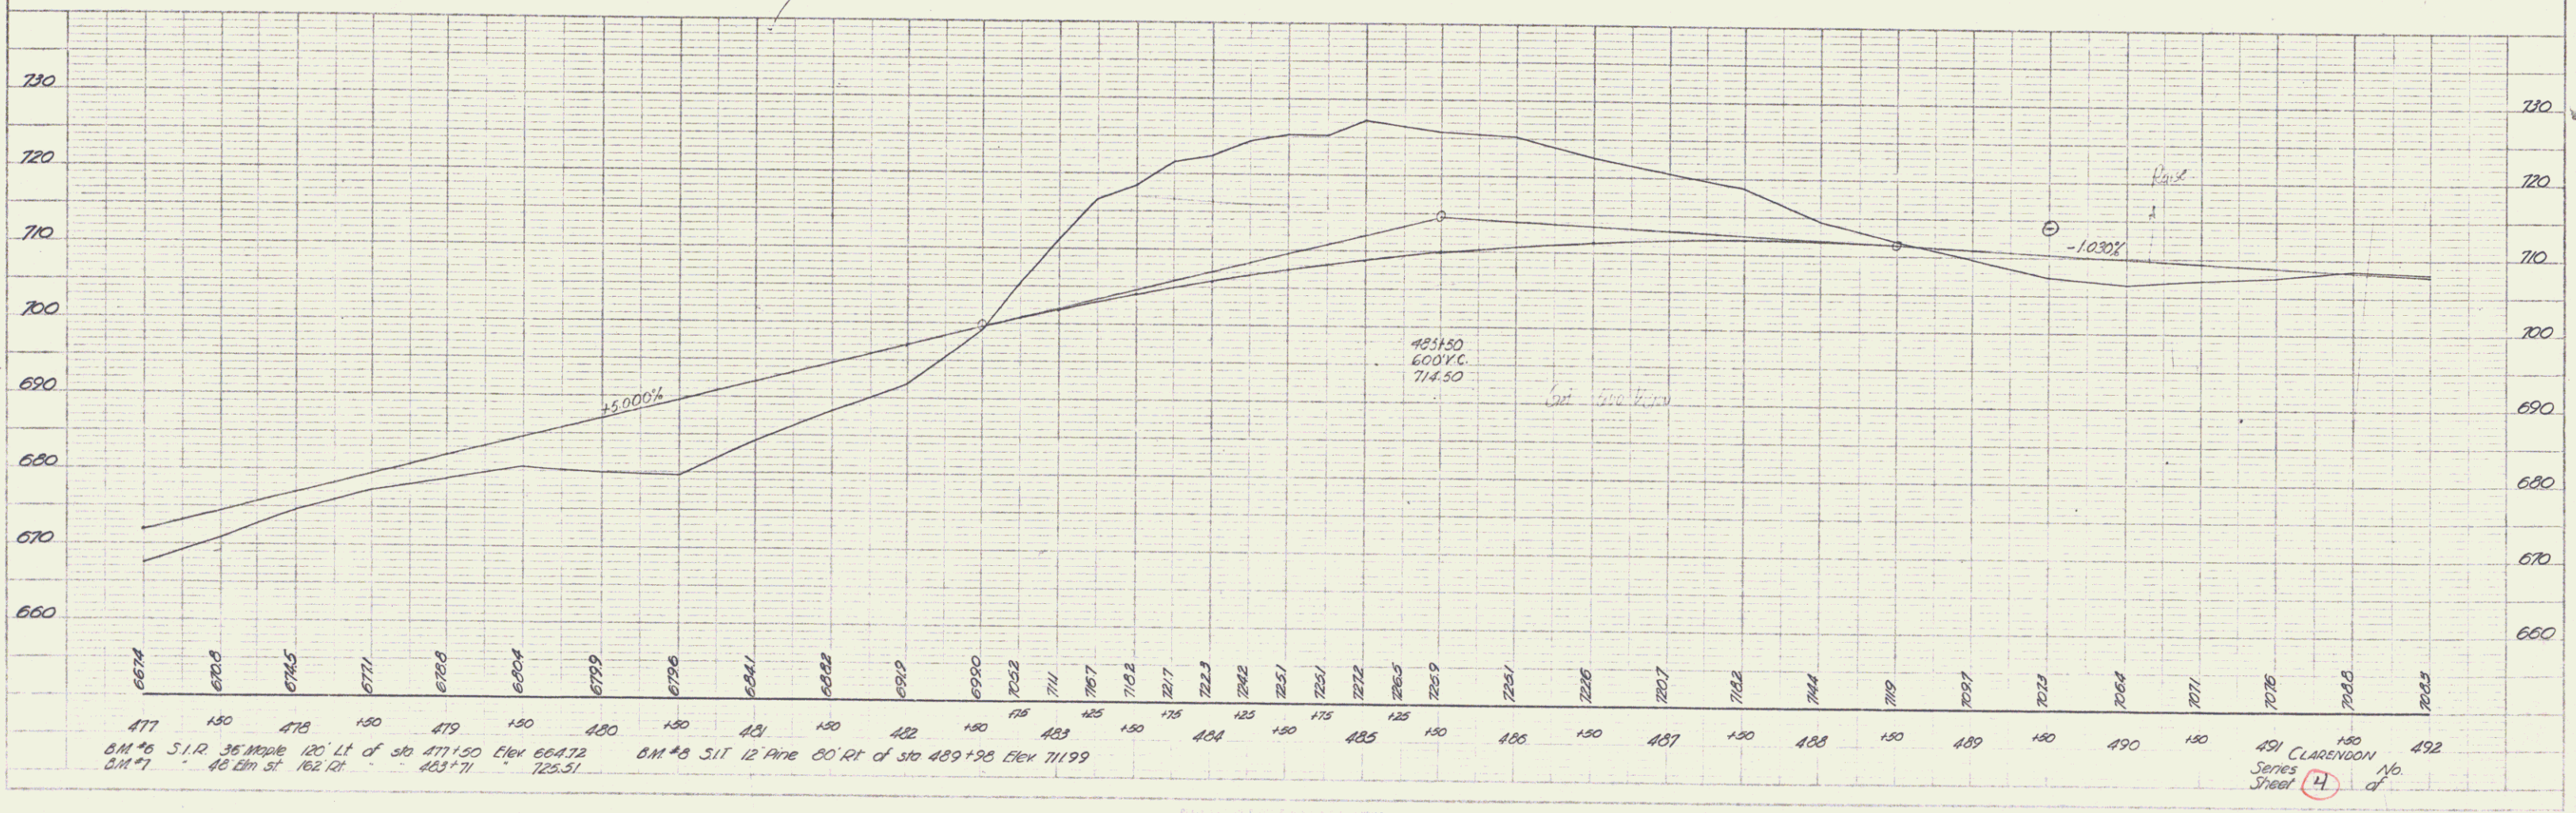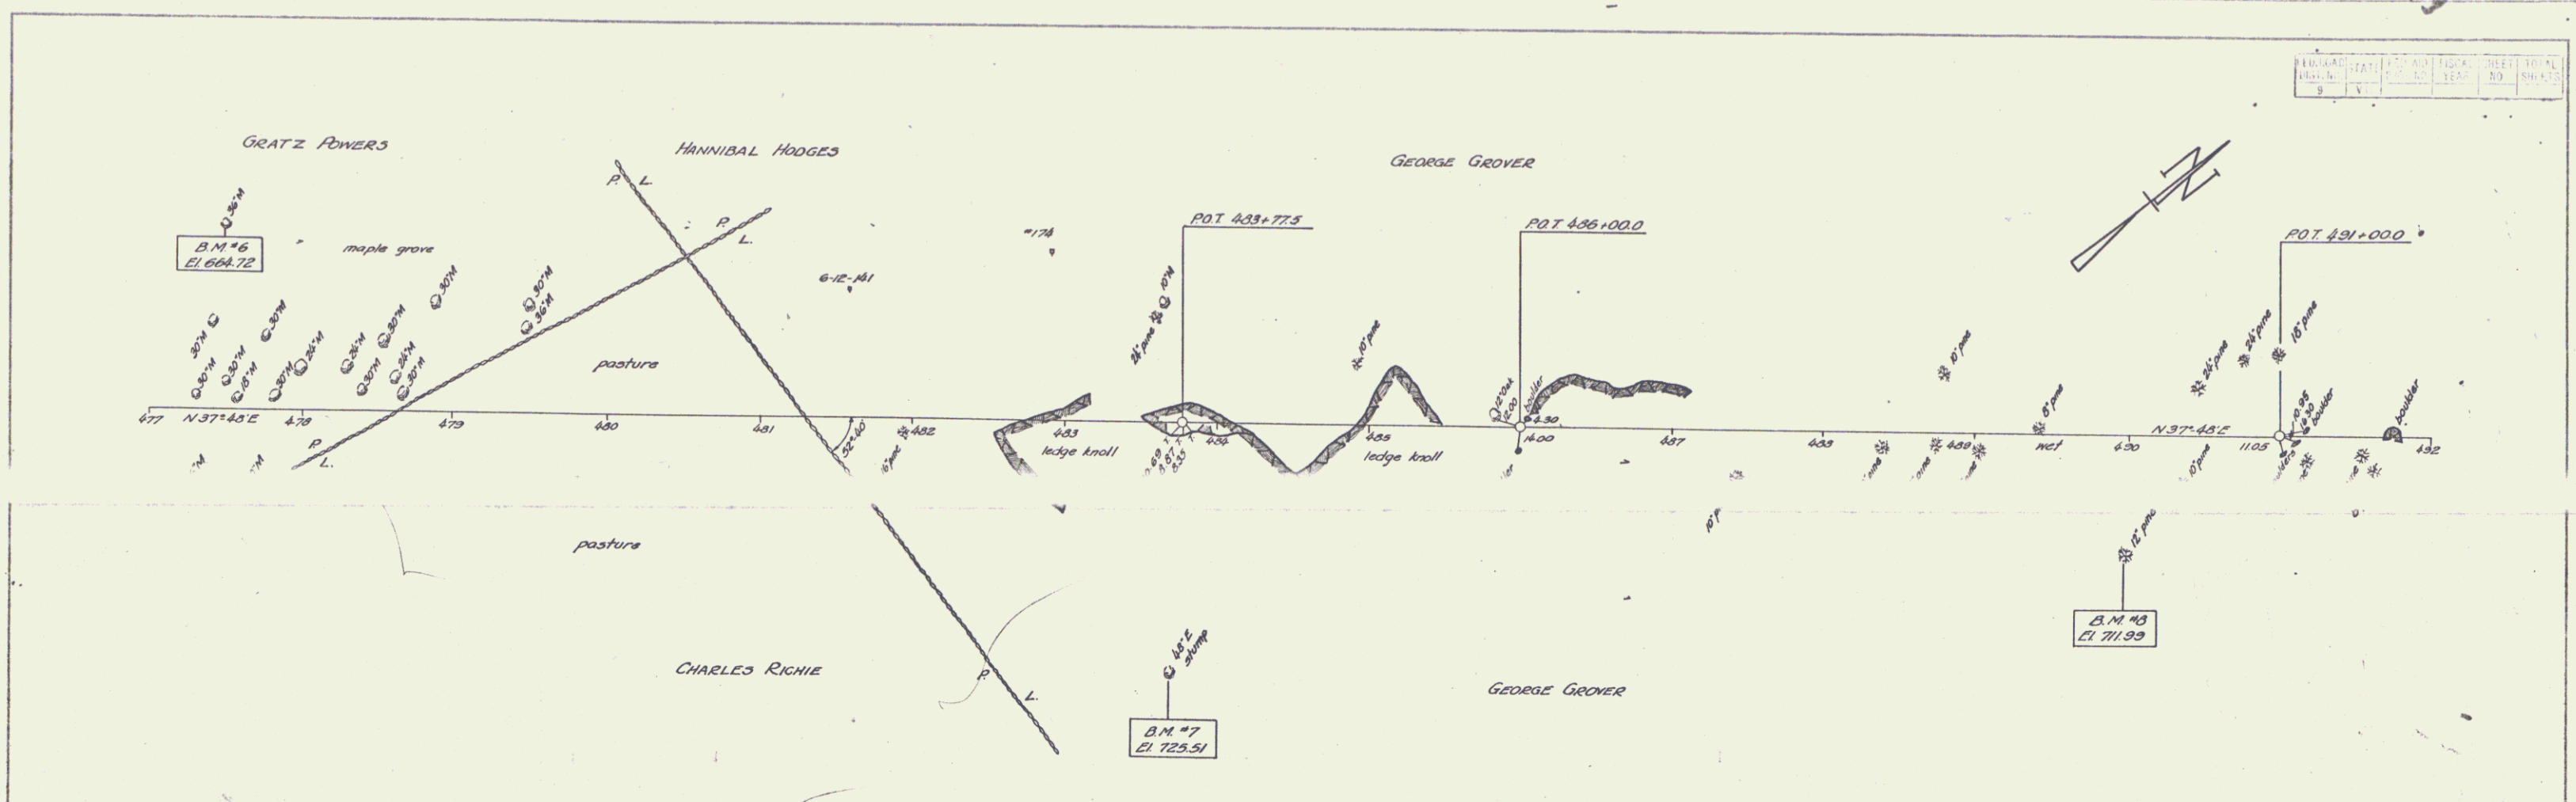

DATE	BY	CHKD.

PLAN	PROF.
DATE	DATE
BY	BY
CHKD.	CHKD.

DATE	BY	CHKD.

B.M. #6 S.I.R. 36 Maple 120' Lt of sta 477+50 Elev 664.72
 B.M. #7 40 Elm St 162 Rt 483+71 Elev 725.51
 B.M. #8 S.I.T. 12 Pine 80' Rt of sta 489+98 Elev 711.99



491 CLARENDON
 Series No. 14
 Sheet of

REVISION	DATE	BY	TO
1			

DATE	BY
4-22	SM

PROJECT	NO. 1
DATE	4-22


PROJECT	NO. 1
DATE	4-22

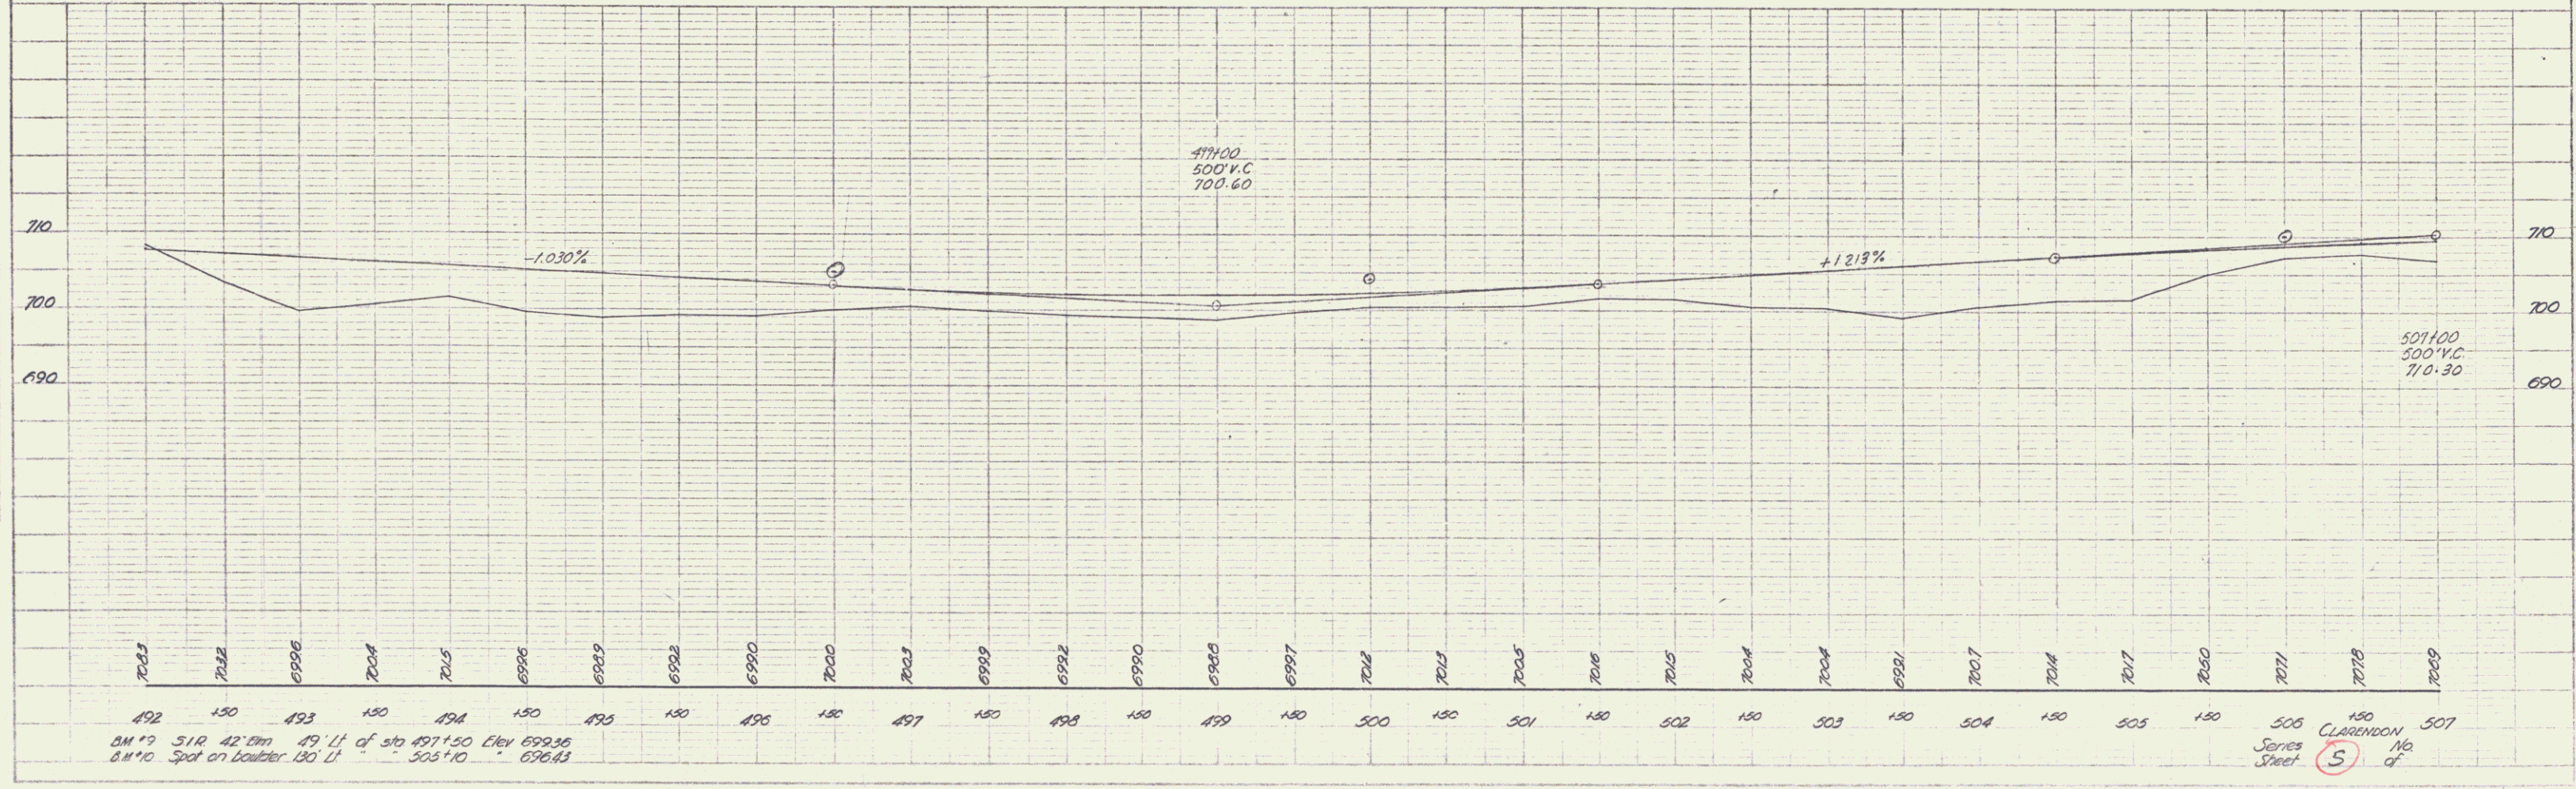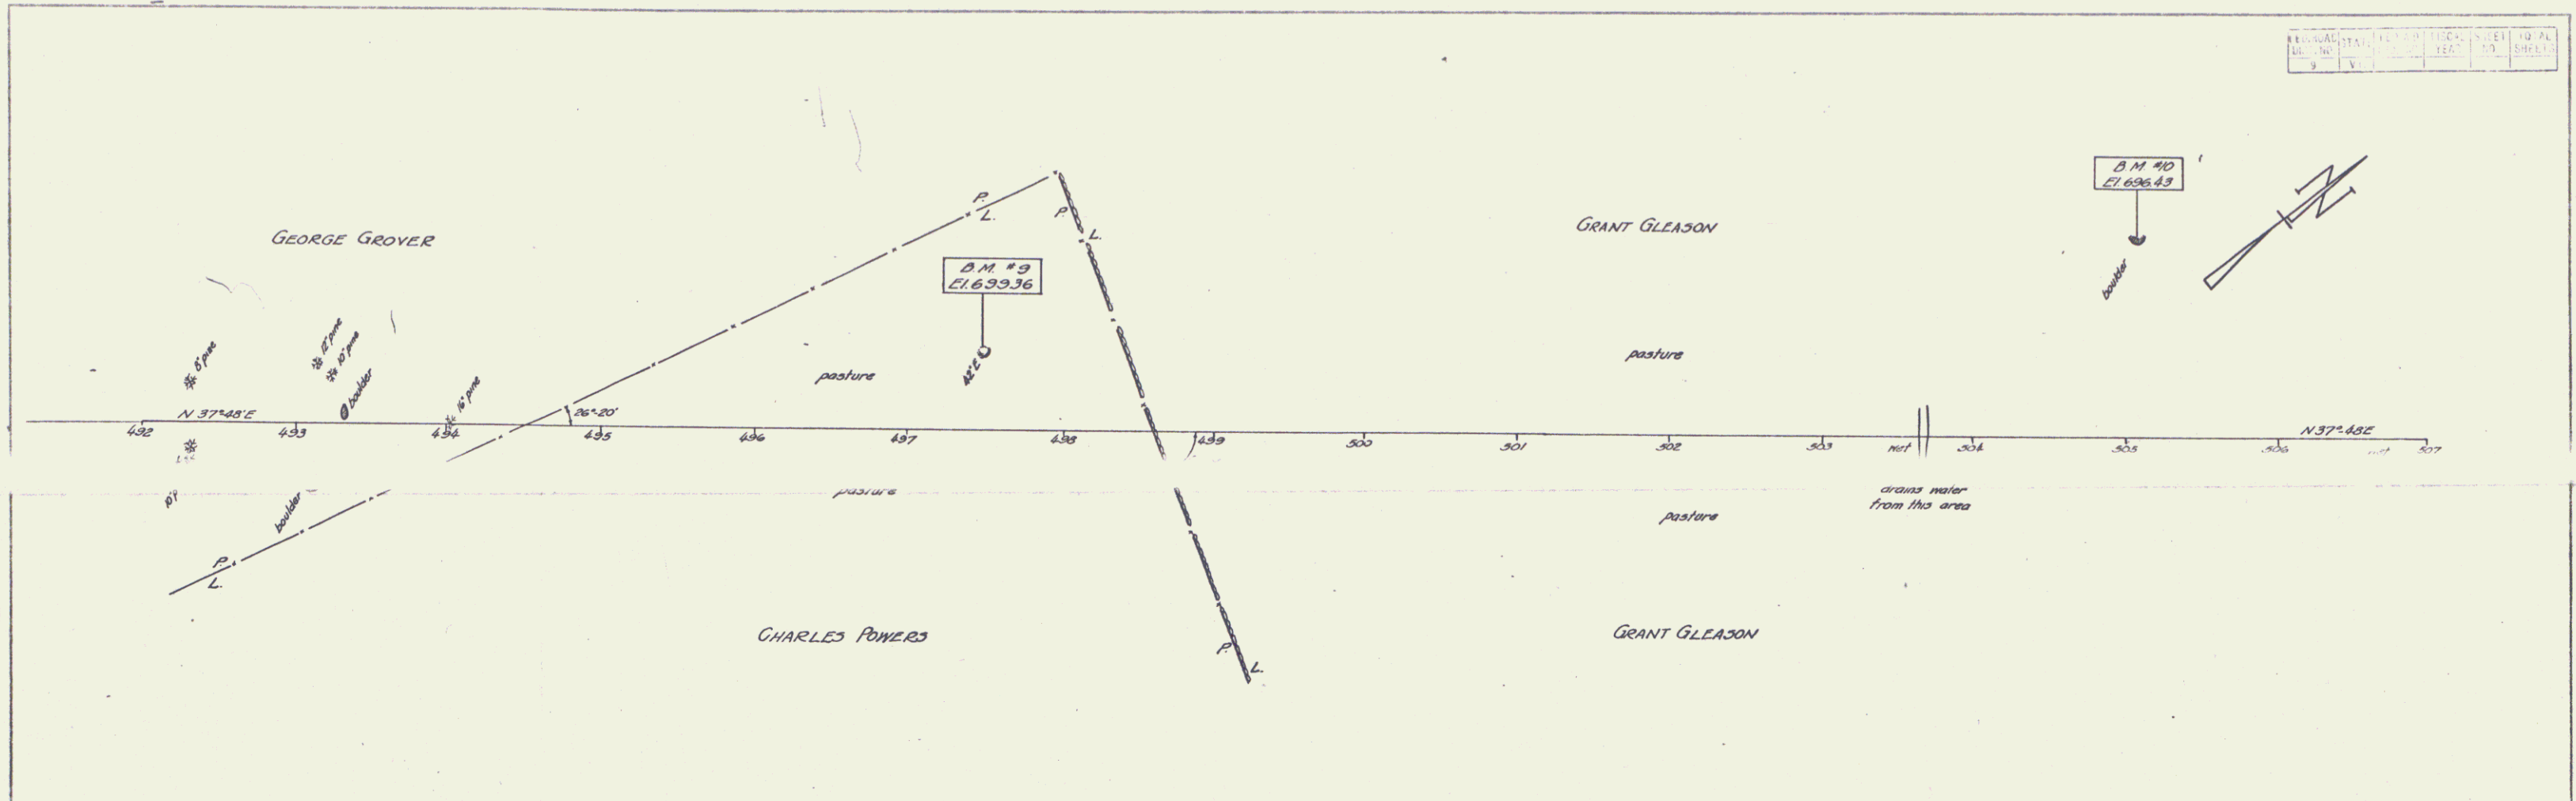

BM #9 51R 42" 49' 11" of 510 Elev 699.36
 6.8" 10 Spot on Boulder 130 LI 506' 10 696.43


501+00 500' V.C. 710.30
 471+00 500' V.C. 700.60
 Series Sheet 5 of 5
 CLARENDON No. 507

5

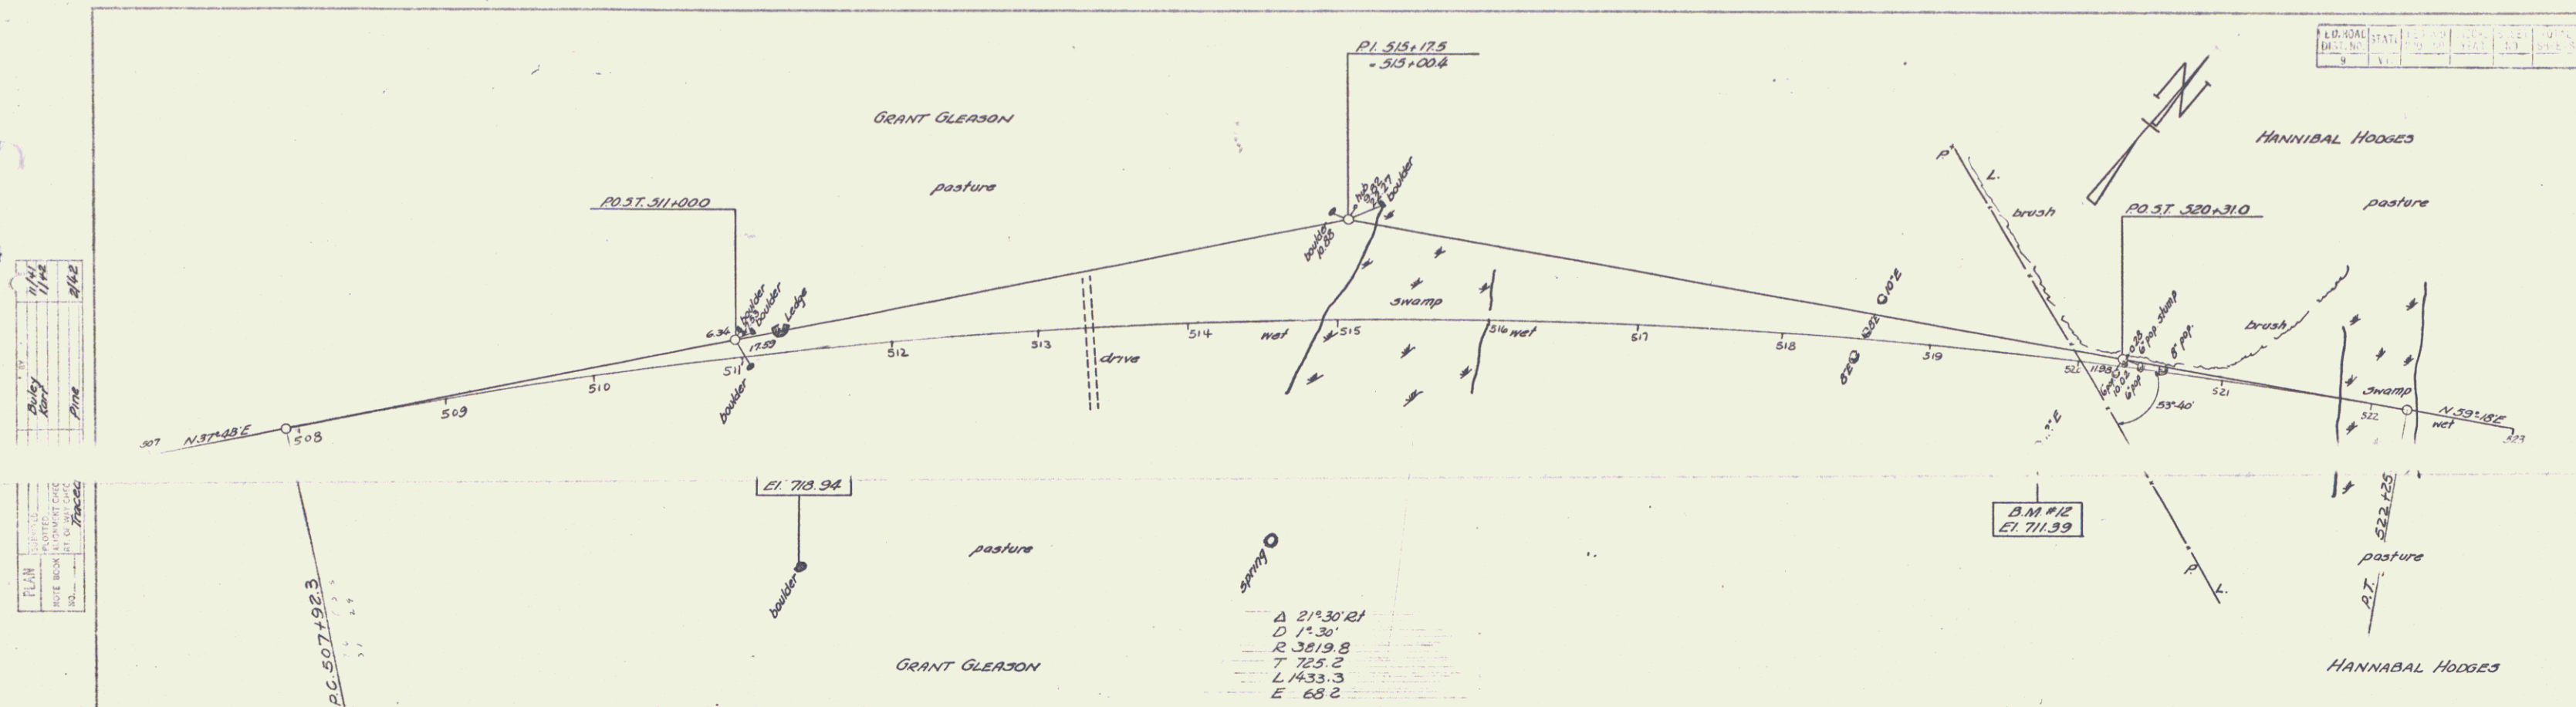

PLAN
 DATE: 1/14/42
 BY: Bully Bully
 FOR: ROUTE 1000 IN CLARENDON CO. VA.
 SHEET NO. 6 OF 10

PLAN
 DATE: 1/14/42
 BY: Bully Bully
 FOR: ROUTE 1000 IN CLARENDON CO. VA.
 SHEET NO. 6 OF 10


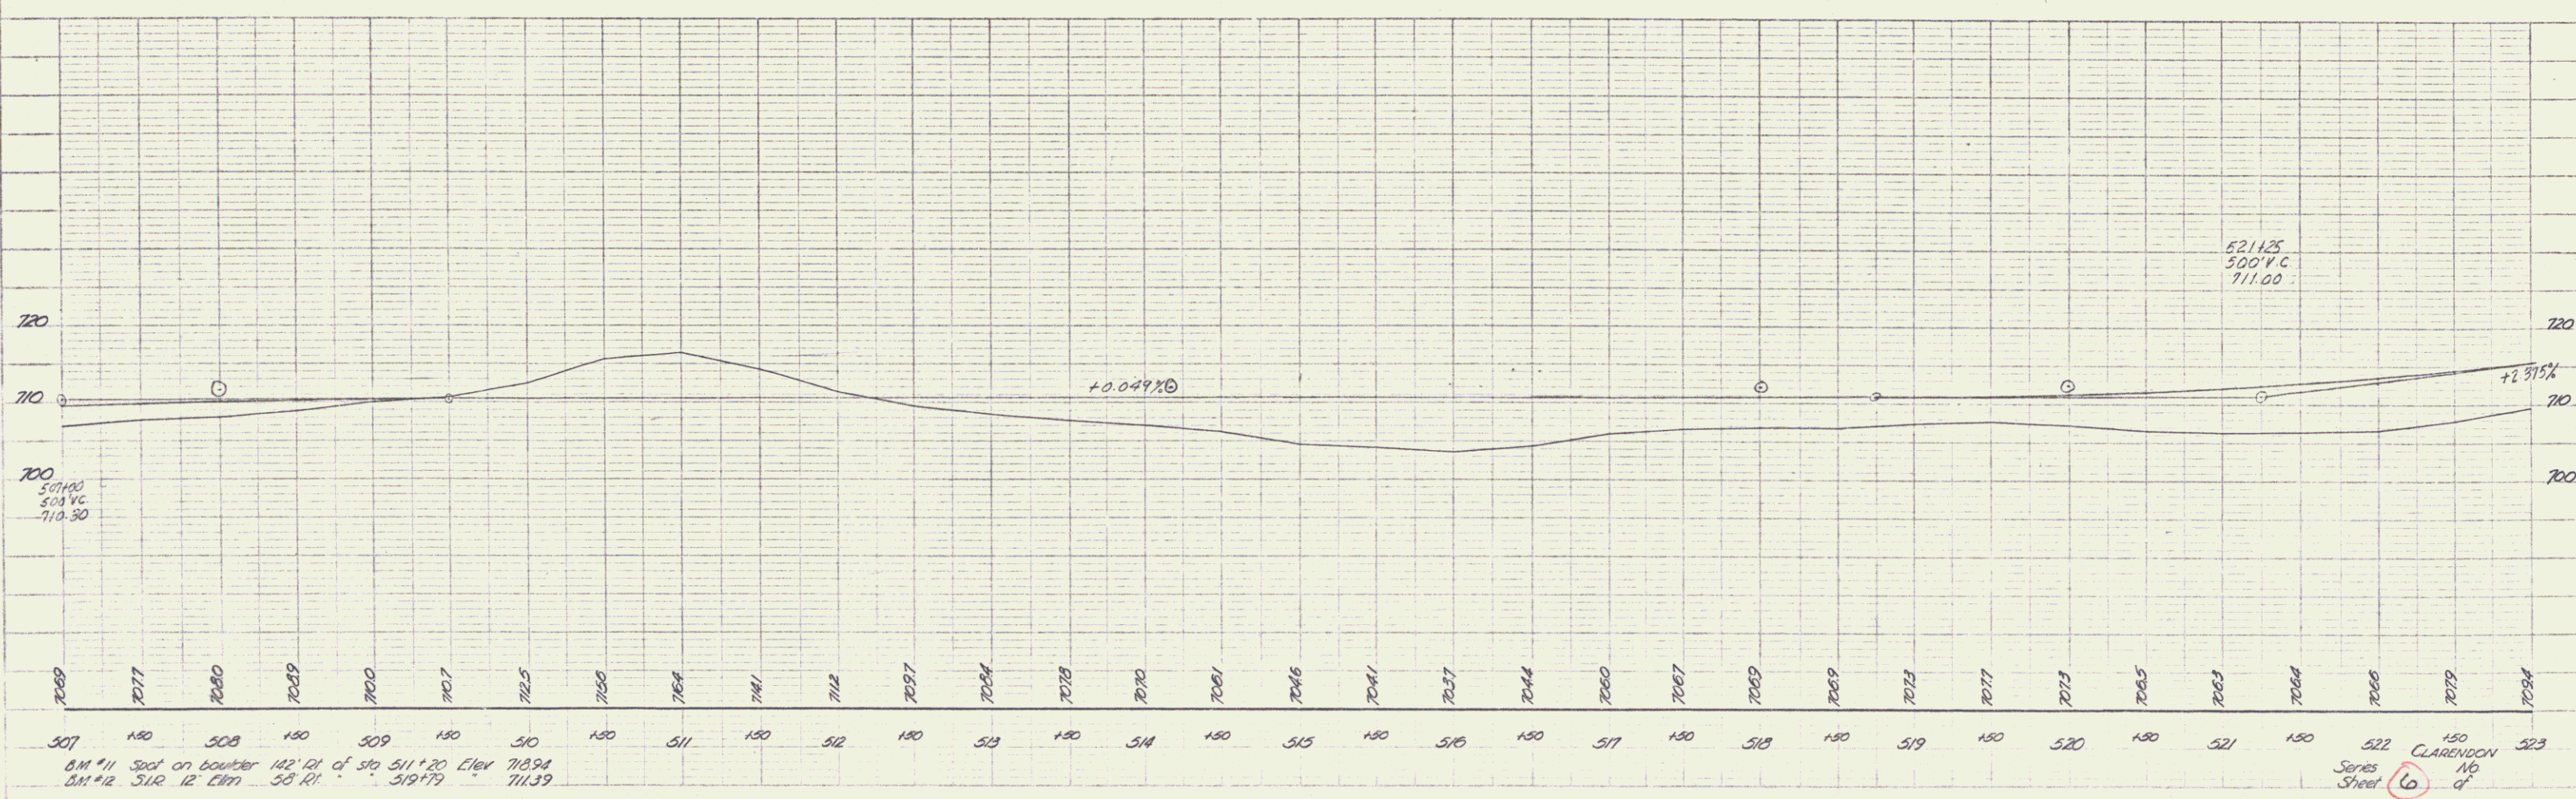


FEDERAL DIST. NO.	STATE	TOWNSHIP	RANGE	SECTION
9	Vt.			

PLAN
 1/4" = 1' 0"
 2/12



PLAN
 1/4" = 1' 0"
 2/12

PLAN
 1/4" = 1' 0"
 2/12

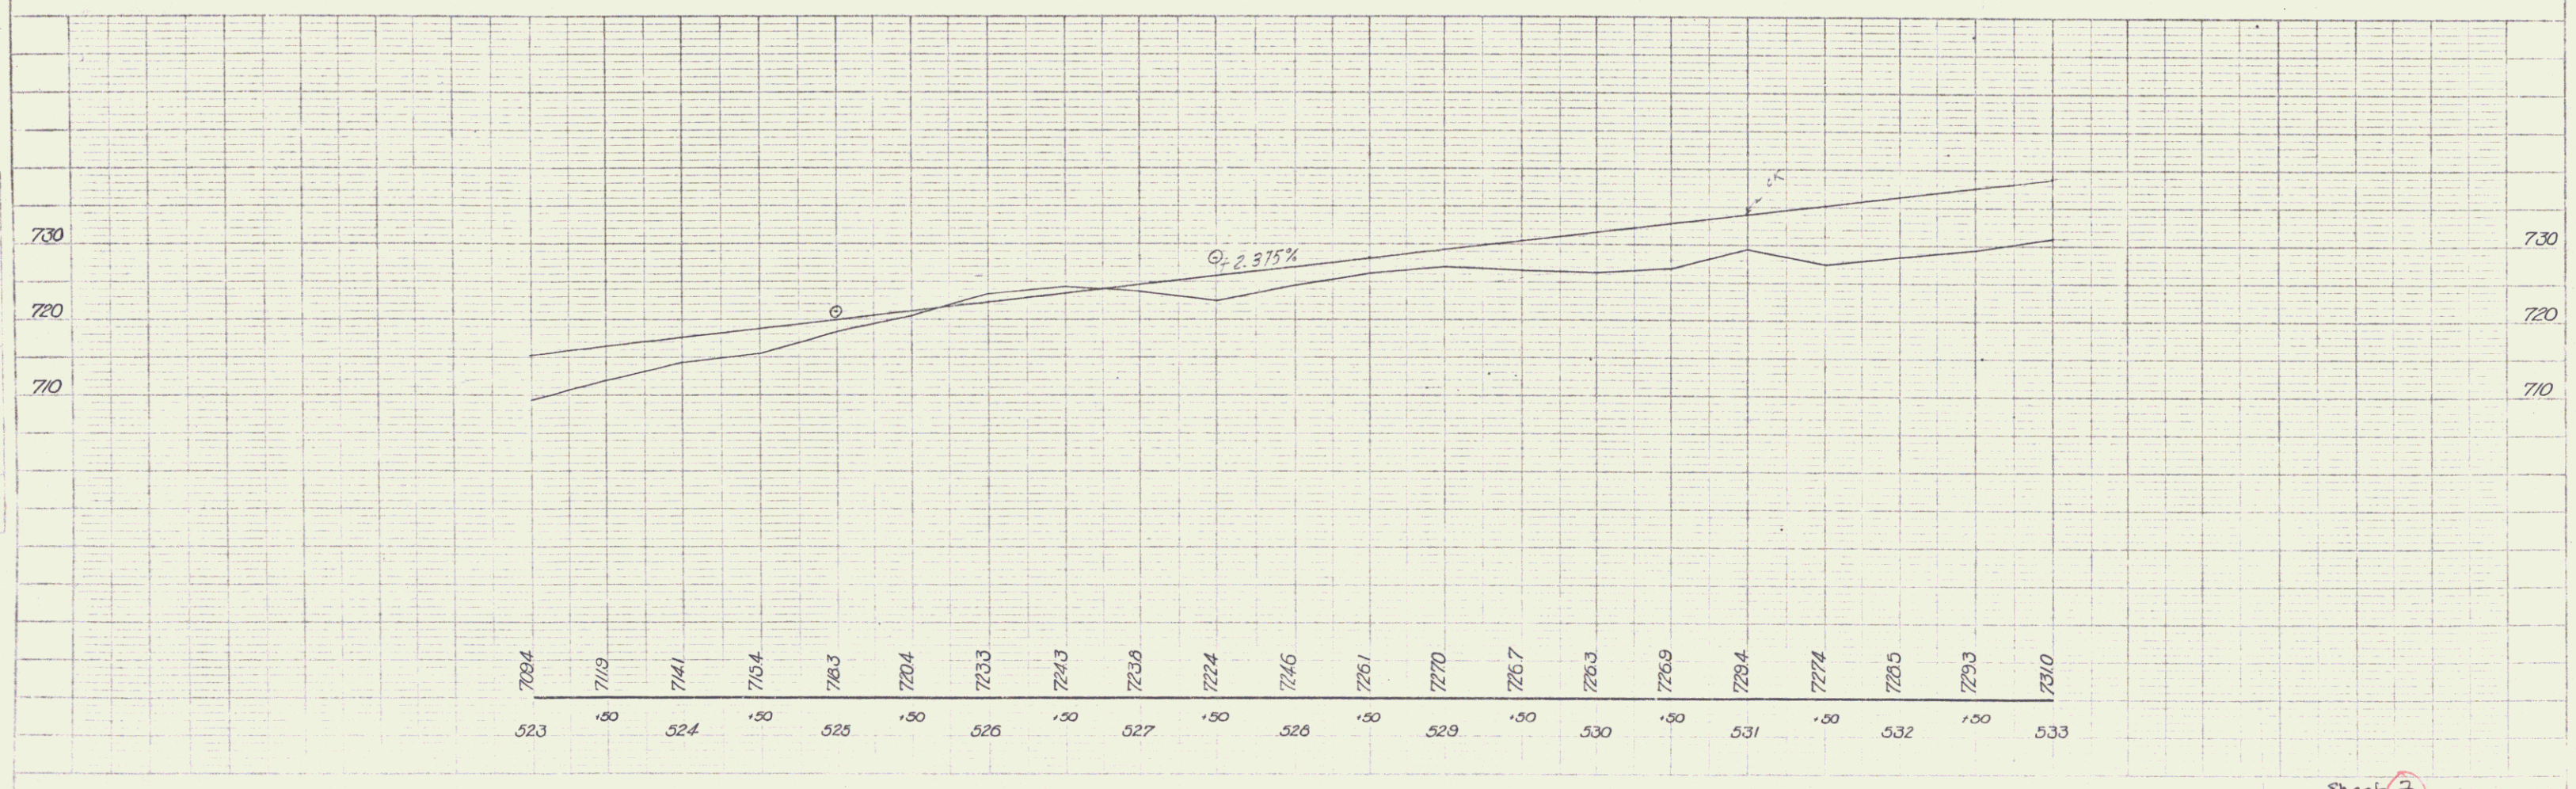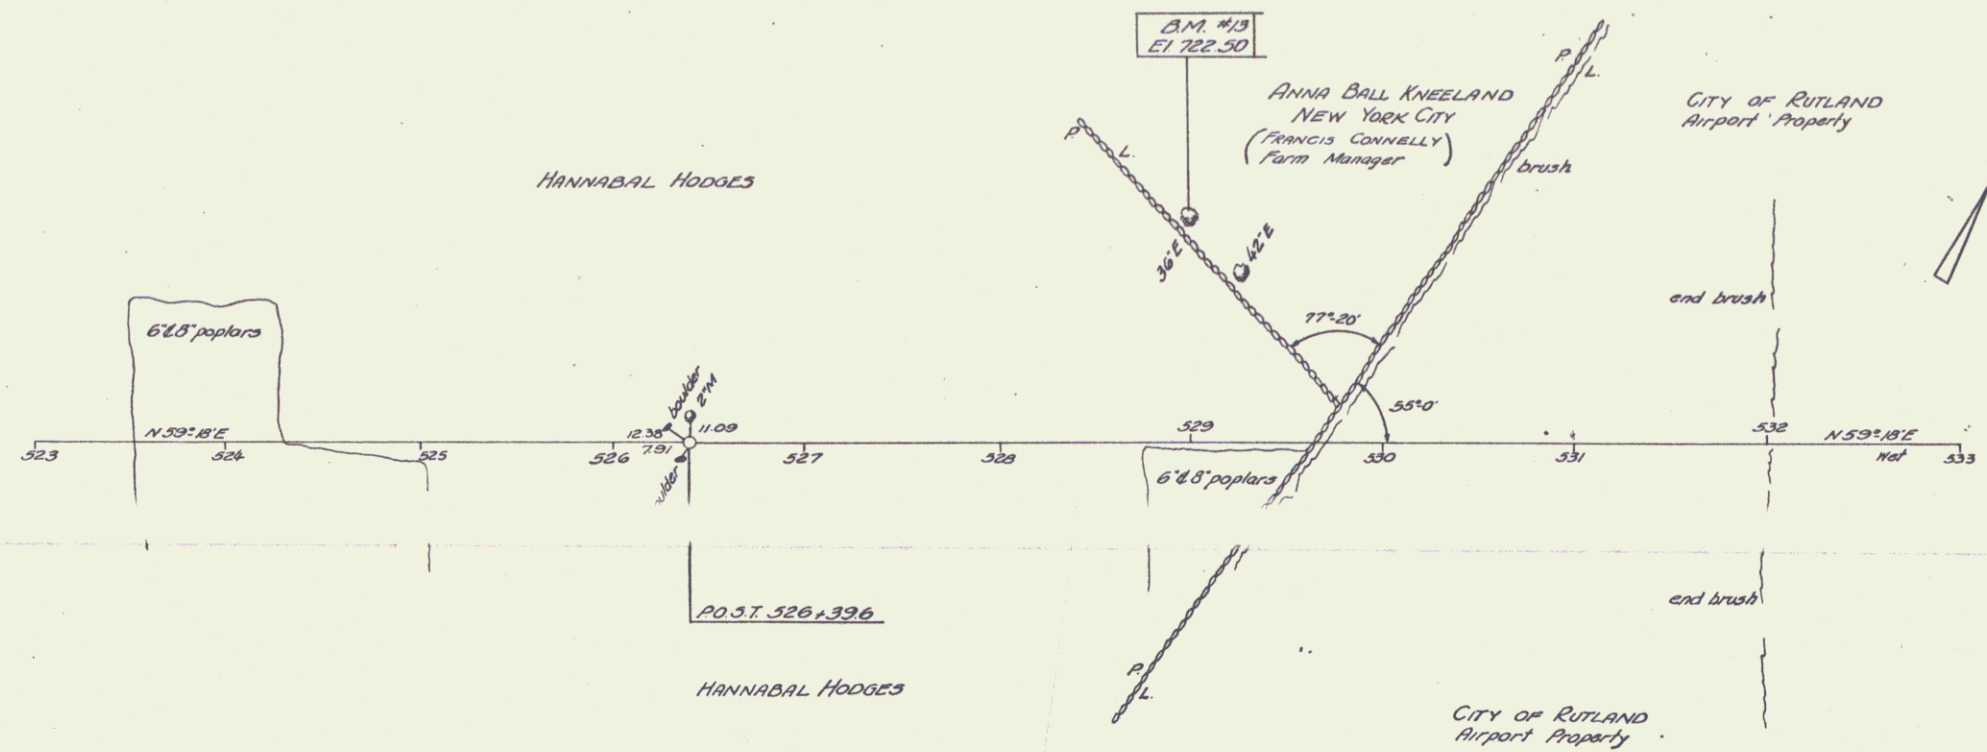

Sheet 7
 Charles M.
 7

FED. ROAD DIST. NO.	STATE	SECTION	SHEET NO.	TOTAL SHEETS
9	Vt.		8	10

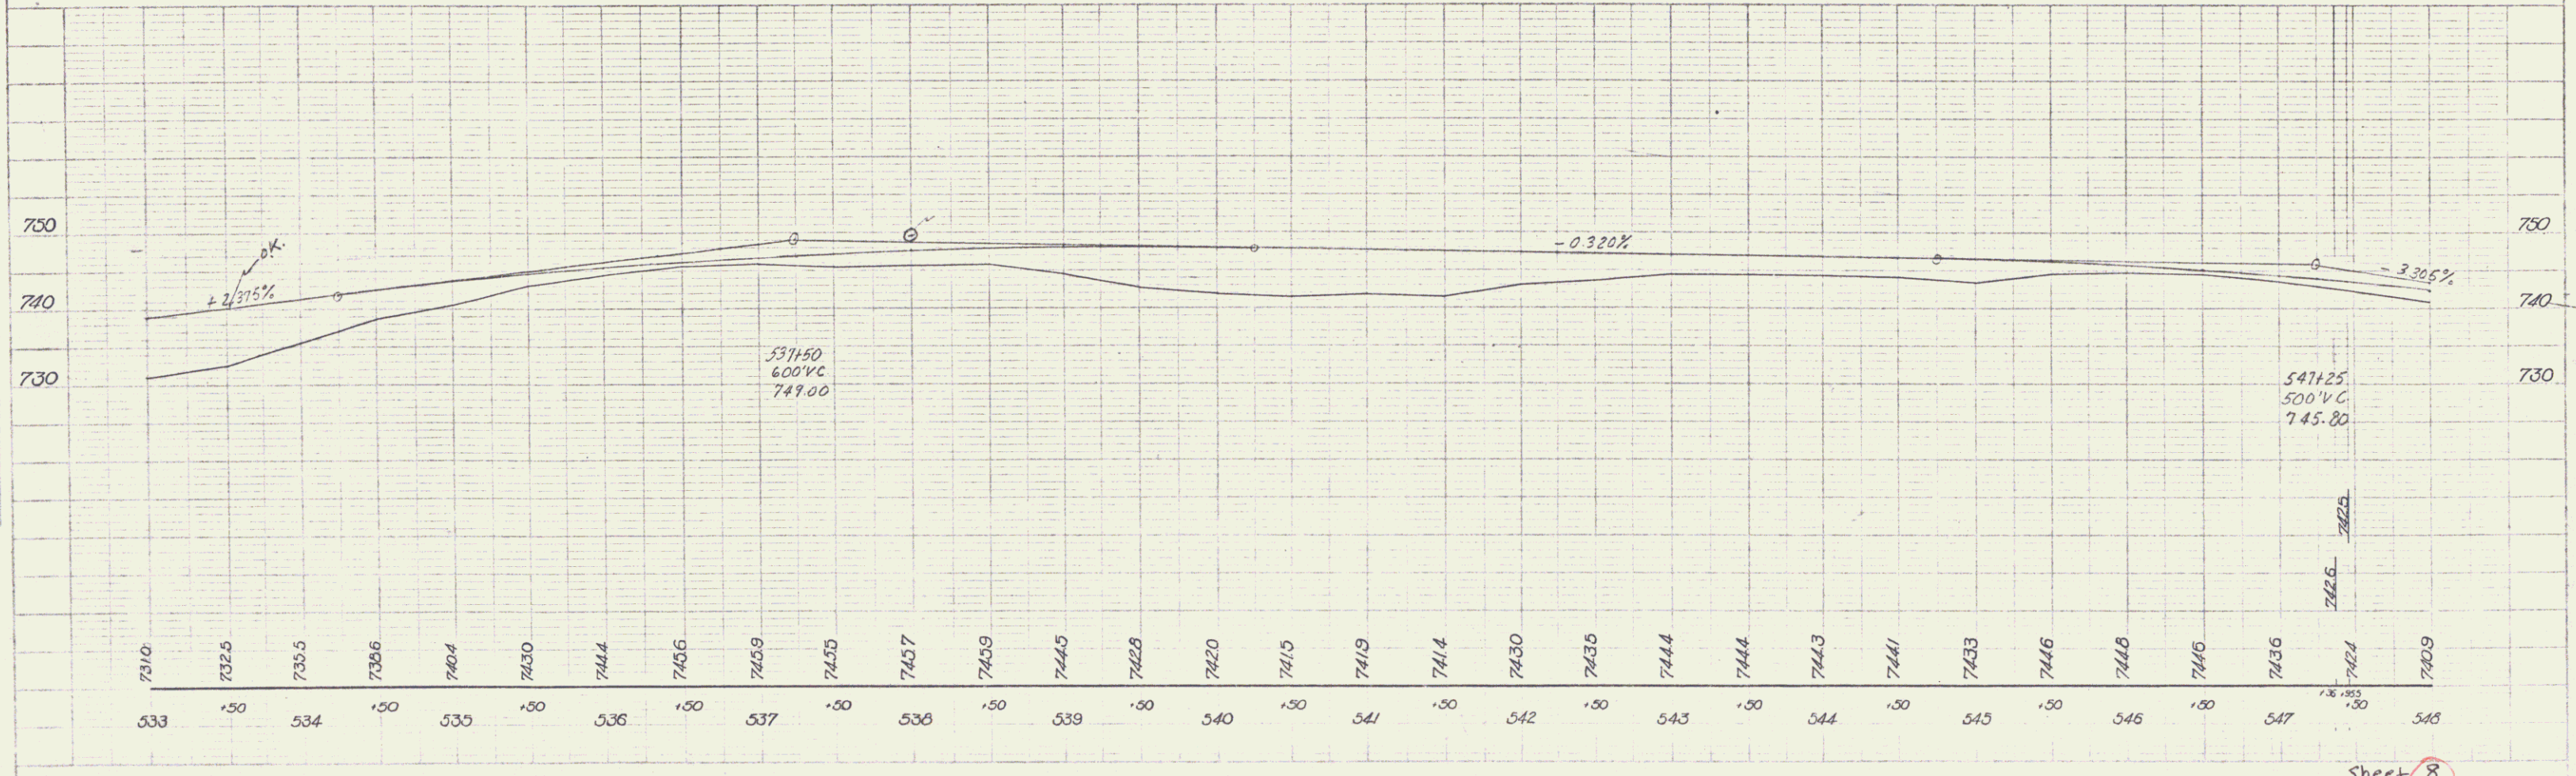
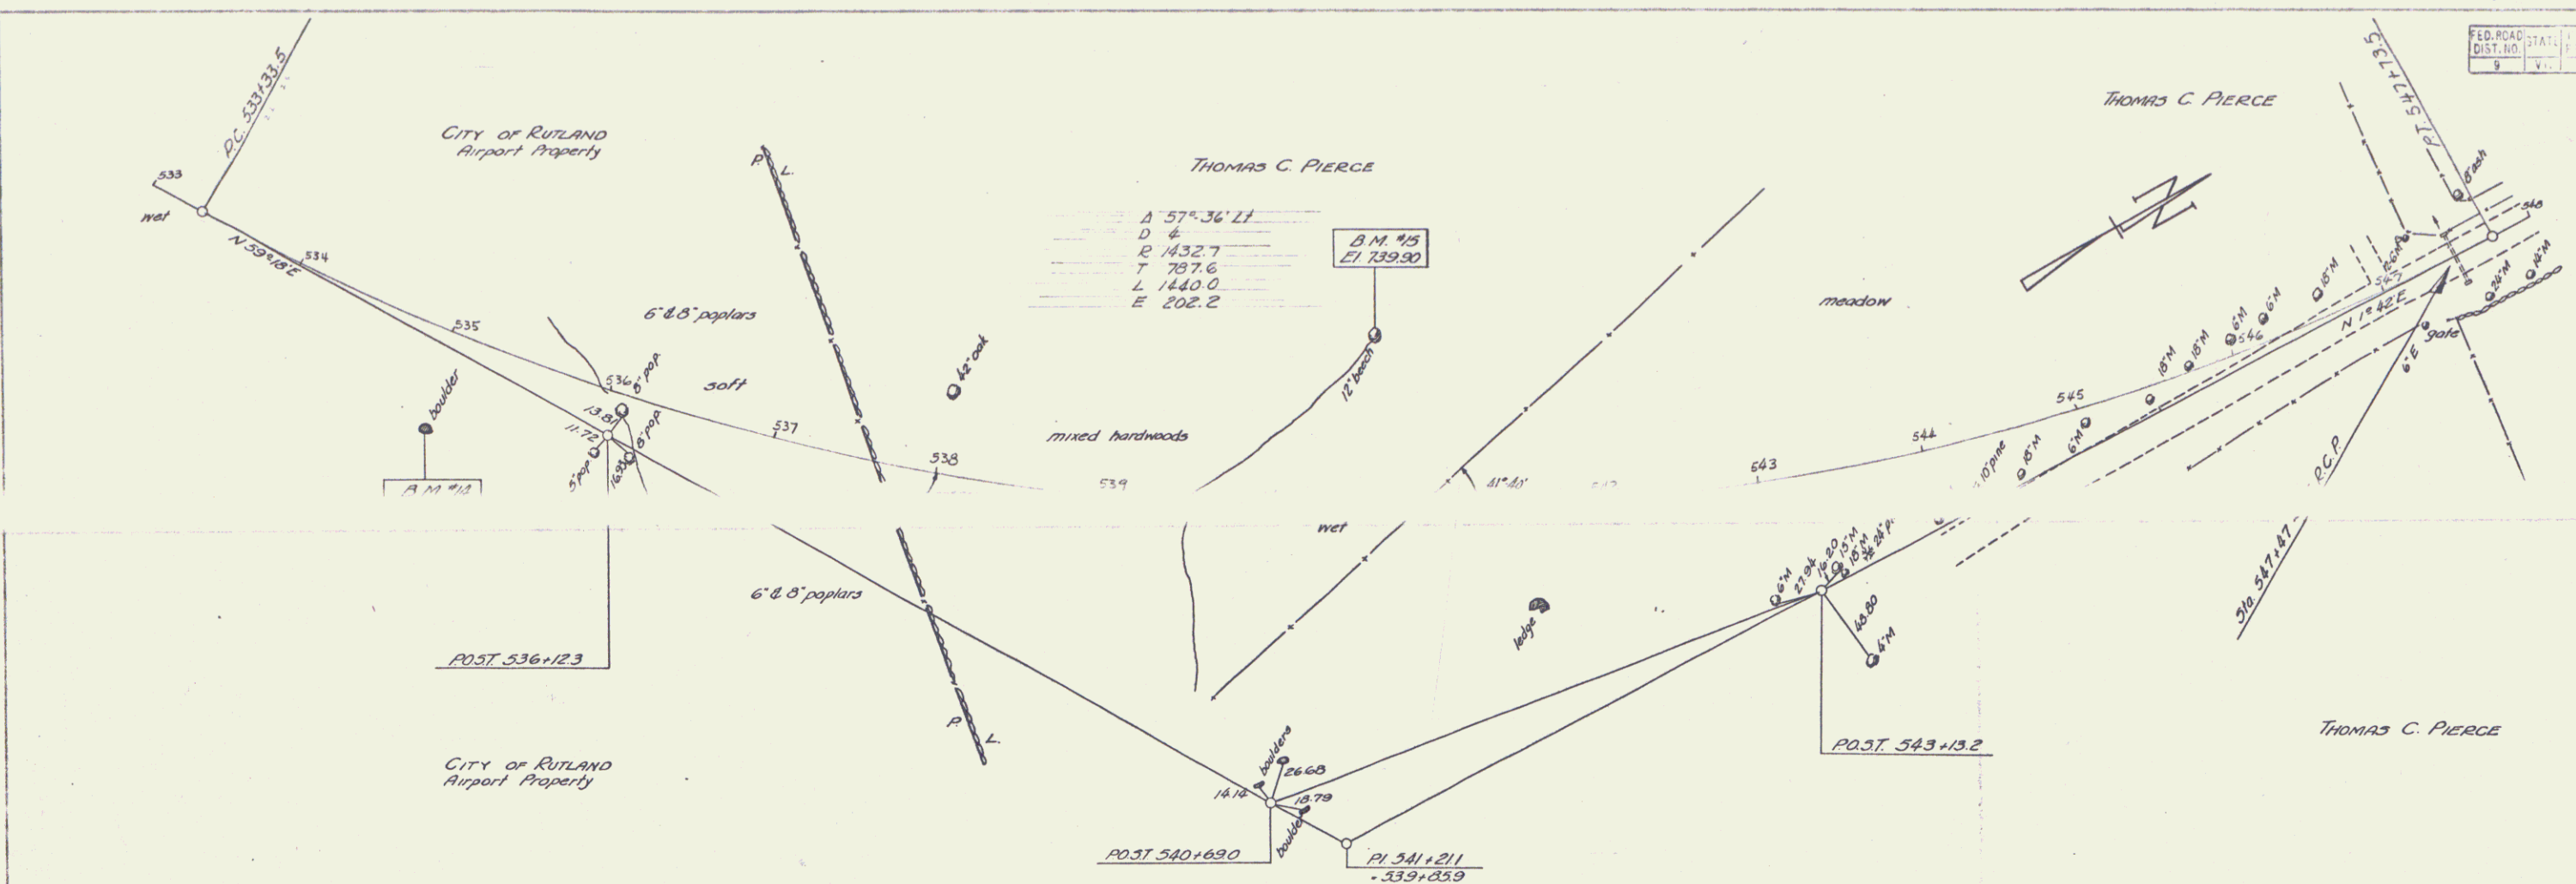


DATE	1/12
BY	AKC
CHECKED	AKC

PLAN	PROPOSED
REVISION	NOTED
DATE	1/12
BY	AKC
CHECKED	AKC

DATE	1/12
BY	AKC
CHECKED	AKC

Sheet 8
 8

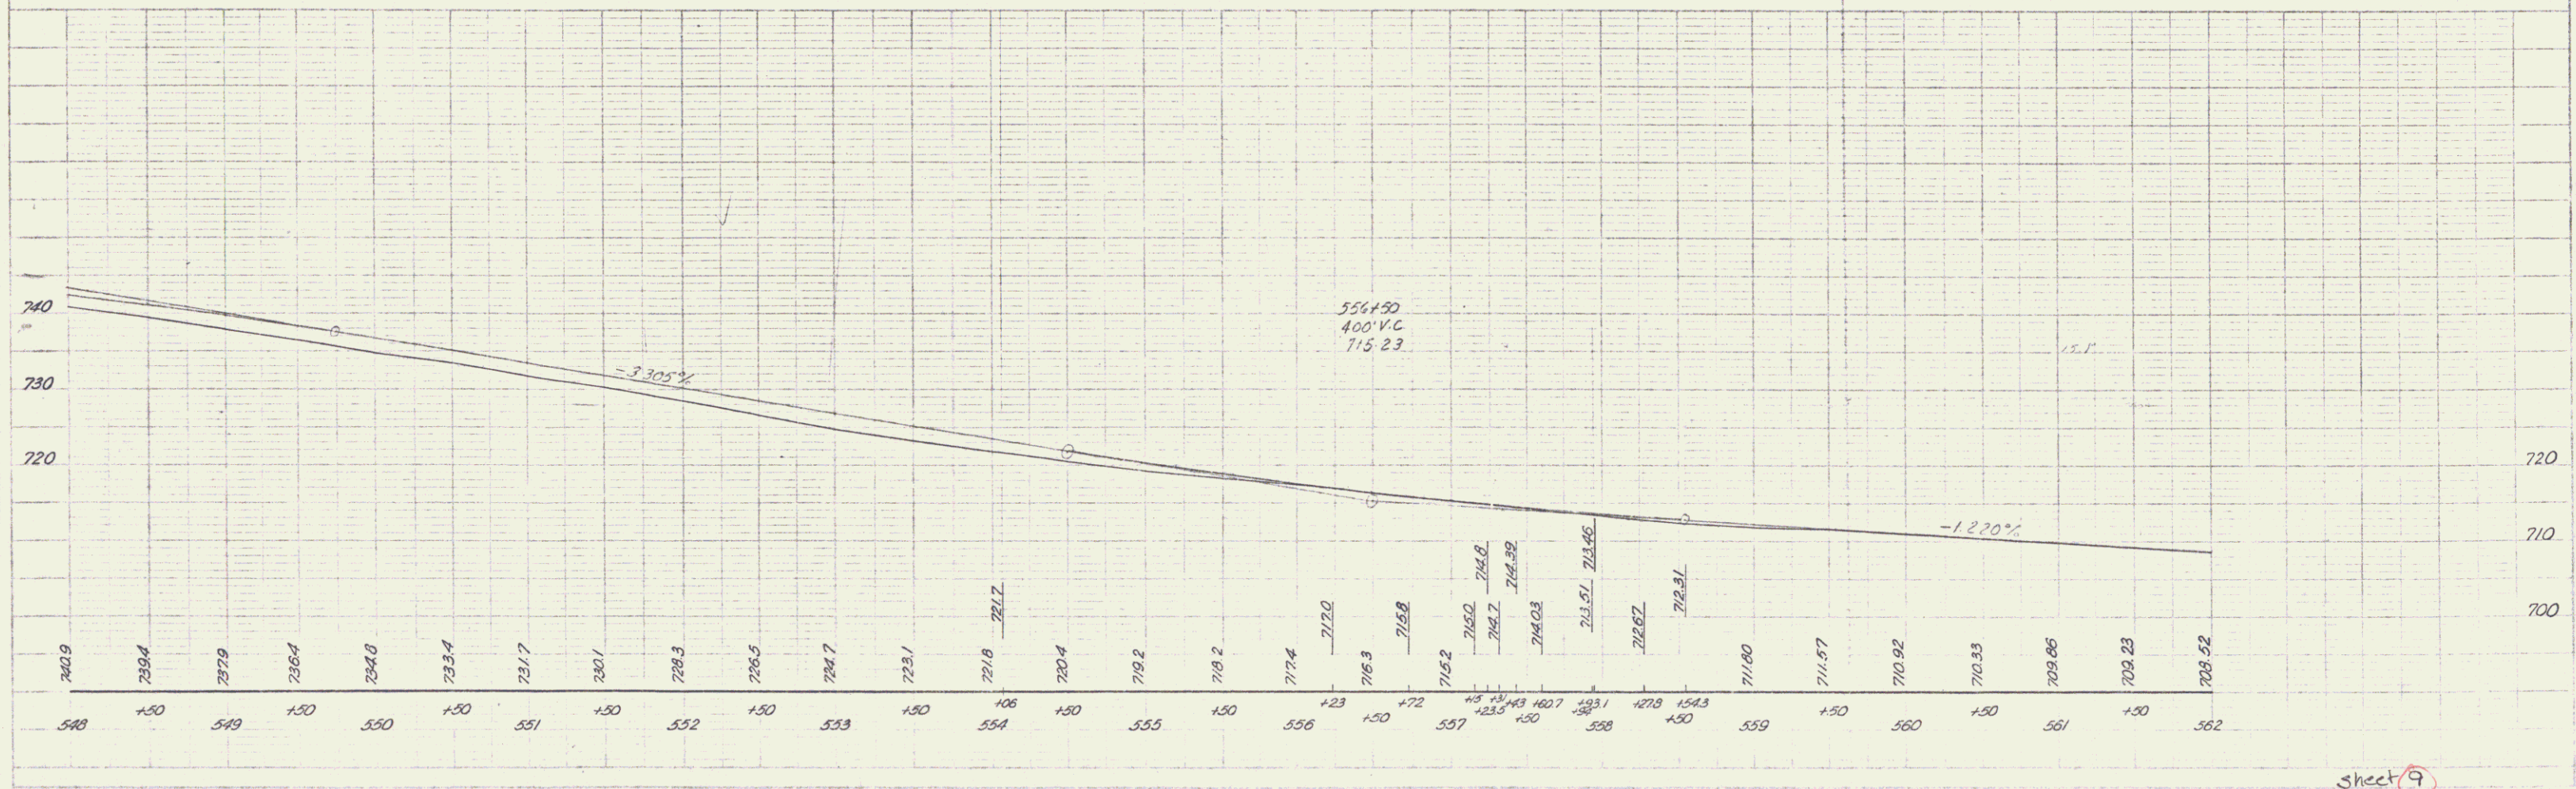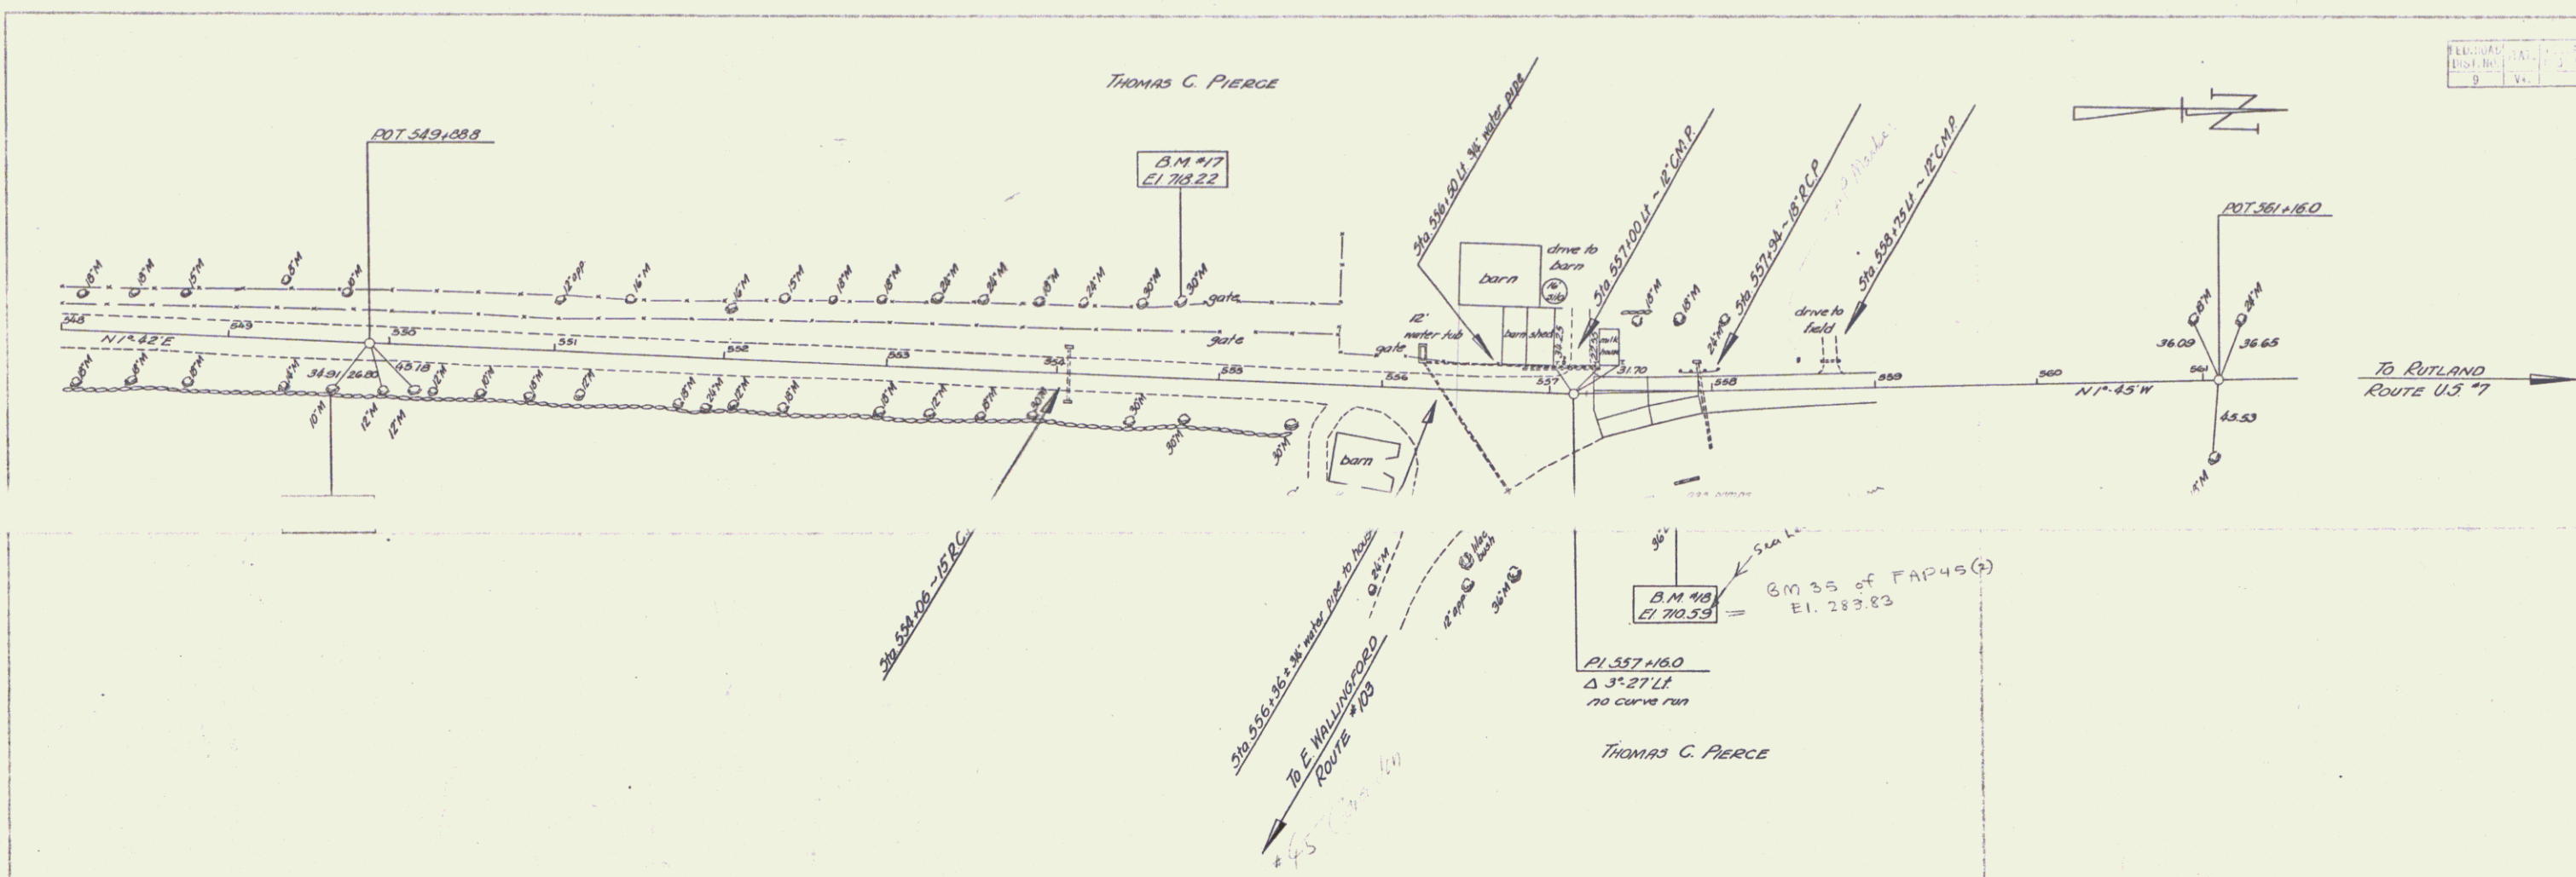

DATE	11/1/71
BY	...
SCALE	...
PROJECT	...
SHEET NO.	9

PLAN
SCALE
DATE

PLAN
SCALE
DATE

PLAN
SCALE
DATE

Sheet 9

9