

PLAN	DATE
PROJECT	
NOTE BOOK	
DATE CHECKED	
BY	

PROFILE	DATE
PROJECT	
NOTE BOOK	
DATE CHECKED	
BY	

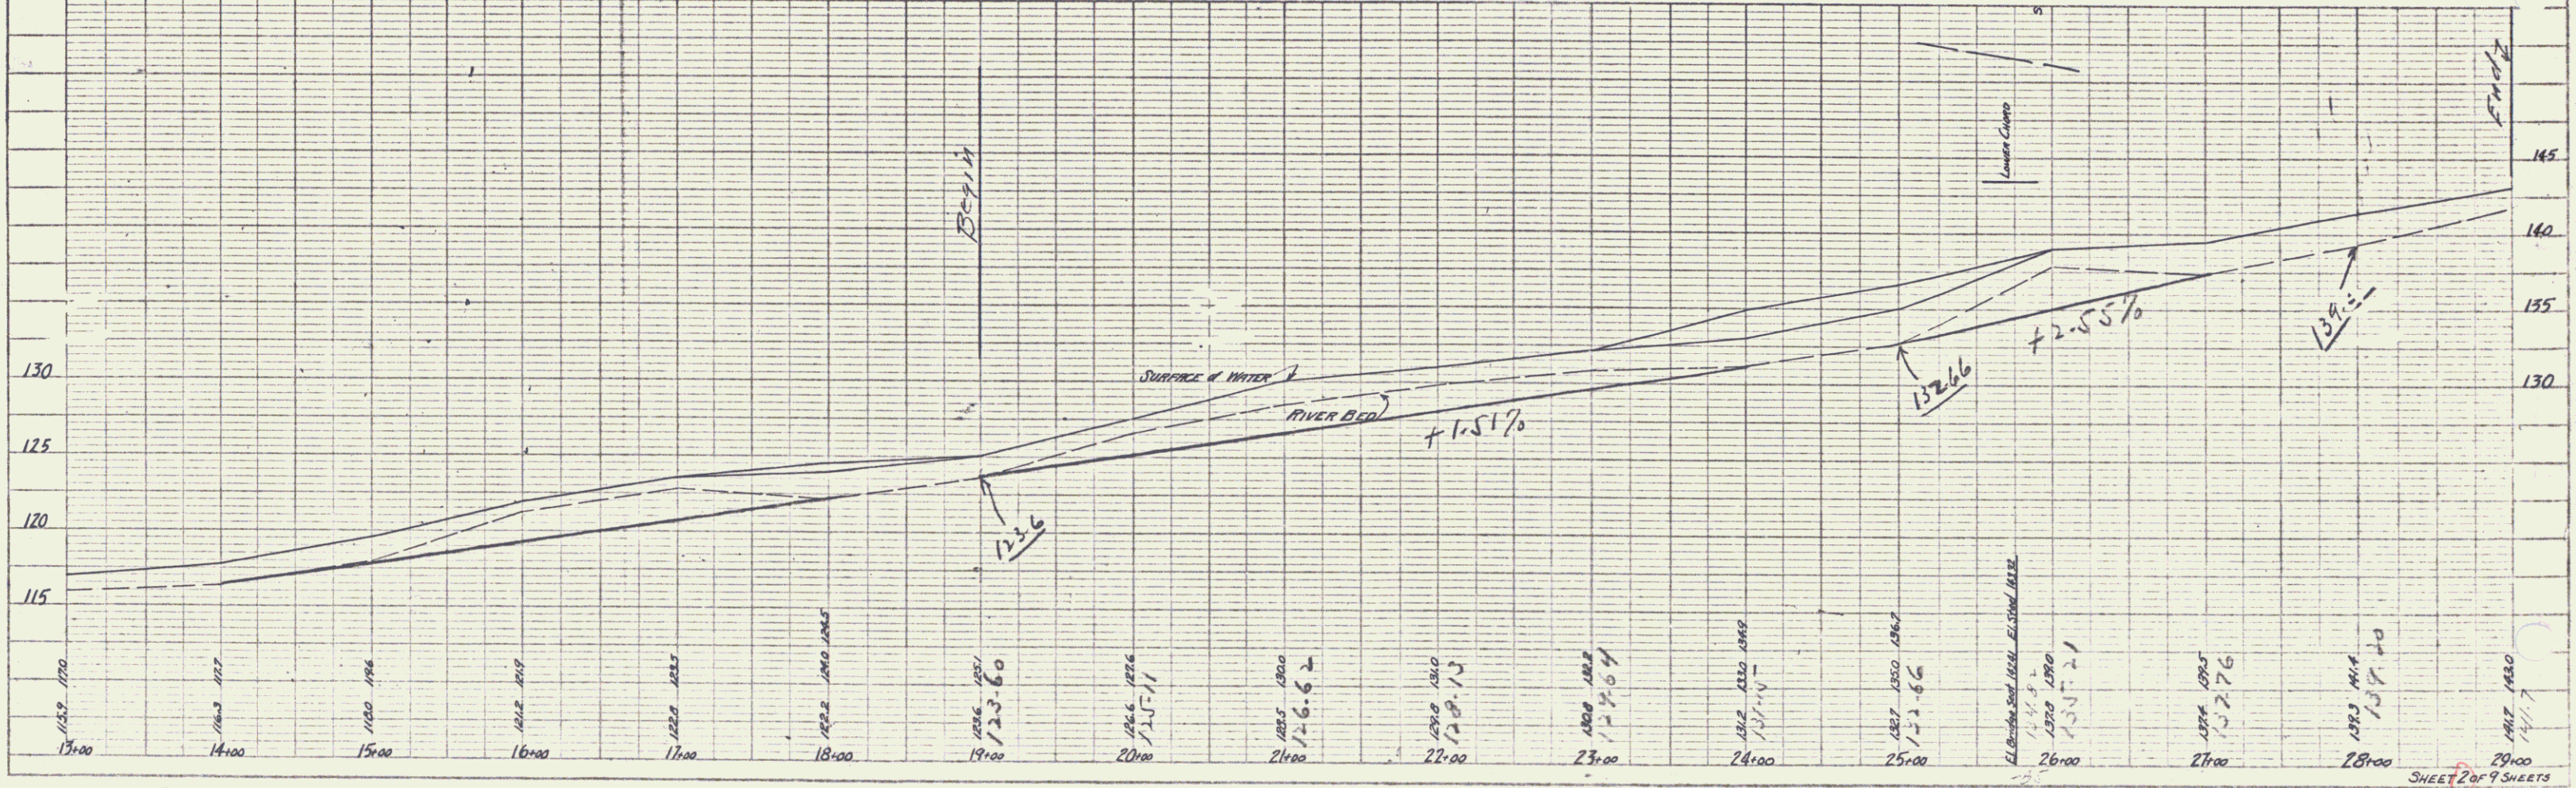
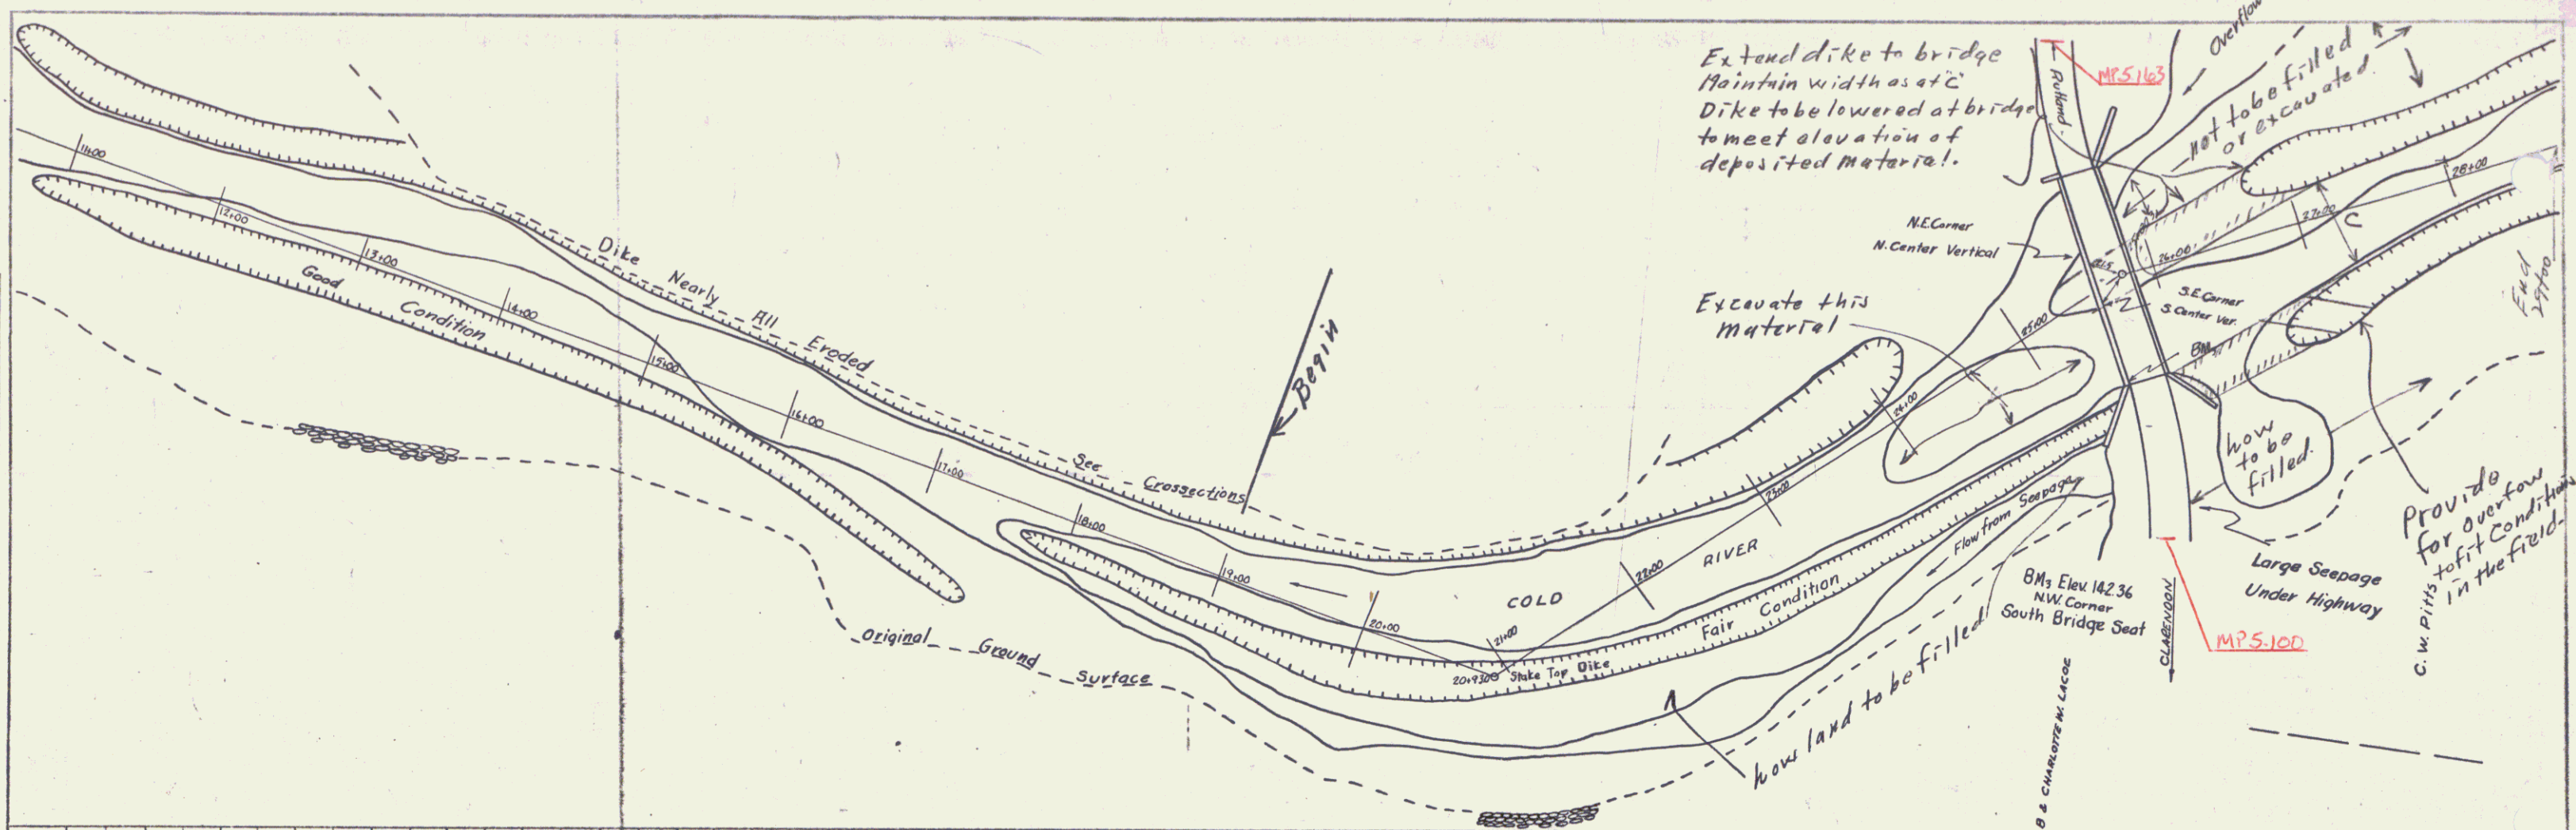


PLATE 1 - PLAN & PROFILE OF P. A. & E. STANLEY
NEWYORK & BOSTON CO., NEW YORK