
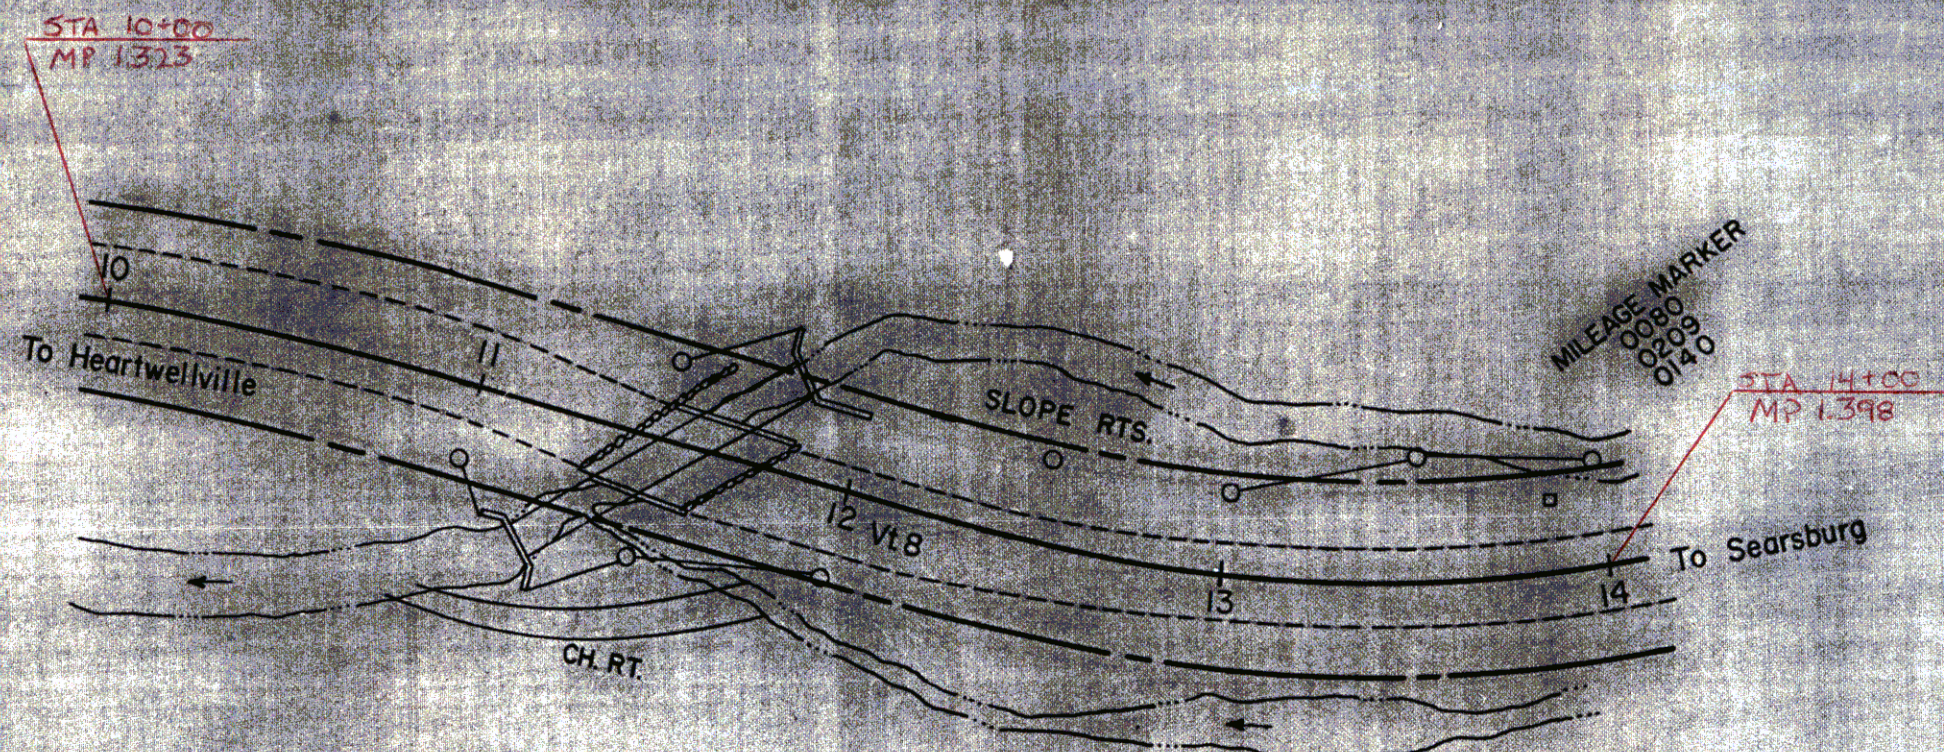



Parcel no. 1
Henry F. Harris

11+00 Rt.	— 12+00 Rt.	Right to construct & maintain (P)
11+50 Lt.	— 12+10 Lt.	Right to construct & maintain (P)
11+90 Lt.	— 14+10 Lt.	(2100 Sq. ft. ±) Slope (T)
10+90 Rt.	— 12+00 Rt.	Channel (T)

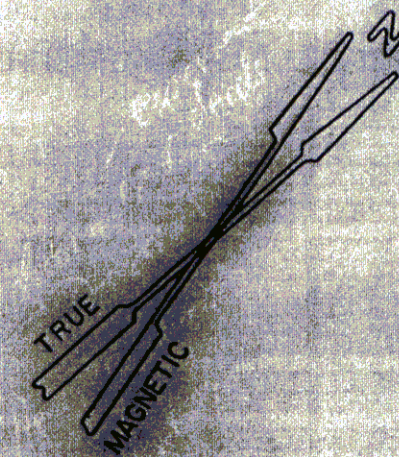

Pin # 99K712

Route VT8

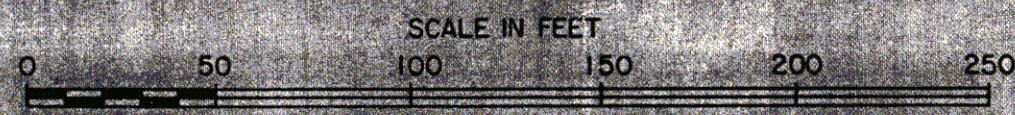

STATE OF VERMONT
DEPT. OF HIGHWAYS

TOWN OF READSBORO

PROJECT	READSBORO	BMA 6508	Bridge 2
APPROX. SCALE	1" = 50'	DATE	8-5-75
		DRAWN BY	ROD S.