


INDEX OF SHEETS



STATE OF VERMONT DEPARTMENT OF HIGHWAYS

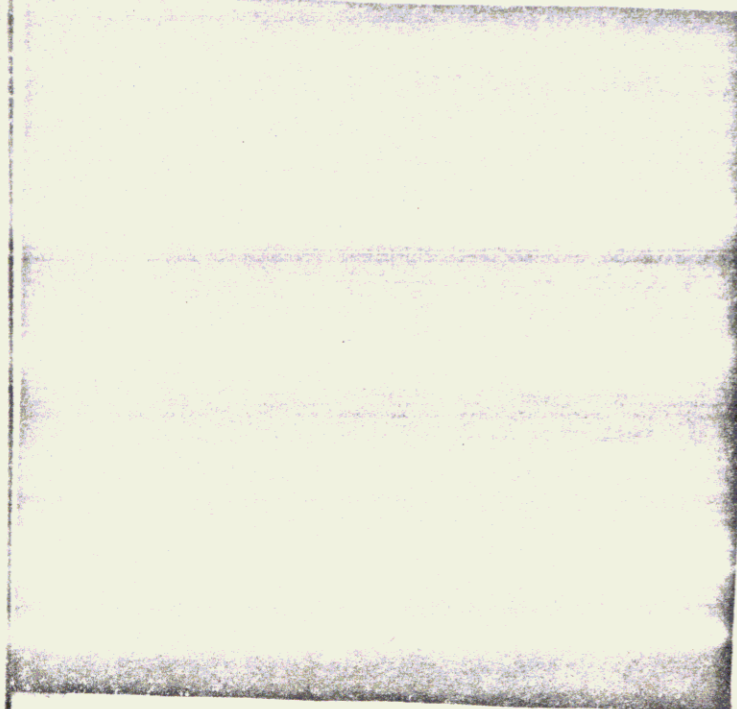


PROPOSED IMPROVEMENT BRIDGE PROJECT

TOWN OF READSBORO
COUNTY OF BENNINGTON

Pin# 998714

ROUTE NO: VT. 8 BRIDGE NO: 1

PROJECT LOCATION: BEGINNING AT A POINT 0.333 MILES NORTHERLY OF THE INTERSECTION
OF VT. ROUTES 100 & 8, AND EXTENDING NORTHERLY 0.076 MILES
PROJECT DESCRIPTION: APPROACH CONSTRUCTION AND BRIDGE WIDENING

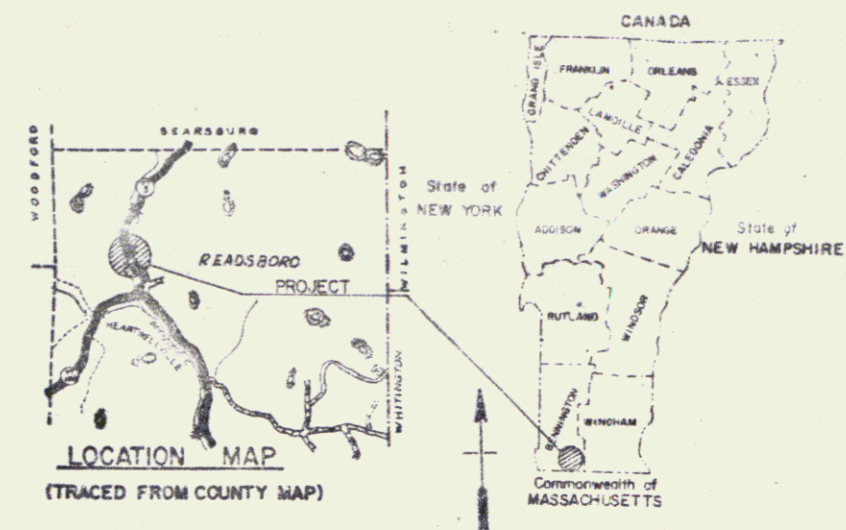


ROW PLANS

LENGTH OF R.O.W. PROJECT:	650	FEET
LENGTH OF STRUCTURE:	27	FEET
LENGTH OF PARTICIPATION ROADWAY:	373	FEET
LENGTH OF NON-PARTICIPATION ROADWAY:		FEET
LENGTH OF PROJECT:	400	FEET

1976 AADT	-	425
1976 DHV	-	60
1996 AADT	-	660 (Est)
1996 DHV	-	95 (Est)
D	-	55%
T	-	5%
DESIGN SPEED	-	40 MPH

BEGIN R.O.W. PROJECT
TQS 0101(3) STA. 17+50

END R.O.W. PROJECT
TQS 0101(3) STA. 24+00

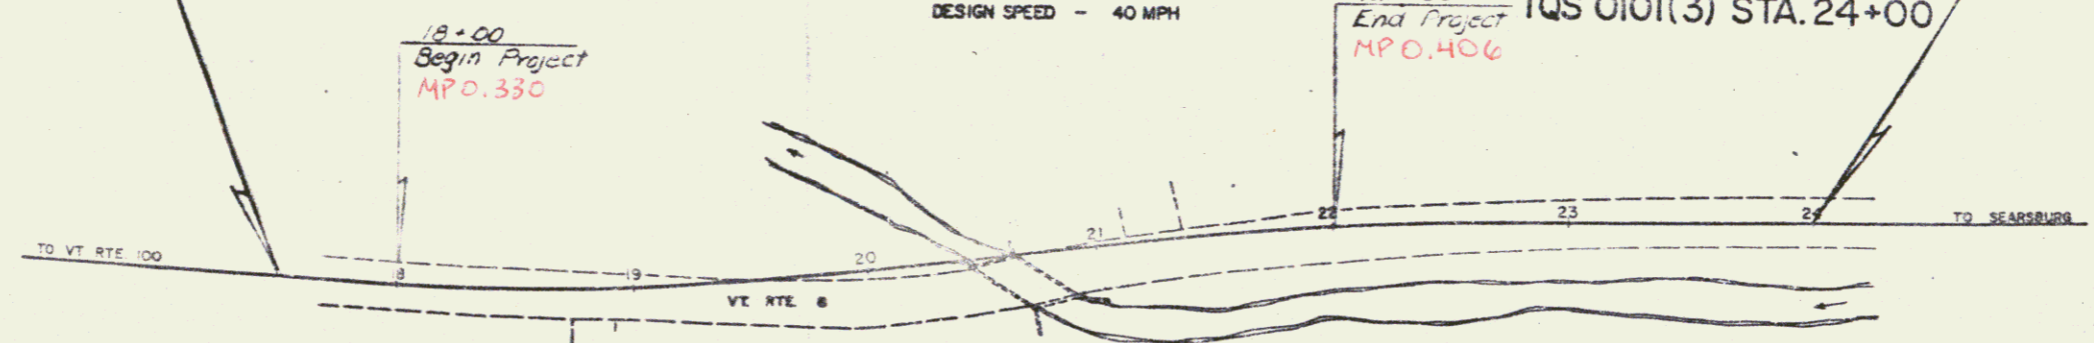


TYPICAL BRIDGE SECTION

TYPICAL ROADWAY SECTION

- CONVENTIONAL SIGNS
- COUNTY LINE
 - TOWN LINE
 - LIMITS OF ACCESS
 - POINT OF ACCESS
 - FENCE LINE
 - STONE WALL
 - TRAVELED WAY
 - GUARD RAIL
 - RAILROAD
 - SURVEY LINE
 - CULVERT
 - POWER POLE
 - TELEPHONE POLE
 - TREES
 - CONTROL OF ACCESS
 - PROPERTY LINE
 - R.O.W. TAKING LINE
 - SLOPE RIGHTS
 - TOP OF CUT
 - TOE OF SLOPE

RIGHT-OF-WAY DIVISION
TOWN FILE
PERPETUAL
Town of Readsboro
(To Be Returned To R.O.W. Division)

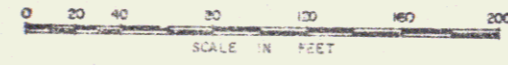

These plans are subject to such engineering changes as may be required by the Federal Highway Administration or the Chief Engineer.
Construction is to be carried on in accordance with these plans and the Standard Specifications for Highway and Bridge Construction dated March, 1975, as approved by the Federal Highway Administration on October 27, 1976 for use in this project, including all subsequent revisions and such revised specifications and special provisions as are incorporated in these plans.

APPROVED: [Signature]
DATE: 4-19-77

SUBMITTED BY ORDER OF THE STATE TRANSPORTATION BOARD

PROJECT TQS 44 0101(3)

SHEET 1 OF 5 SHEETS

1985/1977

MPO = 0.330 - 0.406