

TOWN OF SEARSBURG

Route VT8

Pin# 99R716

Project SA

6/1/1926

MP 2.38-0.00

PLAN

DATE	1926
BY	W. H. ...
CHECKED BY	...
APPROVED BY	...
SCALE	1" = 40'

PROFILE

DATE	1926
BY	W. H. ...
CHECKED BY	...
APPROVED BY	...
SCALE	1" = 10'

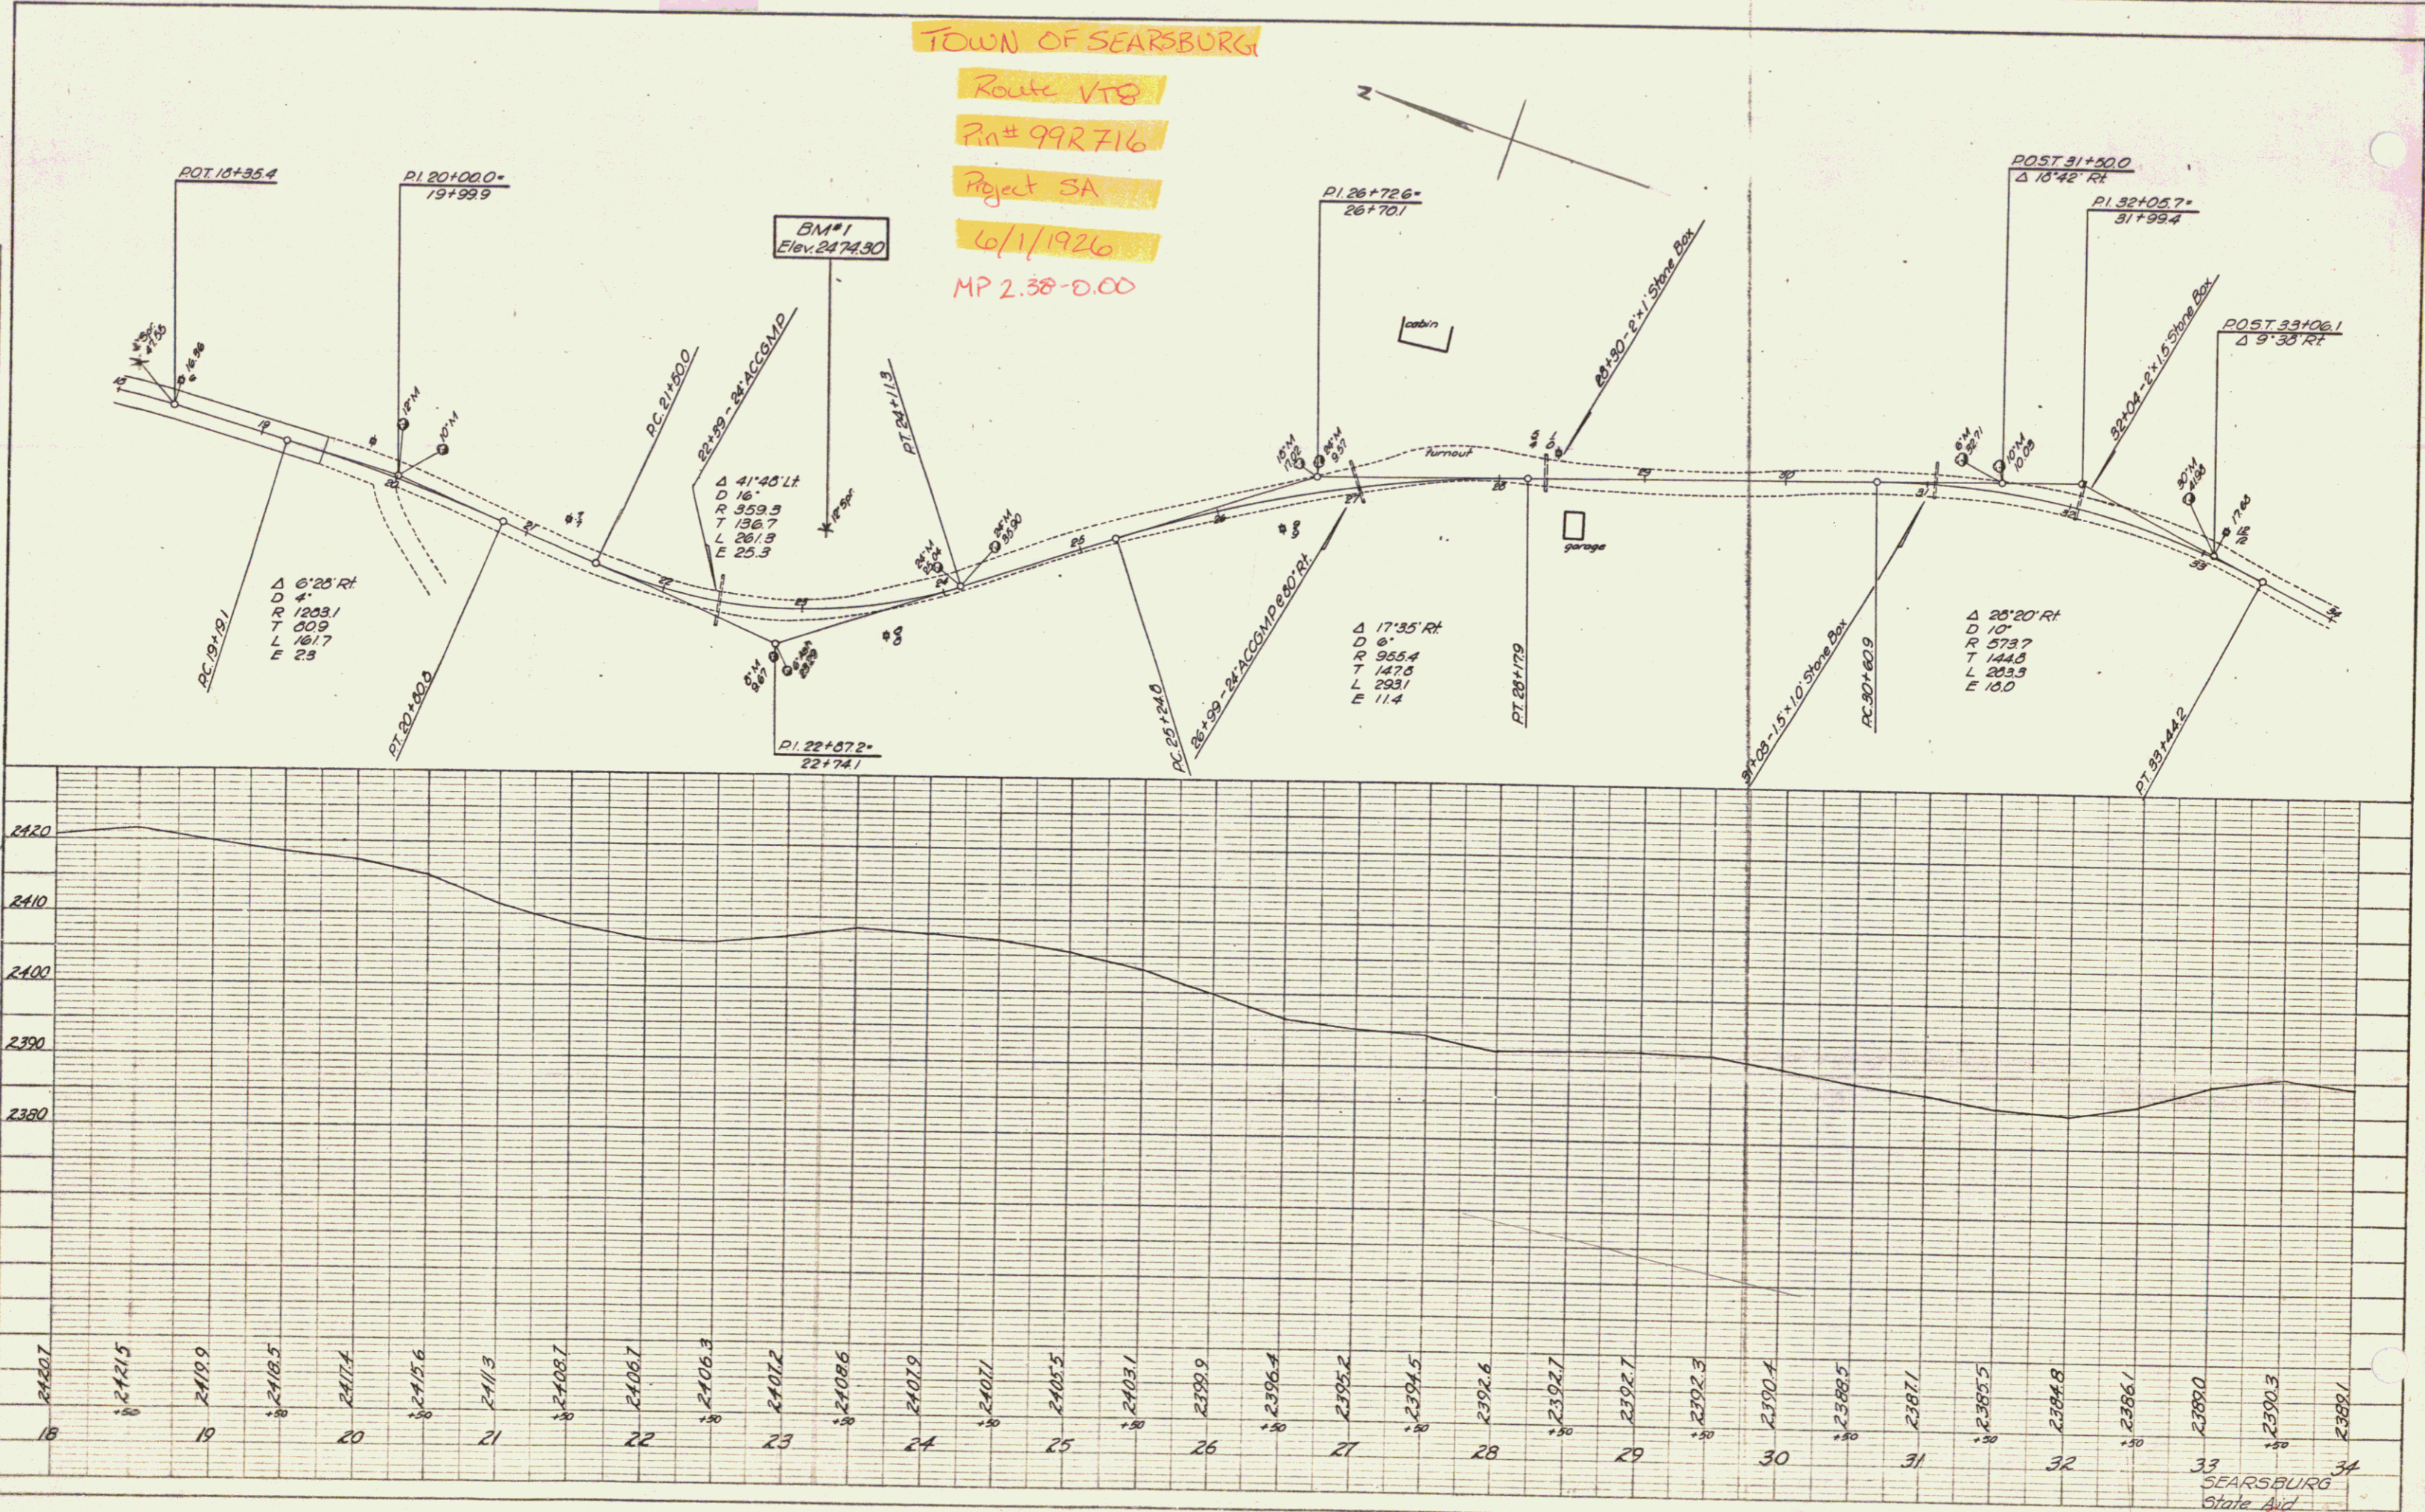


PLATE 1 - PLAN PROFILE - 1" = 40' HORIZ. 1" = 10' VERT.
 H. & O. CO. INC. 1926