

PLAN  
 DRAWN BY: *W. J. Miller*  
 CHECKED BY: *W. J. Miller*  
 DATE: *11/15/55*  
 PROJECT: *SEARSBURG STATE AID*  
 SHEET: *1019*

PROFILE  
 DRAWN BY: *W. J. Miller*  
 CHECKED BY: *W. J. Miller*  
 DATE: *11/15/55*  
 PROJECT: *SEARSBURG STATE AID*  
 SHEET: *1019*

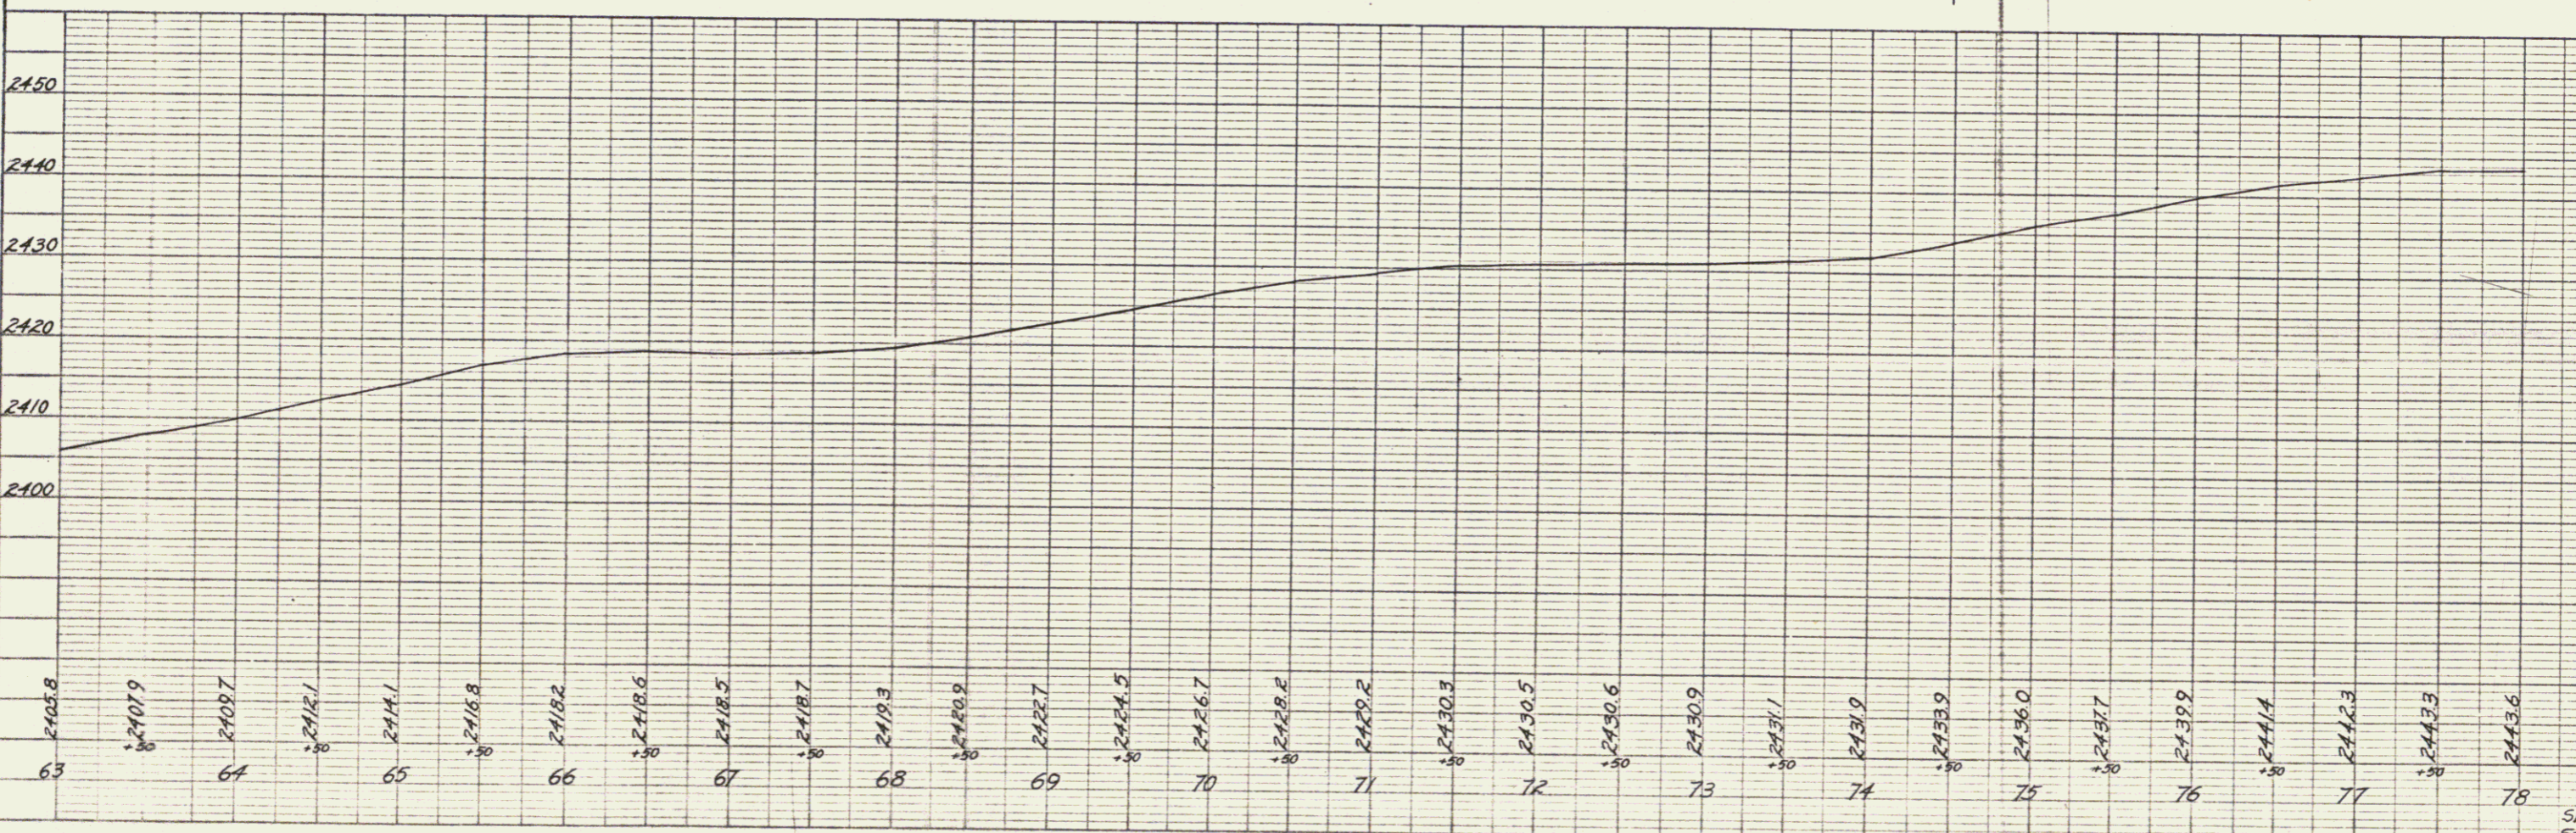
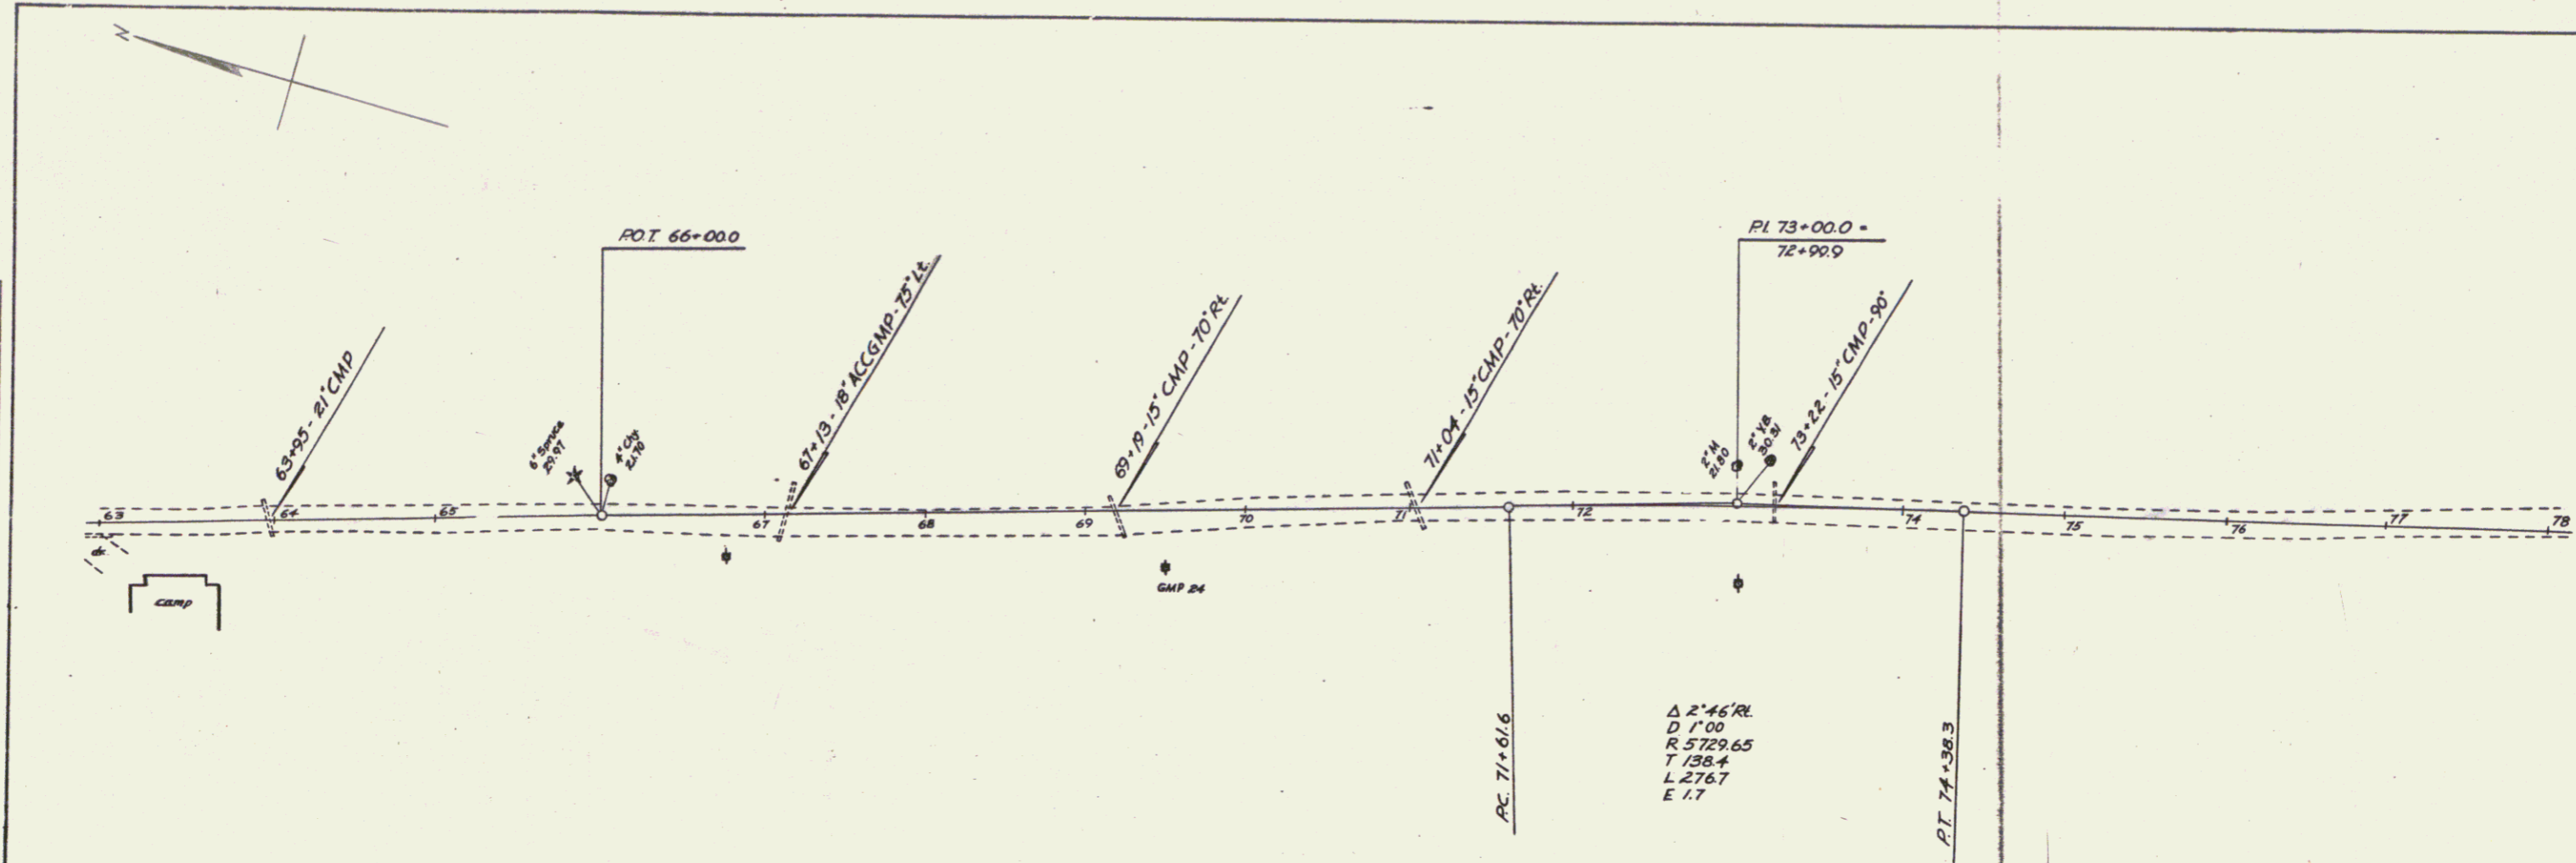


PLATE 1 - PLAN - PROFILE OF P.A.S.S. STANDARD  
 11/15/55  
 W. J. MILLER

SEARSBURG  
 State Aid  
 Sheet 1019  
 of 9  
 4