

PLAN
 DRAWN BY: *D. Miller*
 CHECKED BY: *R.H.S.*
 DATE: _____
 PROJECT: _____
 SHEET NO.: _____
 TOTAL SHEETS: _____
 NOTE: BOOK _____
 NO. _____

PROFILE
 DRAWN BY: *A. Miller*
 CHECKED BY: _____
 DATE: _____
 PROJECT: _____
 SHEET NO.: _____
 TOTAL SHEETS: _____
 NOTE: BOOK _____
 NO. _____

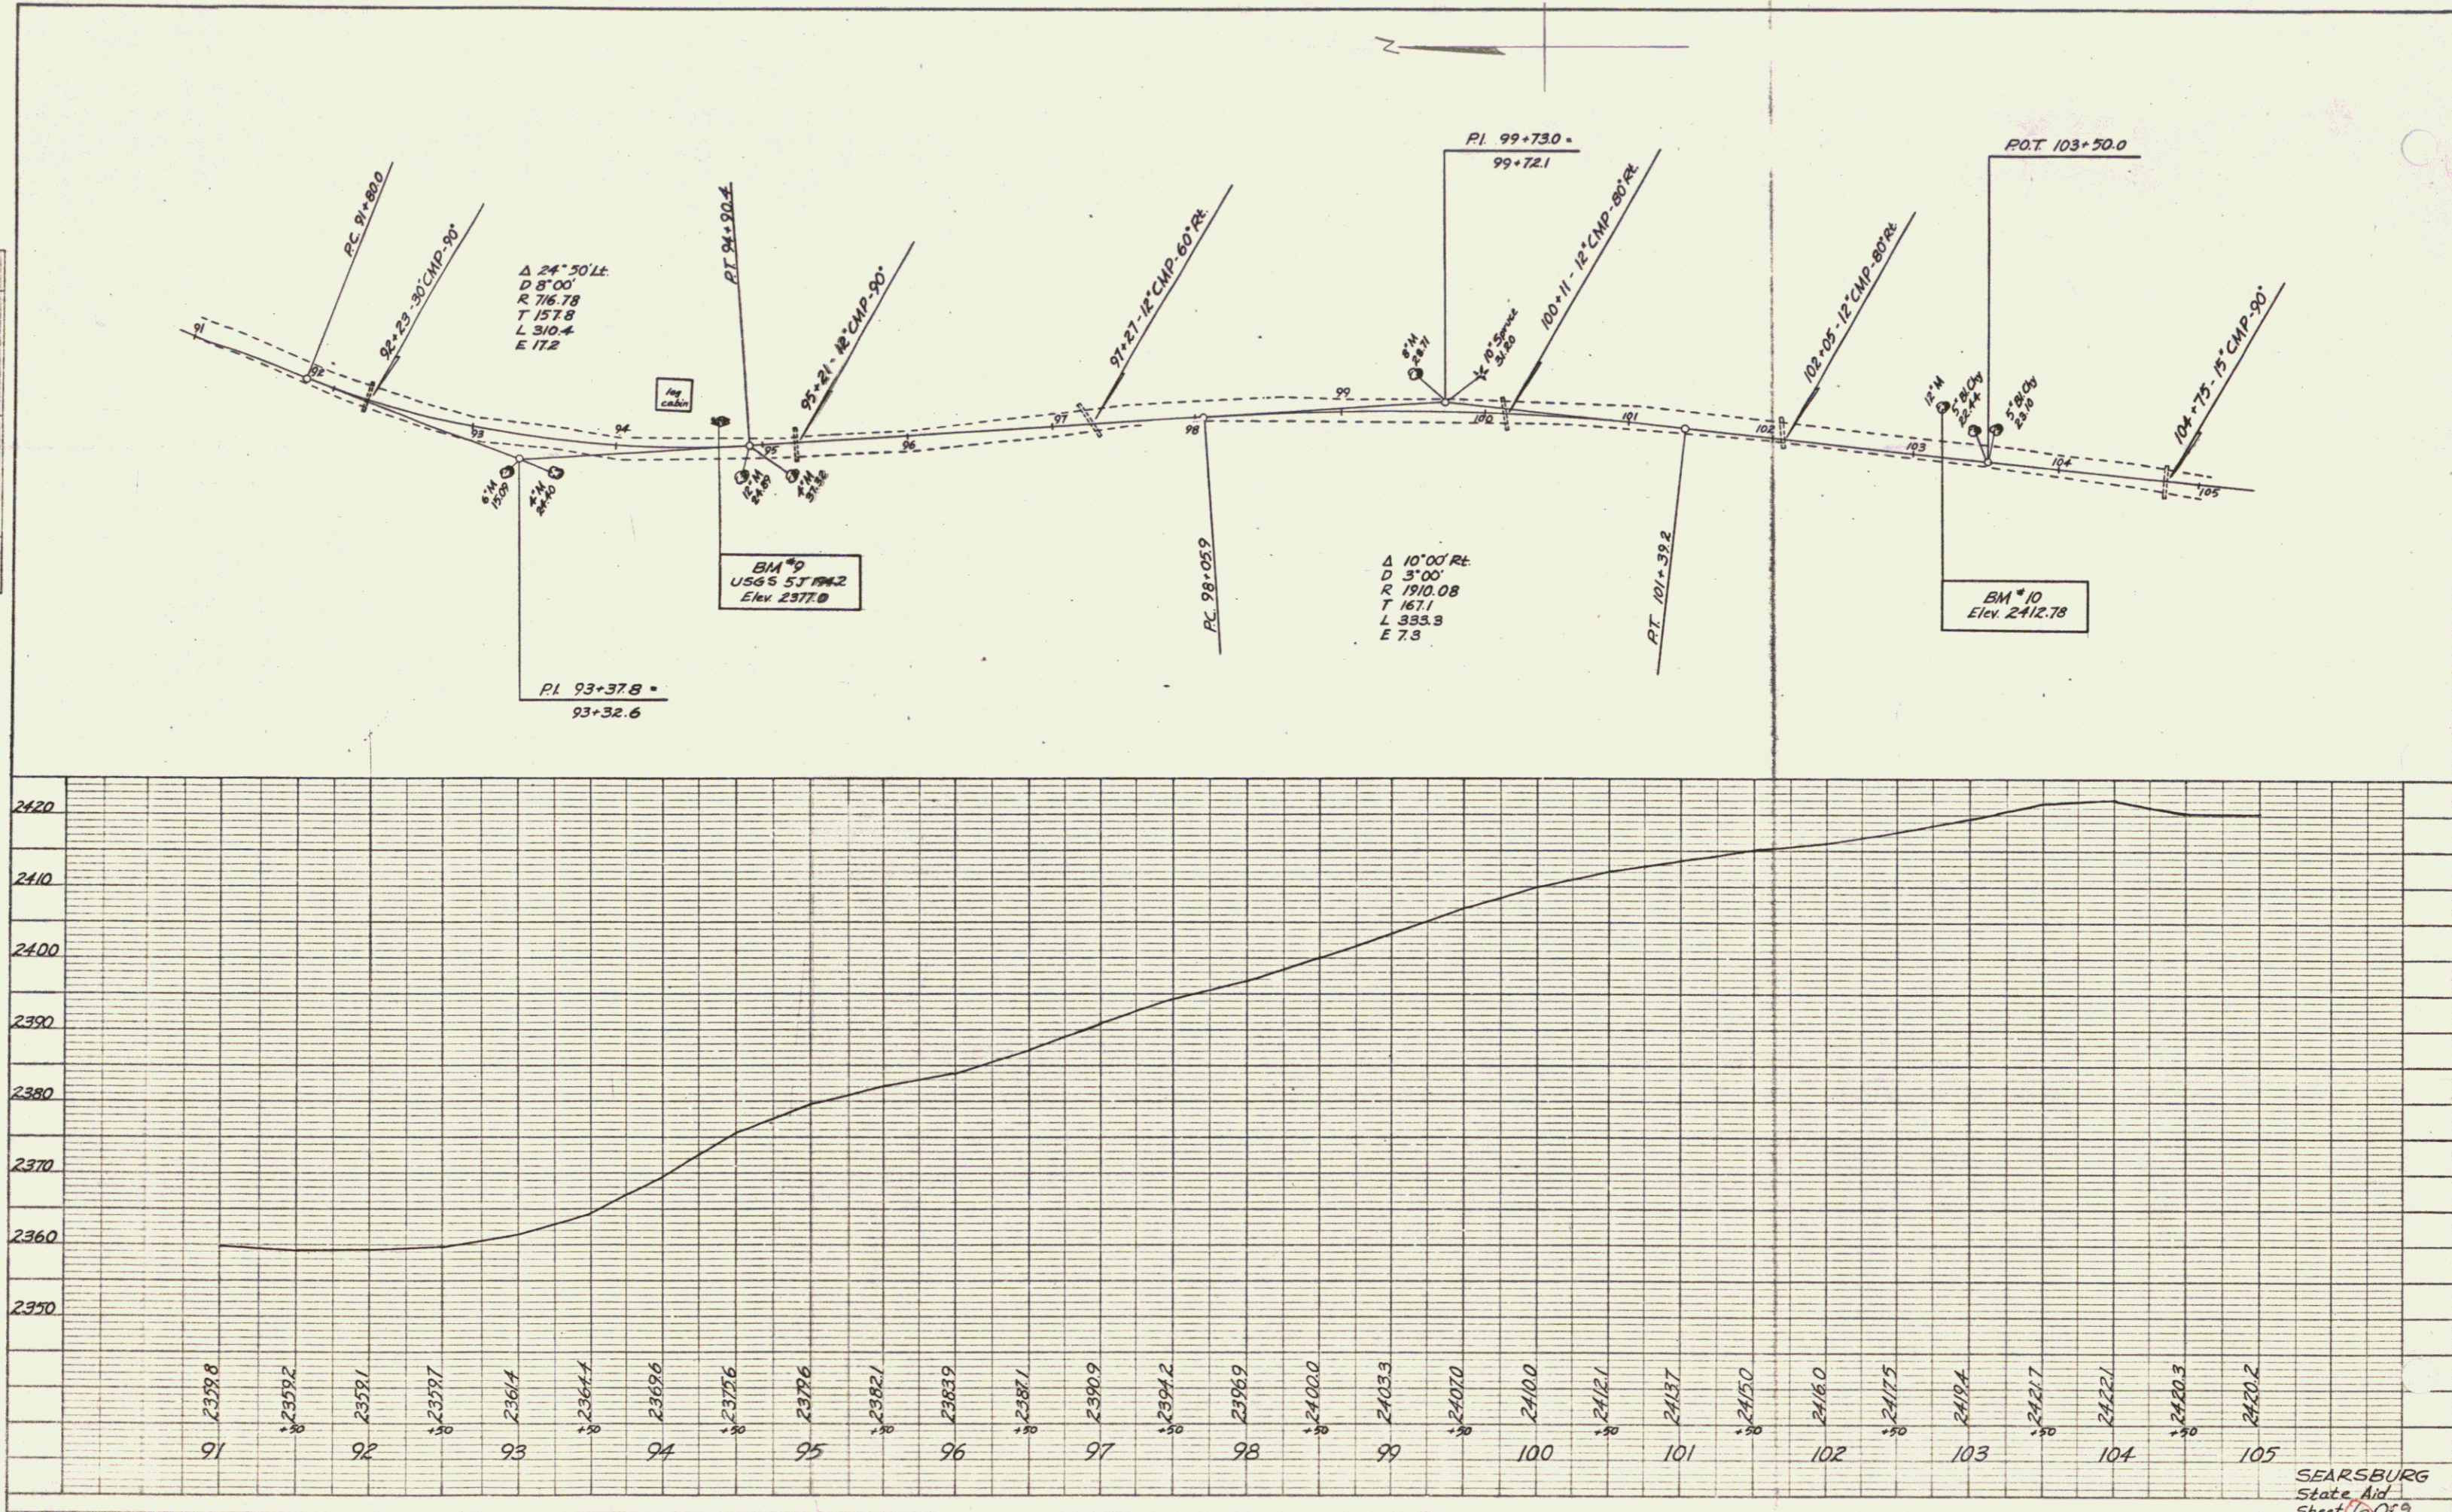


PLATE 1 - PLAN - PROFILE
 REYNOLDS & BERRY CO., NEW YORK
 MADE IN U.S.A.

SEARSBURG
 State Aid
 Sheet 10 of 9