

INDEX OF SHEETS

1. TITLE PAGE
2. SUMMARY OF QUANTITIES & ITEM DETAIL & DRAINAGE SHEET
3. EARTHWORK SHEET
4. BLANK
5. RIGHT OF WAY DETAIL SHEET
6. RIGHT OF WAY PLAN
- 7-8. PLAN & PROFILE SHEETS
9. BLANK
10. A-61 SOLID ROCK EXCAVATION 4/20/73
11. B-1 BANKING TABLES 12/8/71
12. B-5 SLOPE GRADING 12/6/71
13. D-2 HEADWALLS 3/8/72 R
14. E-2 ROAD CONST. APPROACH SIGNS 5/14/74 R
15. E-5 ROAD CONST. SIGNS (B.P.) 9/11/73 R
16. E-6 ON PROJECT CONST. SIGNS 5/14/74 R
17. G-3 THREE CABLE GUARD RAIL 5/23/74 R
18. G-4 STEEL MARKER POSTS 5/23/74 R
19. BLANK
- 20-23. MAINLINE CROSS SECTIONS
24. SA-3 CROSS SECTIONS

WILLISTON BP 0207-7505  
RECORD PLANS

**MATERIALS**  
SUB-BASE OF GRAVEL STATE OF VERMONT PIT, HINESBURG, VT.  
BITUMINOUS CONCRETE PAVEMENT PIKE INDUSTRIES, WILLISTON, VT.  
A.C.C.G.M.P. '8' (064) LANE METAL PRODUCTS CORP., BALLSTON SPA, N.Y.

**CONTRACTOR:**  
STATE OF VERMONT PROJECT BEGAN JUNE, 1975  
DISTRICT 5 PROJECT COMPLETED NOVEMBER, 1975  
RECORD PLANS P.F. WU DECEMBER 24, 1975

STATE OF VERMONT  
DEPARTMENT OF HIGHWAYS




PROPOSED IMPROVEMENT


TOWN OF WILLISTON  
COUNTY OF CHITTENDEN Pin# 99R717  
VT. ROUTE 2-A

BEGINNING AT A POINT APPROXIMATELY  
2.026 MILES NORTHERLY OF THE ST. GEORGE-  
WILLISTON TOWN LINE AND EXTENDING  
NORTHERLY 0.180 MILES.

LENGTH OF ROADWAY 950 FEET 0.180 MILES  
LENGTH OF PROJECT 950 FEET 0.180 MILES

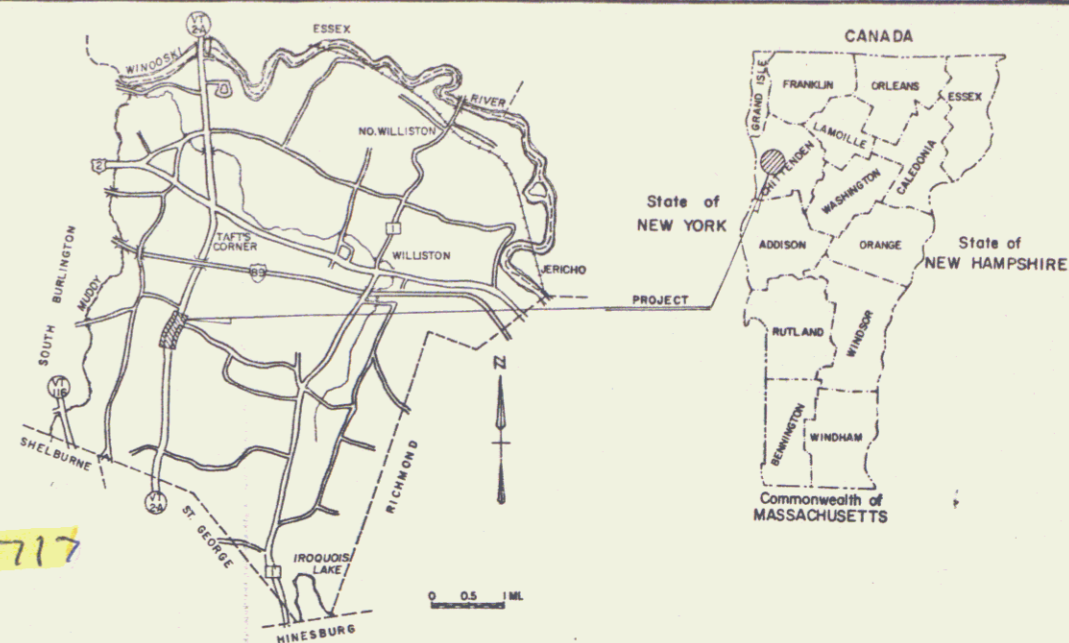

RIGHT-OF-WAY  
PLANS

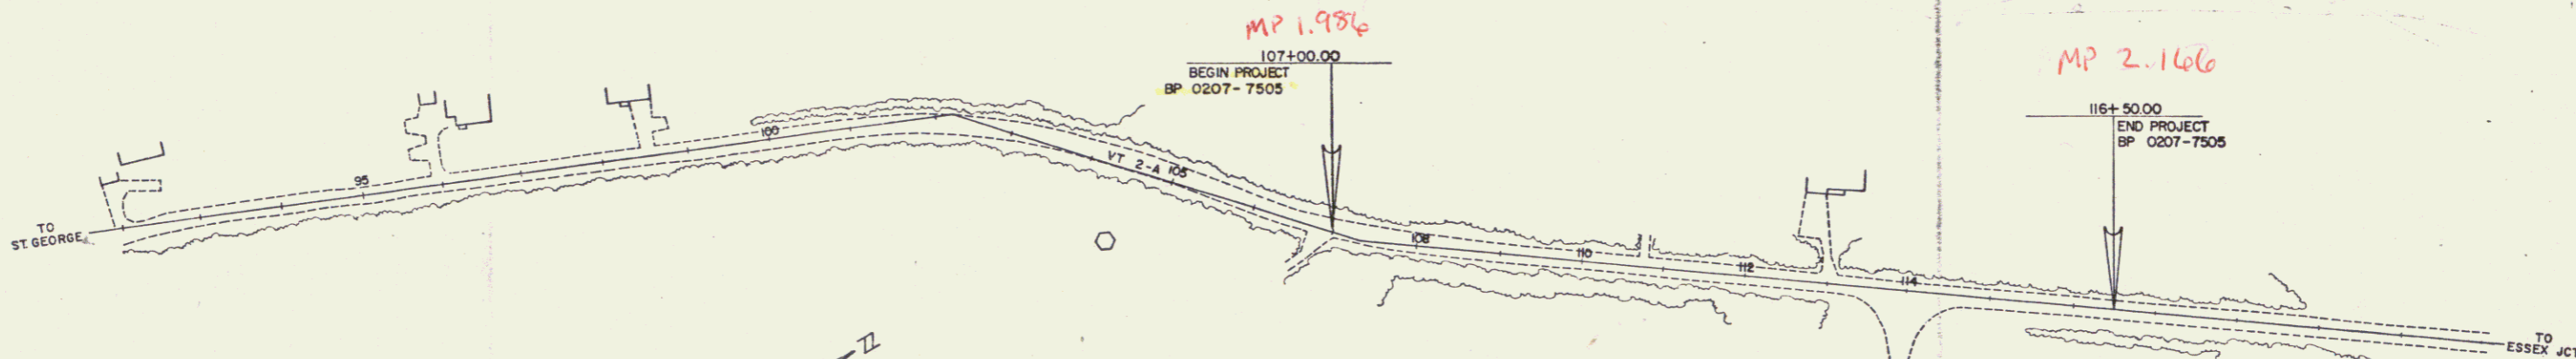

CONVENTIONAL SIGNS

- COUNTY LINE
- TOWN LINE
- LIMITS OF ACCESS
- POINT OF ACCESS
- FENCE LINE
- STONE WALL
- TRAVELED WAY
- GUARD RAIL
- RAILROAD
- SURVEY LINE
- CULVERT
- POWER POLE
- TELEPHONE POLE
- TREES
- LAST IDENTIFICATION SIGNS
- PROPERTY LINE
- R.O.W. TAKING LINE
- SLOPE RIGHTS
- TOP OF CUT
- TOE OF SLOPE

WILLISTON, BP 0207-7505  
CONTRACTOR STATE OF VERMONT, DISTRICT 5  
COMPLETED NOVEMBER, 1975  
RECORD PLANS P.F. WU 12/29/75

FEB 25 1980

SUBMITTED BY ORDER OF THE STATE HIGHWAY BOARD  
APPROVED *E.H. Stiebny* DATE 3-3-75  
CHIEF ENGINEER  
APPROVED *R. Jenkins*  
DIRECTOR OF RIGHT-OF-WAY  
DATE 3-3-75

PROJECT BP NR 0207-7505  
SHEET 1 OF 24 SHEETS

D-10 SRS 12/17/70