

INDEX OF SHEETS

|             |   |
|-------------|---|
| SHEET NO. 1 | TITLE PAGE  |
| 2           | TYPICAL CROSS-SECTION OF IMPROVEMENT (SINGLE TRACK COAT OF REFINED TAR - ITEM 30) |
| 3           | BANKING AND WIDENING TABLES   |
| 4-11        | PLAN AND PROFILE  |
| 12          | STANDARD STRUCTURE SHEET - 520 PIPE CULVERTS                                      |
| 13          | 30x4 BOX CULVERTS   |
| 14          | SC1-4   |
| 15          | SC2-3   |
| 16          | 3-30 GUARD RAIL   |
| 17          | 3-30A UNDERDRAIN  |
| 18          | 3-40 BARRICADES, SIGNS, LIGHTS  |
| 19          | 3-41 ROUNDING OF SLOPES   |
| 20-50       | CROSS-SECTIONS  |

STANDARD STRUCTURE SHEETS  
 APPROVED BY THE CHIEF ENGINEER  
 28 JULY 11, 1932  
 29 JULY 11, 1933  
 30 AUG. 13, 1934

STATE OF VERMONT  
 STATE HIGHWAY DEPARTMENT


PLAN AND PROFILE OF PROPOSED  
 STATE HIGHWAY

TOWN OF WILLISTON  
 ESSEX JCT.-WILLISTON ROAD


BEGINNING AT THE INTERSECTION OF ROUTE U.S. 2 WITH ST. 116 AND EXTENDING  
 NORTHERLY TO A POINT 71.5 FT. SOUTHERLY OF THE WILLISTON ESSEX  
 TOWN LINE AT THE BRIDGE OVER THE WINOOSKI RIVER, OMITTING PROJECT WPSS-189A  
 LENGTH OF PROJECT 9692.2 FT. 1.835 MI.

RIGHT-OF-WAY  
 PLANS

Route: Vt 2A  
 Project: ST 189L  
 Pin# 99R 719

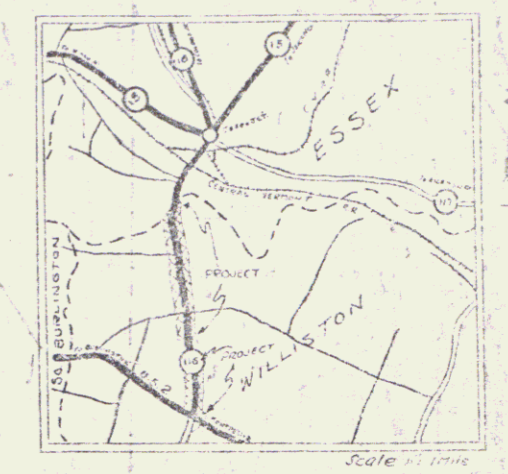

WILLISTON

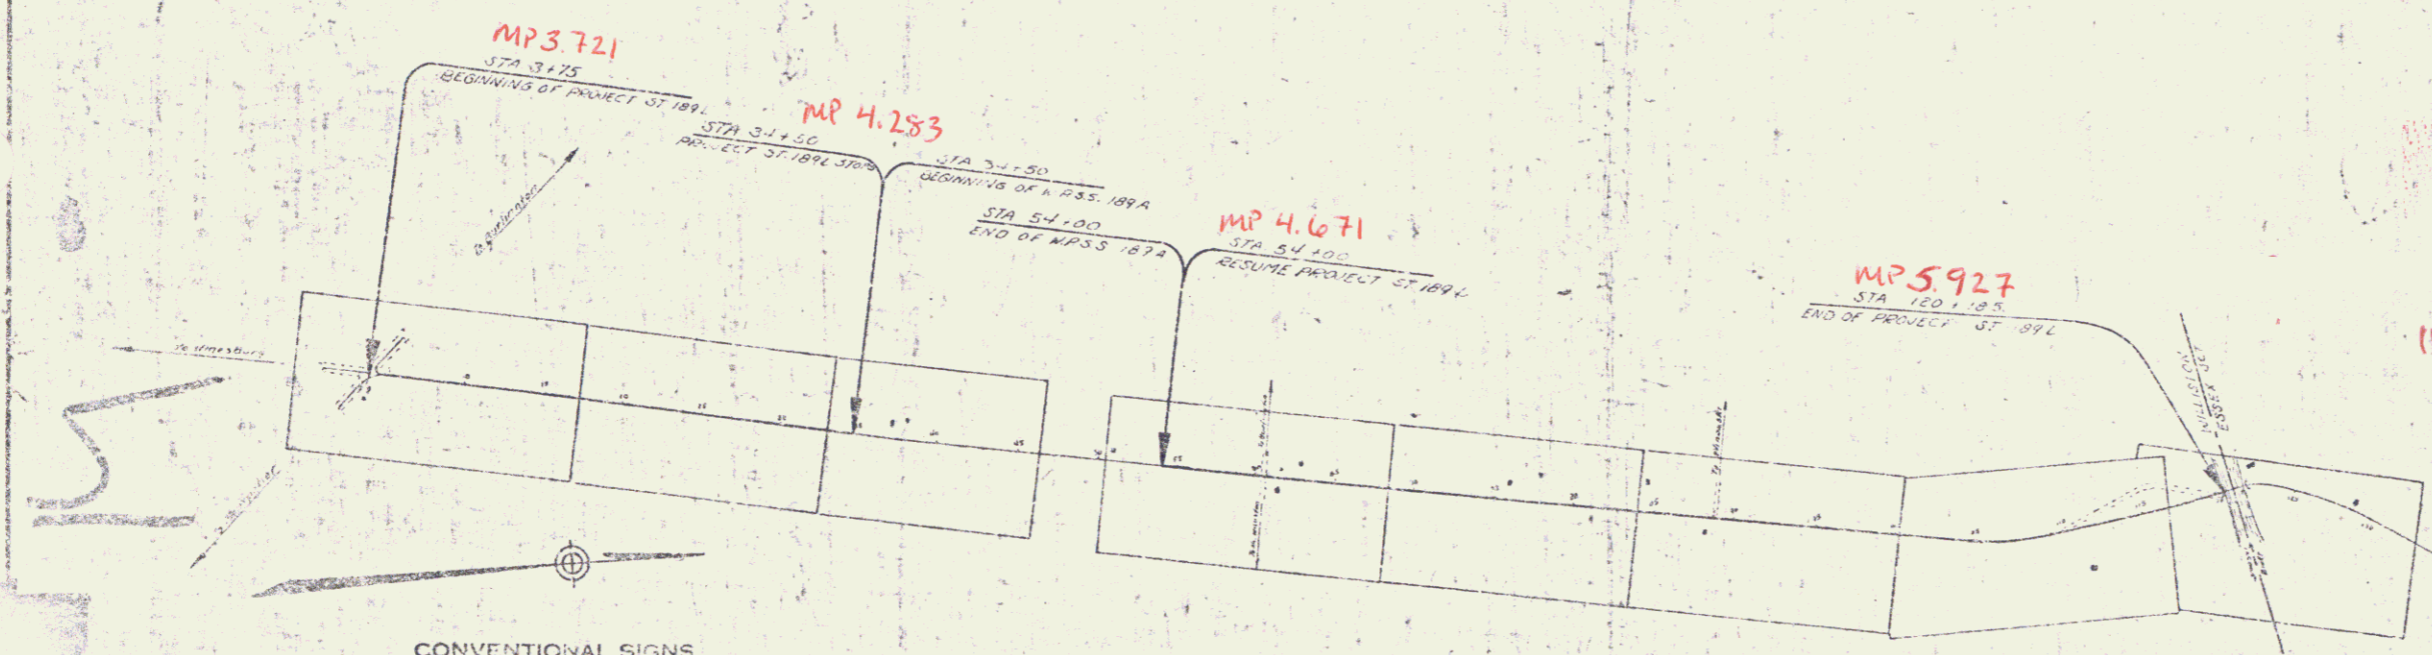

RIGHT-OF-WAY DIVISION  
 TOWN FILE  
 PERPETUAL  
 Town of Vt 2A  
 (To Be Returned To R.O.W. Division)

CONVENTIONAL SIGNS

|               |                  |
|---------------|------------------|
| QUANTITY LINE | GROUND ELEVATION |
| PLAN SIDE     | ELEVATION        |
| PLAN SIDE     | PLAN SIDE        |

CURVE DATA

|                  |        |
|------------------|--------|
| DEFLECTION ANGLE | Δ      |
| TYPE OF CURVE    | S      |
| LENGTH OF CURVE  | C      |
| CHORD DISTANCE   | T      |
| PI OF CURVE      | L      |
| CHORD BEARING    | B      |
| INTERSECTION     | P.I.   |
| POINT OF CURVE   | P.C.   |
| POINT OF TANGENT | P.T.   |
| POINT OF TANGENT | P.O.T. |

SCALES

|                |           |
|----------------|-----------|
| TITLE          | 1" = 600' |
| TYPICAL        | 1" = 20'  |
| PLAN           | 1" = 50'  |
| PROFILE        | 1" = 10'  |
| CROSS SECTIONS | 1" = 5'   |

These plans are subject to such revisions as may be required by the Commissioner of Highways.  
 Construction is to be carried on in accordance with the plans and drawings hereto incorporated.  
 All subsequent proposed revisions and specifications are to be submitted with the plans.

APPROVED: May 16, 1938  
 [Signature]  
 COMMISSIONER OF HIGHWAYS  
 SUBMITTED BY ORDER OF THE STATE HIGHWAY DEPARTMENT

RECOMMENDED  
 RECOMMENDED FOR APPROVAL  
 APPROVED

May 3, 1938  
 SERIES 100-189L FILED  
 SHEET 1 OF 30