
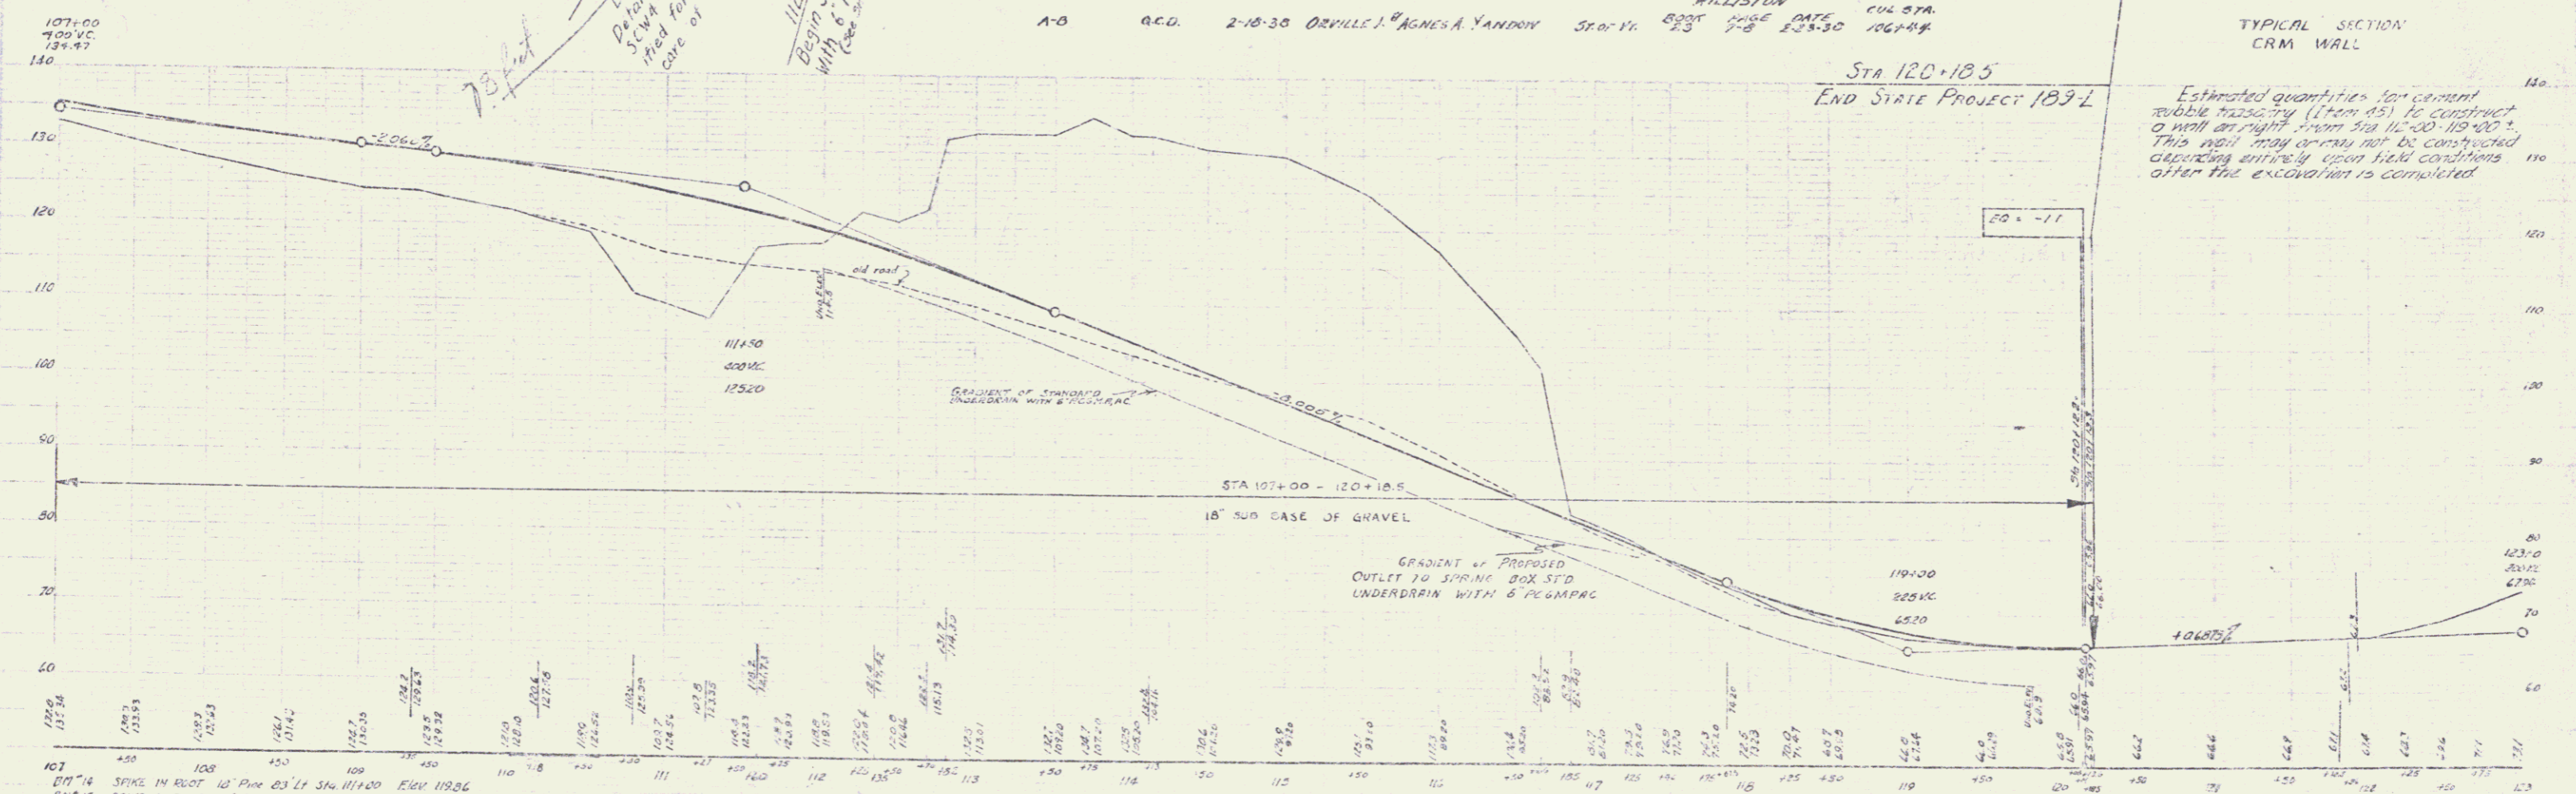


**Note**  
 The contract between the contractor and the State relative to the spring easement box shall be such that the State will be responsible for the spring box and the contractor shall be responsible for the proposed underdrain. The contractor shall be responsible for the proposed underdrain and the State shall be responsible for the proposed underdrain. The contractor shall be responsible for the proposed underdrain and the State shall be responsible for the proposed underdrain.

PARCEL INSTRUMENT	DATE	GRANTOR	GRANTEE	RECORDED MILLISIM	REMARKS
A-0	a.c.d.	2-18-30	ORVILLE, AGNES A. YANDRY	ST. 11. 23	1-8 23-30 1067-44

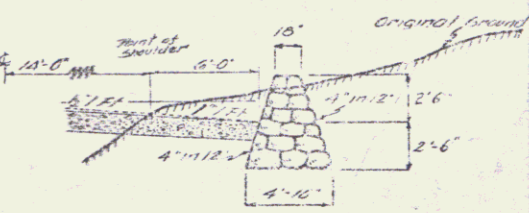

Estimated quantities for concrete rubble masonry (from 85) to construct a wall on right from Sta 115+00 to 119+00. This wall may or may not be constructed depending entirely upon field conditions after the excavation is completed.

107 120  
 BM 14 SPIKE IN ROOT 10" PIN 83' LY STA 111+00 ELEV 119.06  
 BM 15 SPIKE IN ROOT 28" ELEV 122.11 STA 113+10 ELEV 86.68  
 BM 16 STONE IN TOP CORNER WITH WALL 163' BY STA 120+12 ELEV 66.12

SERIES STATE NO 109 L  
 SHEET 11 OF 50