

INDEX OF SHEETS

SHEET NO. 1	TITLE PAGE
2	TYPICAL CROSS-SECTION OF IMPROVEMENT (SINGLE TRACK COAT OF REFINED TAR - ITEM 30)
3	BANKING AND WIDENING TABLES
4-11	PLAN AND PROFILE
12	STANDARD STRUCTURE SHEET - 520 PIPE CULVERTS
13	30x4 BOX CULVERTS
14	SC1-4
15	SC2-3
16	3-30 GUARD RAIL
17	3-30A UNDERDRAIN
18	3-40 BARRICADES, SIGNS, LIGHTS
19	3-41 ROUNDING OF SLOPES
20-50	CROSS-SECTIONS

STANDARD STRUCTURE SHEETS  
 APPROVED BY THE CHIEF ENGINEER  
 28 JULY 11, 1932  
 29 JULY 11, 1933  
 30 AUG. 13, 1934

STATE OF VERMONT  
 STATE HIGHWAY DEPARTMENT


PLAN AND PROFILE OF PROPOSED  
 STATE HIGHWAY

TOWN OF WILLISTON  
 ESSEX JCT.-WILLISTON ROAD


BEGINNING AT THE INTERSECTION OF ROUTE U.S. 2 WITH ST. 116 AND EXTENDING  
 NORTHERLY TO A POINT 71.5 FT. SOUTHERLY OF THE WILLISTON ESSEX  
 TOWN LINE AT THE BRIDGE OVER THE WINOOSKI RIVER, OMITTING PROJECT WPSS-189A  
 LENGTH OF PROJECT 9692.2 FT. 1.835 MI.

RIGHT-OF-WAY  
 PLANS

Route: Vt 2A  
 Project: ST 189L  
 Pin# 99R 719

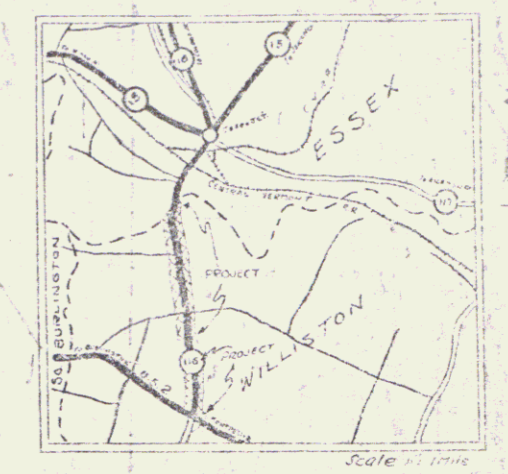

WILLISTON

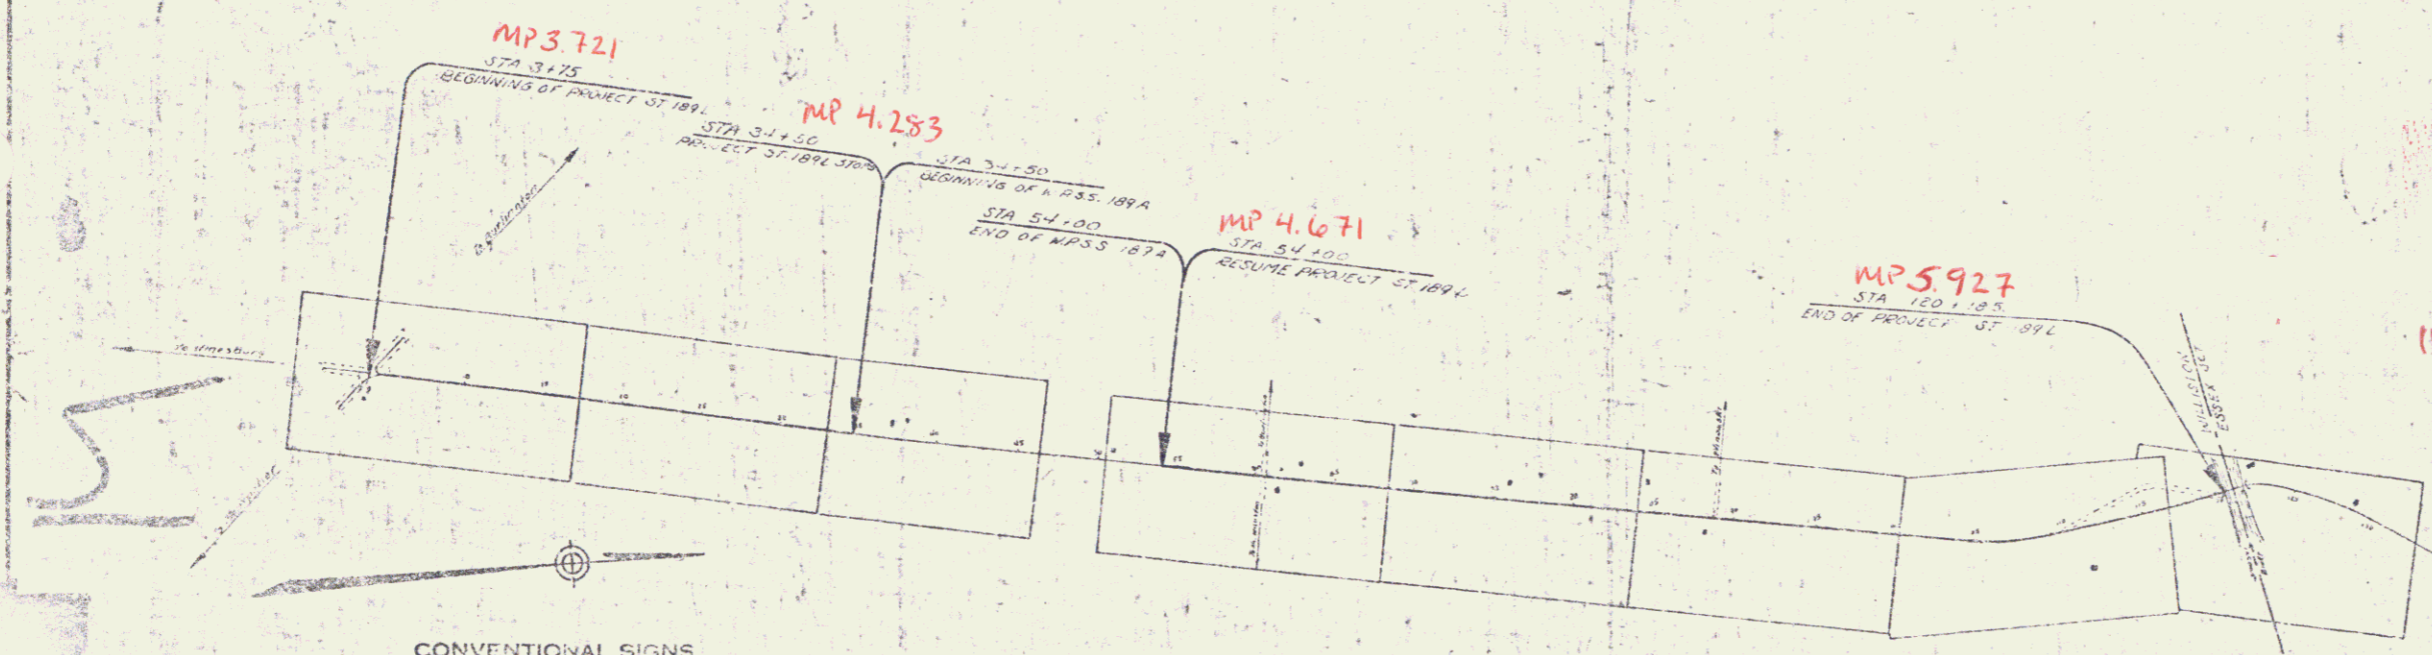

RIGHT-OF-WAY DIVISION  
 TOWN FILE  
 PERPETUAL  
 Town of Vt 2A  
 (To Be Returned To R.O.W. Division)

CONVENTIONAL SIGNS

QUANTITY LINE	GROUND ELEVATION
POINT	ELEVATION
POINT	ELEVATION

CURVE DATA

DEFLECTION ANGLE	Δ
TYPE OF CURVE	S
LENGTH OF CURVE	C
CHORD DISTANCE	T
PI OF CURVE	L
CHORD BEARING	B
INTERSECTION	P.I.
POINT OF CURVE	P.C.
POINT OF TANGENT	P.T.
POINT OF TANGENT	P.O.T.

SCALES

TITLE	1" = 600'
TYPICAL	1" = 20'
PLAN	1" = 50'
PROFILE	1" = 10'
CROSS SECTIONS	1" = 5'

These plans are subject to such revisions as may be required by the Commissioner of Highways.  
 Construction is to be carried on in accordance with the plans and drawings hereto incorporated.  
 All subsequent proposed revisions and specifications are to be submitted with the plans.


APPROVED: May 16, 1938  
 [Signature]  
 COMMISSIONER OF HIGHWAYS  
 SUBMITTED BY ORDER OF THE STATE HIGHWAY DEPARTMENT

RECOMMENDED  
 RECOMMENDED FOR APPROVAL  
 APPROVED

APPROVED: May 3, 1938  
 [Signature]  
 CHIEF ENGINEER  
 SERIES: 10189L FILED  
 SHEET 1 OF 3

PLAN	REVISIONS
DATE	BY
NO.	NO.


PROJECT	DESCRIPTION
NO.	NO.
DATE	DATE
BY	BY

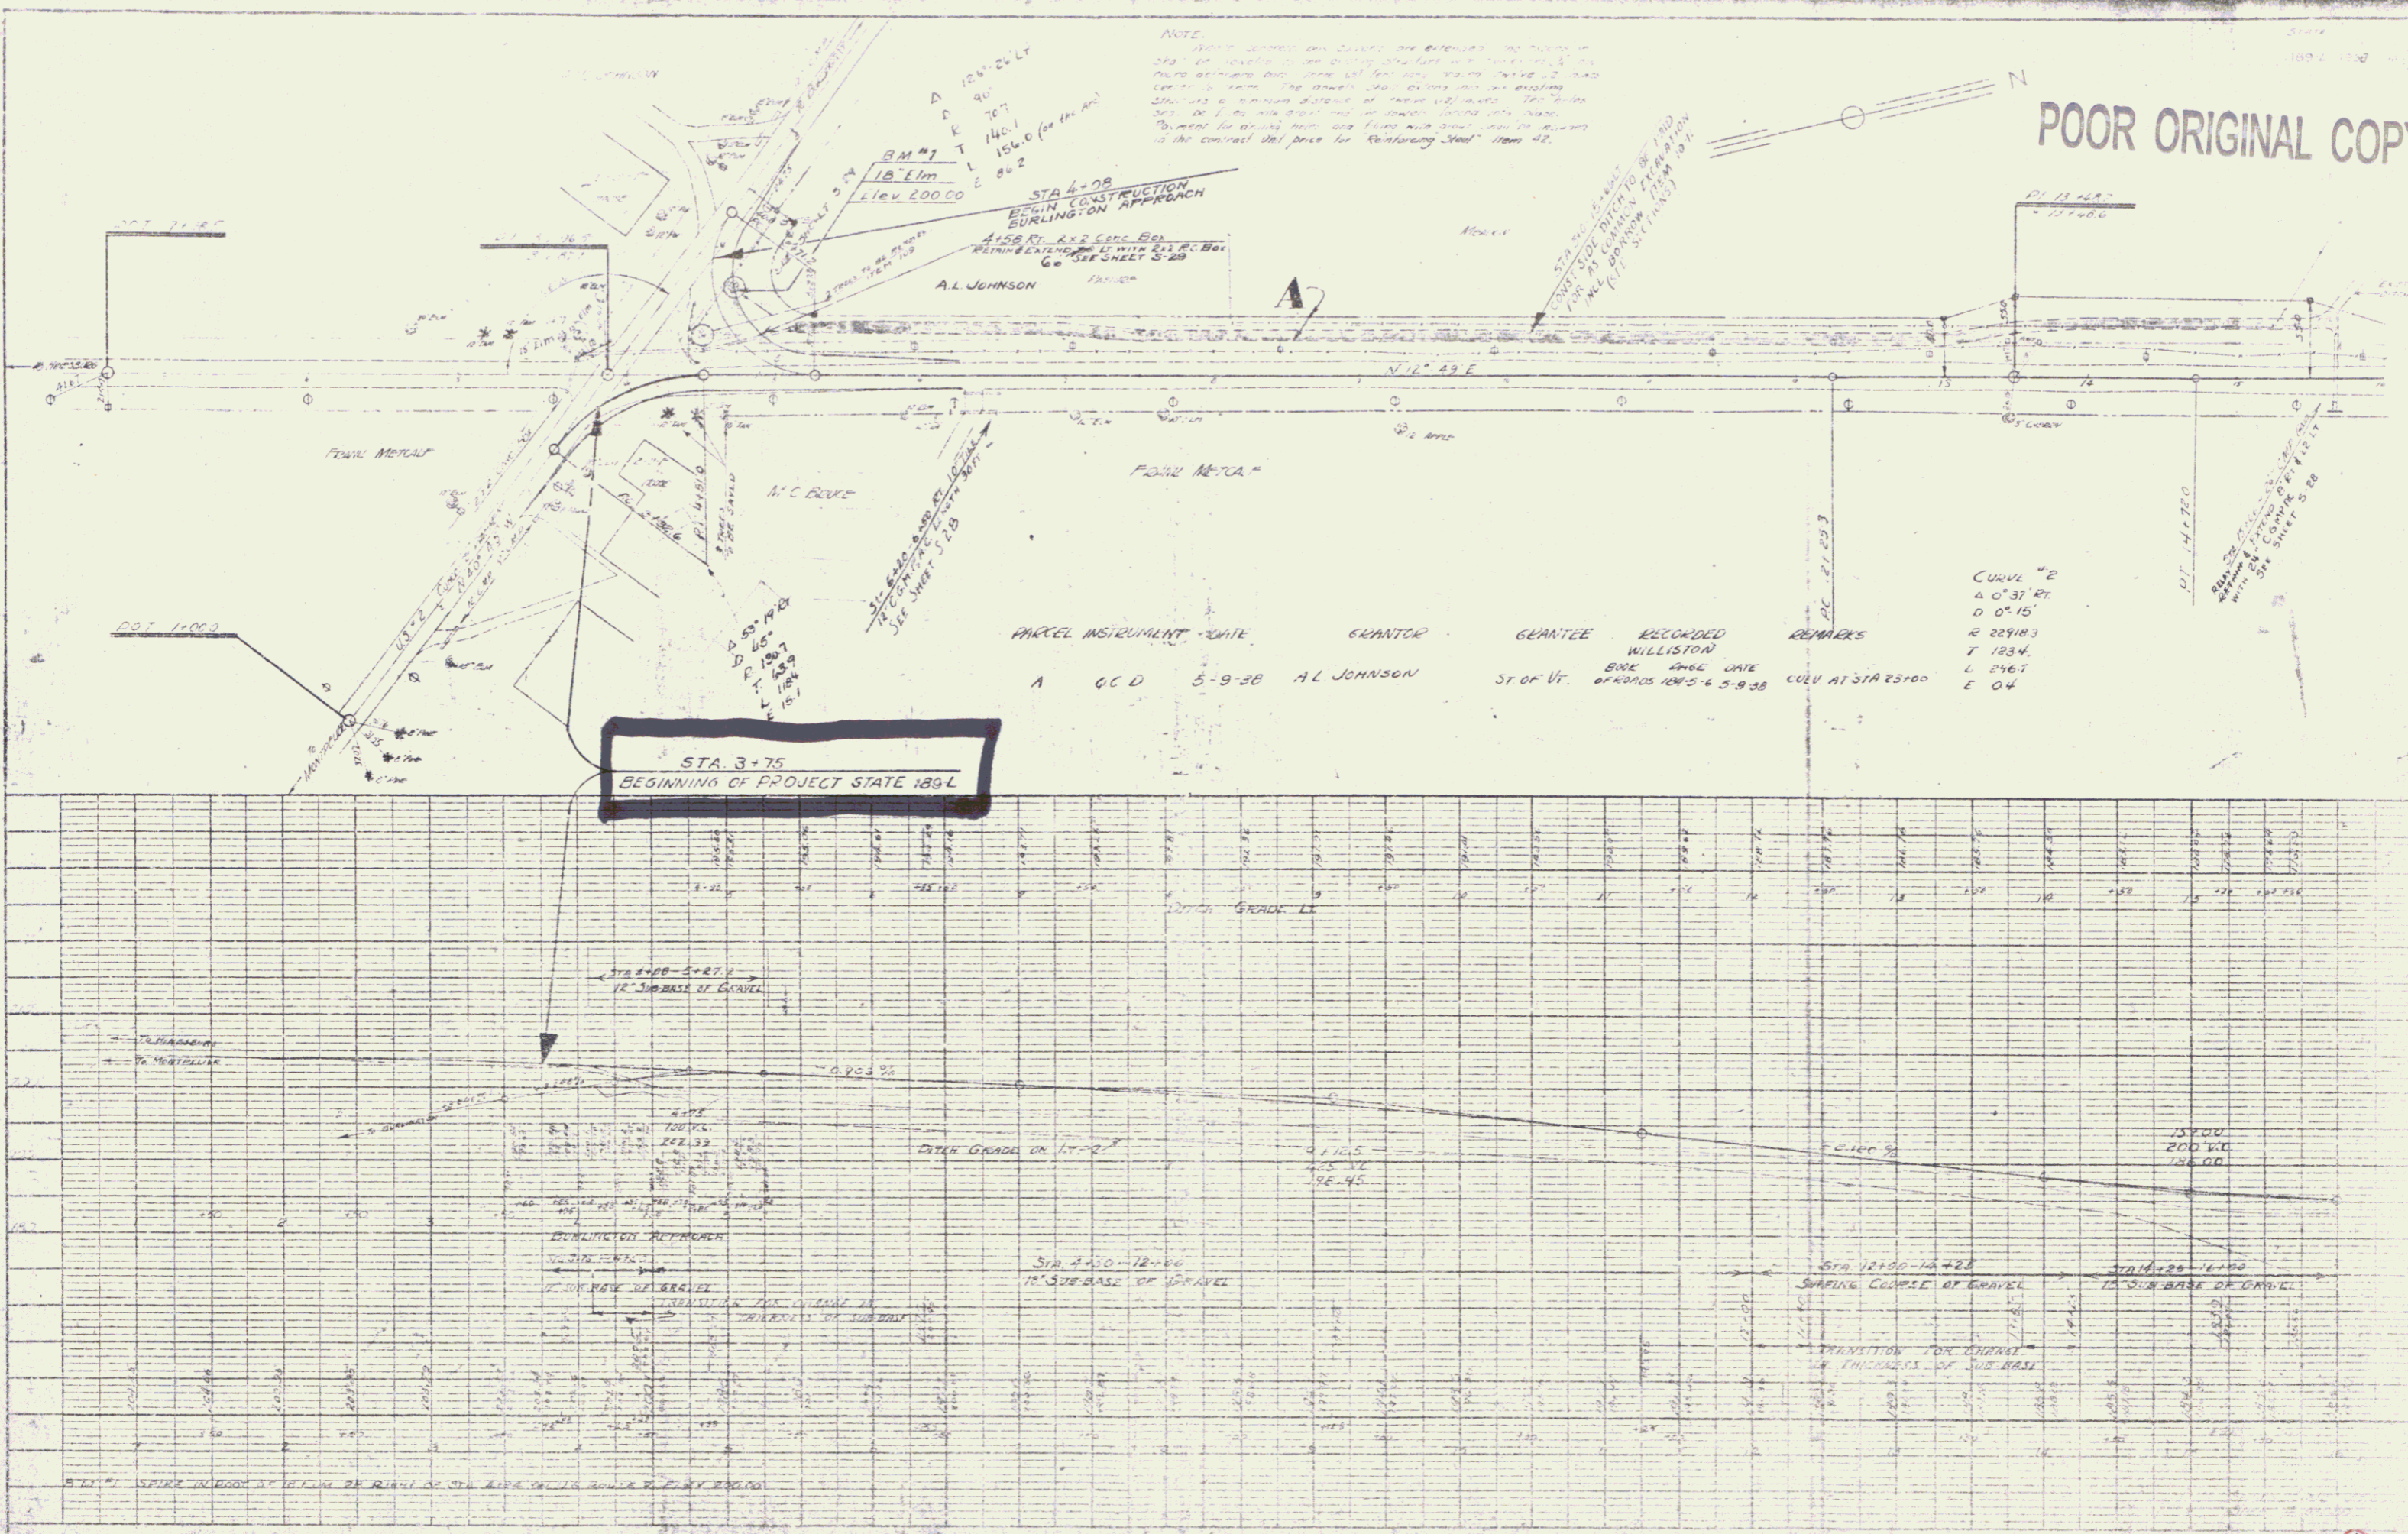

POOR ORIGINAL COPY


DATE  
09 18 1979

PLAN  
 SHEET NO. 1  
 PROJECT NO. 1000  
 DRAWN BY WATKINS  
 CHECKED BY  
 DATE 9-18-79

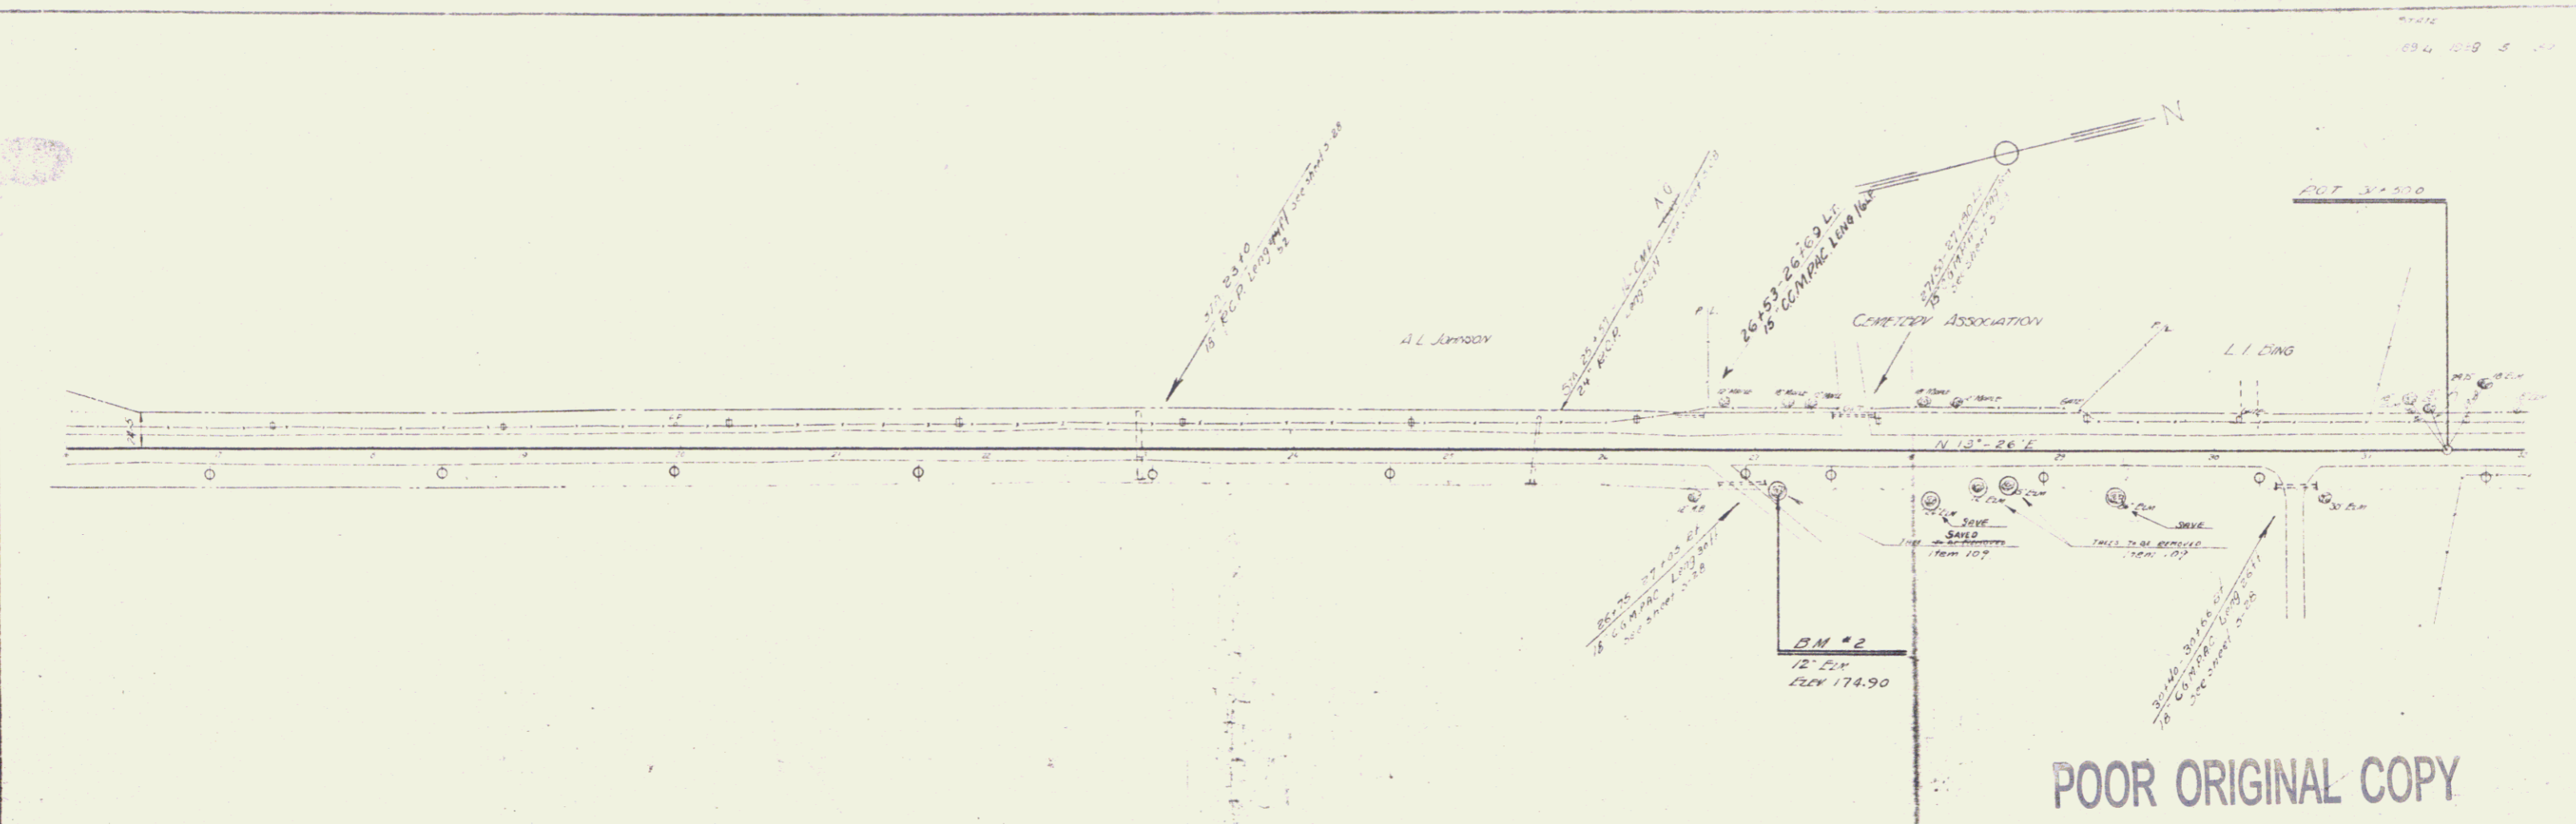

POOR ORIGINAL COPY

PLAN  
 SHEET NO. 2  
 PROJECT NO. 1000  
 DRAWN BY WATKINS  
 CHECKED BY  
 DATE 9-18-79

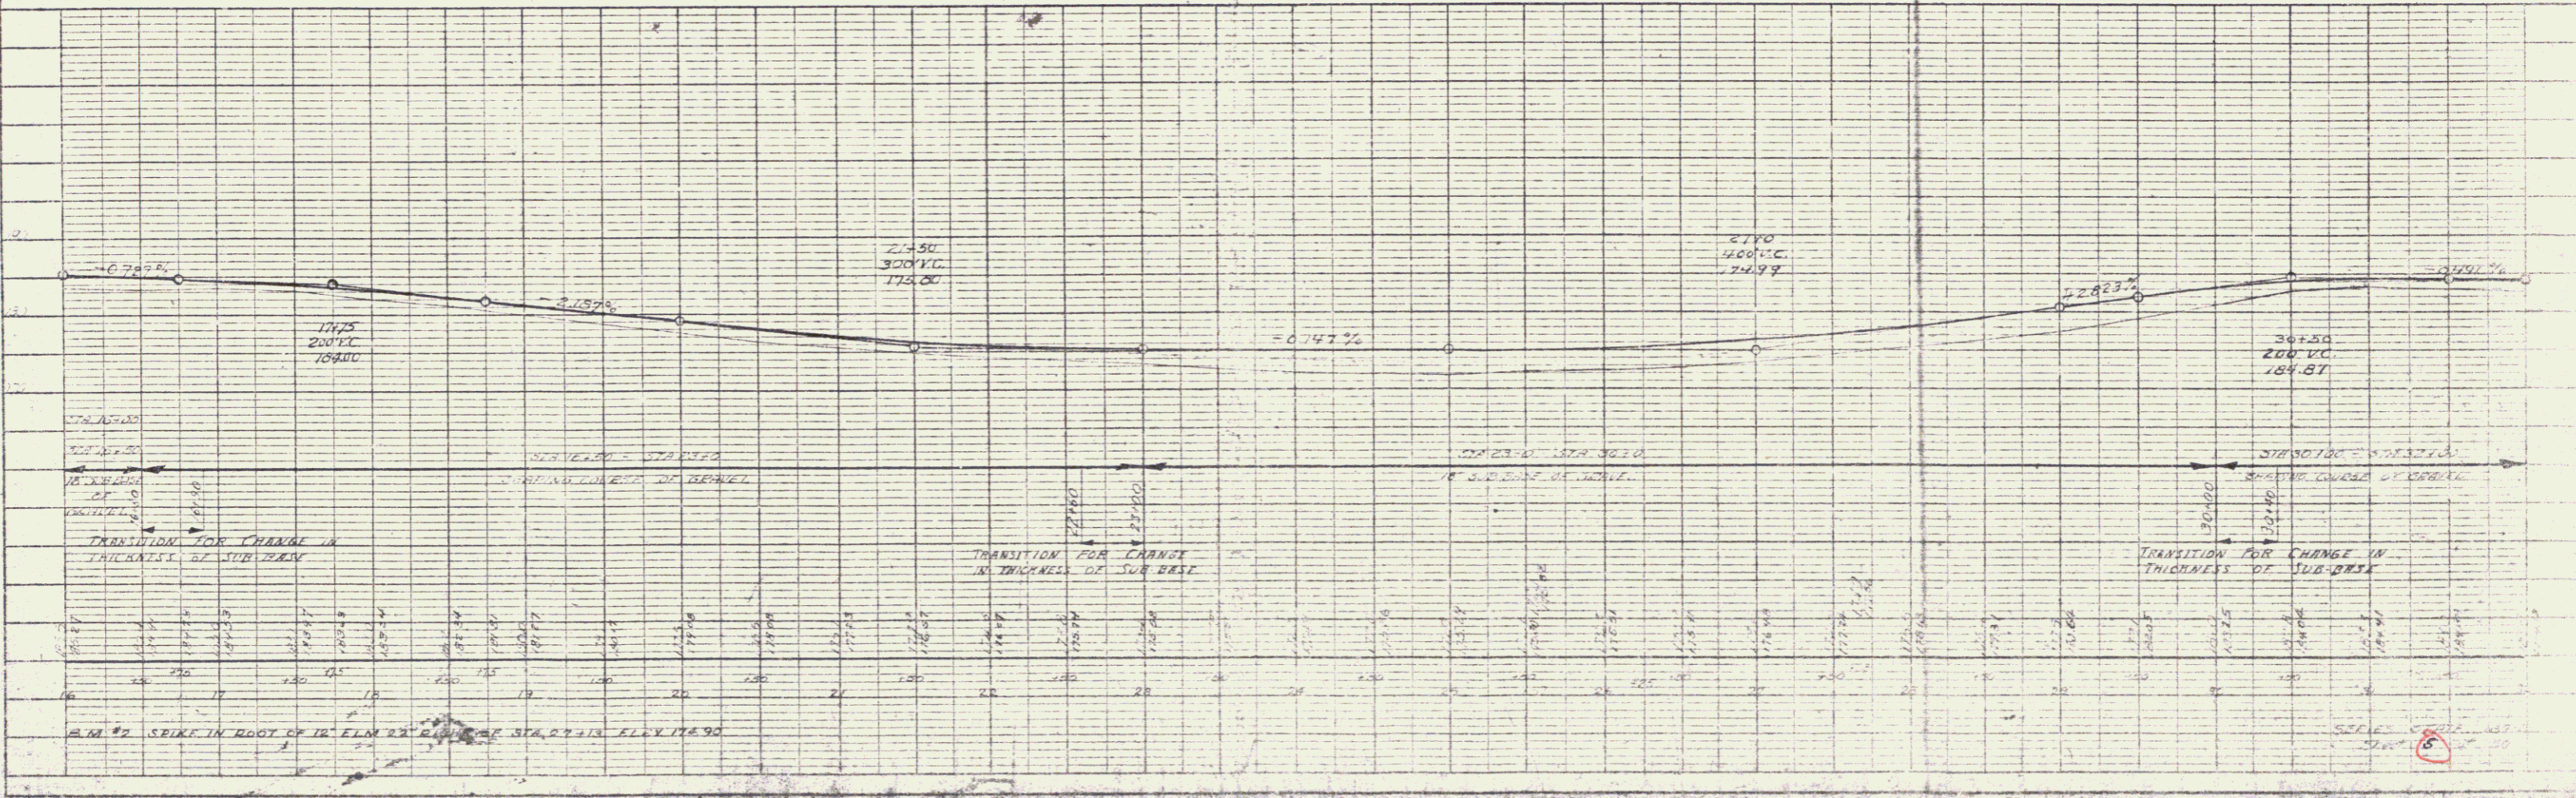


SEP 18 1979 3

Note  
Shoulders shall be widened to 4 ft on  
the old W.P.S.S. Project 189-A, also the slopes  
shall be flattened to a 1 on 3 wherever  
possible - Sta 34+00 to Sta 34+00




PLAN	DATE	BY	CHKD.
NO.	10/2/77	J.A.	J.A.
PROJECT	STATE 189-L		
SECTION	STATION 34+00 TO 34+50		
SCALE	1" = 40'		

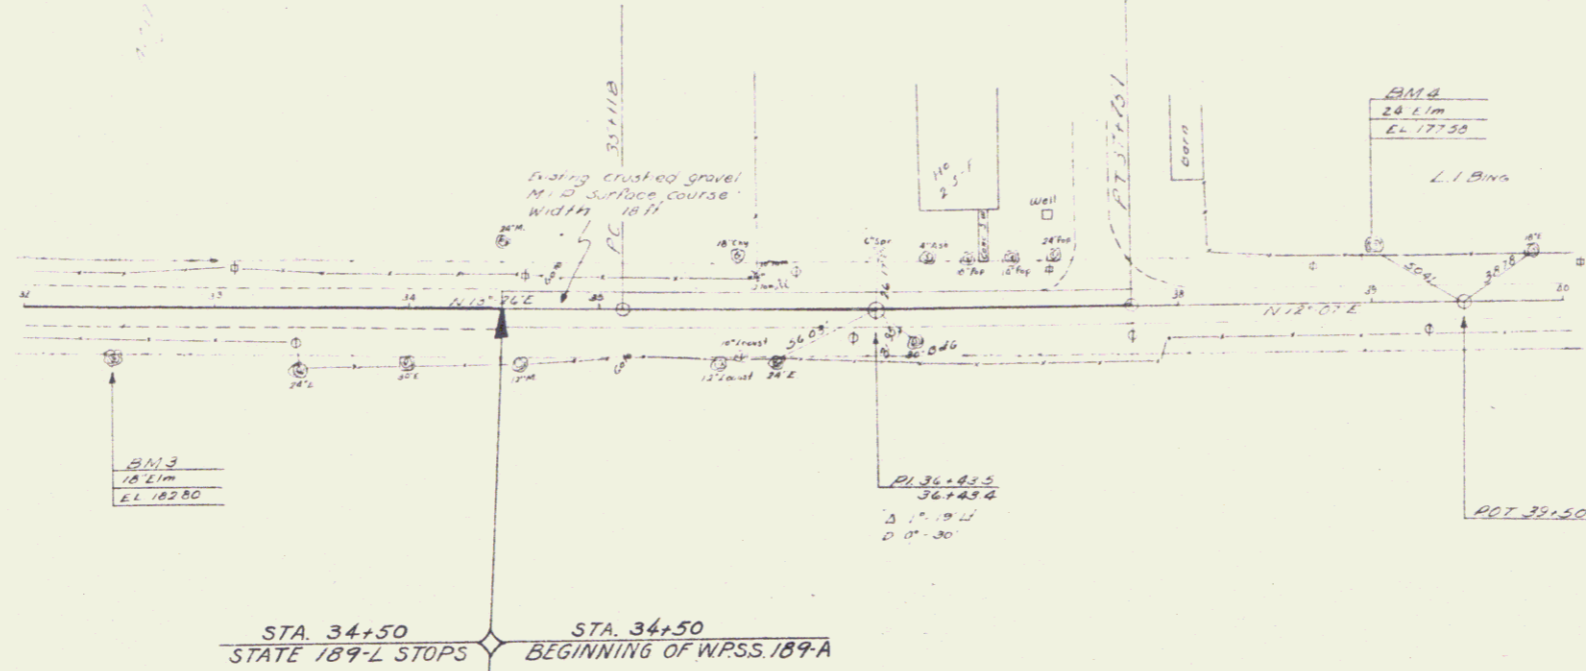



STA. 34+50 STATE 189-L STOPS  
STA. 34+50 BEGINNING OF W.P.S.S. 189-A

PROFILE	DATE	BY	CHKD.
NO.	10/2/77	J.A.	J.A.
PROJECT	STATE 189-L		
SECTION	STATION 34+00 TO 34+50		
SCALE	1" = 40'		

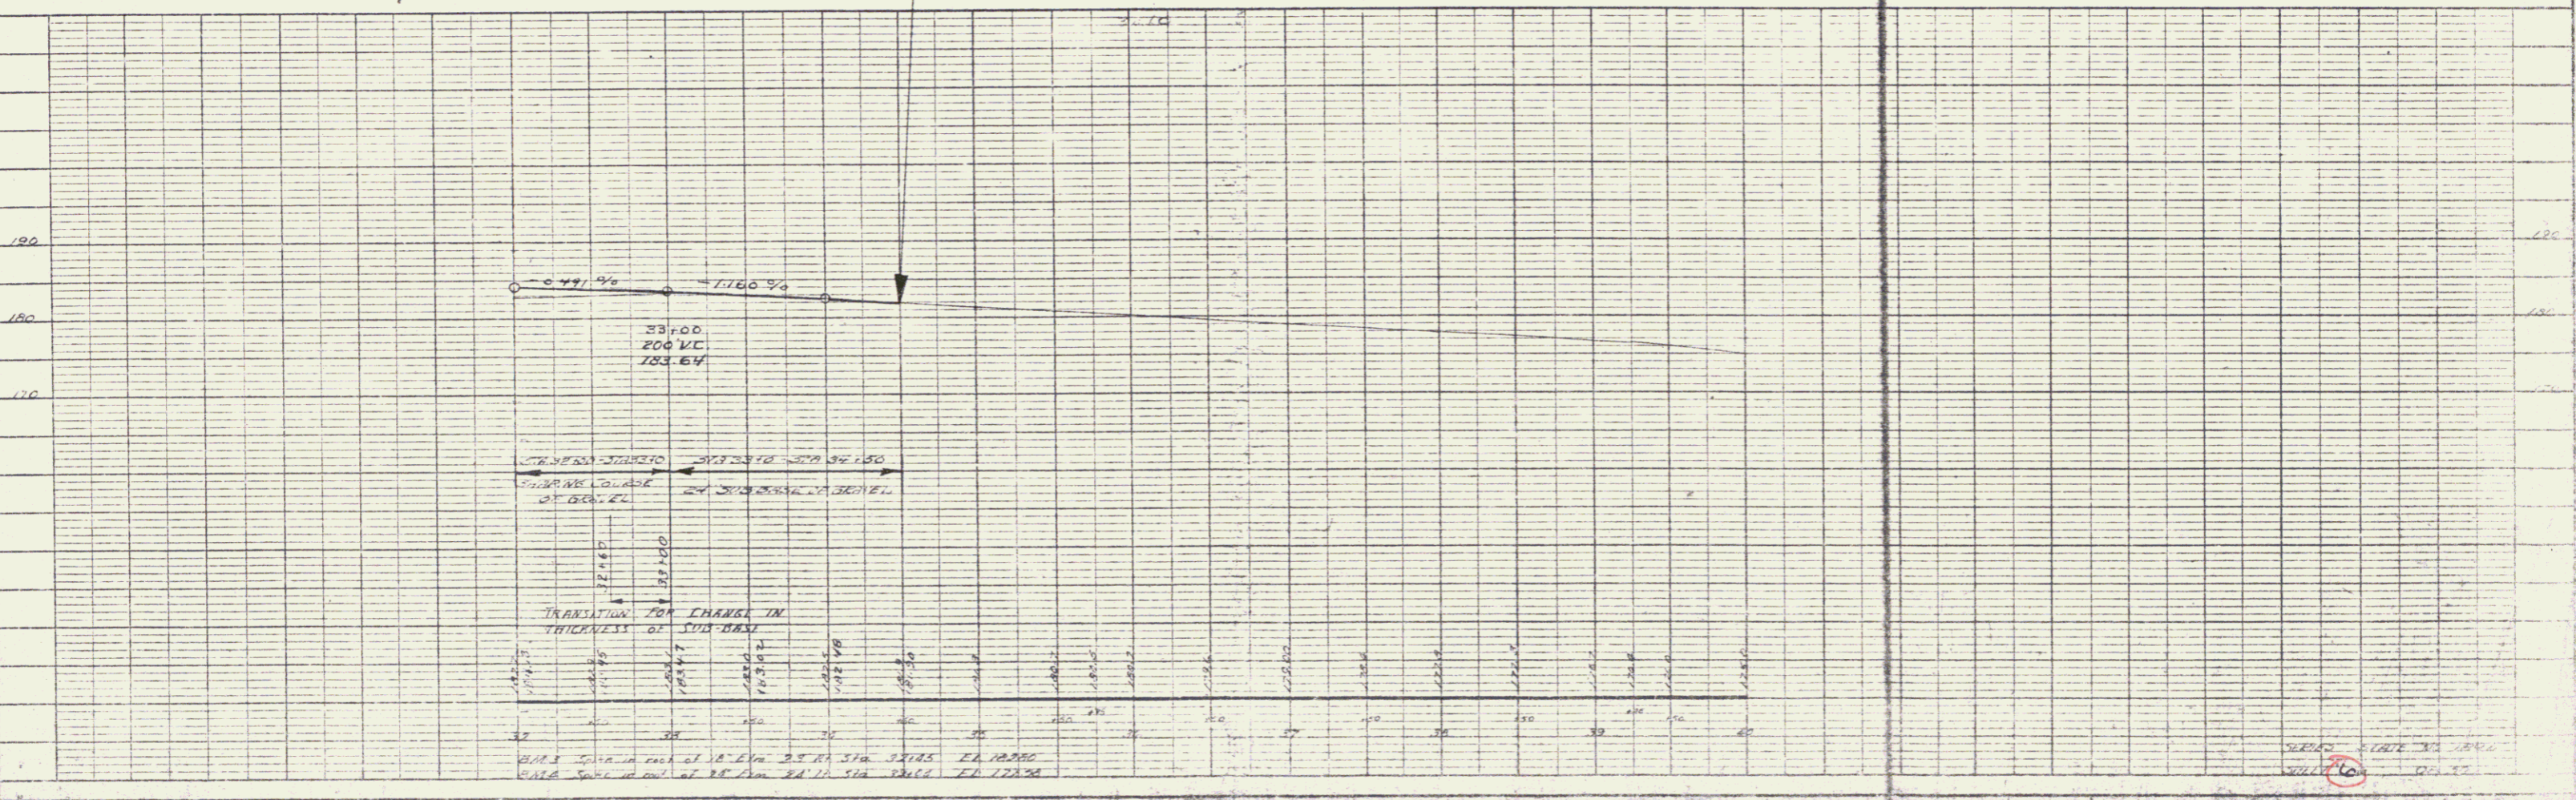


SEP 18 1979



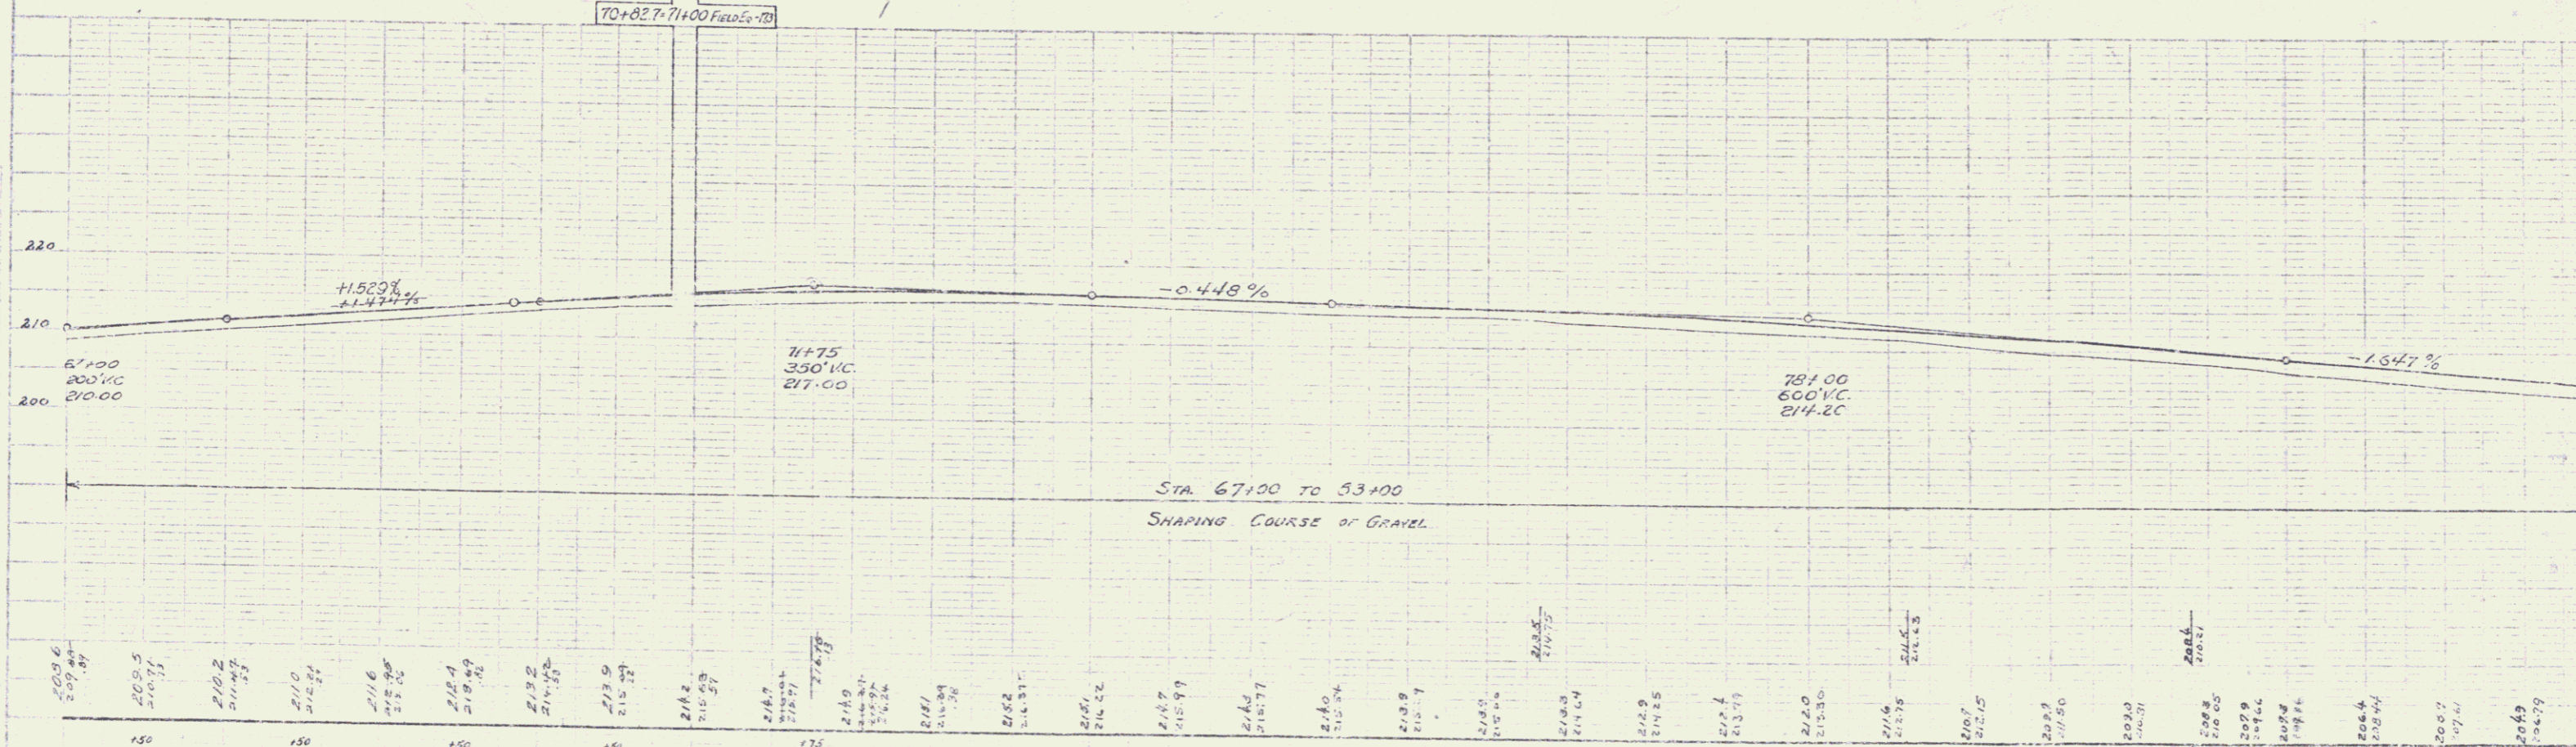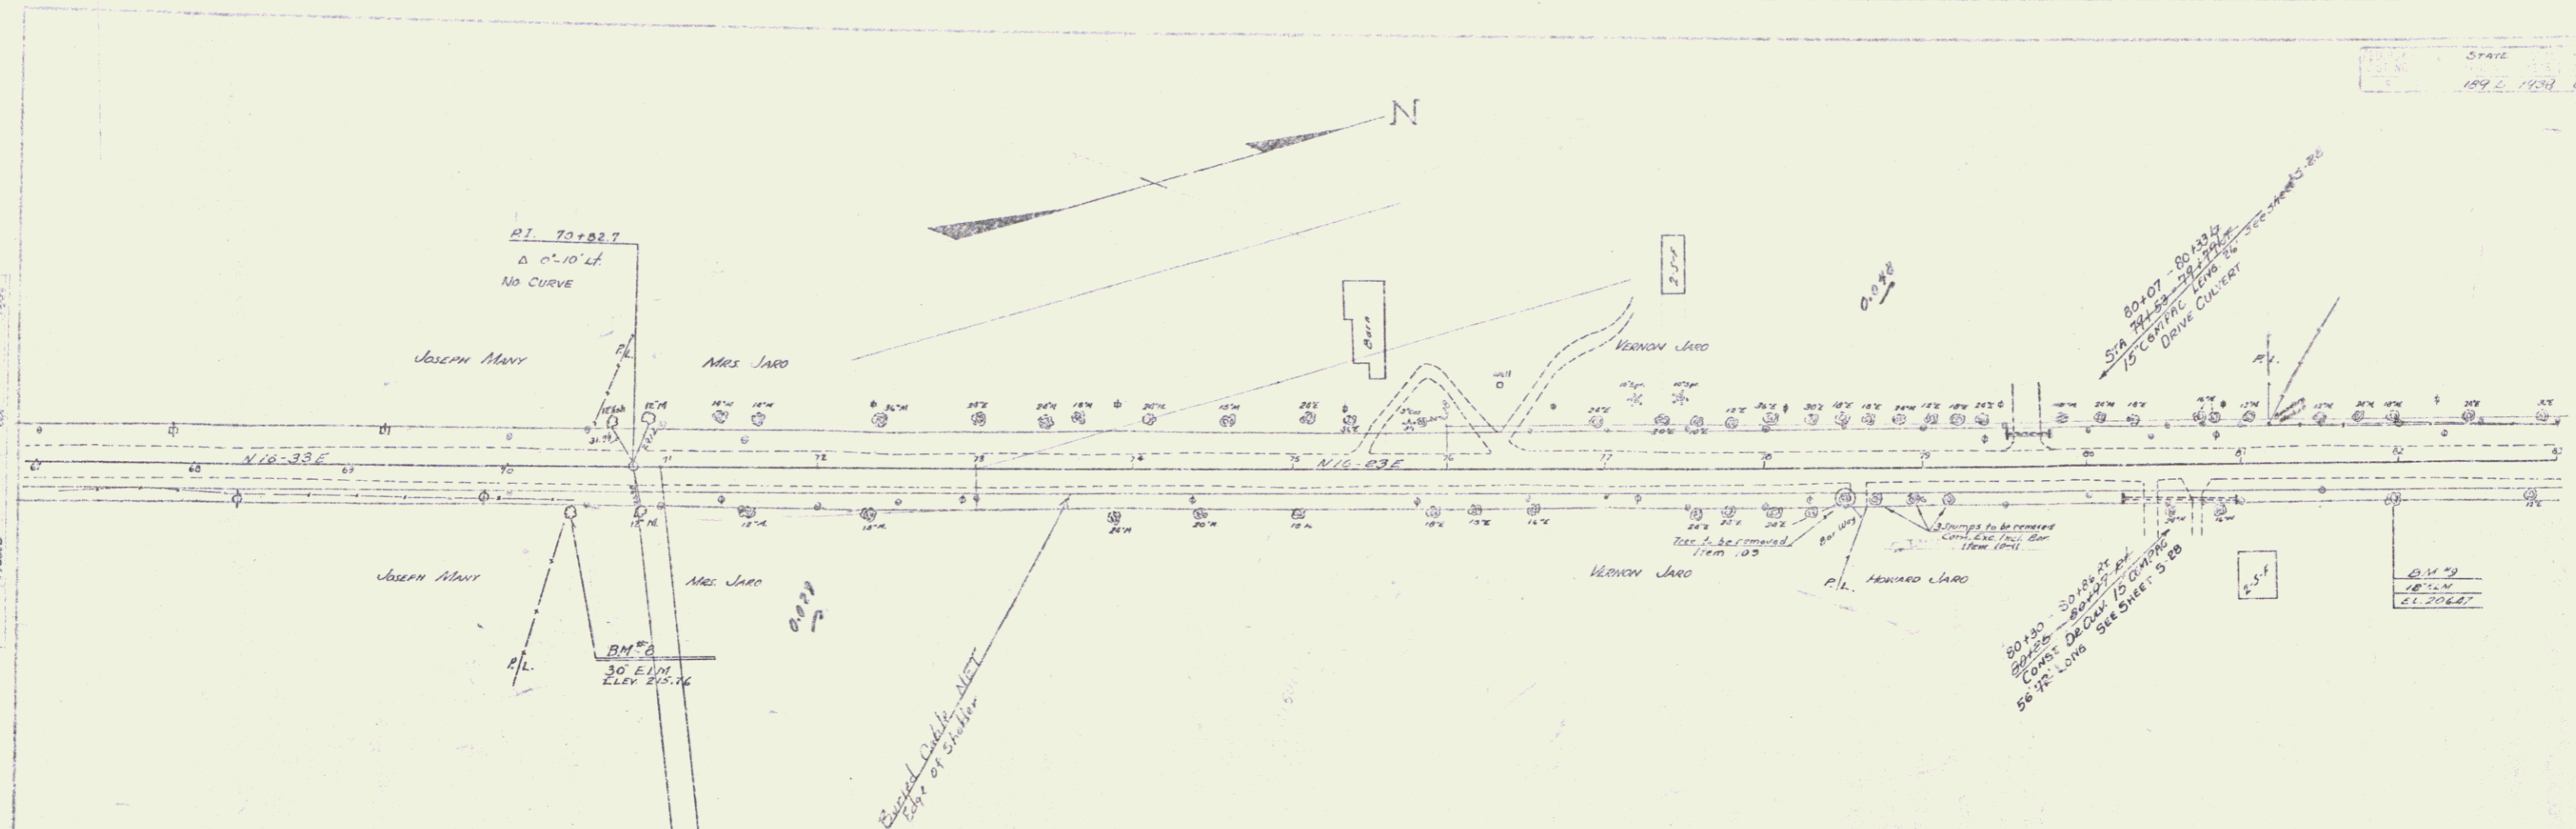


67	68	69	70	71	72	73	74	75	76	77	78	79	80	81	82	83
209.4	209.5	210.2	211.0	211.6	212.4	213.2	213.9	214.8	215.7	216.7	217.5	218.3	219.2	220.0	220.8	221.7

BM 15 Spike in root of 31' Elm 27' RH Sta 70+00 Elev. 215.72  
 BM 2 Spike in root of 15' Elm 15' RH Sta 81+26 Elev. 206.87

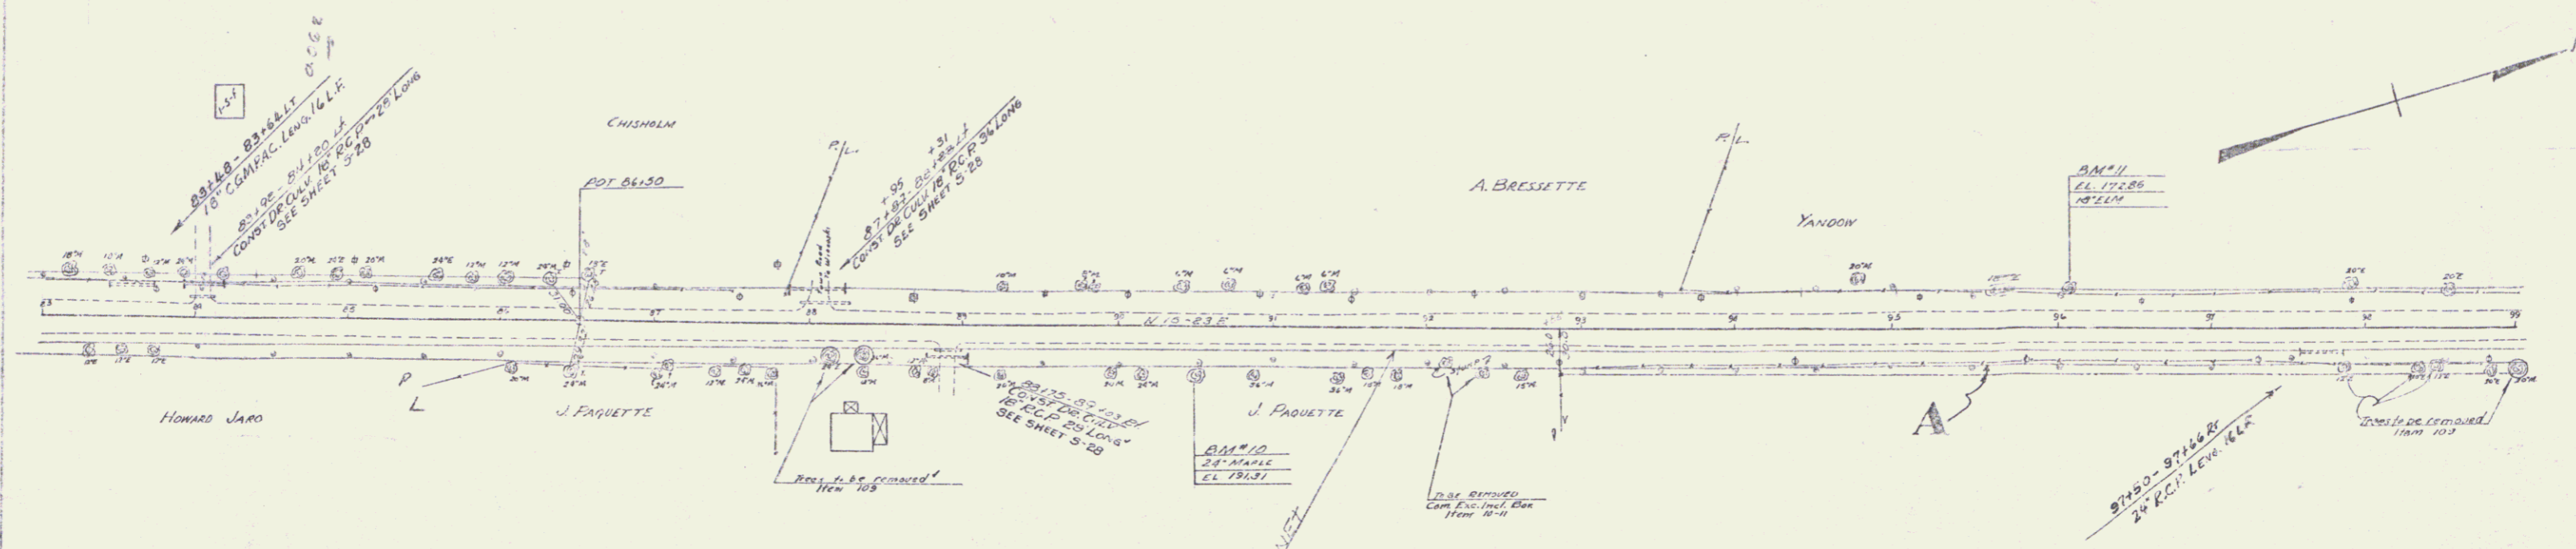


PARCEL	INSTRUMENT	DATE	GRANTOR	GRANTEE	RECORDED	REMARKS
A	Q.C.D.	5-5-38	CEVILLE J. & AGNES A. YANDON	STOFV.	BOOK PAGE DATE	WILLISTON 8002 1948 5-9-38

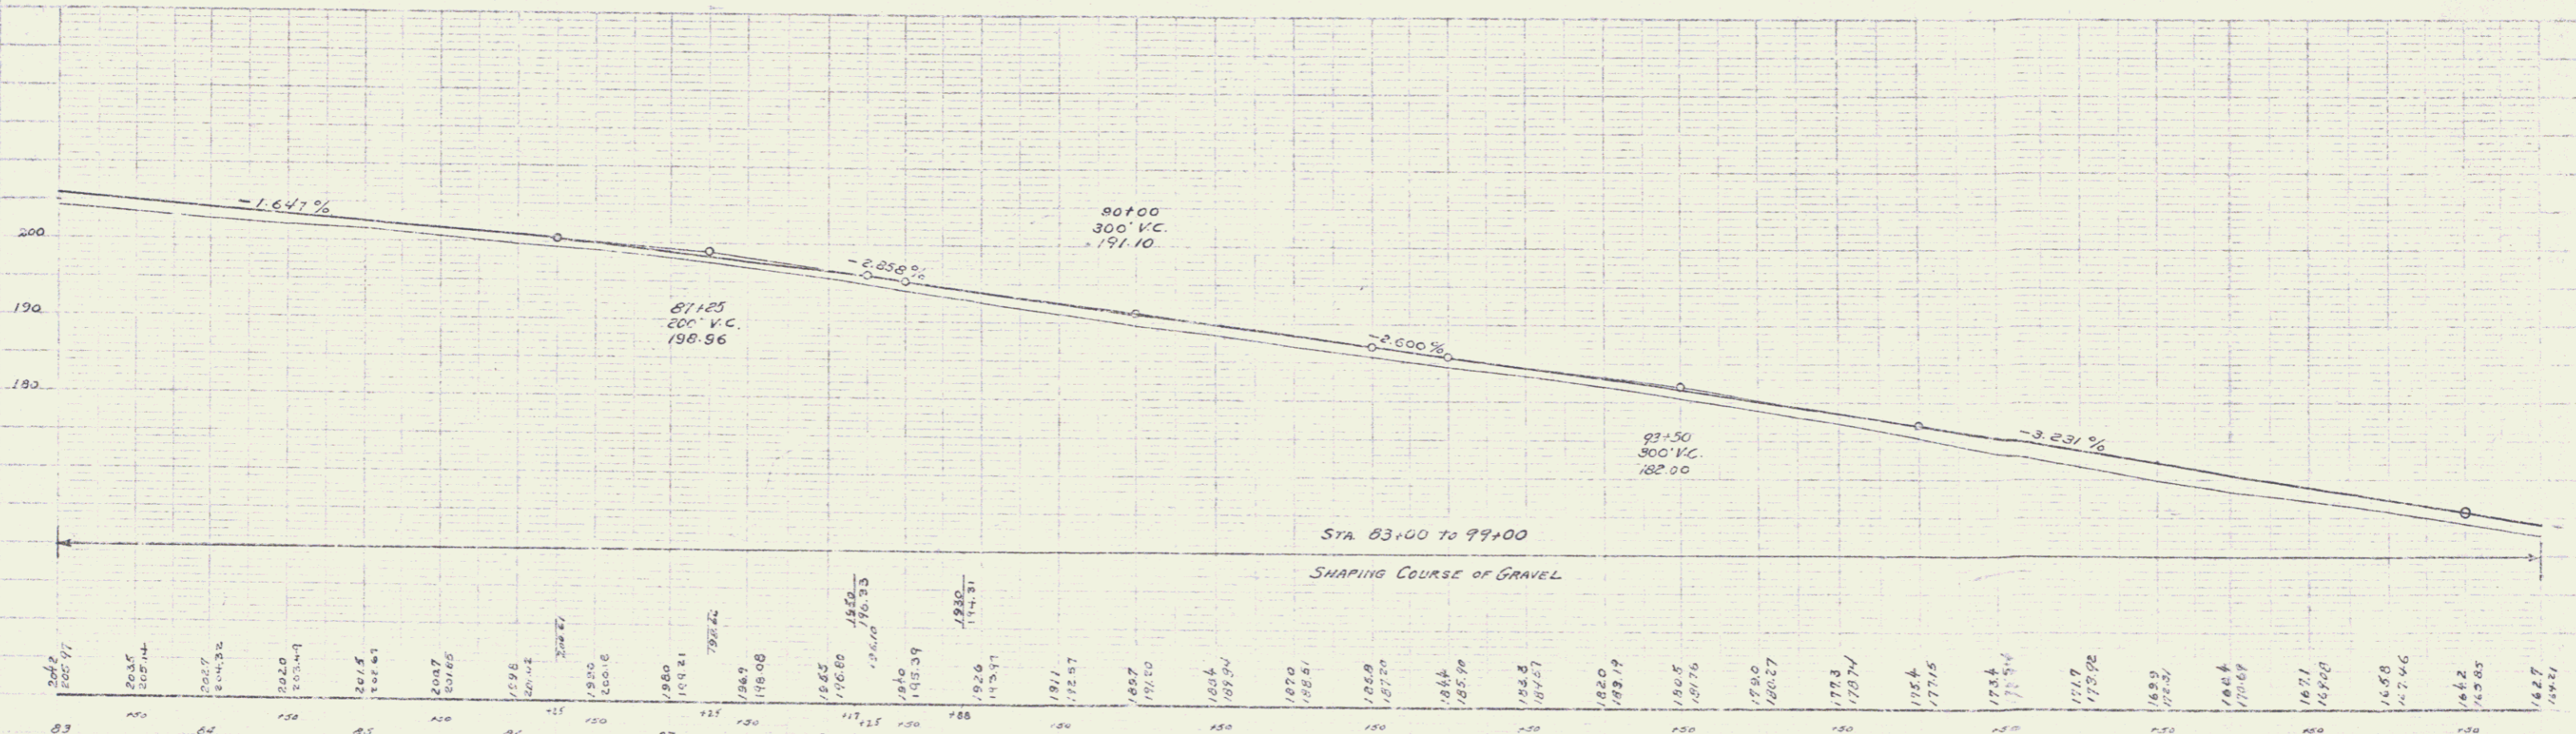

Sta	83	84	85	86	87	88	89	90	91	92	93	94	95	96	97	98	99
Elev	180.00	180.00	180.00	180.00	180.00	180.00	180.00	180.00	180.00	180.00	180.00	180.00	180.00	180.00	180.00	180.00	180.00




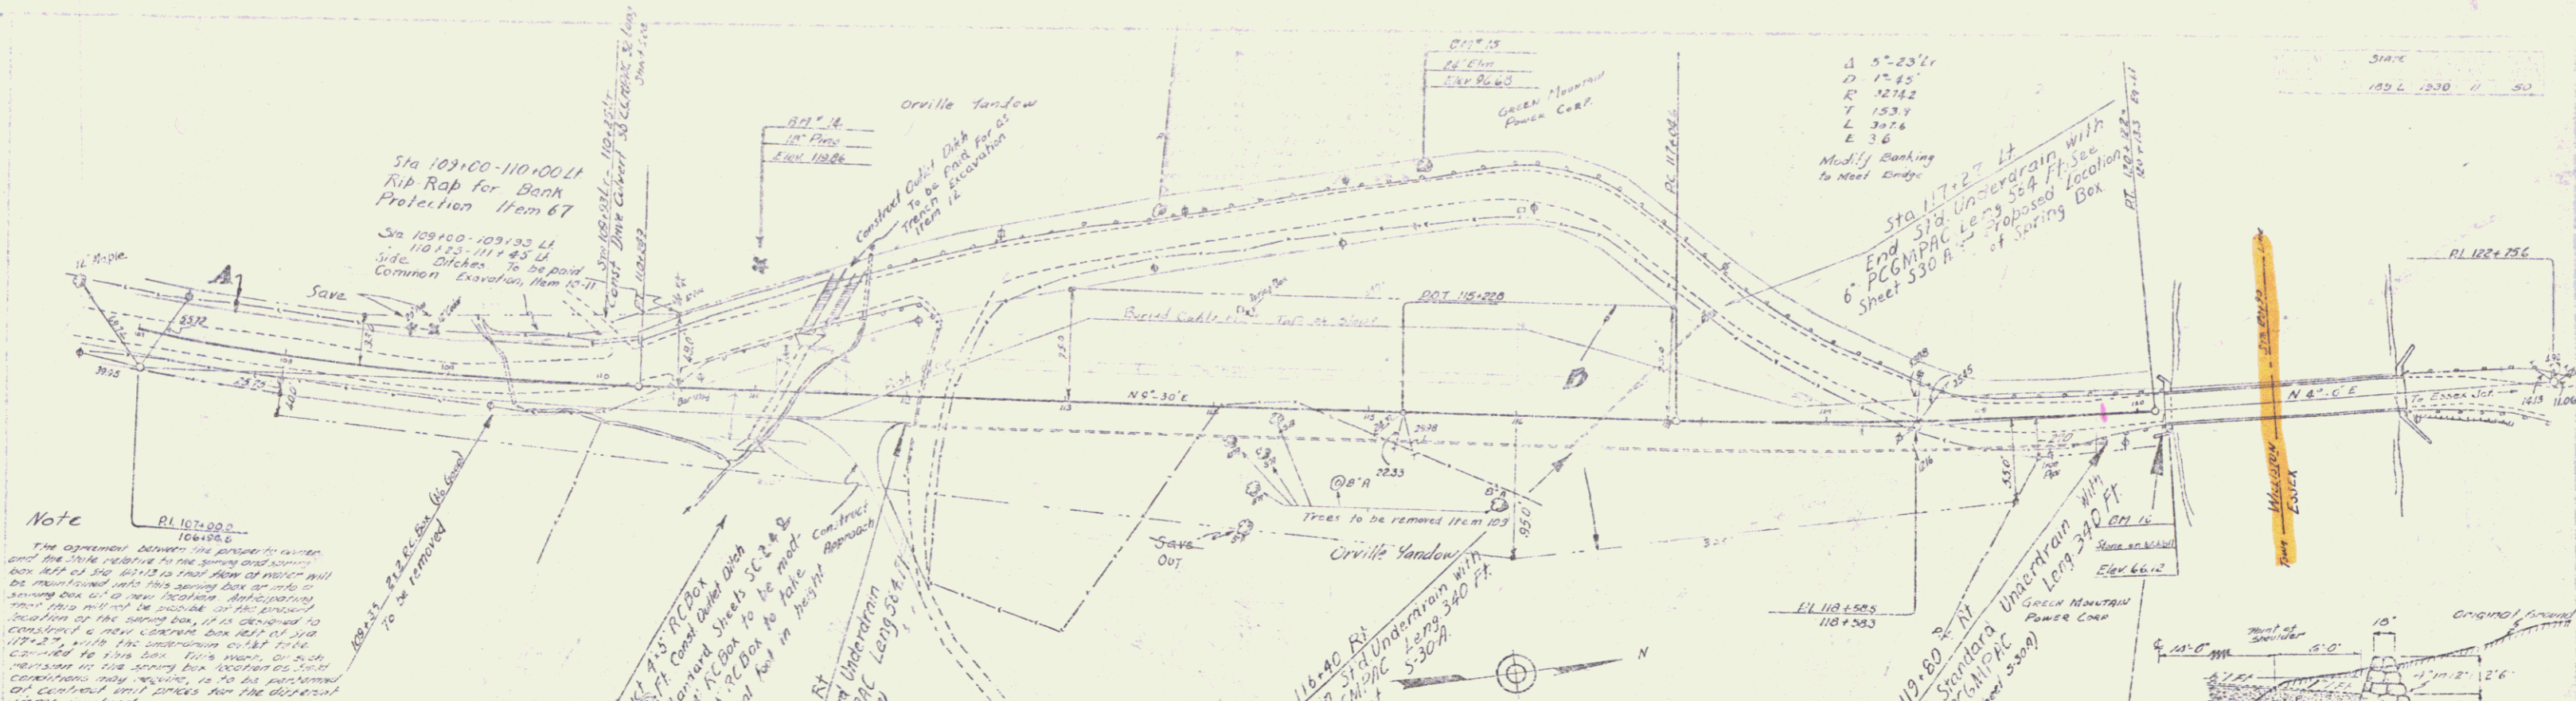

**Note**  
 The contract between the contractor and the State relative to the spring excavation box shall be such that the item of interest will be maintained until the spring box is in place or until the spring excavation is completed. The contractor shall be responsible for the maintenance of the spring box until it is completed. The contractor shall be responsible for the maintenance of the spring box until it is completed. The contractor shall be responsible for the maintenance of the spring box until it is completed.

Contract Call for Proposals  
 To be paid for  
 Common Excavation Item 10-11  
 118+00 RI  
 Begin 3" Underdrain with 6" PCGMIPAC Length 300 ft. See Sheet 109-L  
 112+00-RT  
 Begin Standard Underdrain with 6" PCGMIPAC Length 54 ft. See Sheet 109-L

PARCEL INSTRUMENT	DATE	GRANTOR	GRANTEE	RECORDED MILLISIM	REMARKS
A-0	a.c.d.	2-18-35	ORVILLE, AGNES A. YANDRY	510-11	8307 1-8 225-30 1067-44

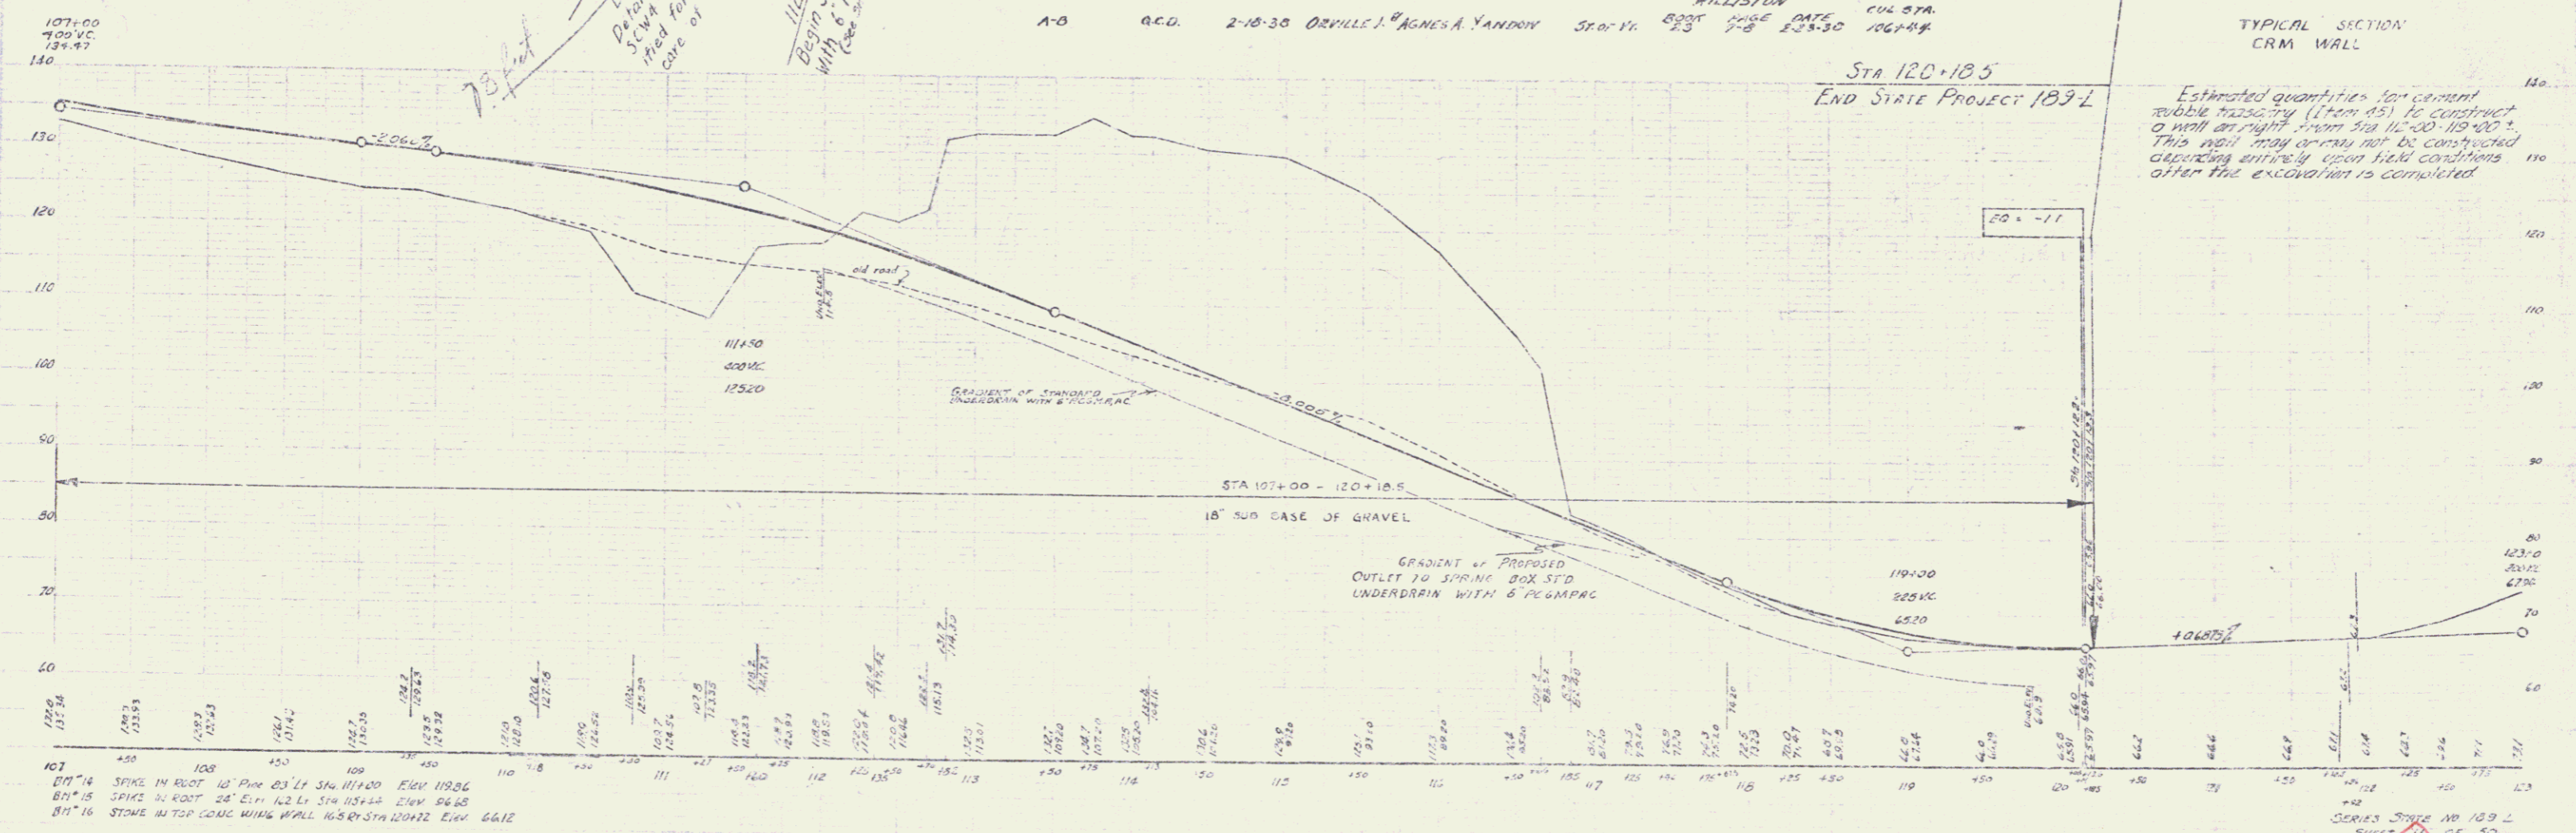

Estimated quantities for cement rubble masonry (Item 85) to construct a wall on right from Sta 112+00-119+00. This wall may or may not be constructed depending entirely upon field conditions after the excavation is completed.

SERIES STATE NO 189-L SHEET 11 OF 50

