
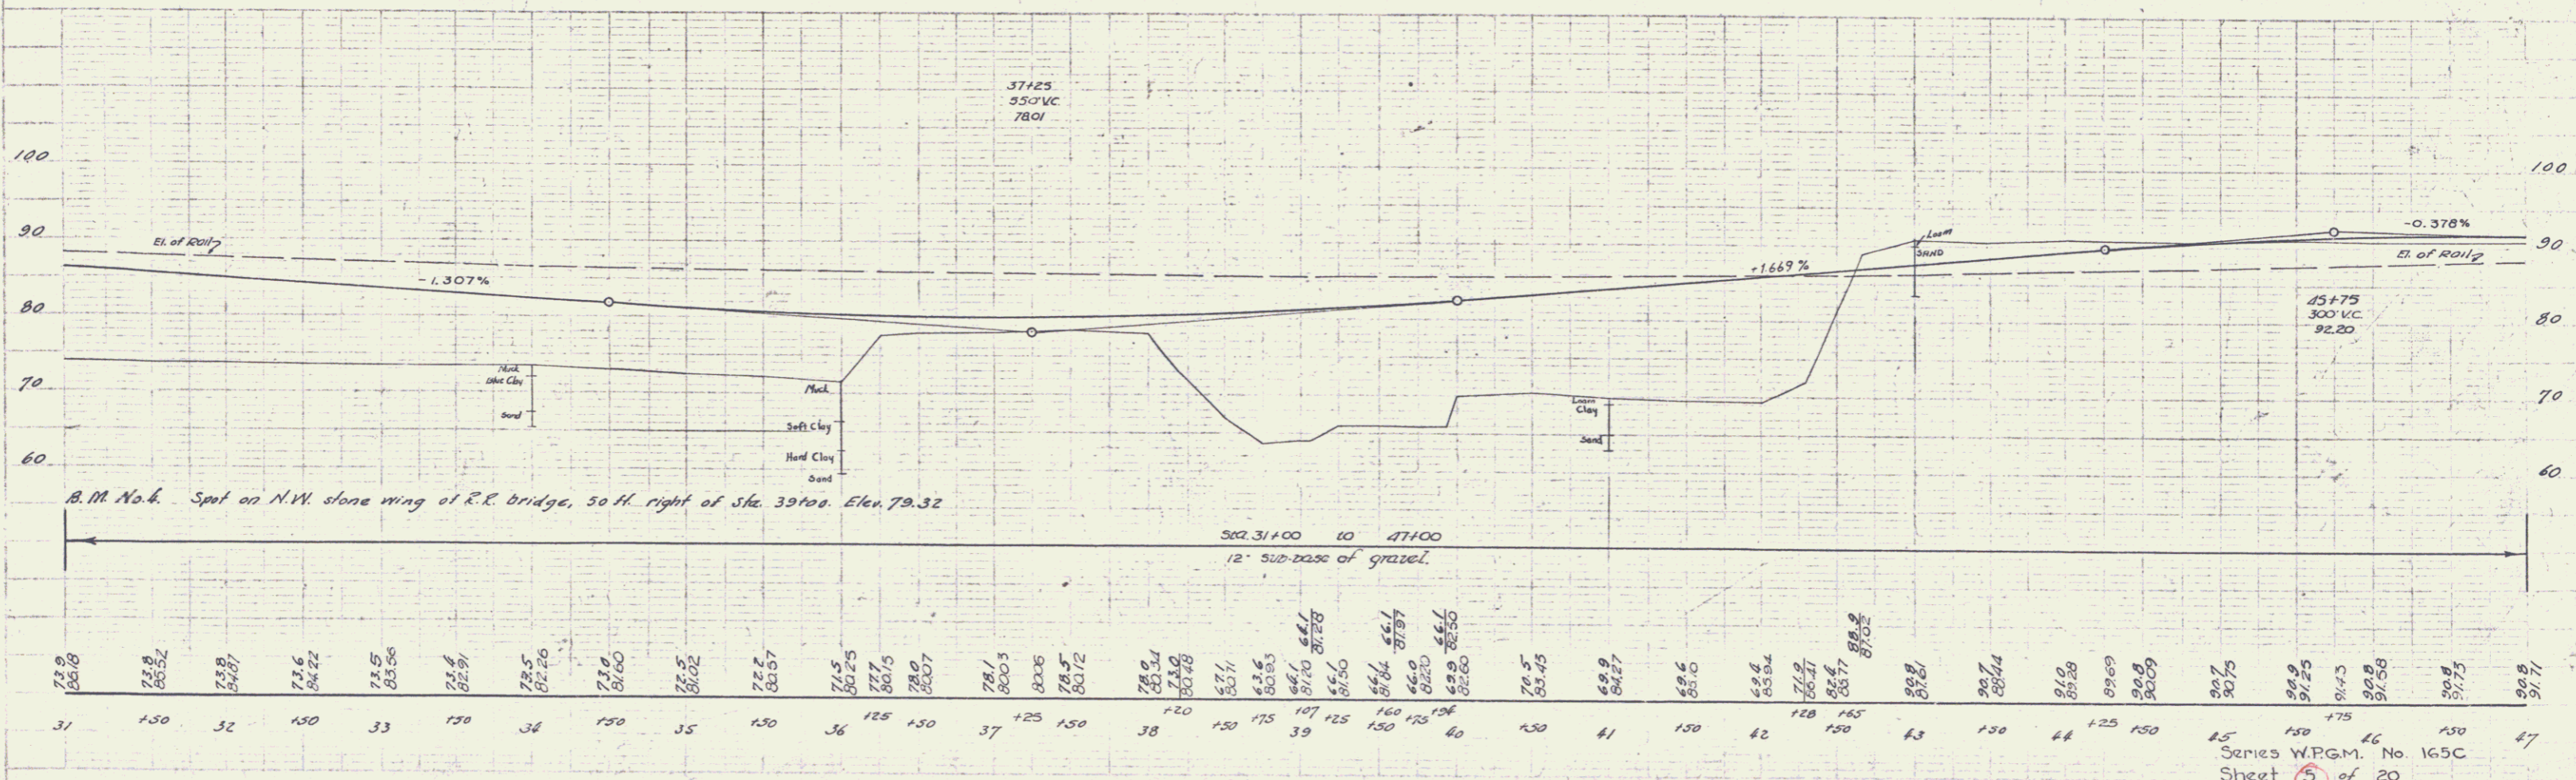


Parcel	Kind of Instrument	Date of Instrument	Grantor	Grantee	Received Essex	Remarks
A	Y.D.	10-24-35	Milton Coop Dairy Corp	S. J. of H. B. Willey Est.	Boh Page	11-20-35
A	"	1-13-36	H.B. Willey Est.	"	A1 H.S.	1-23-36
A	Condemnation	11-1-35	Cent. Vt. Ry. Inc.	"	"	11-2-35 Filed

165C 19% 5 20

NOTE:
CULVERT CONSTRUCTED EXACTLY AS DESIGNED
AND SHOWN ON SHEET II SERIES W.R.G.M. 165-C

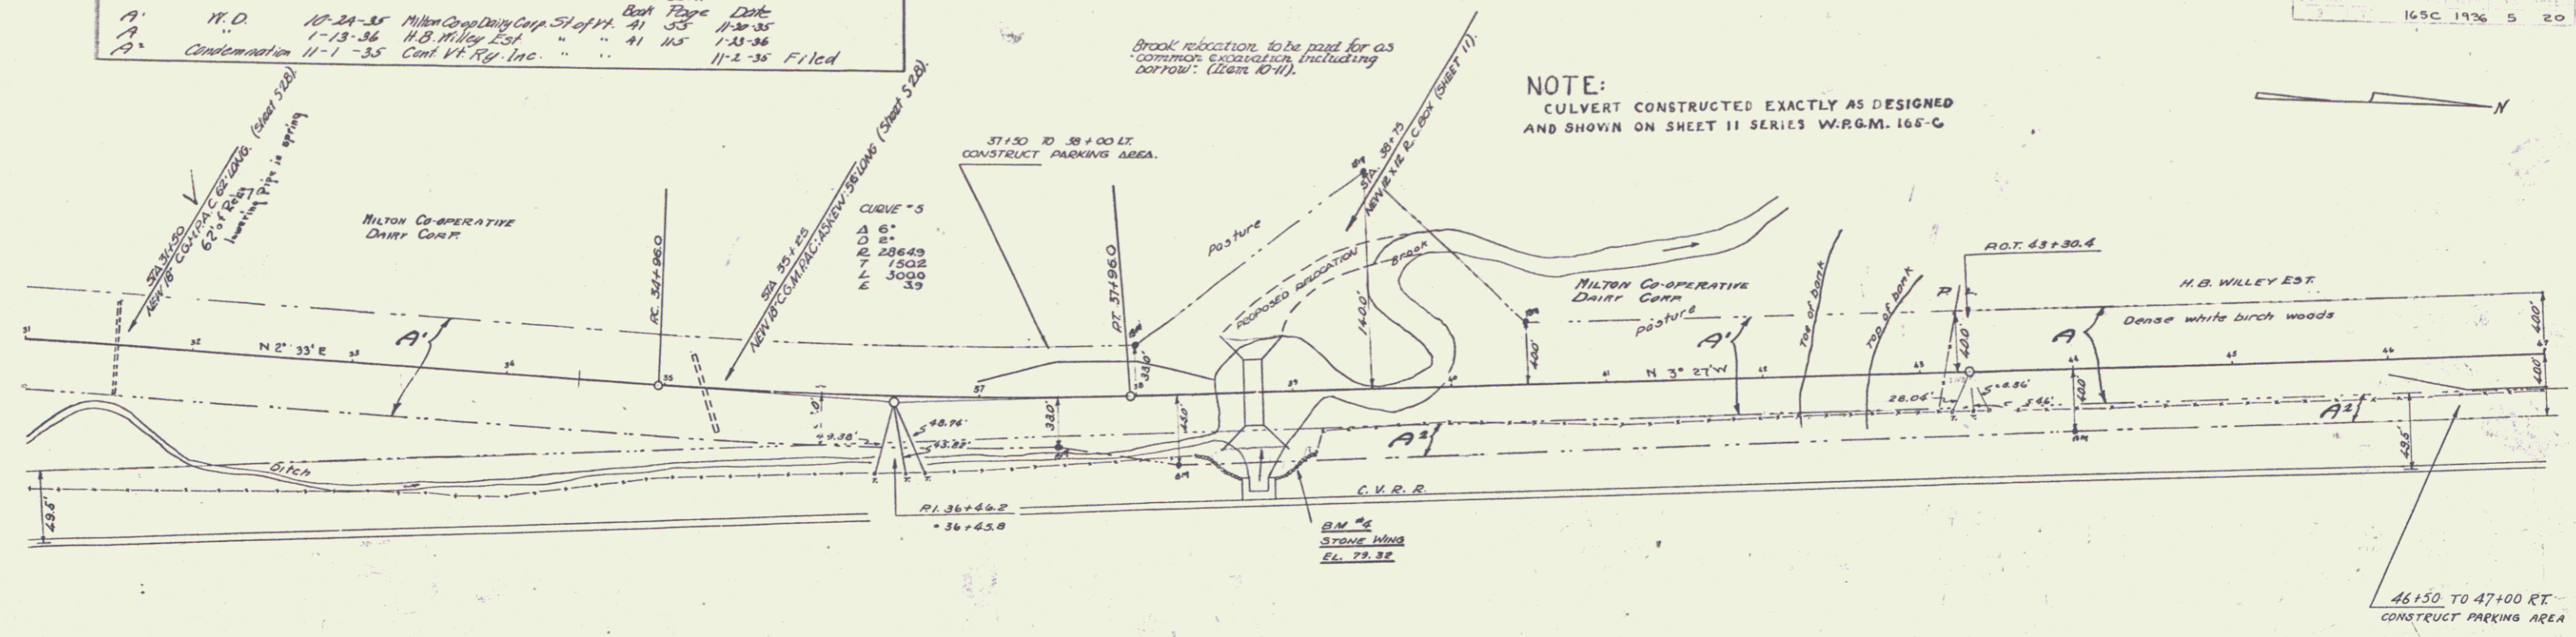

Series W.R.G.M. No. 165C
Sheet 5 of 20

6