

INDEX OF SHEETS

SHEET NO.	TITLE PAGE
2	TYPICAL CROSS-SECTION OF IMPROVEMENT GRADING-BASE AND DRAINAGE
3	BANKING & WIDENING TABLES
4-12	PLAN & PROFILE SHEETS
13	STANDARD STRUCTURE SHEET 5 22 PIPE CULVERTS
14	DOCK CULVERTS
15	UNDERDRAIN DOOR CULVERTS
16	50 BARRICADES-SIGNS & LIGHTS
17-39	CROSS SECTIONS

STANDARD STRUCTURE SHEETS 5 28-529 APPROVED BY THE CHIEF ENGINEER ON JULY 13, 1933
 STANDARD STRUCTURE SHEET 530 APPROVED BY THE CHIEF ENGINEER ON AUGUST 13, 1933.

**STATE OF VERMONT
 STATE HIGHWAY DEPARTMENT**

**PLAN AND PROFILE OF PROPOSED
 STATE HIGHWAY**

NATIONAL RECOVERY SECONDARY PROJECT

TOWNS OF ESSEX & COLCHESTER


ESSEX JCT.-COLCHESTER ROAD
 FROM A POINT 100 FT. SOUTH OF THE RESIDENCE OF EUGENE PARISEAU NORTHERLY 2.091 MI. TO A POINT 200 FT. SOUTH OF THE RESIDENCE OF HENRY CROSS.

LENGTH OF PROJECT-11,040.9 FT.
 = 2.091 MILES


Pin # 99R727

Route: VT. 2A

Project: NRS 165

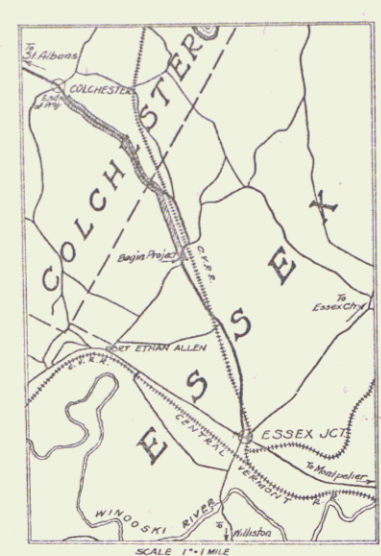

RECORD PLANS

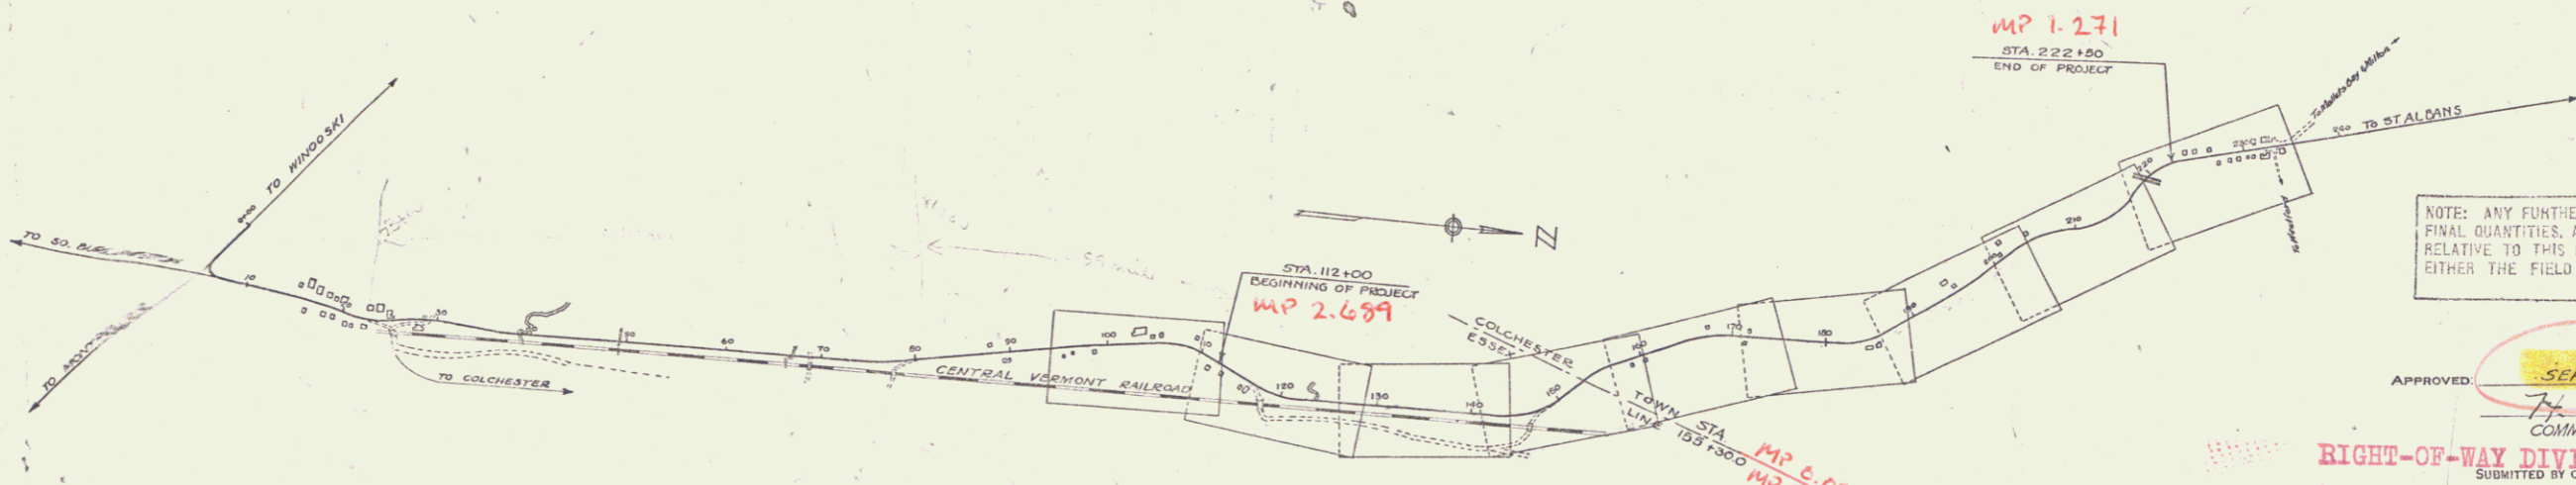

NOTE: ANY FURTHER INFORMATION CONCERNING FINAL QUANTITIES, AMOUNTS OR OTHERS RELATIVE TO THIS PROJECT MAY BE FOUND EITHER THE FIELD BOOKS OR THE SET FILE.

APPROVED: *H. E. ...*
 COMMISSIONER OF HIGHWAYS

RIGHT-OF-WAY DIVISION
 TOWN FILE

PERPETUAL

of VT 2A

(To Be Returned To R.O.W. Division)

CONVENTIONAL SIGNS

COUNT	VT 2A	GROUND ELEVATION	BATHY LINE
TOWN		GRADE ELEVATION	BATHY LINE
FENCE			

SCALES

TITLE	1" = 4000 FT.
PLAN	1" = 200 FT.
PROF.	1" = 20 FT.

CURVE DATA

DEFLECTION ANGLE	Δ
DEGREE OF CURVE	D
RADIUS OF CURVE	R
TANGENT DISTANCE	T
LENGTH OF CURVE	L
EXTERNAL DISTANCE	E
POINT OF INTERSECTION	P. I.
POINT OF CURVE	P. C.
POINT OF TANGENT	P. T.
POINT ON TANGENT	P. O. T.

CORRECT: _____
 ROAD ENGINEER

SERIES PLAN NO. 155 F.I. (1933)
 SHEET 1 OF 39

DIST. # 5 PLANS