

INDEX OF SHEETS

SHEET NO.	TITLE PAGE
2	TYPICAL CROSS-SECTION OF IMPROVEMENT GRADING-BASE AND DRAINAGE
3	BANKING & WIDENING TABLES
4-12	PLAN & PROFILE SHEETS
13	STANDARD STRUCTURE SHEET 5 22 PIPE CULVERTS
14	DOCK CULVERTS
15	UNDERPASS BOX CULVERTS
16	50 BARRICADES-SIGNS & LIGHTS
17-39	CROSS SECTIONS

STANDARD STRUCTURE SHEETS 5 28-529 APPROVED BY THE CHIEF ENGINEER ON JULY 13, 1933
 STANDARD STRUCTURE SHEET 530 APPROVED BY THE CHIEF ENGINEER ON AUGUST 15, 1933.

**STATE OF VERMONT
 STATE HIGHWAY DEPARTMENT**

**PLAN AND PROFILE OF PROPOSED
 STATE HIGHWAY**

NATIONAL RECOVERY SECONDARY PROJECT

TOWNS OF ESSEX & COLCHESTER


ESSEX JCT.-COLCHESTER ROAD
 FROM A POINT 100 FT. SOUTH OF THE RESIDENCE OF EUGENE PARISEAU NORTHERLY 2.091 MI. TO A POINT 200 FT. SOUTH OF THE RESIDENCE OF HENRY CROSS.

LENGTH OF PROJECT-11,040.9 FT.
 = 2.091 MILES


Pin # 99R727

Route: VT. 2A

Project: NRS 165

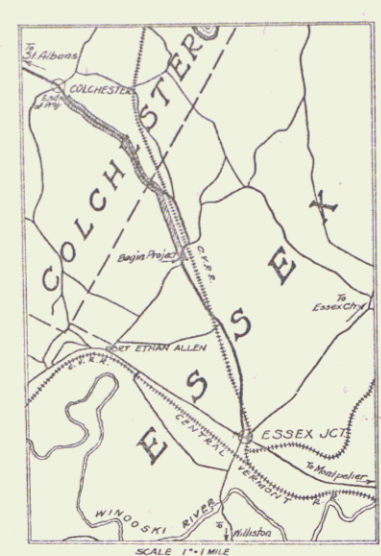

RECORD PLANS

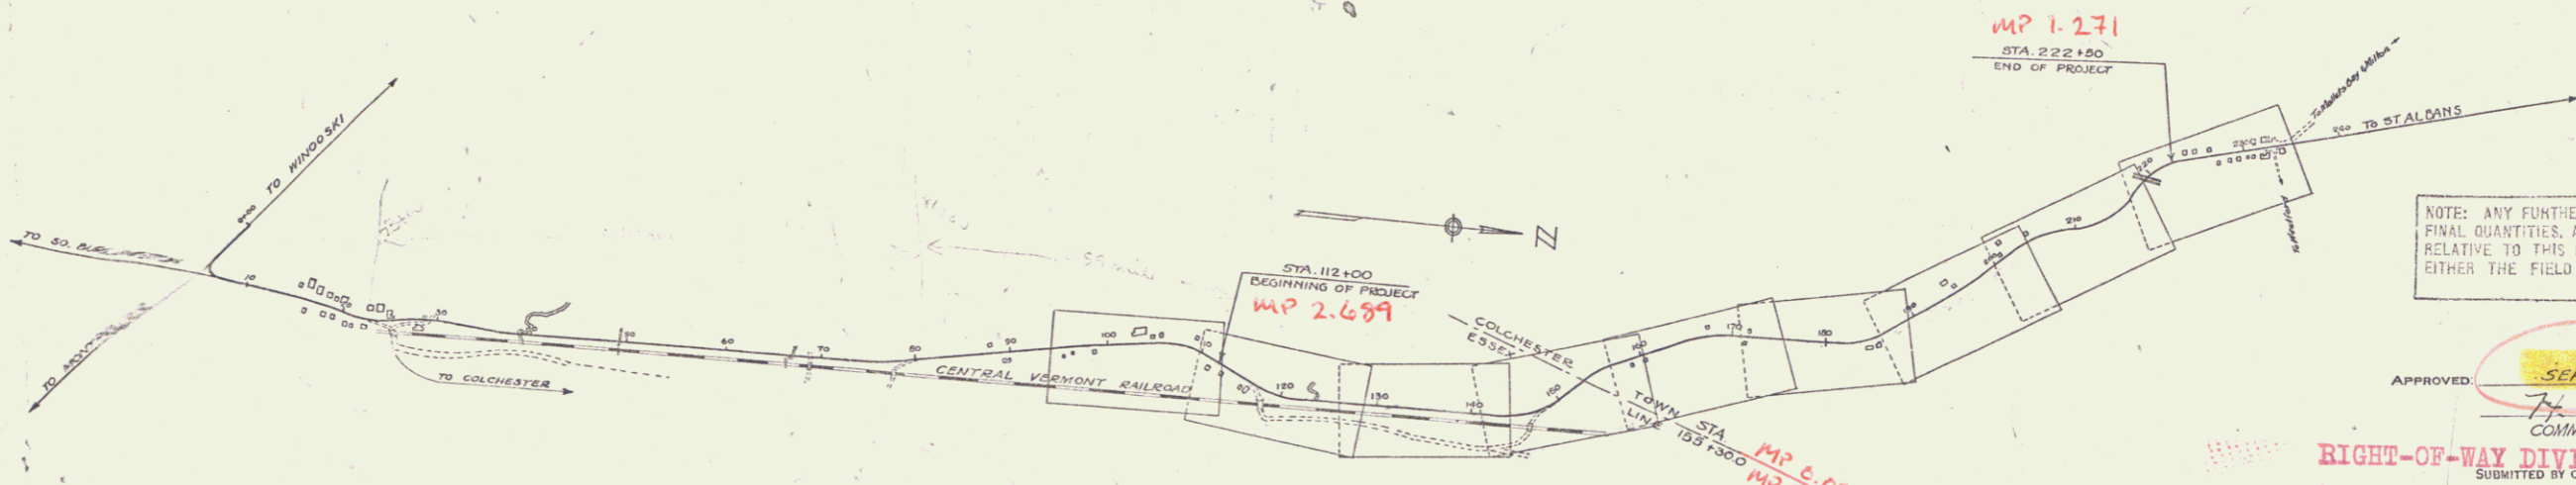

NOTE: ANY FURTHER INFORMATION CONCERNING FINAL QUANTITIES, AMOUNTS OR OTHERS RELATIVE TO THIS PROJECT MAY BE FOUND EITHER THE FIELD BOOKS OR THE SET FILE.


APPROVED: *[Signature]*
 COMMISSIONER OF HIGHWAYS

RIGHT-OF-WAY DIVISION
 TOWN FILE

PERPETUAL

of VT 2A

(To Be Returned To R.O.W. Division)

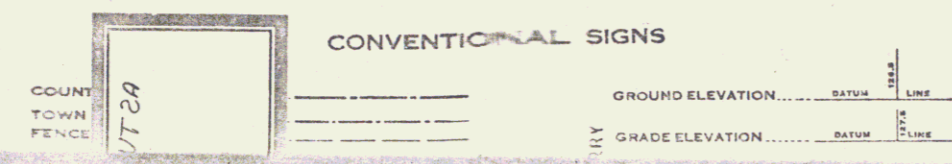

SCALES

TITLE	1" = 4000 FT.
PLAN	1" = 200 FT.
PROF.	1" = 20 FT.



CURVE DATA

DEFLECTION ANGLE	Δ
DEGREE OF CURVE	D
RADIUS OF CURVE	R
TANGENT DISTANCE	T
LENGTH OF CURVE	L
EXTERNAL DISTANCE	E
POINT OF INTERSECTION	P. I.
POINT OF CURVE	P. C.
POINT OF TANGENT	P. T.
POINT ON TANGENT	P. O. T.

CORRECT: _____
 ROAD ENGINEER

SERIES PLAN NO. 155 F.I. (1933)
 SHEET 1 OF 39



DIST. # 5 PLANS

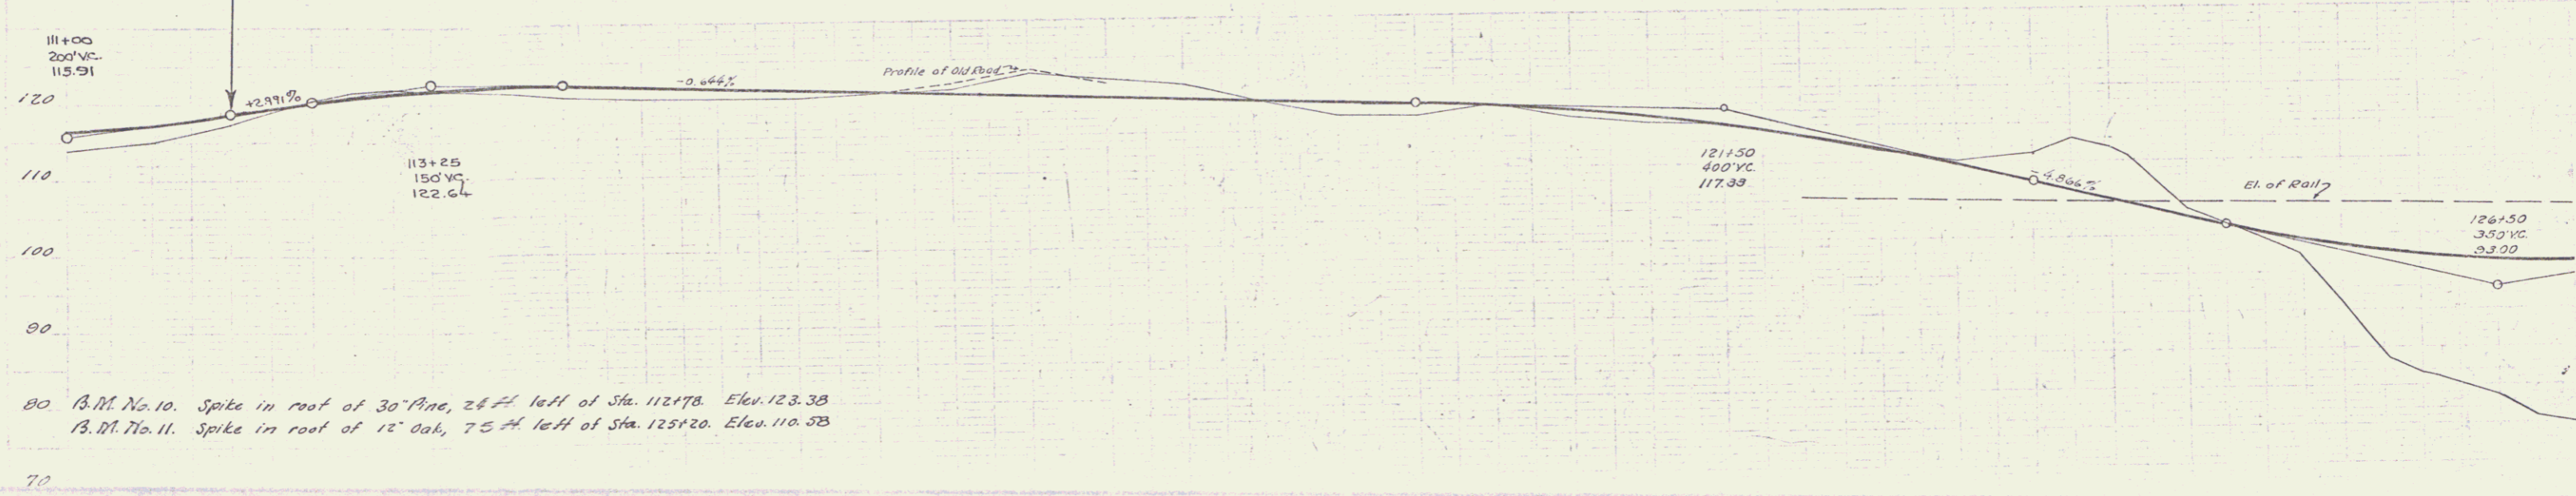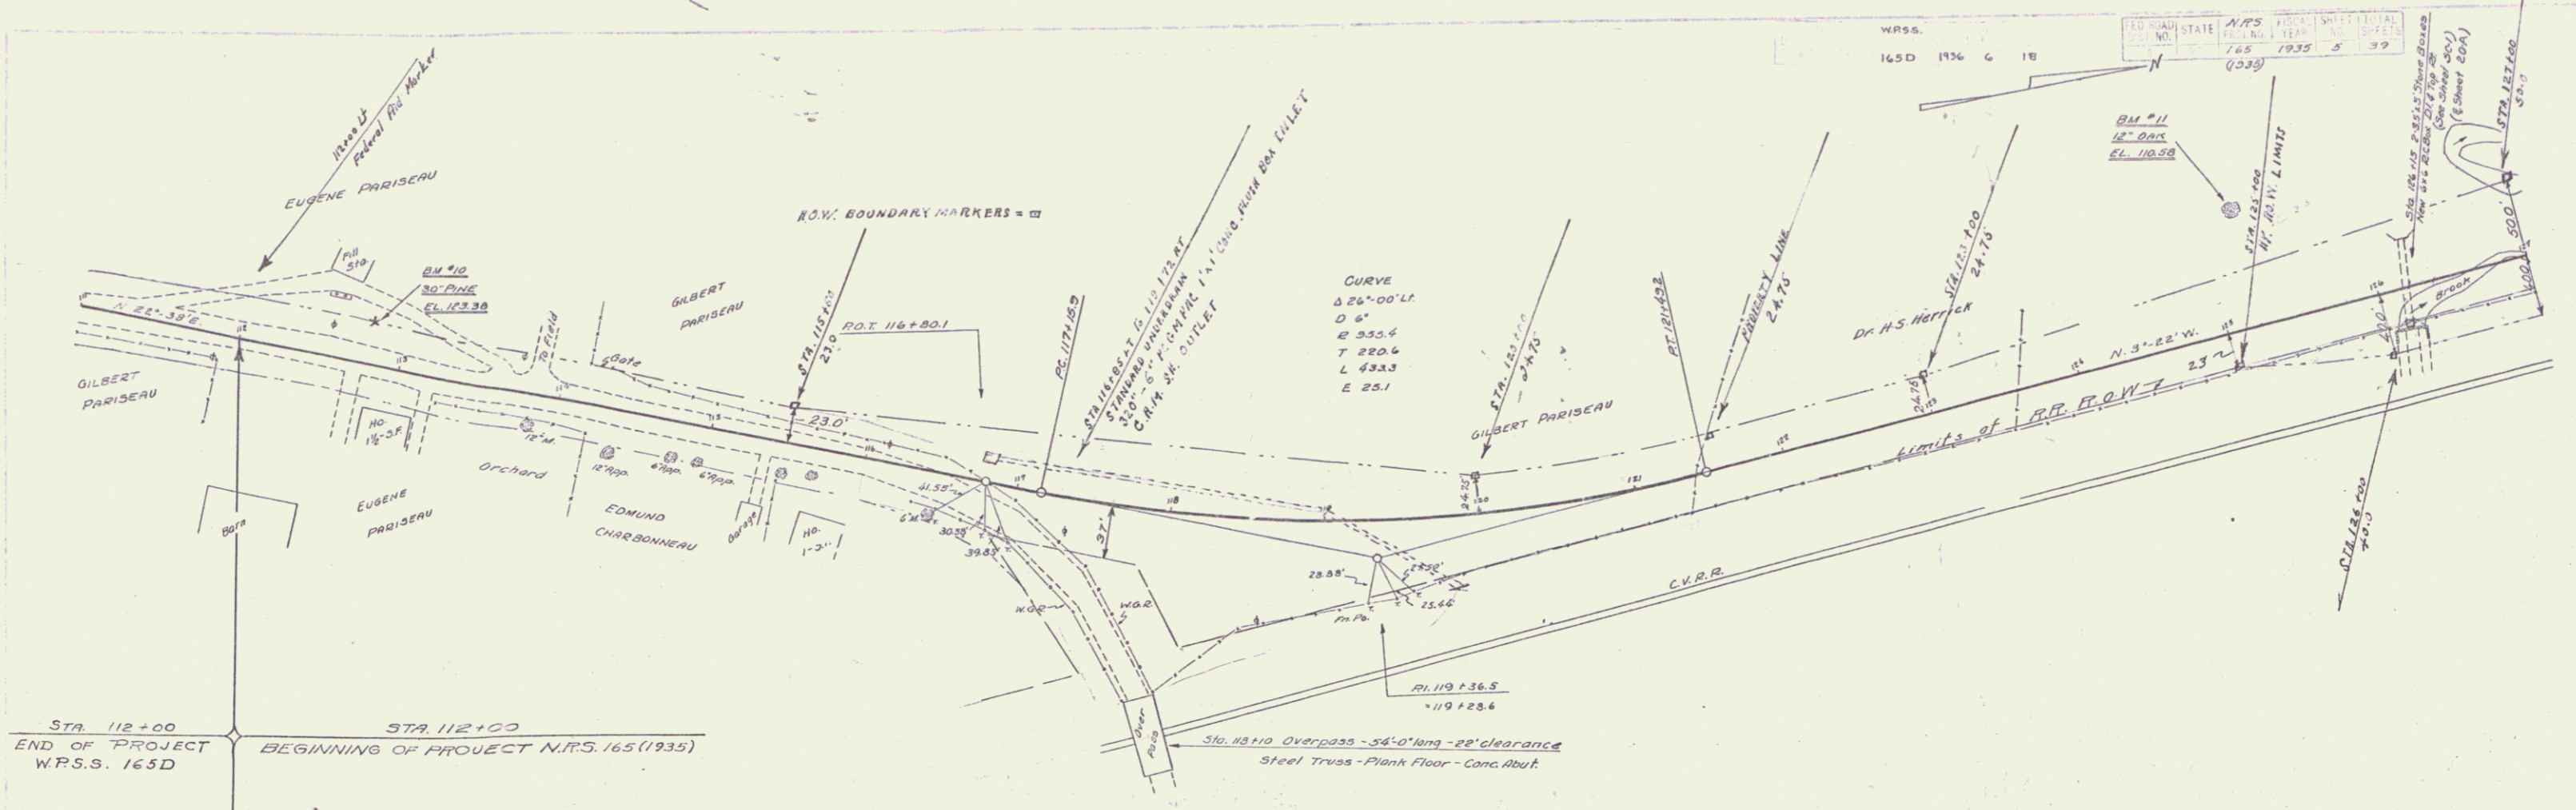

B.M. No. 10. Spike in roof of 30" Pine, 28 ft left of Sta. 112+78. Elev. 123.38
 B.M. No. 11. Spike in roof of 12" Oak, 75 ft left of Sta. 125+20. Elev. 110.58

Station	Elevation
112+00	115.91
112+25	122.64
112+50	118.50
112+75	117.50
113+00	117.50
113+25	117.50
113+50	117.50
114+00	117.50
114+25	117.50
114+50	117.50
115+00	117.50


WRSS. 165D 1936 6 18
 A.P.S. 1935 5 39
 SHEET NO. 6 OF 18

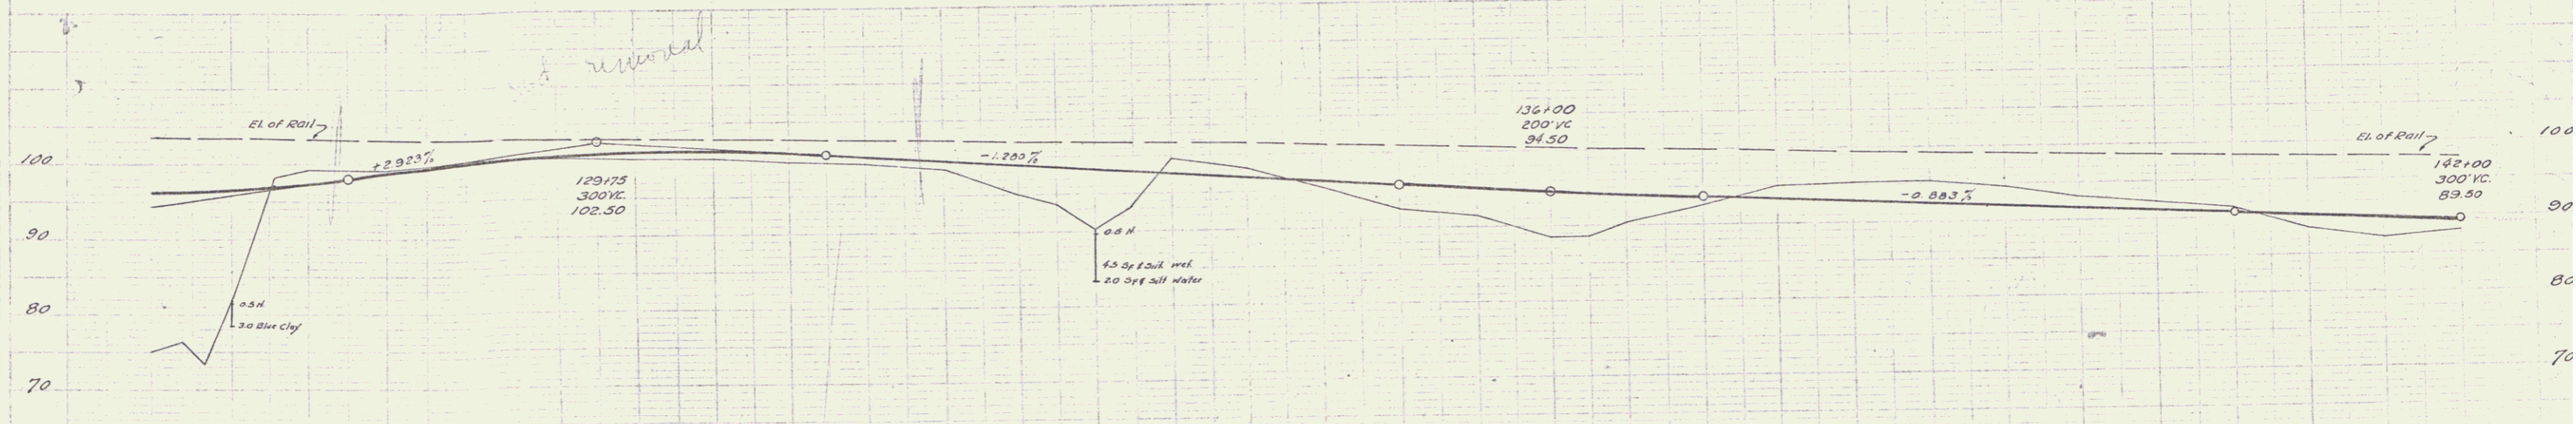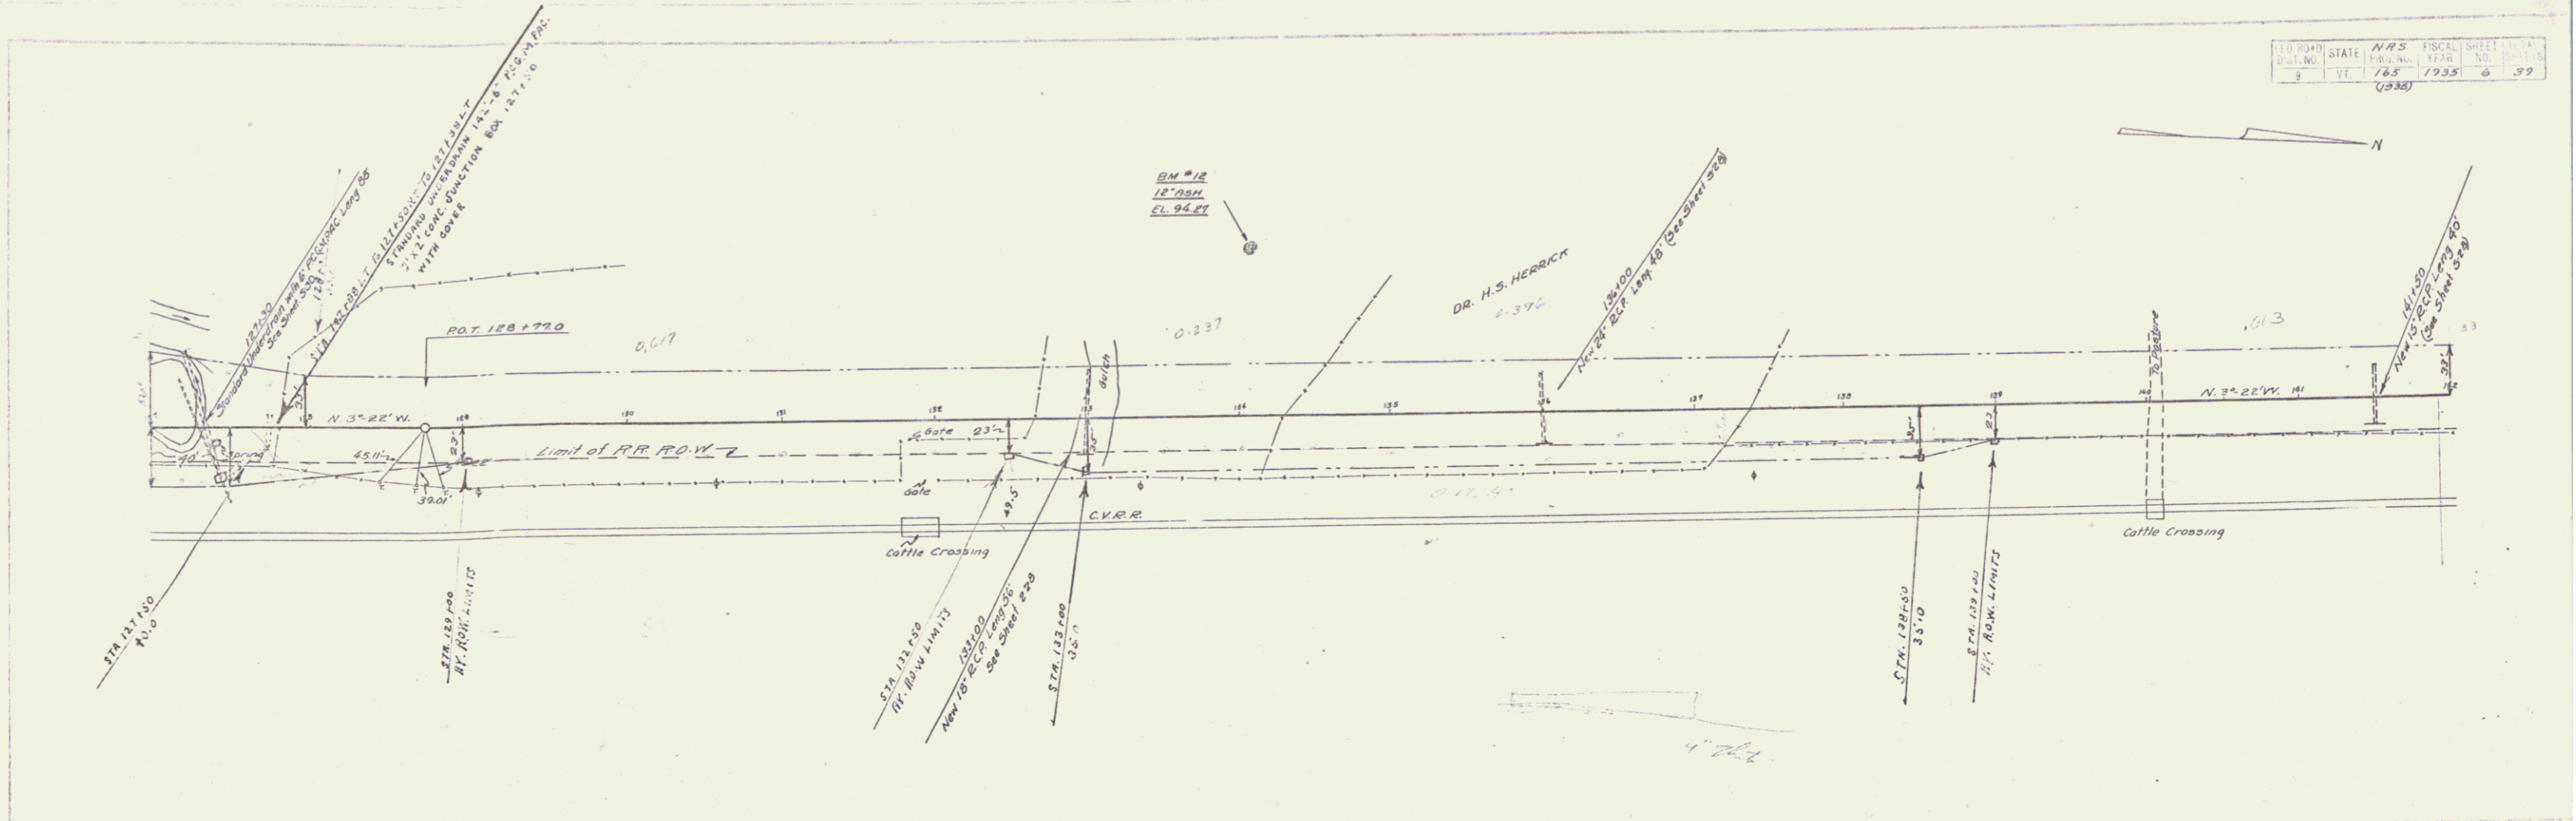

B.M. No. 12. Spike in roof of 12" Ast. 110 ft. left of Sta. 136+116. Elev 94.27



127	128	129	130	131	132	133	134	135	136	137	138	139	140	141	142
94.20	94.25	94.30	94.35	94.40	94.45	94.50	94.55	94.60	94.65	94.70	94.75	94.80	94.85	94.90	94.95
100.00	100.00	100.00	100.00	100.00	100.00	100.00	100.00	100.00	100.00	100.00	100.00	100.00	100.00	100.00	100.00

SERIES 123 NO 165 (1935)
 SHEET 6 OF 39

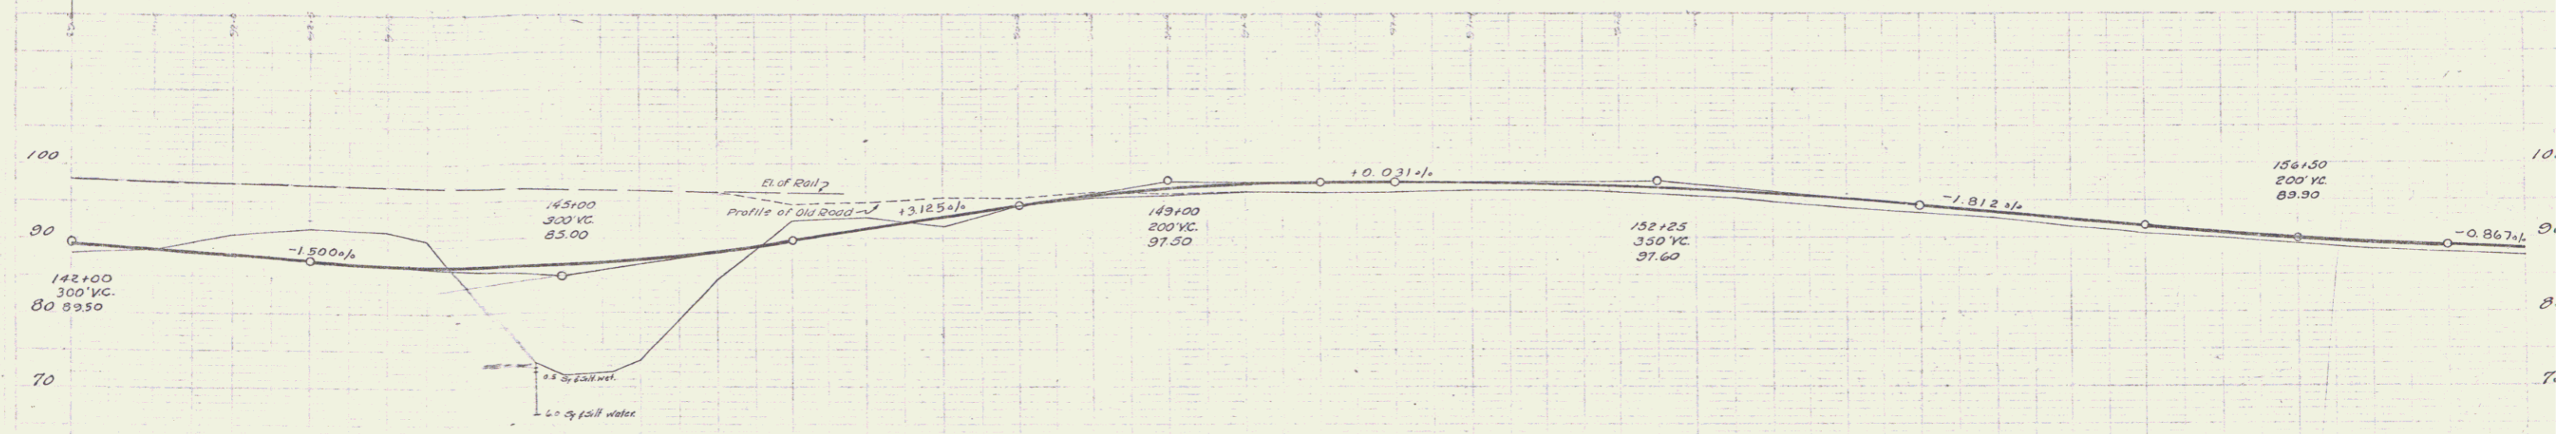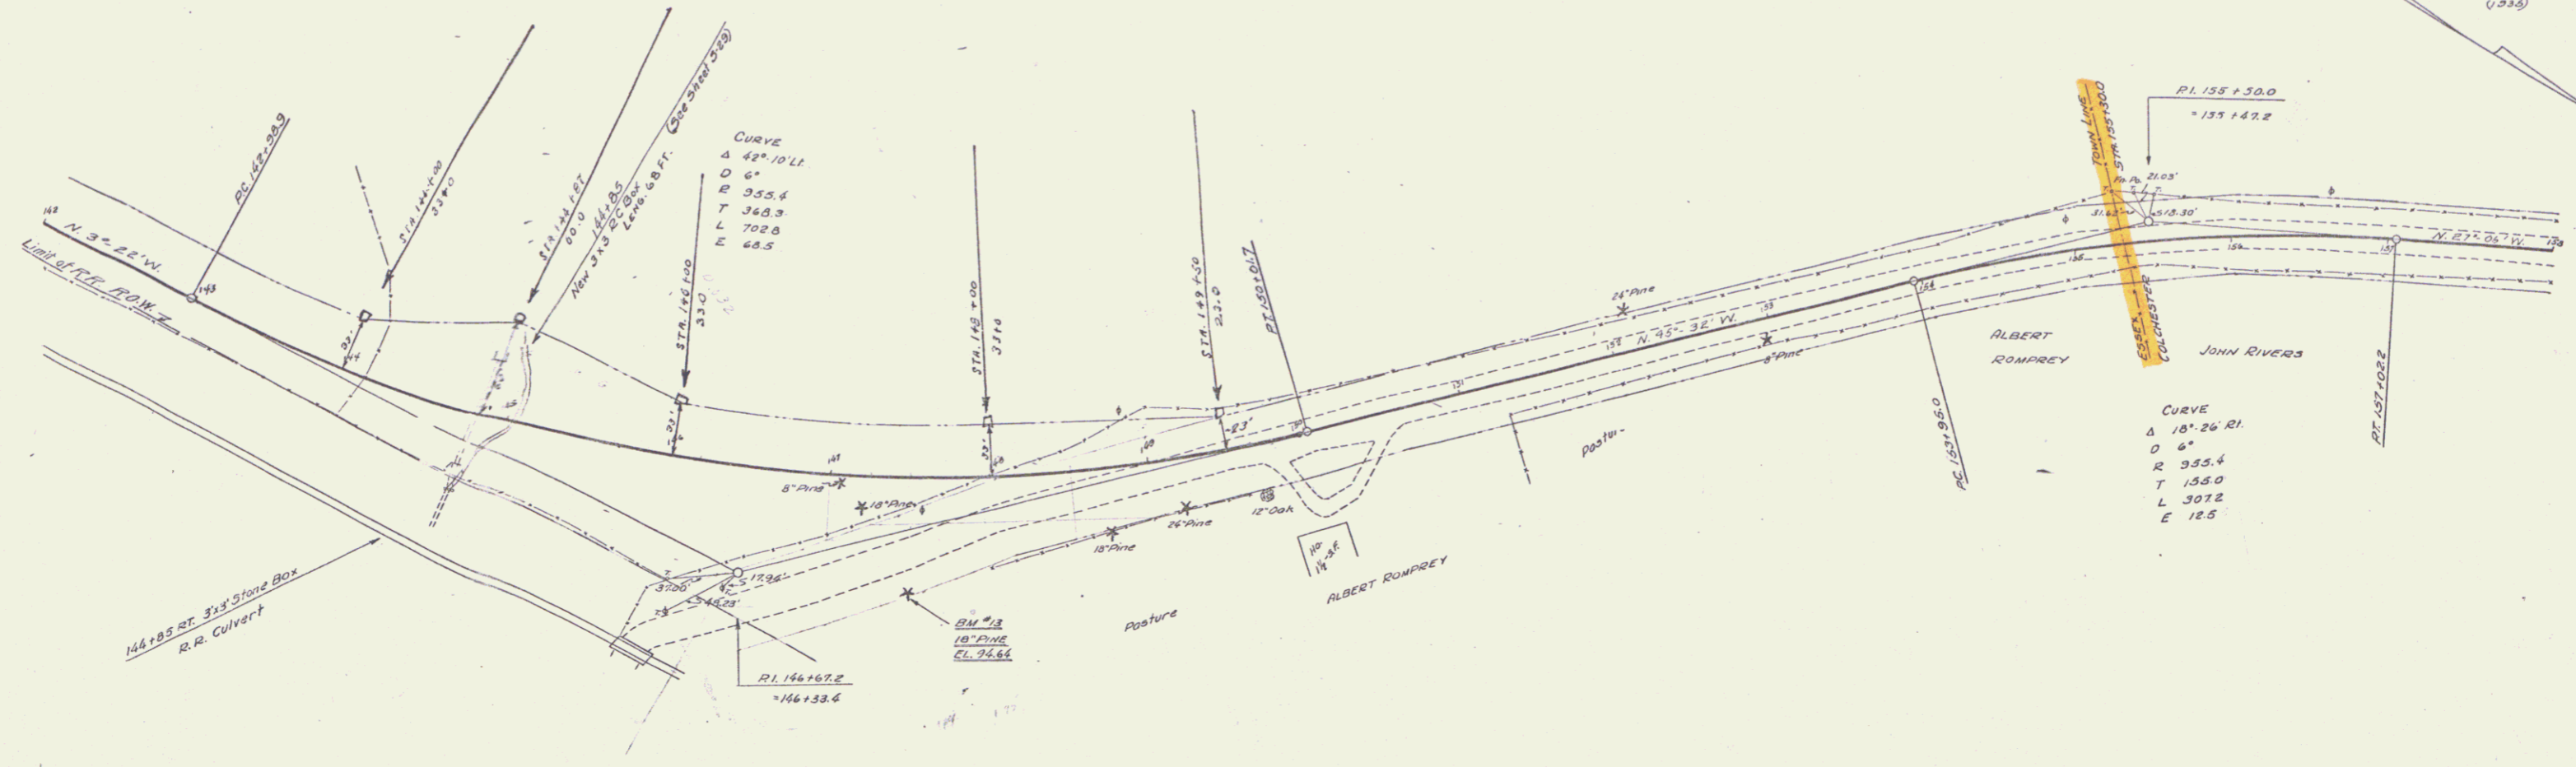



B.M. 76.13. Spike in roof of 18" Pine 75' right of Sta. 147+50. Elev. 94.64

88.0	88.25	88.5	100.0										
142	143	144	200

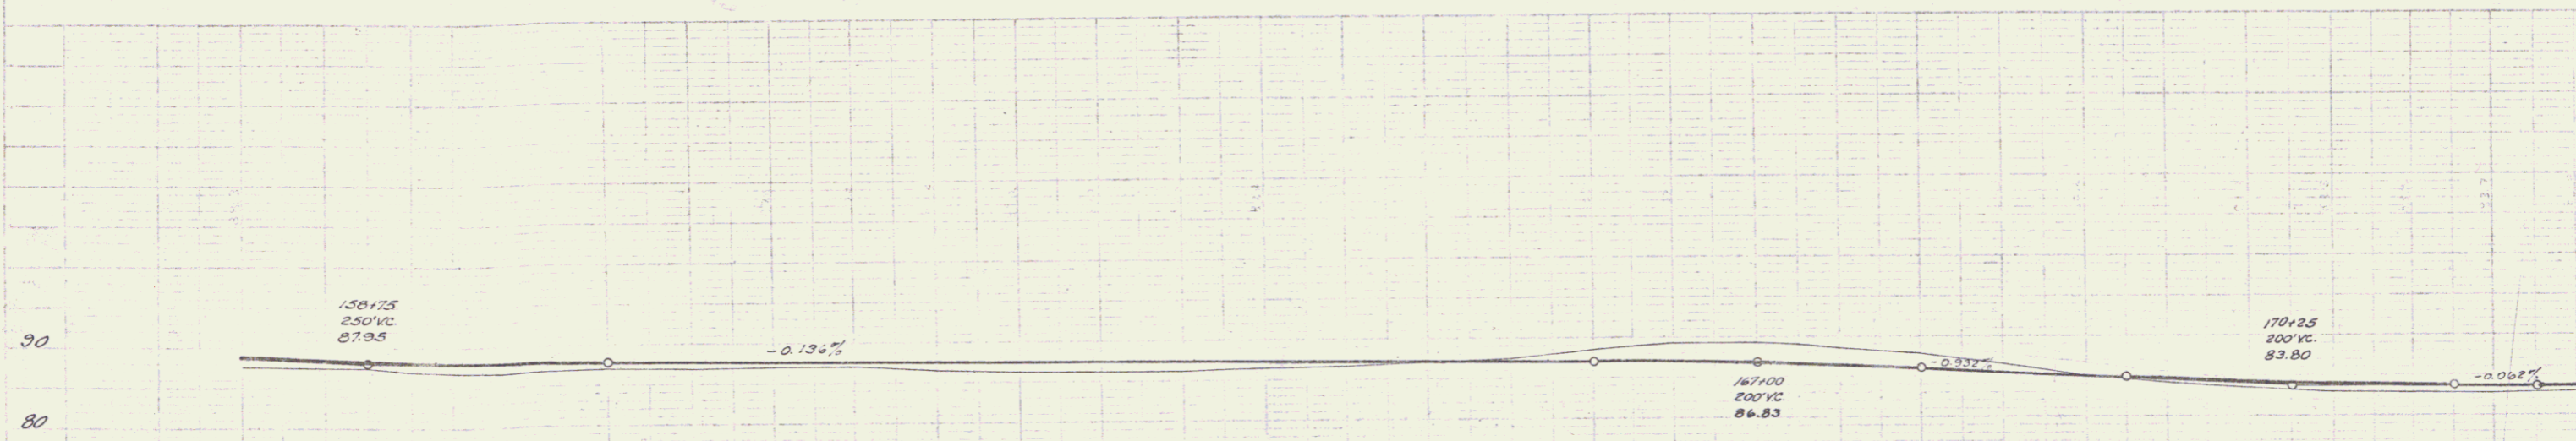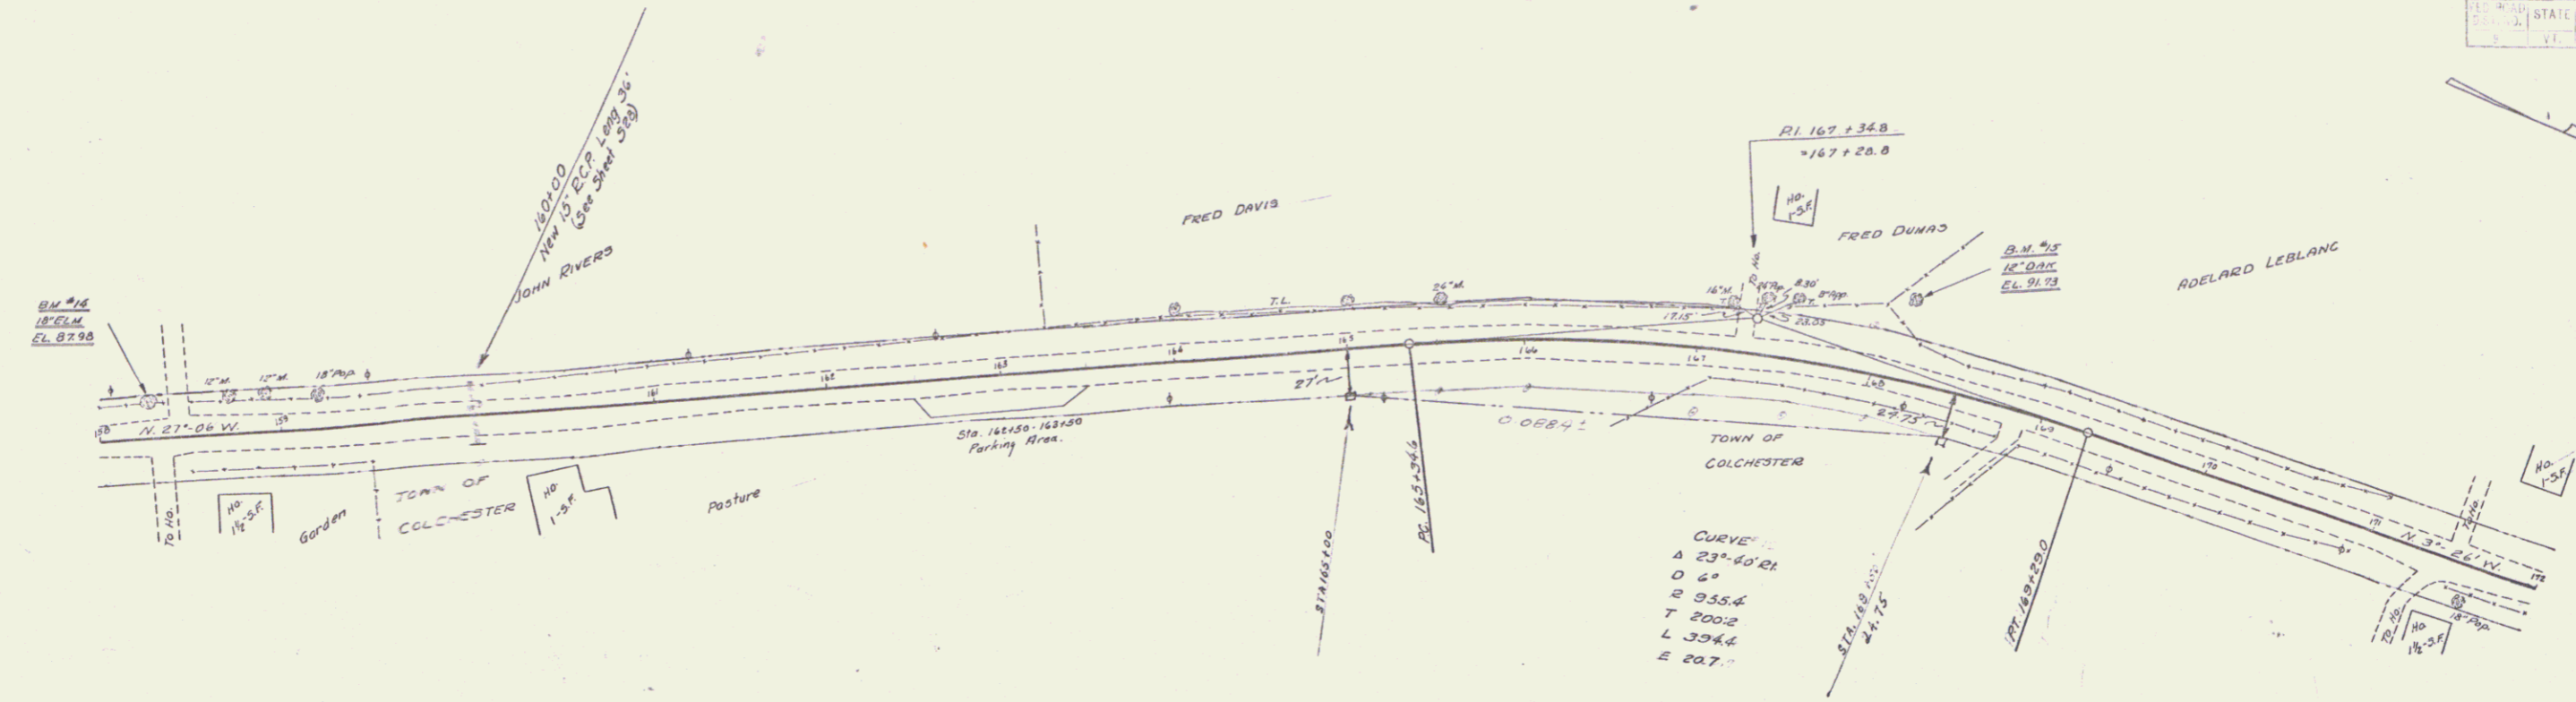


A.M. N. 16 Spike in cut 8' Elm. 18 ft. left of Sta. 158+25. Elev. 87.98


87.6	87.5	87.3	87.0	86.9	86.8	0.0
------	------	-----	-----	
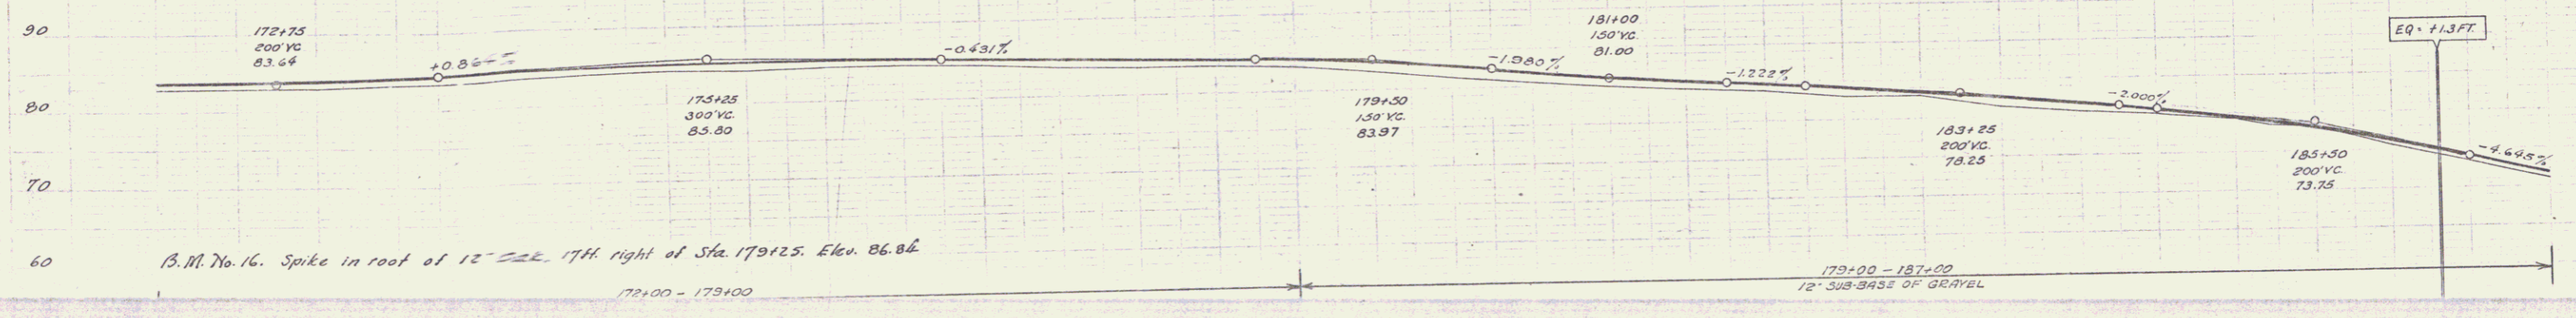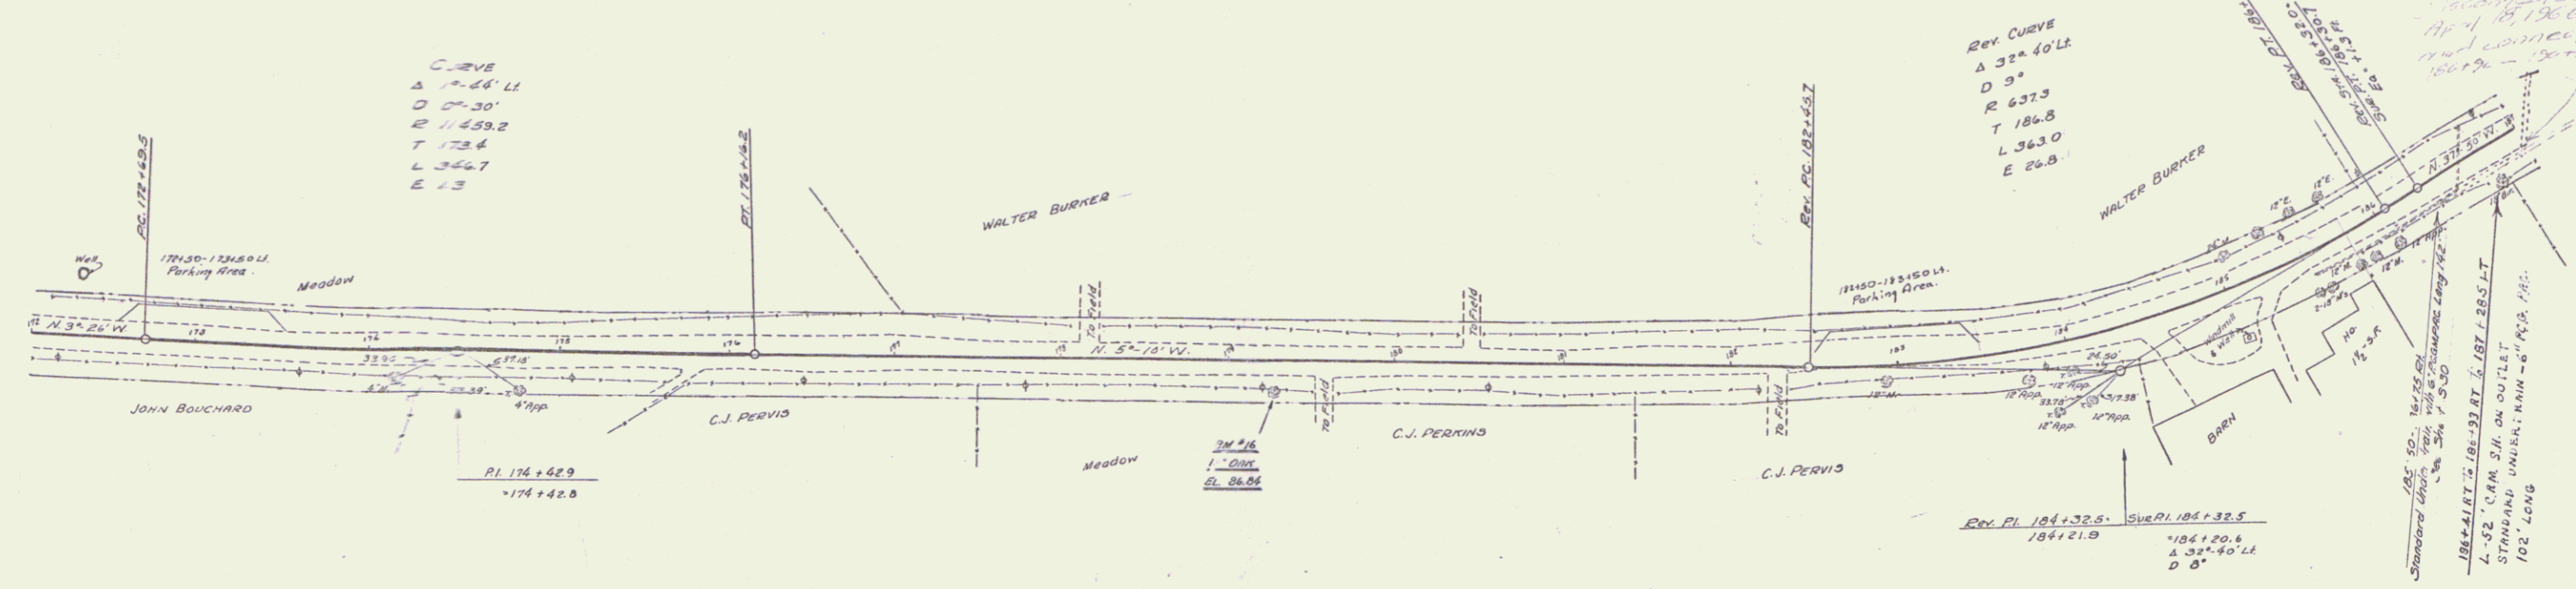

211	210	209	0
-----	-----	----	----	---	---	---	---	---	---	---	---	---	---

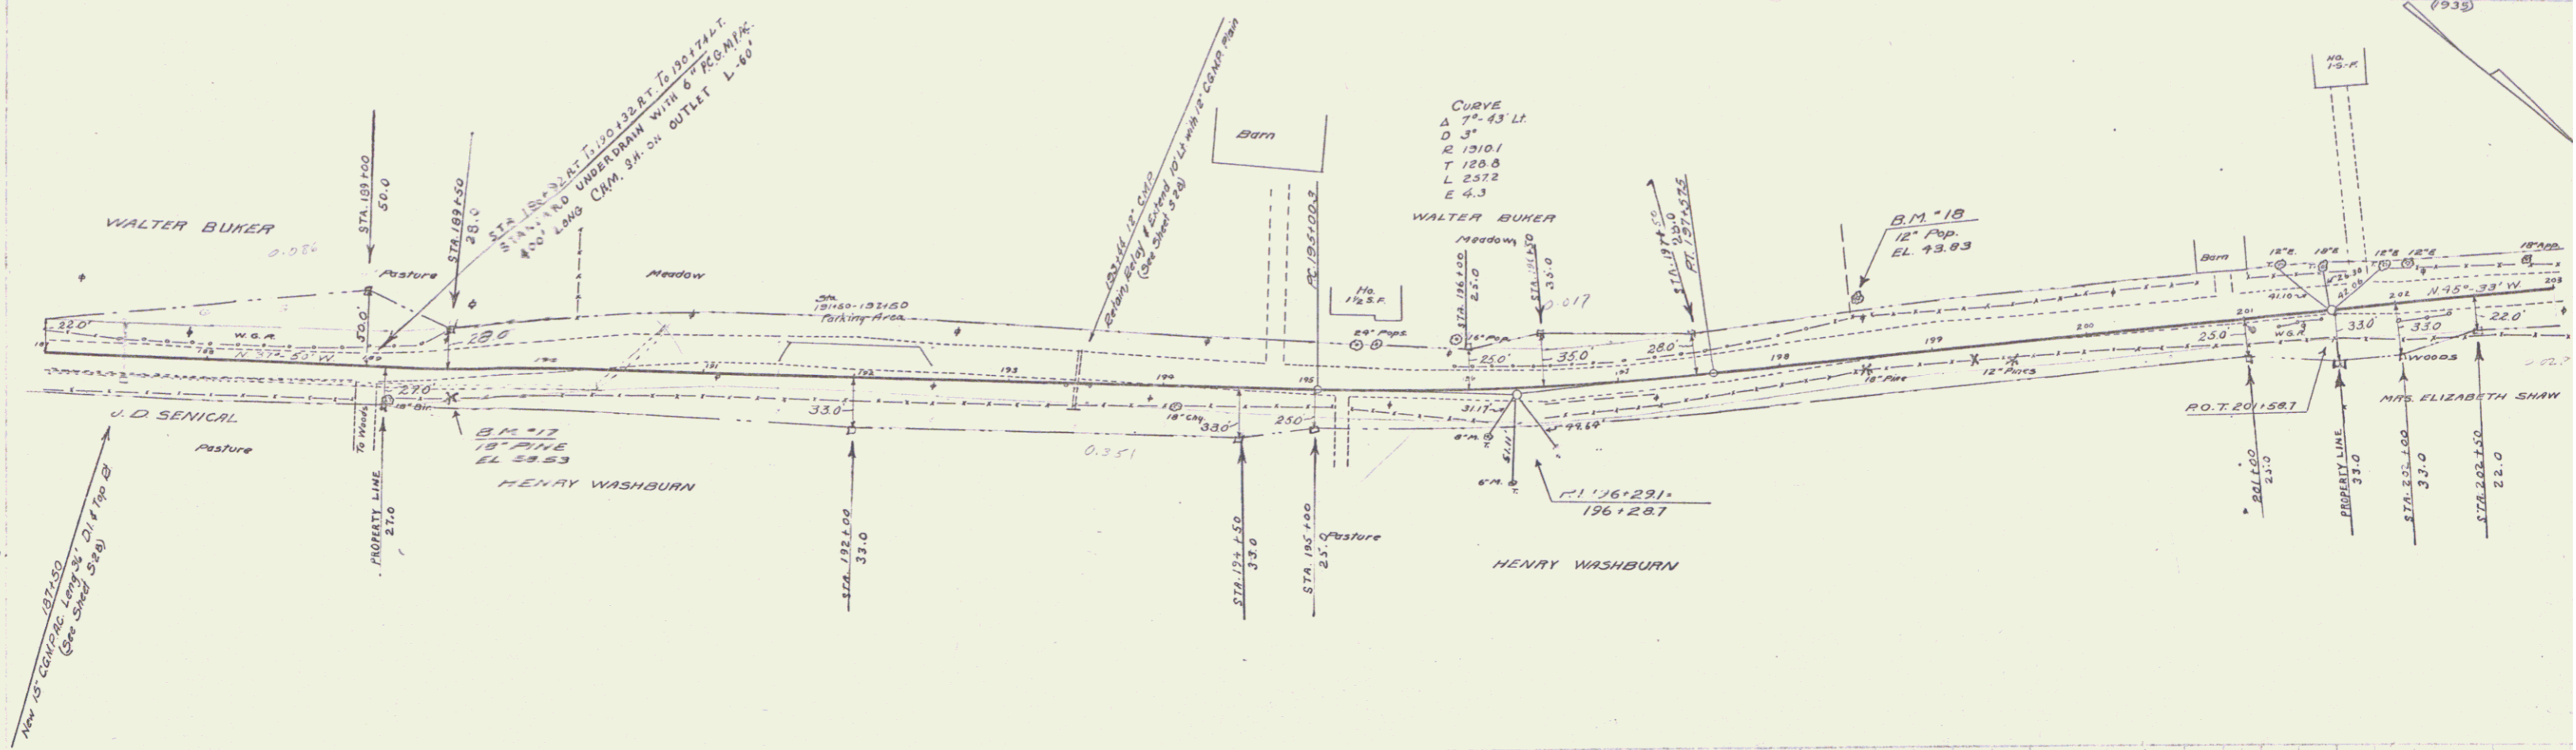

Proposed
 Highway
 1933

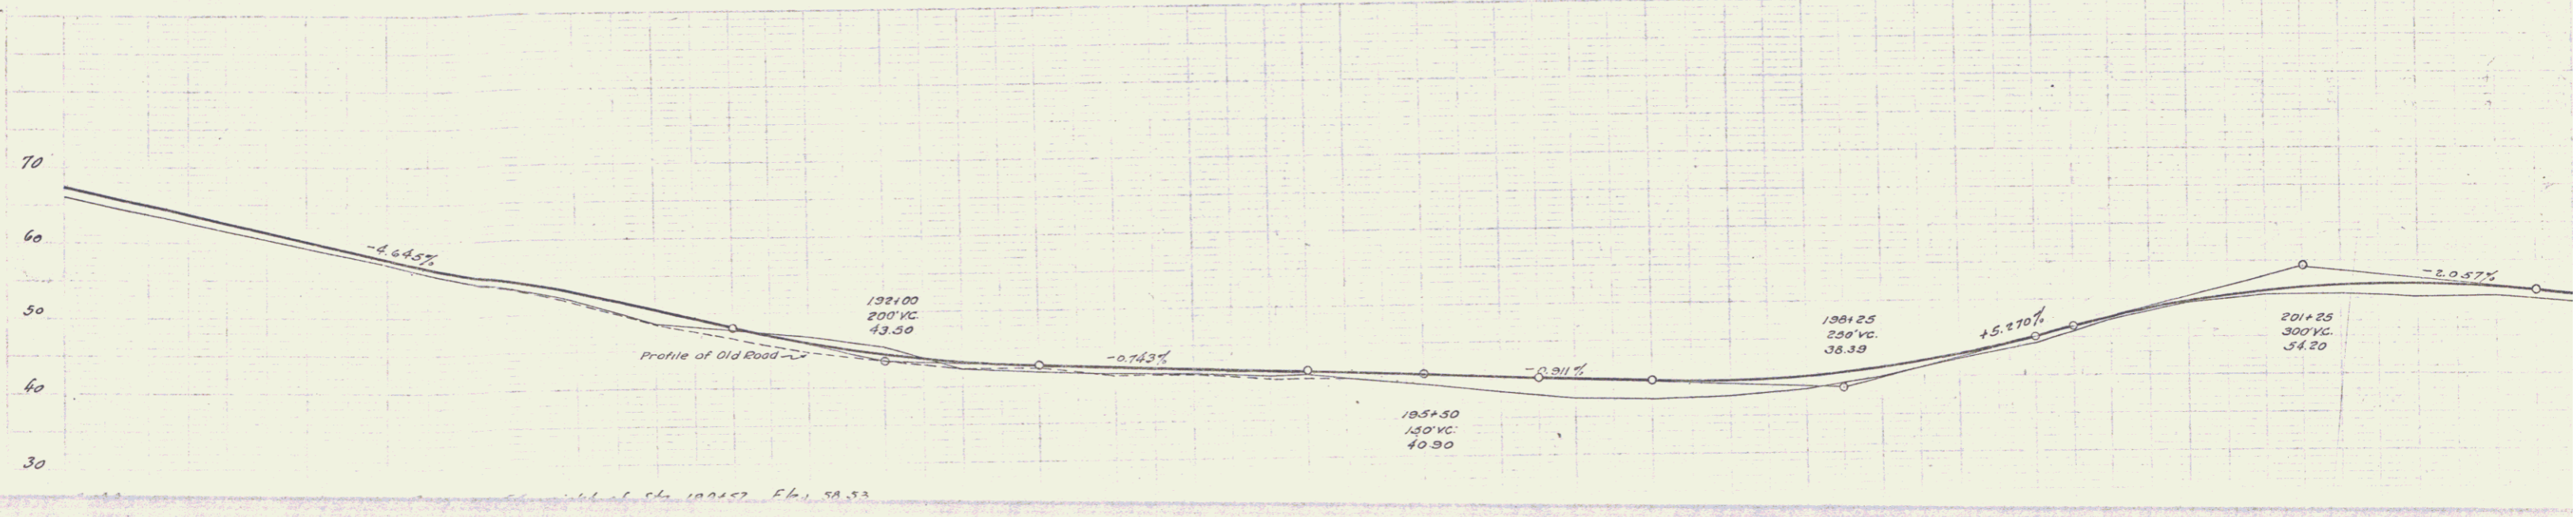

187	188	189	190	191	192	193	194	195	196	197	198	199	200	201	202
46.1 46.72	47.8 48.46	49.5 50.18	51.2 51.82	52.9 53.44	54.6 55.18	56.3 56.84	58.0 58.54	59.7 60.24	61.4 61.98	63.1 63.64	64.8 65.38	66.5 67.12	68.2 68.76	69.9 70.44	71.6 72.18

