


INDEX OF SHEETS

SHEET NO	TITLE PAGE
1	TITLE PAGE
2	WEIGHING STATION AND APPROACHES
3	PLAN AND PROFILE
4	CROSS SECTION
5	WEIGHING STATION LAYOUT
6	FOUNDATION DETAILS
7	SCALE HOUSE DETAILS
8	REINFORCING SCHEDULE
9	AXLE LOAD SCALE 10'X12' PLATFORM
10	MOTOR TRUCK SCALE 24'X12' PLATFORM
11	MOTOR TRUCK SCALES
12	MOTOR TRUCK SCALE
13	MOTOR TRUCK SCALE
14	E-1 (BARRICADES, SIGNS AND LIGHTS)


STATE OF VERMONT
DEPARTMENT OF HIGHWAYS
PROPOSED IMPROVEMENT
TOWN OF FAIR HAVEN
COUNTY OF RUTLAND
VT ROUTE 4A
WHITEHALL, N.Y.- RUTLAND, VT. ROAD
WEIGHING STATION

FED. ROAD DISTRICT	STATE	PROJECT NO.	FISCAL YEAR	SHEET NO.	TOTAL SHEETS
1	VT	ST 20-M	1962	1	13

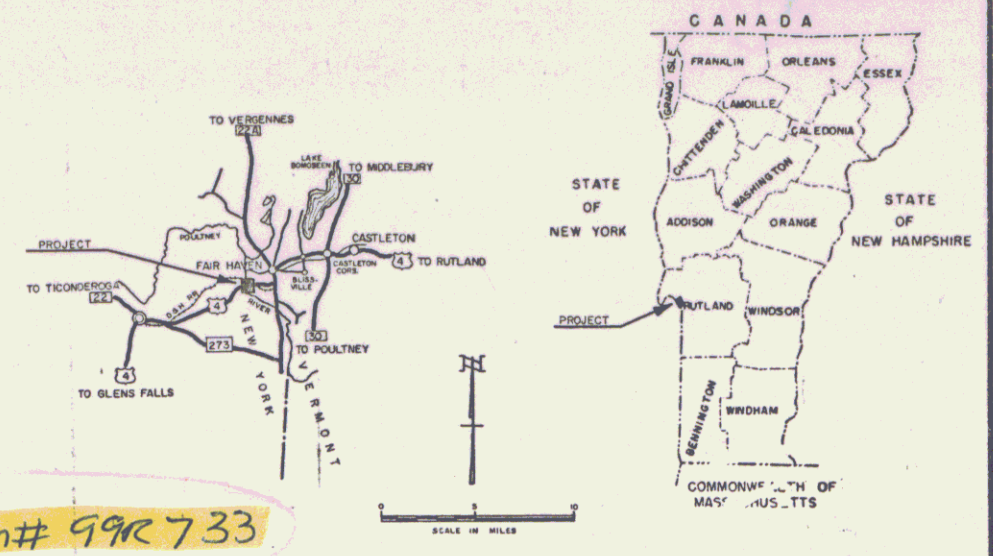

PROJECT NAME & NUMBER	TYPE
FAIR HAVEN ST 20-M	STAGE 1 WEIGHING STATION STAGE 3 WELL PUMP
RECORD PLANS	
MATERIALS	
GRAVEL - CASTLETON TOWN PIT - CASTLETON, VT. ACCGMETAL PIPE - NORTHEASTERN CULVERT CO. - WESTMINSTER, VT. BITUMINOUS CONCRETE & TAR EMULSION - L.M. PIKE & SON INC. - LACONIA, N.H. CONCRETE CLASS 'B' - JOSEPH P. CARRARA - RUTLAND, VT. STEEL - JOSEPH T. RYERSON & SON INC. - BOSTON, MASS. WELL CASING - NORMAN SPAFFORD & SONS - CASTLETON, VT. PLUMBING - JOHN E. GEROW & SONS - MIDDLEBURY, VT. PAINTING - BROSSAU BROTHERS - MIDDLEBURY, VT. ROOFING - VERMONT ROOFING CO. - RUTLAND, VT. STAGE 3 PUMP - TWIN STATE WELL CO. - BETHEL, VT. CONTRACTOR - W.H. DELONG INC., MIDDLEBURY, VT. CONTRACT DATED - JULY 24, 1962. RES. ENG. - W.V. KALLIO, MIDDLEBURY, VT. STARTED - AUGUST 2, 1962. RECORD PLANS - A.G. SPIDLE. COMPLETED - NOV. 23, 1962. ACCEPTED - NOV. 23, 1962.	

WEIGHING STATION APPROXIMATELY
1412 FEET, EAST OF THE N.Y.-VT.
STATE LINE, ON U.S. ROUTE 4

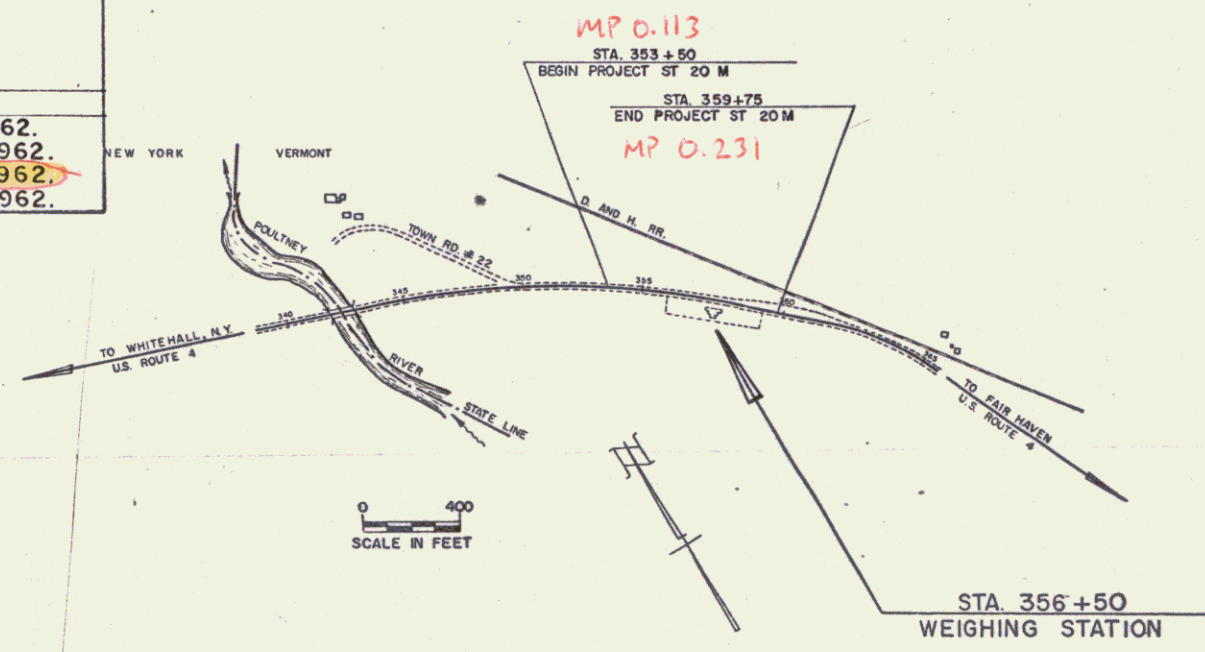

RIGHT-OF-WAY DIVISION
TOWN FILE
PERPETUAL
At Town of VT 4A
(To Be Returned To R.O.W. Division)

CO	TO	FE	UN	GU	TR	RA	RE	CE	SU	CU	DR	TR	PO	TE	TR	HE				
PROJECT	FAIR HAVEN	ST 20-M	TYPE	TRUCK WEIGHING STATION & APPROACHES	CONTRACTOR	W.H. DELONG INC.	LOCATION	WEIGHING STATION APPROXIMATELY 1,412 FEET, EAST OF THE N.Y.-VT. STATE LINE, ON U.S. ROUTE 4.	YEAR IN USE	1962	RECORD PLANS	A.G. SPIDLE	CONST. COMP.	NOV. 23, 1962	CONTRACTOR	W.H. DELONG INC.	LOCATION	WEIGHING STATION APPROXIMATELY 1,412 FEET, EAST OF THE N.Y.-VT. STATE LINE, ON U.S. ROUTE 4.	YEAR IN USE	1962

GROUND ELEVATION	DATUM	LINE
DATE	LINE	
GRADE ELEVATION	DATUM	LINE
DATE	LINE	
CURVE DATA		
DEFLECTION OF ANGLE	A
DEGREE OF CURVE	D
RADIUS OF CURVE	R
TANGENT DISTANCE	T
LENGTH OF CURVE	L
EXTERNAL DISTANCE	E
POINT OF INTERSECTION	P.I.
POINT OF CURVE	P.C.
POINT ON TANGENT	P.T.
POINT ON SUB-TANGENT	P.O.T.

SCALES

TITLE	1" = 10'
PLAN	1" = 10'
PROFILE	1" = 10'
CROSS-SECTIONS	1" = 10'

APPROVED	APPROVED	APPROVED	APPROVED	APPROVED	APPROVED
SECONDARY ENGINEER	CONSTRUCTION ENGINEER	BRIDGE ENGINEER	DISTRICT ENGINEER	HIGHWAY ENGINEER	CHIEF ENGINEER
DATE	DATE	DATE	DATE	DATE	DATE
	6/19/62		6/19/62	6/19/62	6/25/62

NOTE: ANY FURTHER INFORMATION CONCERNING FINAL QUANTITIES, AMOUNTS OR OTHER DETAILS RELATIVE TO THIS PROJECT MAY BE FOUND IN EITHER THE FIELD BOOKS OR THE ESTIMATE FILE.

DEPARTMENT OF COMMERCE BUREAU OF PUBLIC ROADS	
APPROVED	
DIVISION ENGINEER	DATE
PROJECT	ST NO. 20 M
SHEET	1 OF 13 SHEETS