

Guard Rail Required
 On Right 24'
 Sta. 3163.5 to Bridge 24'
 Bridge to Sta. 4163.5 24'



On Left 40'
 Sta. 352.5 to Bridge 40'
 Bridge to Sta. 4163.5 24'
 Total on Sheet 112'

Br 7

FOR SETBACKS AND TIES SEE SHEET
 9 11 63 24 3 19

E. F. Welch
 Engineer

E. F. Welch
 M. S. Peterson
 Assoc.

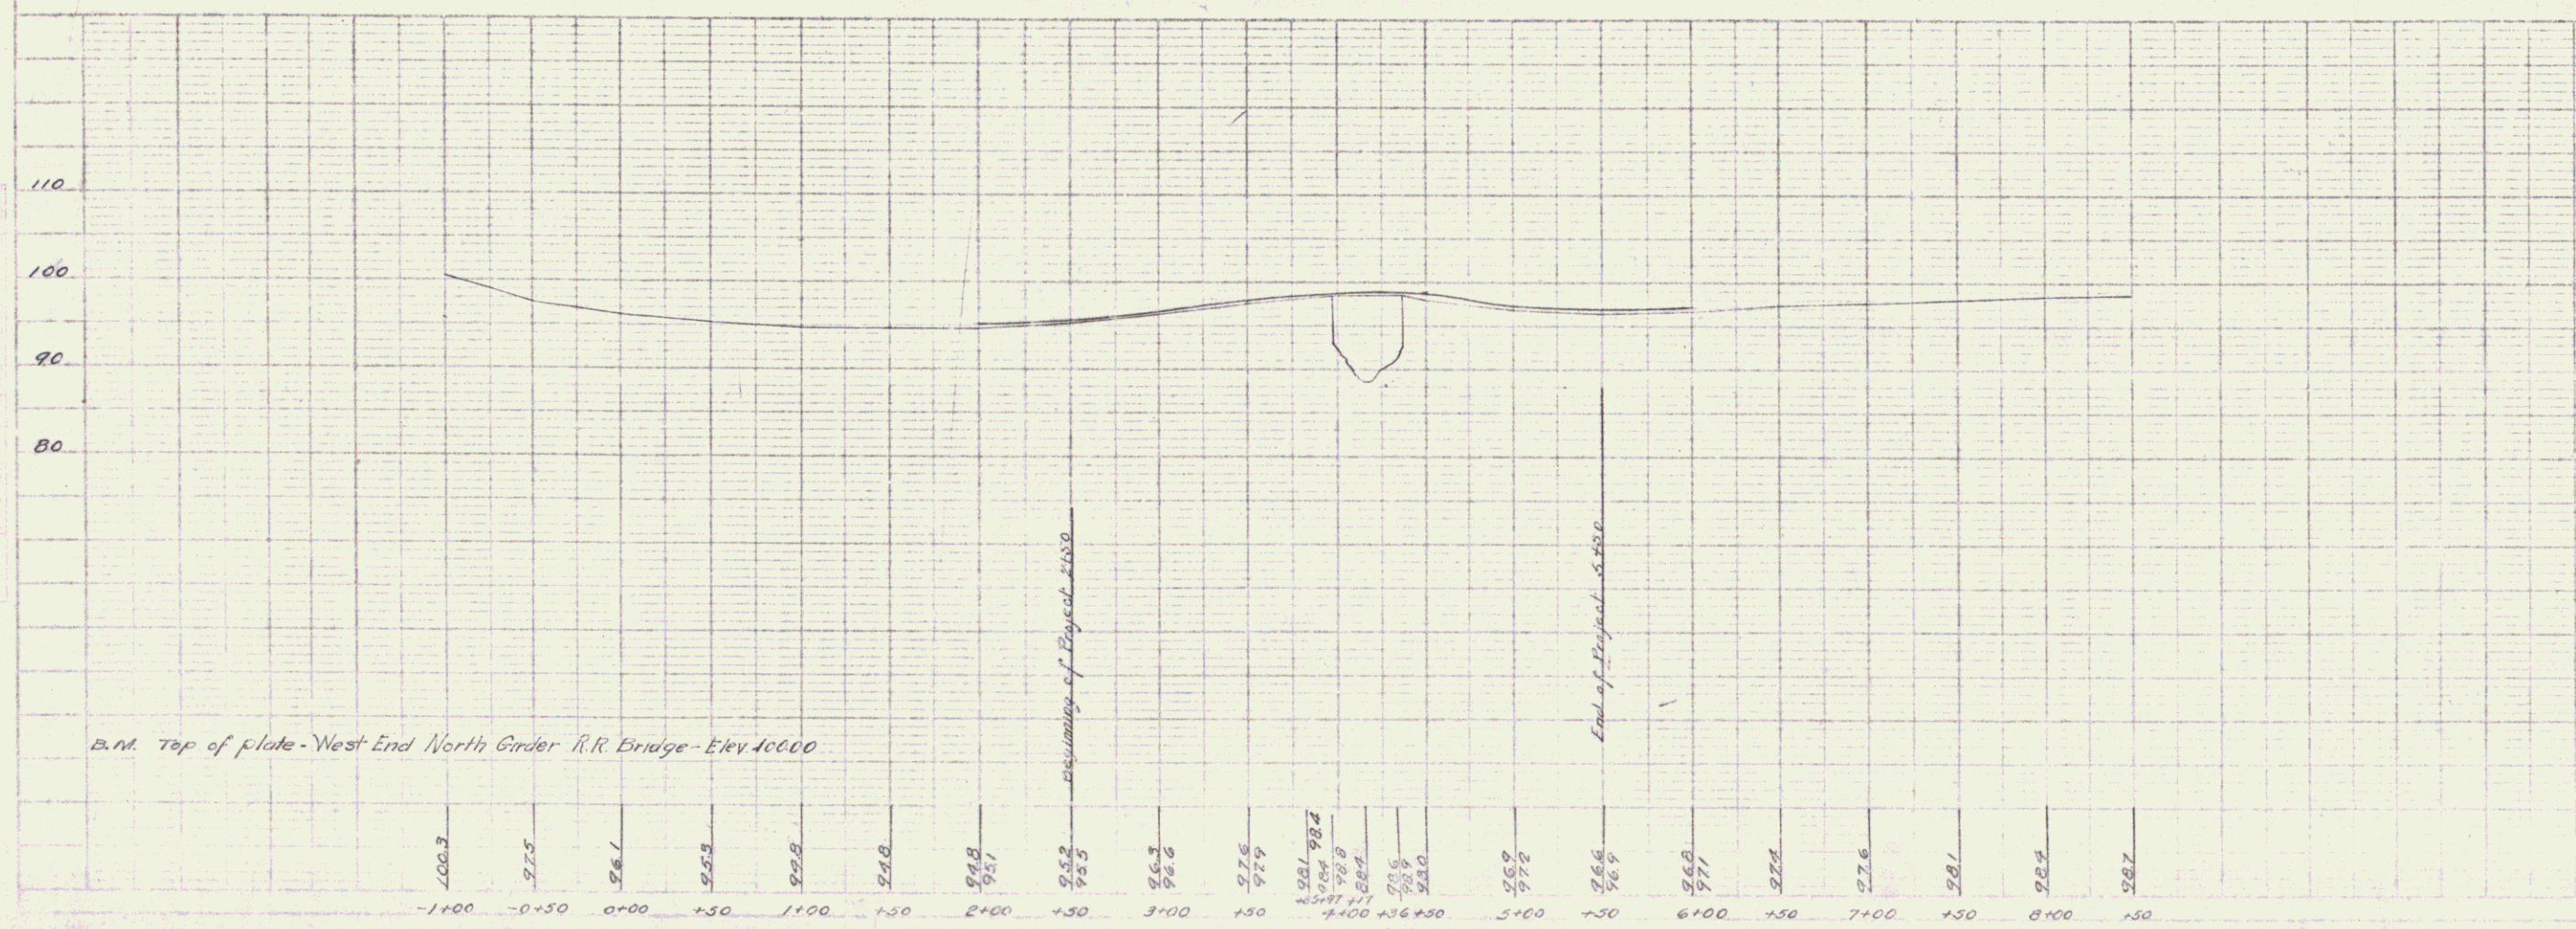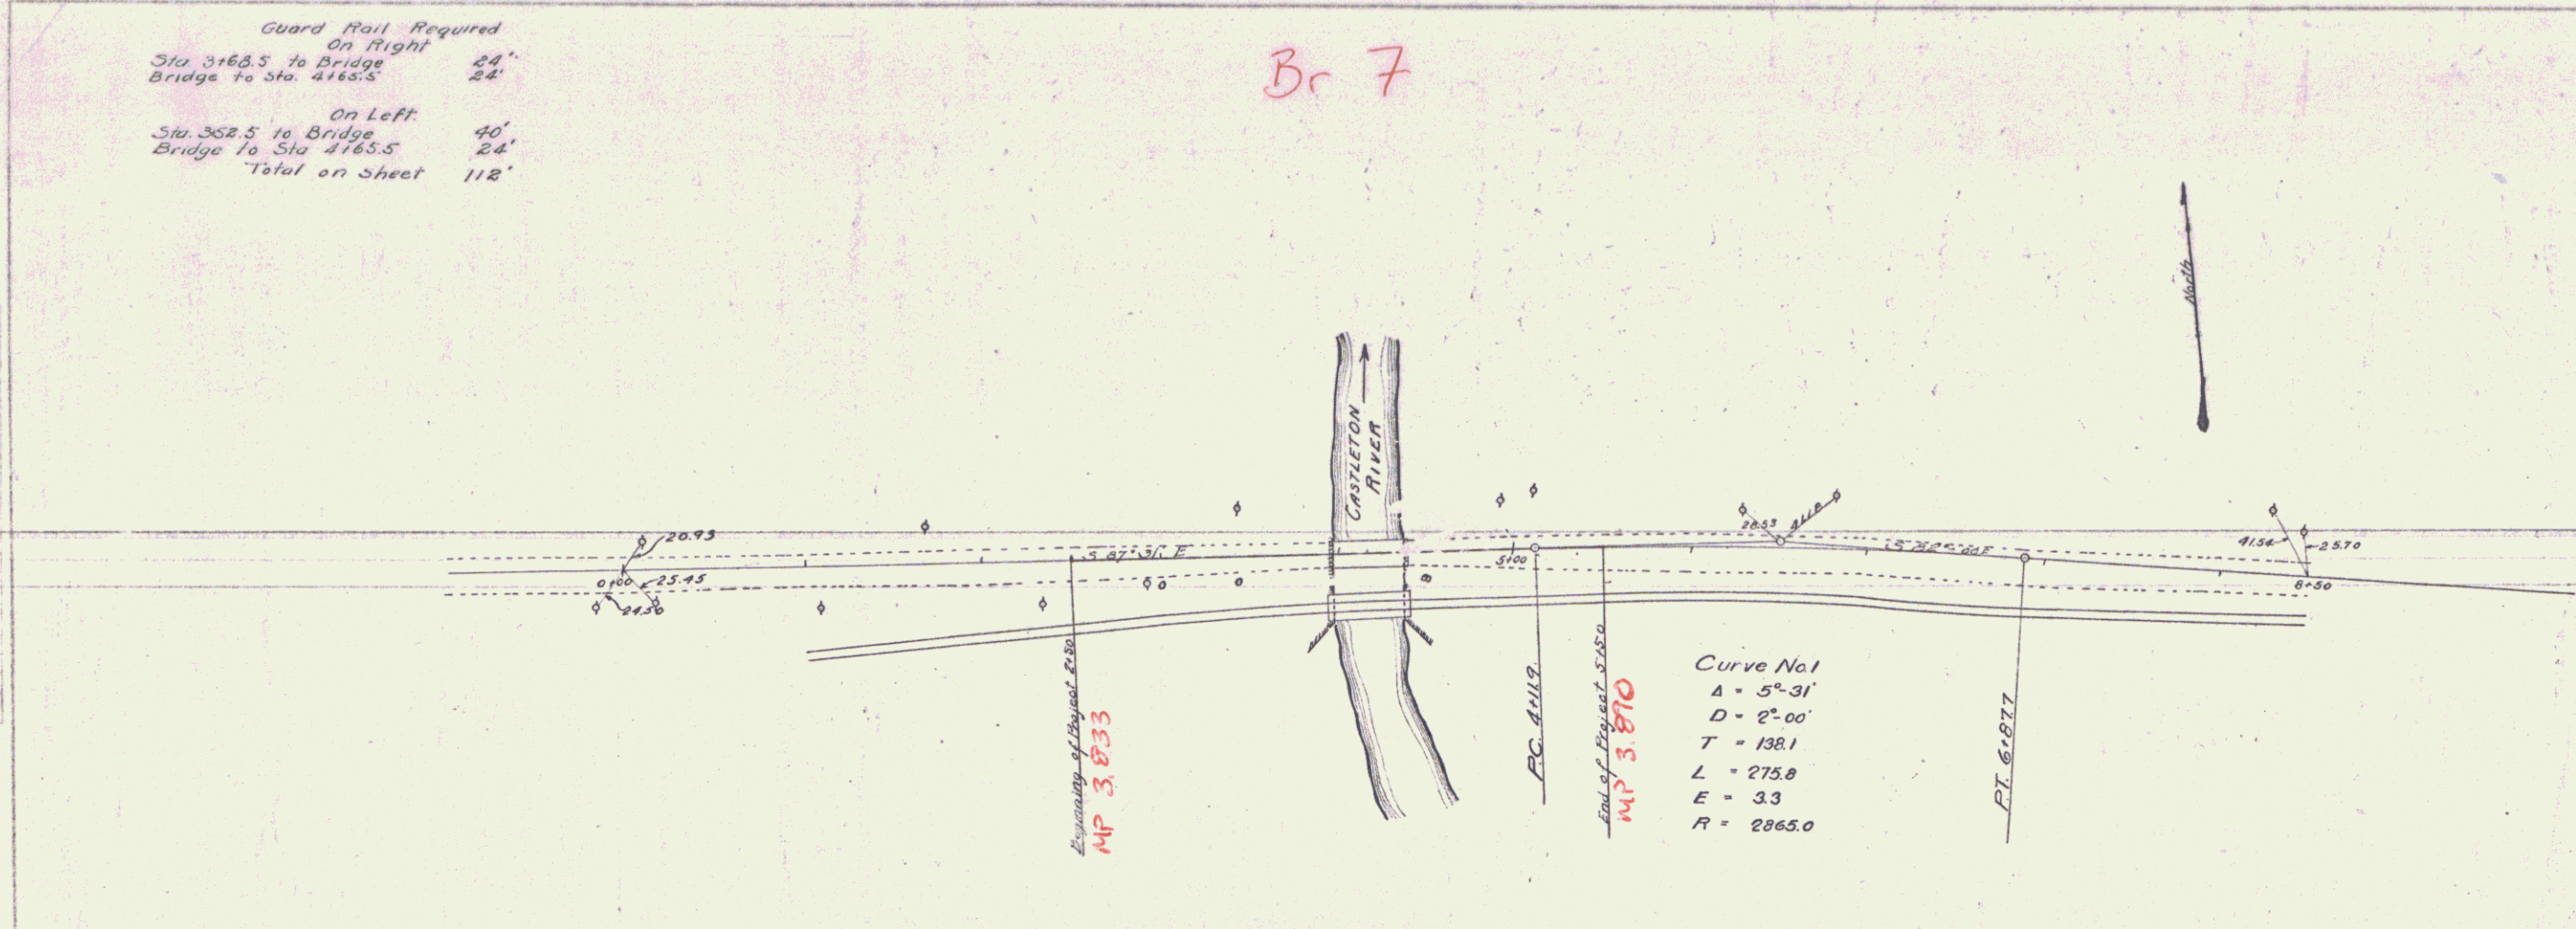

B.M. Top of plate - West End North Gider R.R. Bridge - Elev. 100.00

Bridge No. 1

Drawn by E. F. Welch
 Planned by M. S. Peterson
 Checked by M. S. Peterson
 Examined by M. S. Peterson
 Date 5/19

2