

GUARD RAIL REQUIRED
ON LEFT
 Sta. 15+00 to 15+12 Length 12 Ft
 " 27+01 to 27+25 " 24 "



ON RIGHT
 Sta. 15+00 to 15+12 Length 12 Ft
 " 27+01 to 27+25 " 24 "

TOTAL THIS SHEET 72 FT

NEW CULVERTS REQUIRED
 Sta. 27+13 - 2"x16" Concrete Culvert
 1-2-4 Concrete 5.7 Cu Yds
 1-2-5 Concrete 7.3 Cu Yds

SUB BASE REQUIRED
 Sta. 15+00 to 30+00 Length 1500 Ft

FED. ROAD DIST. NO.	STATE	FED. AID PROJ. YEAR	FISCAL YEAR	SHEET NO.	TOTAL SHEETS
9	VT	50	1917	4	11

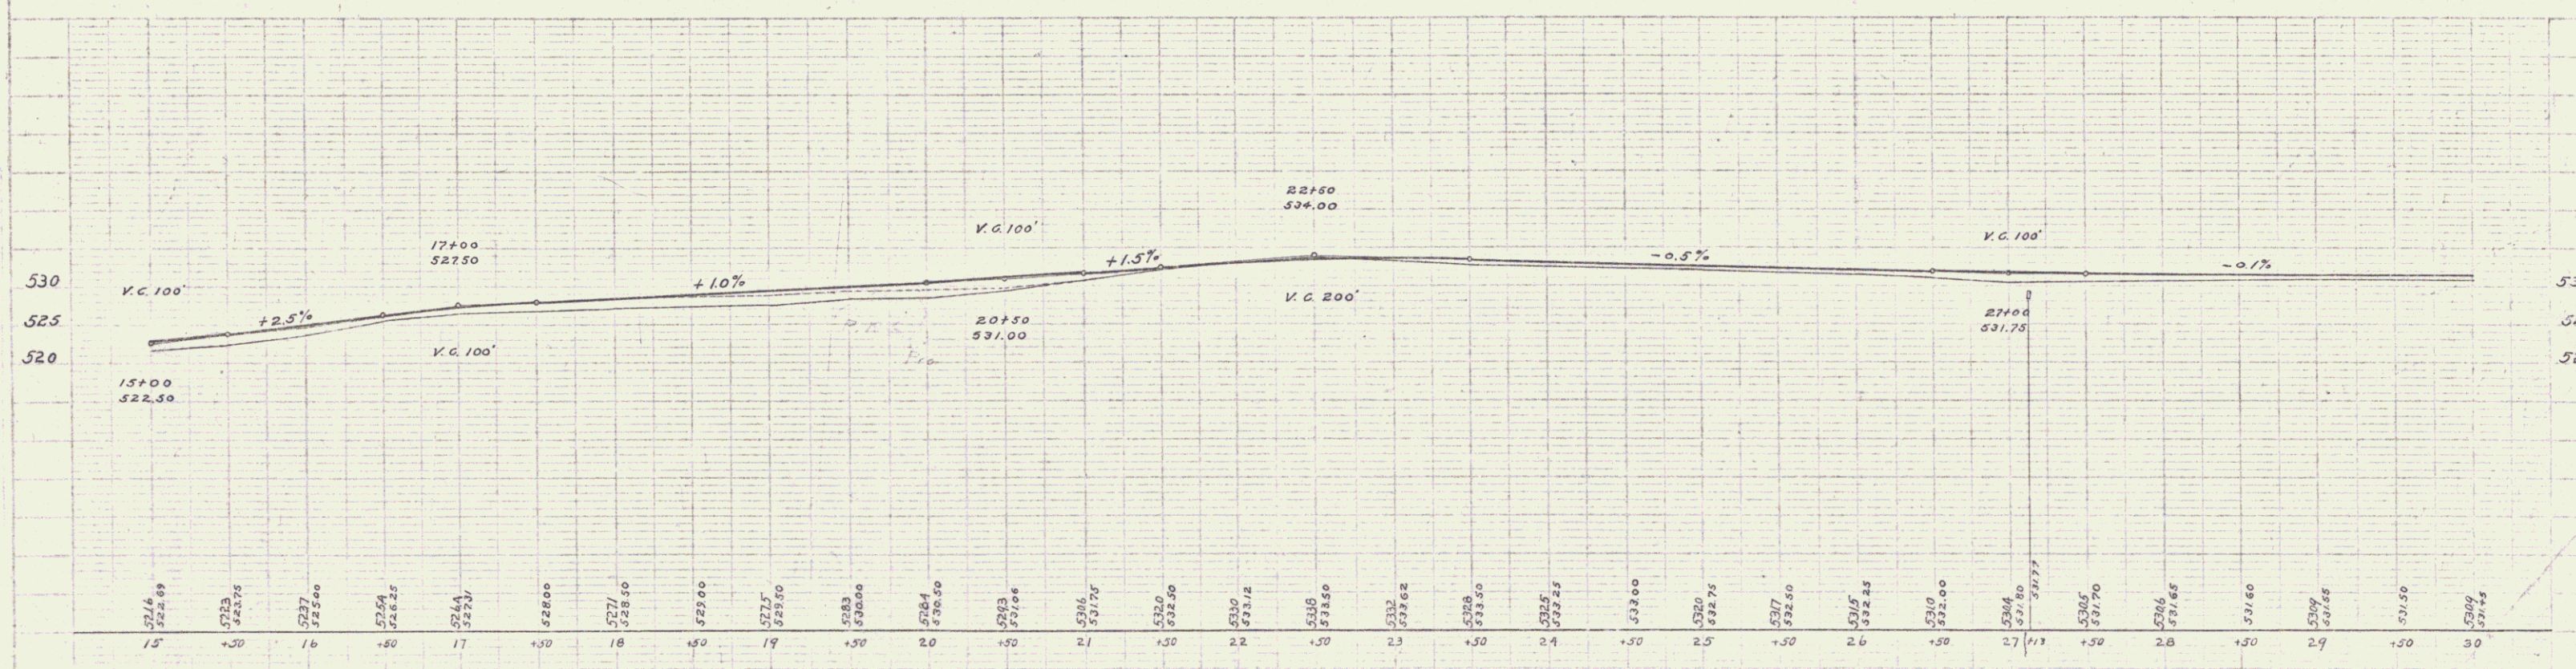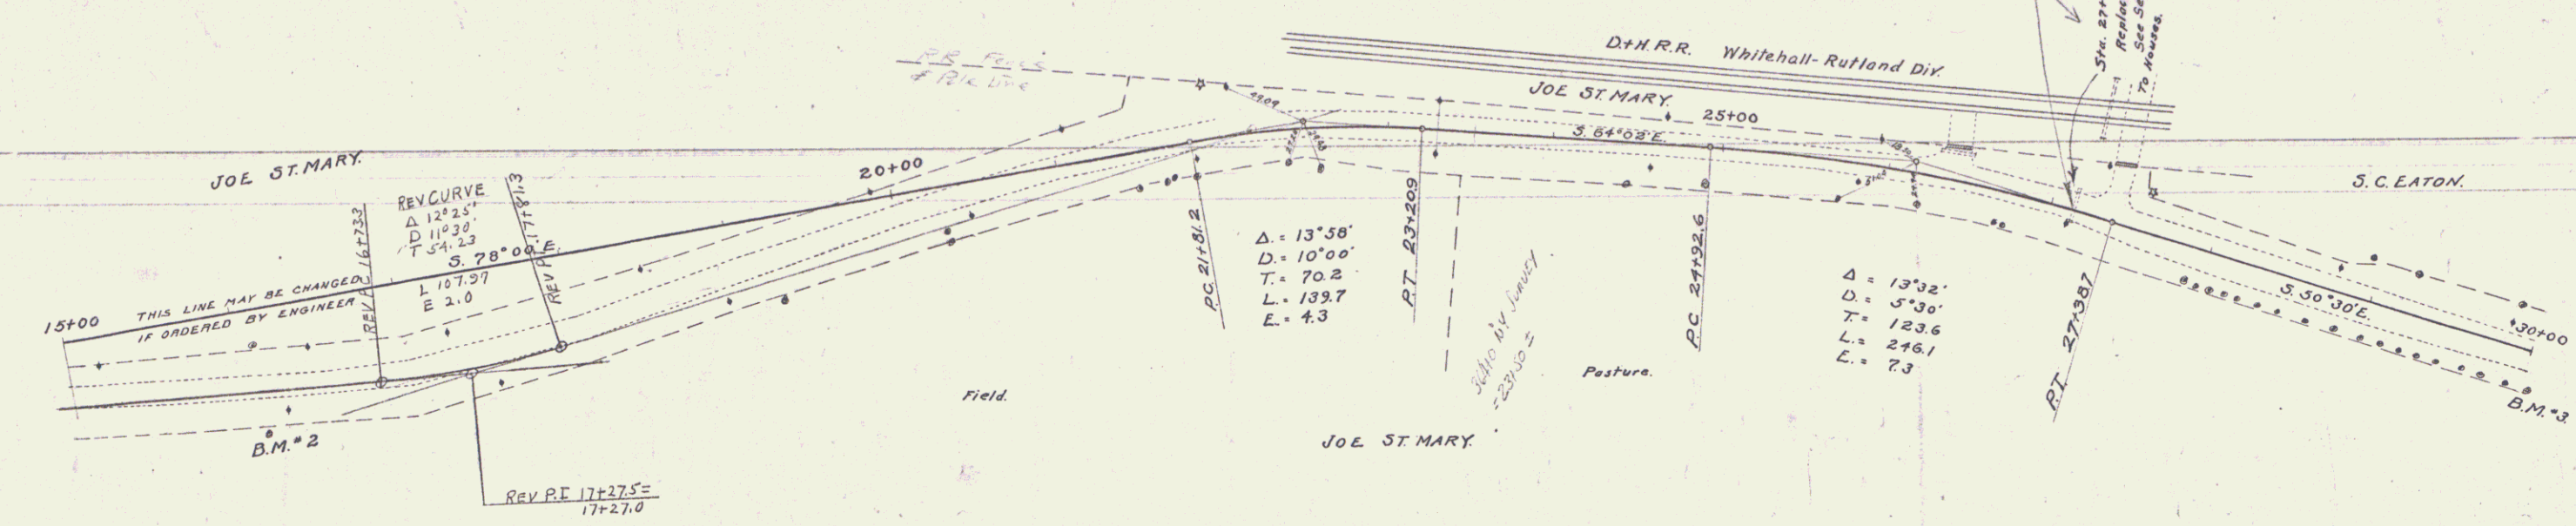

BM #2 Spike in Elm Tree South Side of Road Sta. 16+10 Elev. 528.10
 BM #3 Spike in Elm Tree South Side of Road Sta. 30+00 Elev. 531.83

Series E No. 1112
 Sheet 4 of 11