



**GUARD RAIL REQUIRED**

ON LEFT

Sta. 0+00 to 0+16	Length 16 FT
" 10+07 to 10+31	" 24 "
" 14+88 to 15+00	" 12 "

ON RIGHT

Sta. 0+00 to 1+44	Length 144 FT
" 10+07 to 10+31	" 24 "
" 14+88 to 15+00	" 12 "

TOTAL THIS SHEET 232 FT

**NEW CULVERTS REQUIRED**



Sta. 10+19	2'x2' Concrete Culvert
" 1-2'-4"	Concrete 5.5' Curb
" 1-2'-5"	" 7.3 "

Sta. 15+00	15" Concrete 32 FT
" 1-2'-5"	Concrete 20 Curb
" Curb	6.2 "

**SUB BASE REQUIRED**

Sta. 3+00 to 15+00 Length 1205.5 FT

PROJECT NO.	STATE	FED. AID	FISCAL YEAR	SHEET NO.	TOTAL SHEETS
9	VT	50	1922	9	11

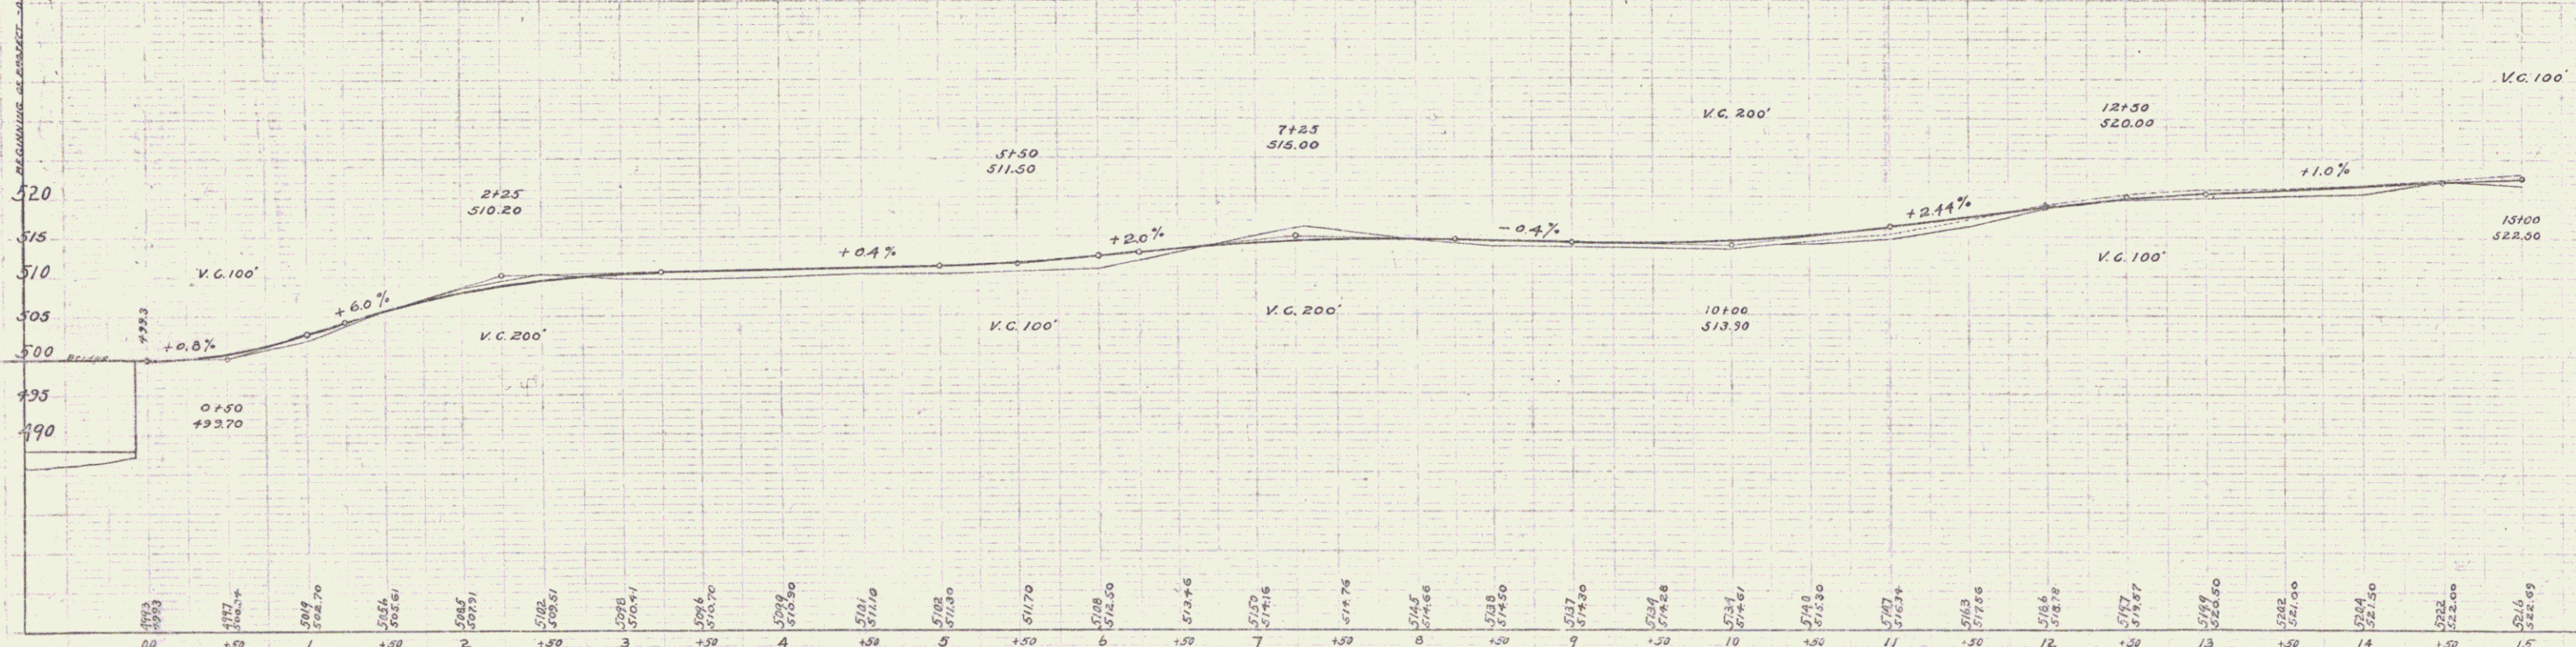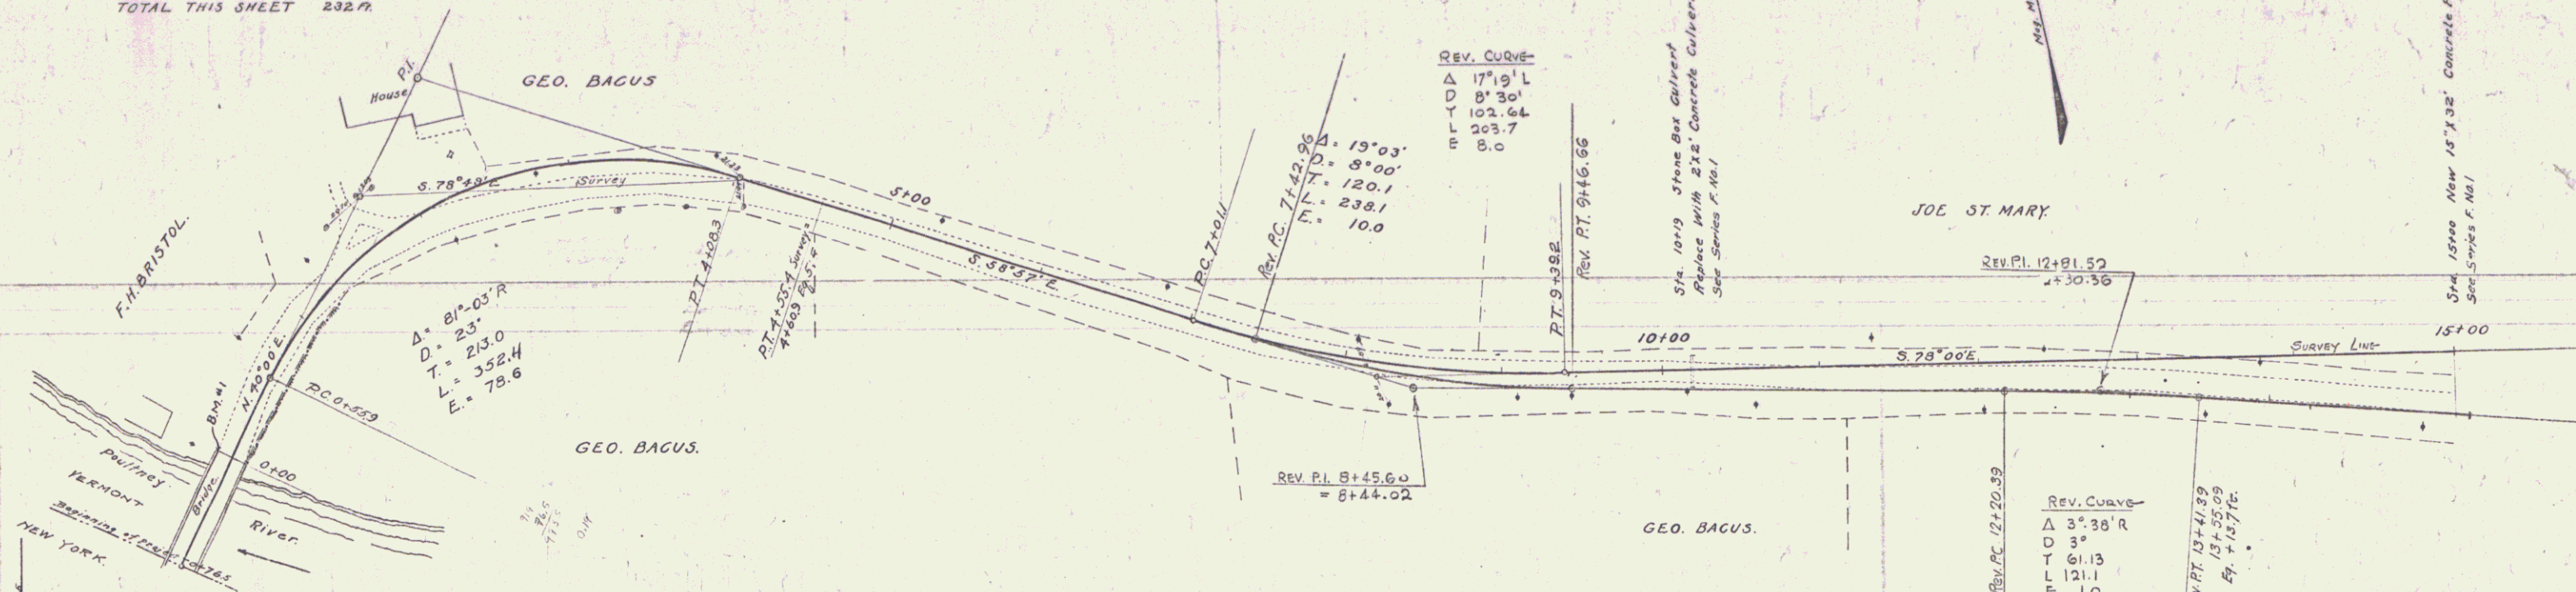

B.M. #1. Top of Curb North End of Bridge. East Side. Sta. 0+00 Elev. 500.00

Series No. 11  
Sheet 9 of 11

**GUARD RAIL REQUIRED**  
**ON LEFT**  
 Sta. 15+00 to 15+12 Length 12 Ft  
 " 27+01 to 27+25 " 24 "



**ON RIGHT**  
 Sta. 15+00 to 15+12 Length 12 Ft  
 " 27+01 to 27+25 " 24 "

**TOTAL THIS SHEET 72 FT**

**NEW CULVERTS REQUIRED**  
 Sta. 27+13 - 2"x16" Concrete Culvert  
 1-2-4 Concrete 5.7 Cu Yds.  
 1-2-5 Concrete 7.3 Cu Yds.

**SUB BASE REQUIRED**  
 Sta. 15+00 to 30+00 Length 1500 Ft

FED. ROAD DIST. NO.	STATE	FED. AID PROJ. YEAR	FISCAL YEAR	SHEET NO.	TOTAL SHEETS
9	VT	50	1917	4	11

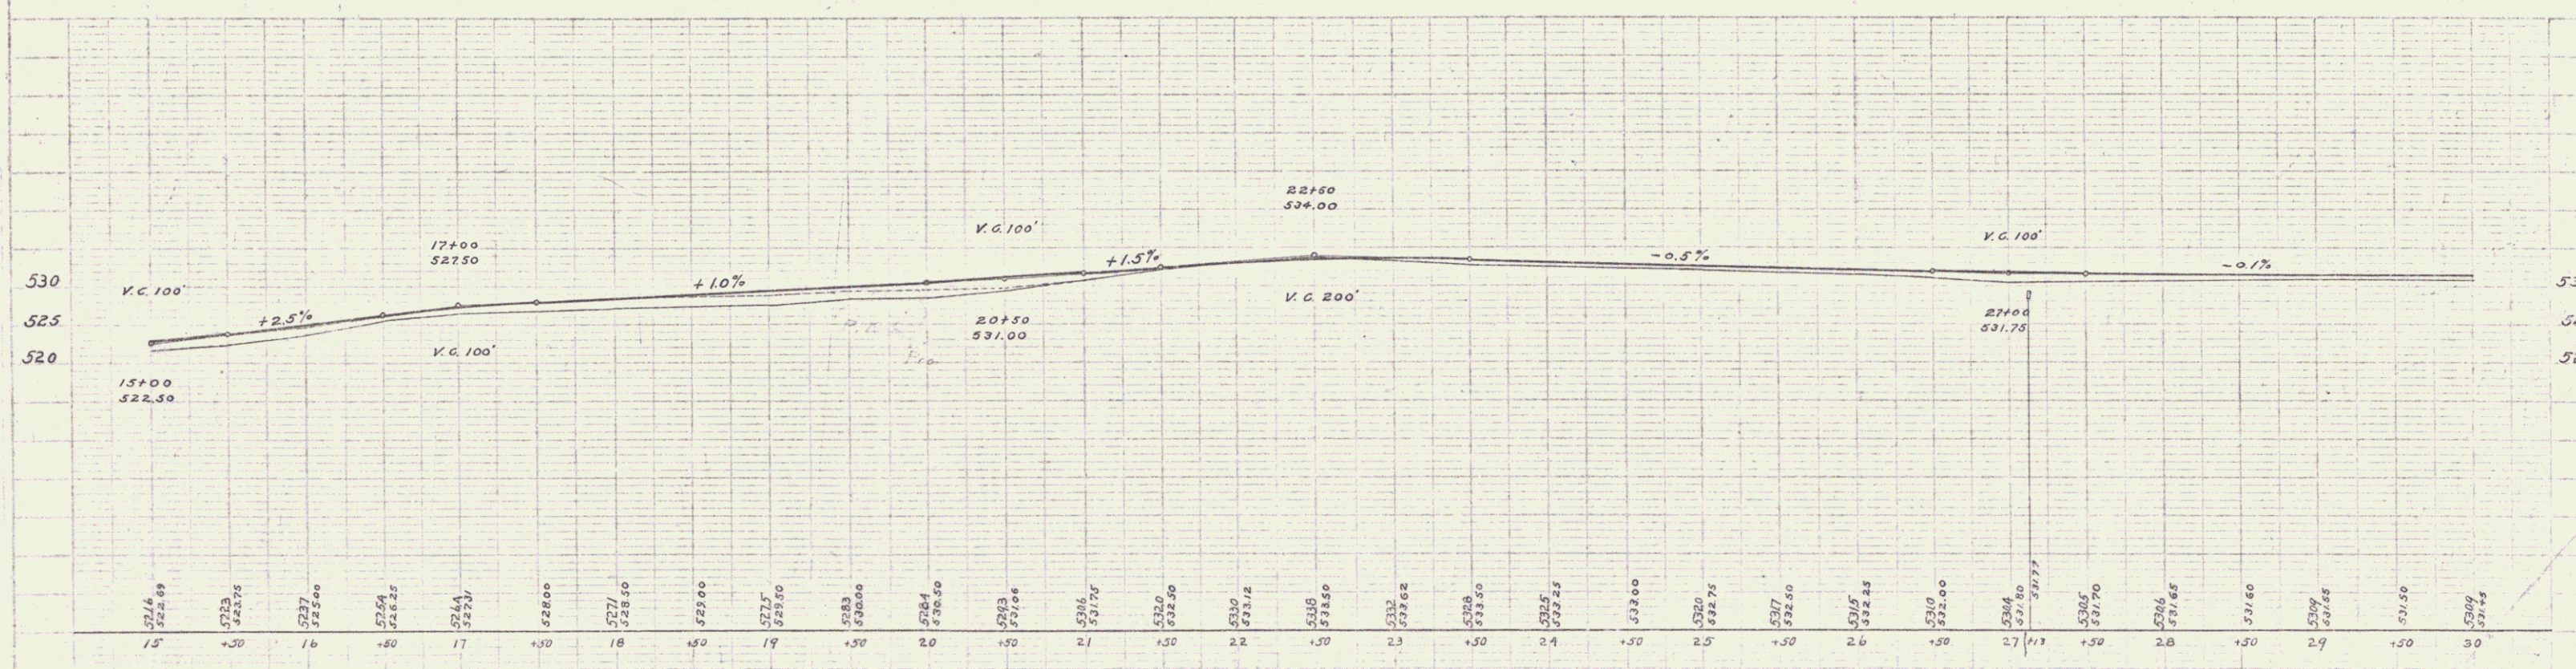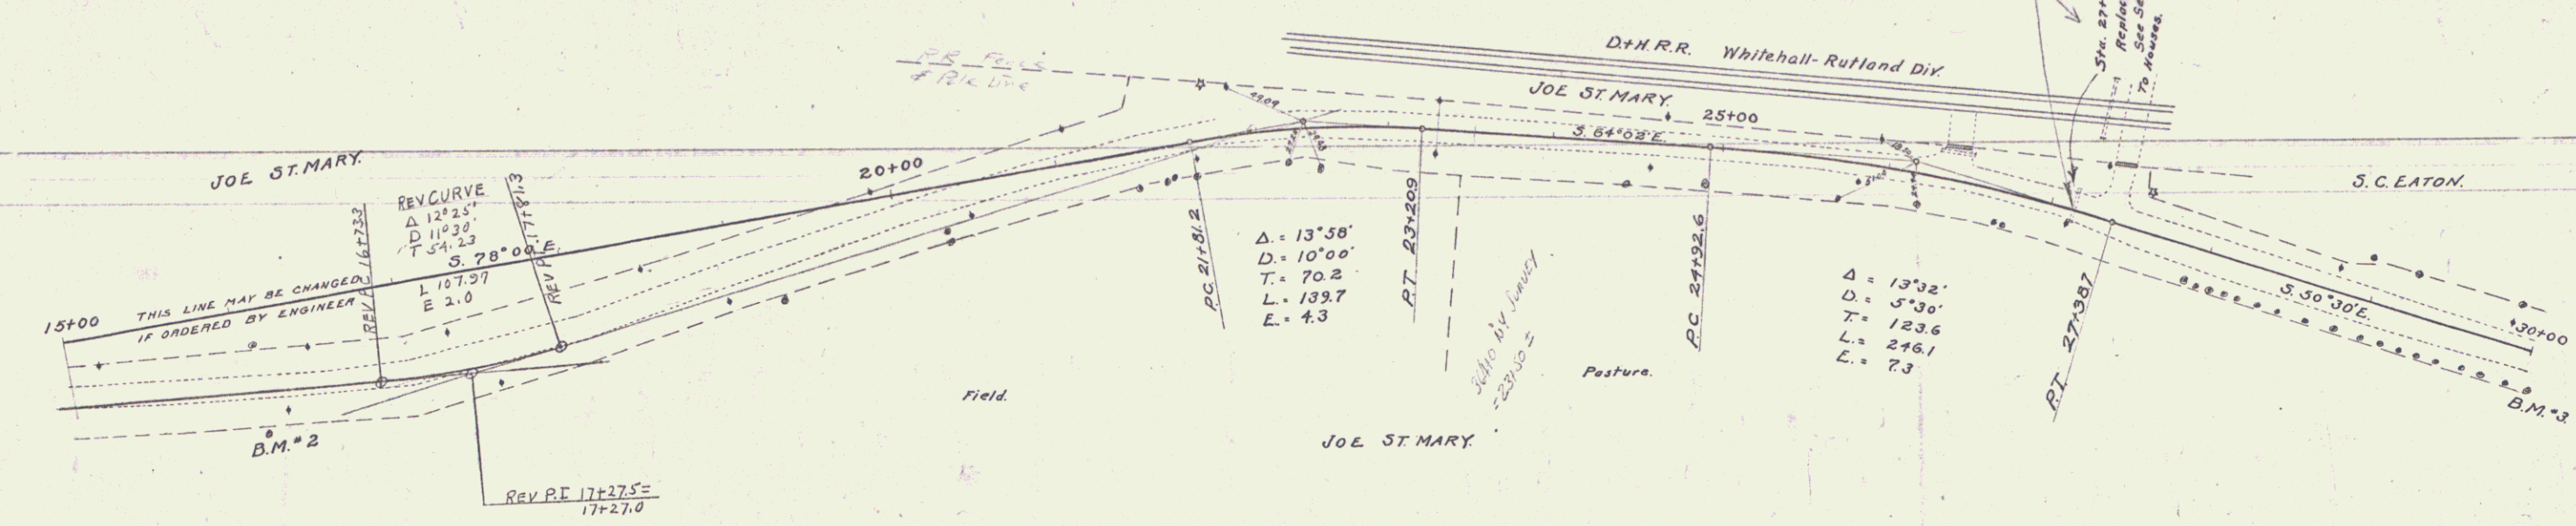


BM #2 Spike in Elm Tree South Side of Road Sta. 16+10 Elev. 528.10  
 BM #3 Spike in Elm Tree South Side of Road Sta. 30+00 Elev. 531.83

Series No. 4  
 Sheet 4 of 11




PLAN  
 DATE BOOK  
 E.P. HENCH  
 CIVIL ENGINEER  
 11/1/40  
 V.O. CRANE  
 11/1/40

PROFILE  
 DATE BOOK  
 11/1/40  
 11/1/40  
 11/1/40

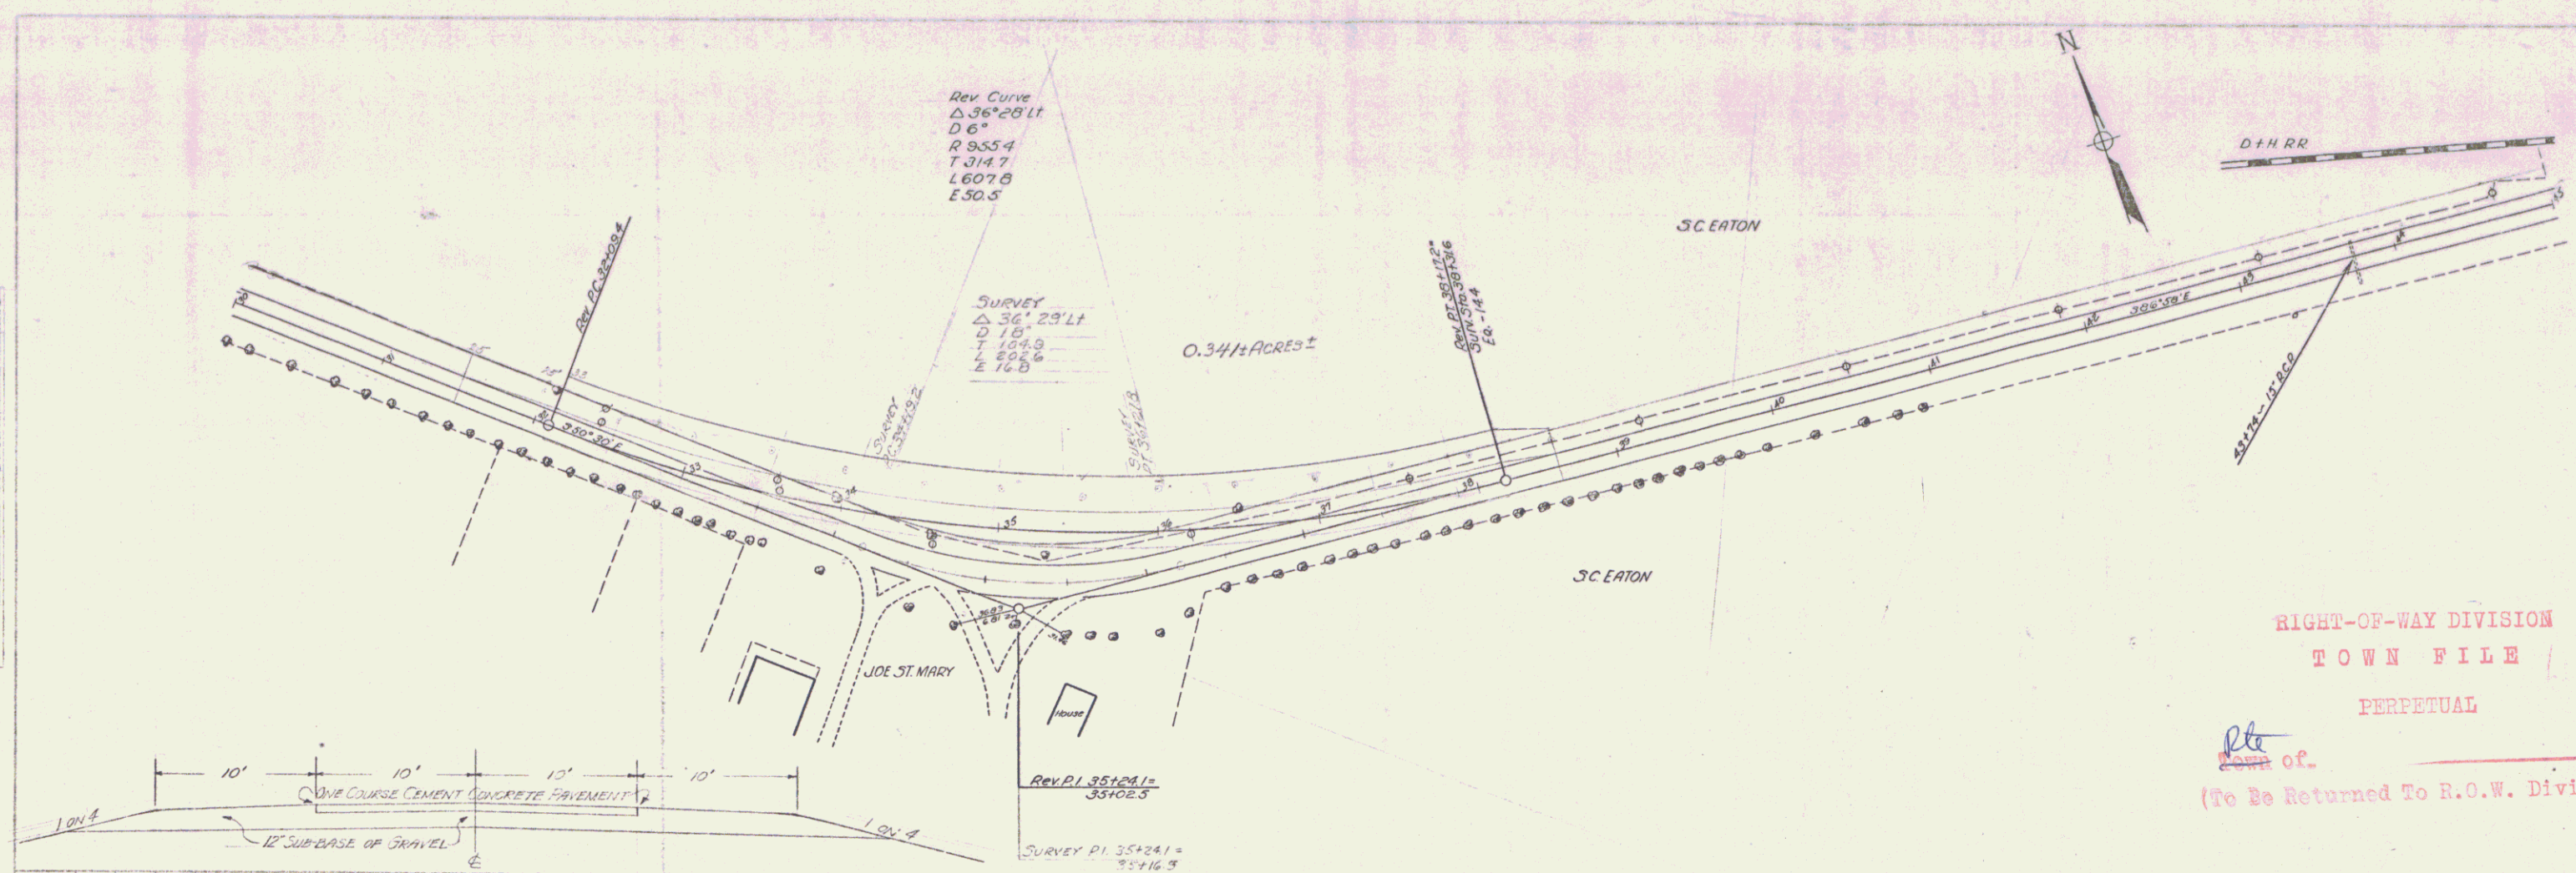

RIGHT-OF-WAY DIVISION  
 TOWN FILE  
 PERPETUAL  
 of.  
 (To Be Returned To R.O.W. Division)

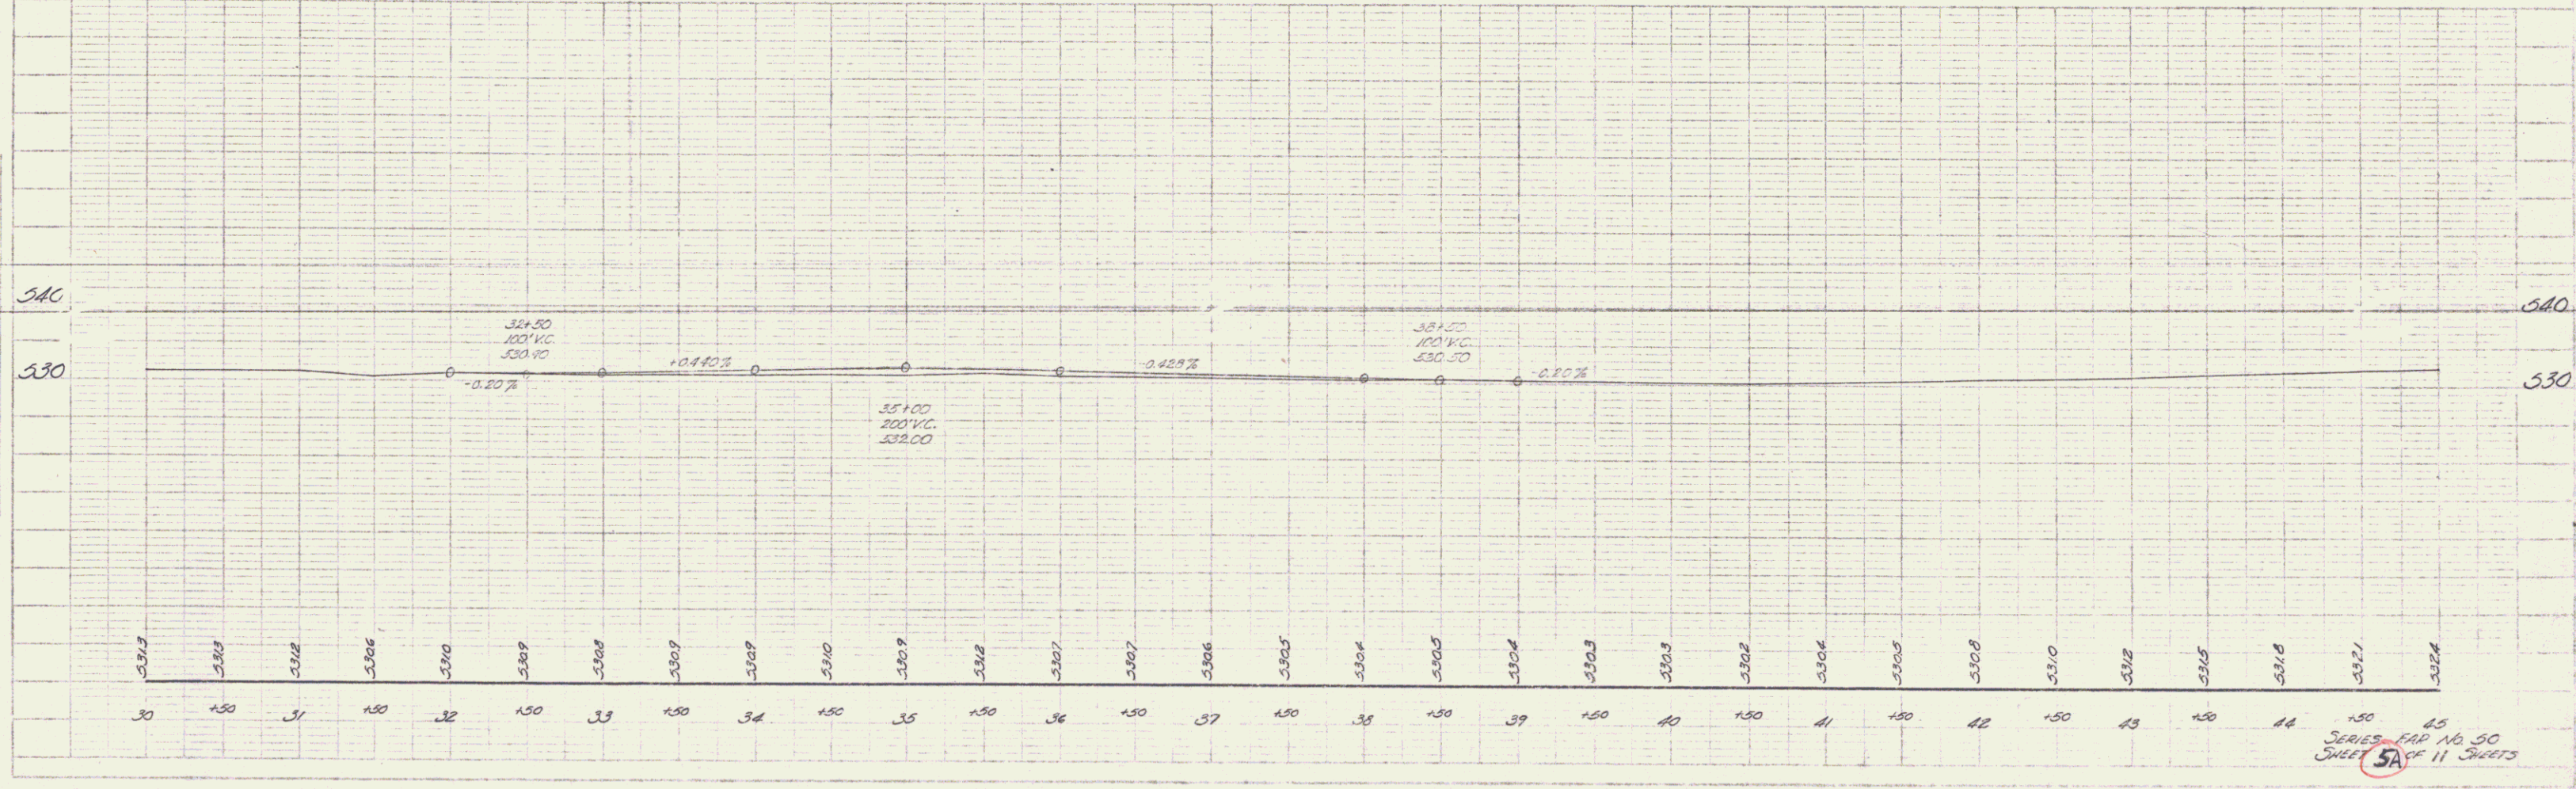

150 25  
 SERIES MAP NO. 50  
 SHEET 5A OF 11 SHEETS

Fair Haven

