

- INDEX TO SHEETS
1. TITLE SHEET
 2. TYPICAL SECTION
 3. DETAIL SHEET
 - 4-5. PLAN SHEETS
 - 6-7. PROFILE SHEETS
 - A. CRONAFLEX SHEET

STATE OF VERMONT
DEPARTMENT OF HIGHWAYS




PROPOSED IMPROVEMENT

SECONDARY PROJECT

TOWN OF FAIR HAVEN

COUNTY OF RUTLAND
U.S. ROUTE 4 CONNECTION
RIGHT OF WAY PLANS

BEGINNING AT A POINT APPROXIMATELY 0.682 MILES EASTERLY OF THE NEW YORK - VERMONT STATE LINE AND PROCEEDING EASTERLY 0.279 MILES.

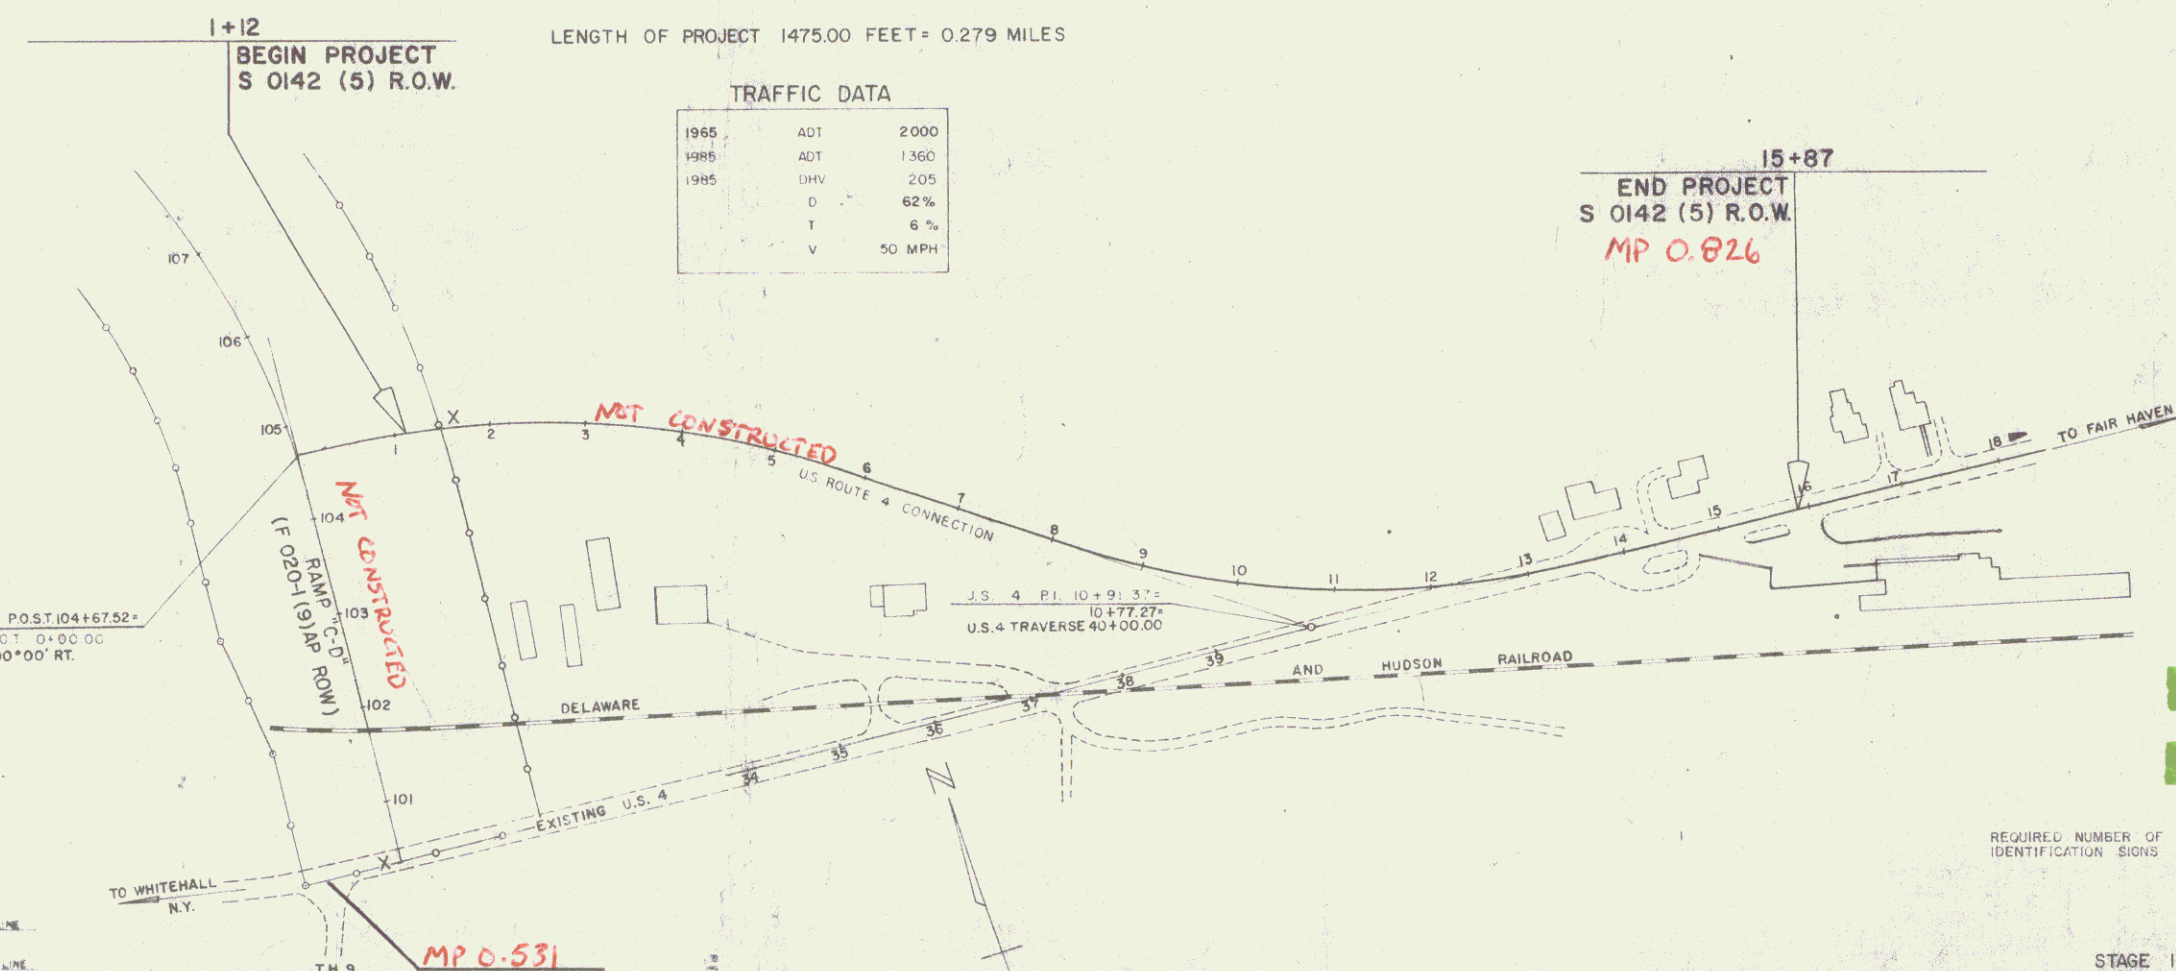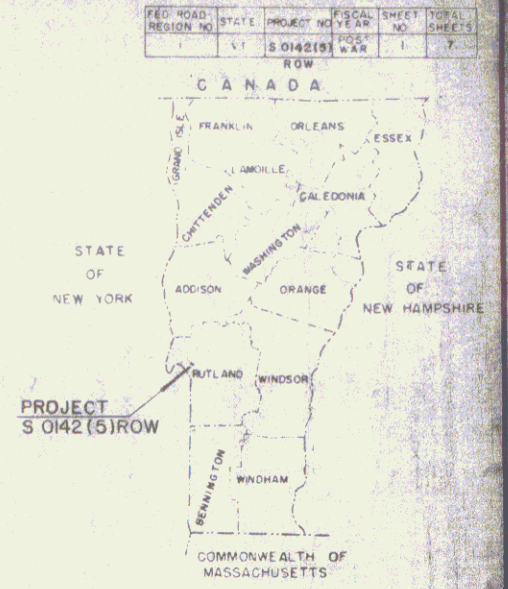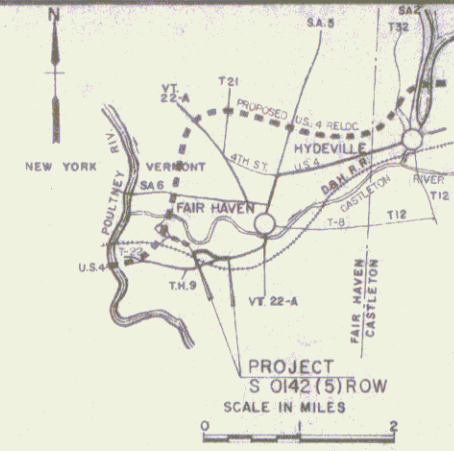

TRAFFIC DATA

1965	ADT	2000
1985	ADT	1360
1985	DHV	205
	D	62%
	T	6%
	V	50 MPH

- CONVENTIONAL SIGNS
- ROW FENCE
 - SLOPE RIGHTS
 - CONTROL OF ACCESS
 - ROW
 - COUNTY LINE
 - TOWN LINE
 - FENCE LINE
 - STONE WALL
 - UNFENCED PROPERTY
 - GUARD RAIL
 - TRAVELED WAY
 - RAILROAD
 - RETAINING WALL
 - CENTER LINE
 - SURVEY LINE
 - CULVERT
 - DROP INLET
 - JOINT OCCUPANCY POLE
 - POWER POLE
 - TELEPHONE POLE
 - TREES
 - HEDGE
 - ACCESS POINT

- DATUM - MEAN SEA LEVEL.
ALL ELEVATIONS ARE U.S. ELEVATIONS
- ROUND ELEVATION
- SCALE IN FEET
- 0 100 200 300
- CONSTRUCTION IDENTIFICATION SIGNS

THESE PLANS ARE SUBJECT TO SUCH REVISIONS AS MAY BE REQUIRED BY THE BUREAU OF PUBLIC ROADS OR THE COMMISSIONER OF HIGHWAYS.

CONSTRUCTION IS TO BE CARRIED ON IN ACCORDANCE WITH THESE PLANS AND THE STANDARD SPECIFICATIONS FOR HIGHWAY AND BRIDGE CONSTRUCTION DATED APRIL, 1964, AS APPROVED BY THE BUREAU OF PUBLIC ROADS ON OCTOBER 12, 1964, INCLUDING ALL SUBSEQUENT APPROVED REVISIONS AND SUCH REVISED SPECIFICATIONS AND SPECIAL PROVISIONS AS ARE INCORPORATED IN THESE PLANS.

REQUIRED NUMBER OF FEDERAL AID CONSTRUCTION IDENTIFICATION SIGNS 1 EACH

Pin # 99R737
Route VT4A

APPROVED [Signature] DATE 10/18/67	APPROVED [Signature] DATE 10/18/67	APPROVED [Signature] DATE 10/18/67	APPROVED [Signature] DATE 10/18/67	APPROVED [Signature] DATE 10/18/67	APPROVED [Signature] DATE 10/17/67	APPROVED [Signature] DATE 10/17/67
--	--	--	--	--	--	--

STAGE 1 - CONSTRUCTION

DEPARTMENT OF COMMERCE
BUREAU OF PUBLIC ROADS

APPROVED

DIVISION ENGINEER DATE

PROJECT S NO. 0142 (5) R.O.W.

SHEET 6 OF 7 SHEETS