

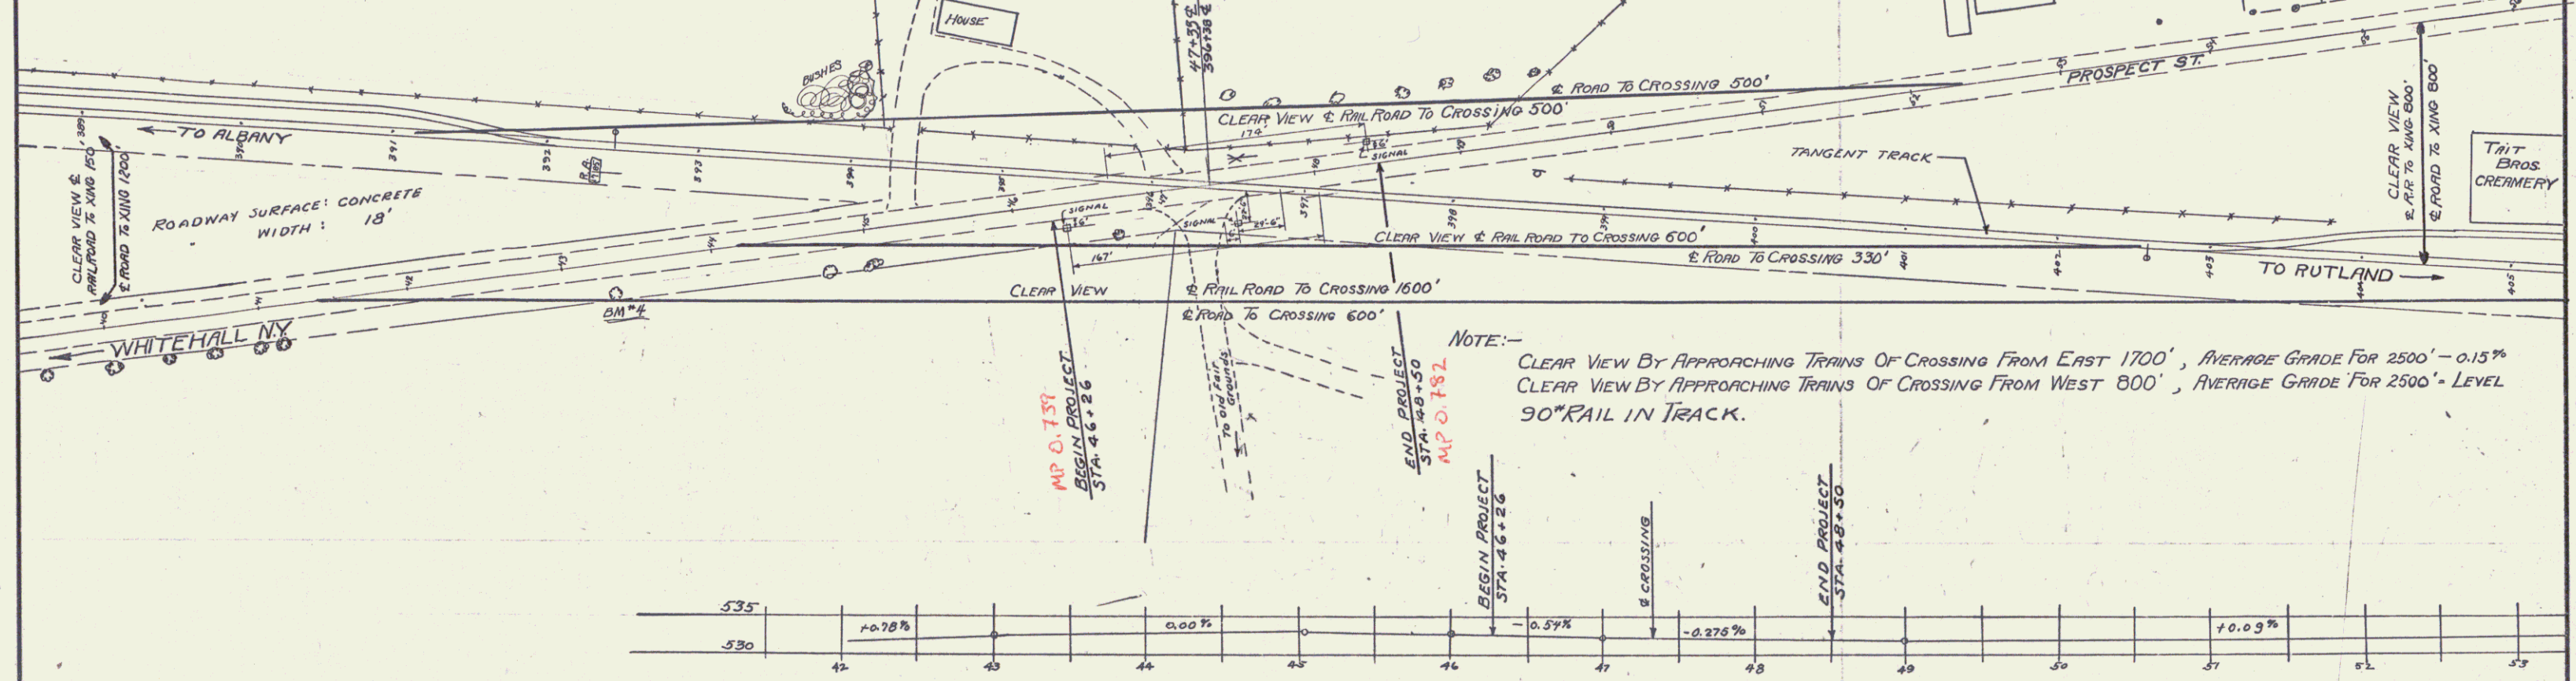


PER. NO.	DATE	BY	REVISION
50	1/26	E. S.	

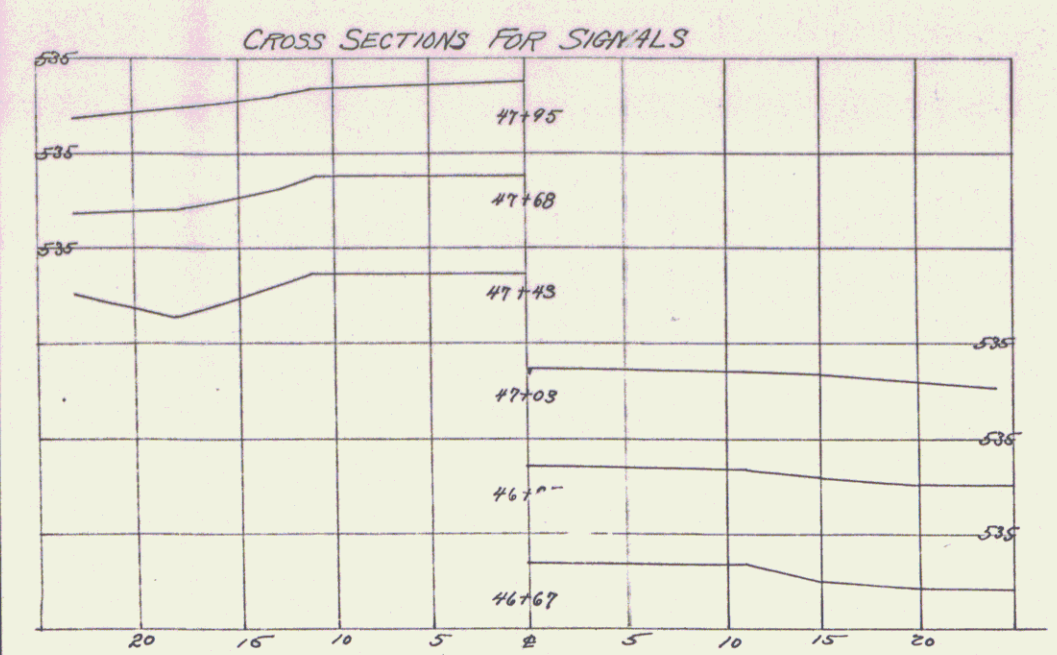

NOTE:-  
 CLEAR VIEW BY APPROACHING TRAINS OF CROSSING FROM EAST 1700', AVERAGE GRADE FOR 2500' - 0.15%  
 CLEAR VIEW BY APPROACHING TRAINS OF CROSSING FROM WEST 800', AVERAGE GRADE FOR 2500' - LEVEL  
 90° RAIL IN TRACK.

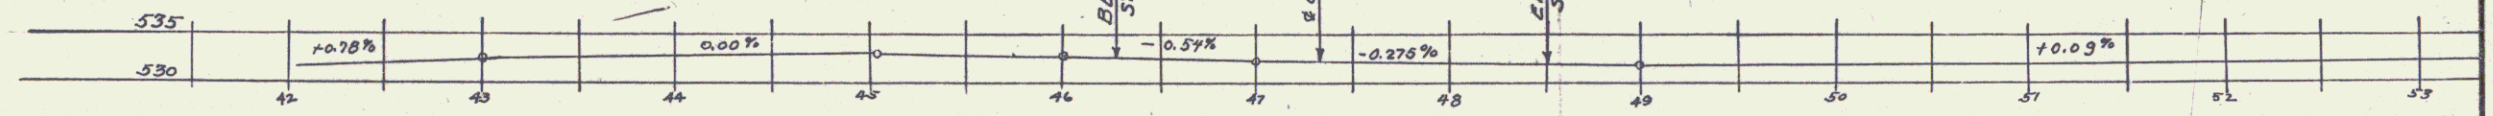

**AUTOMATIC FLASH SIGNAL  
 OVER  
 DELAWARE & HUDSON RAILROAD  
 Vt. W.P.G.H.-50 FAIR HAVEN, VT Scale 1"=50'  
 ESTIMATED QUANTITIES ROUTE US 4. STA. 47+33 FAIR 50'**

REQUIRED: 3 SIGNALS WITH WIRING	Surveyed by <i>Hobson</i> Designed by Drawn by Traced by <i>Hosmer</i> Checked by Series W.P.G.H. No. 50 Filed Sheet 2 of 5 Sheets
---------------------------------	--