
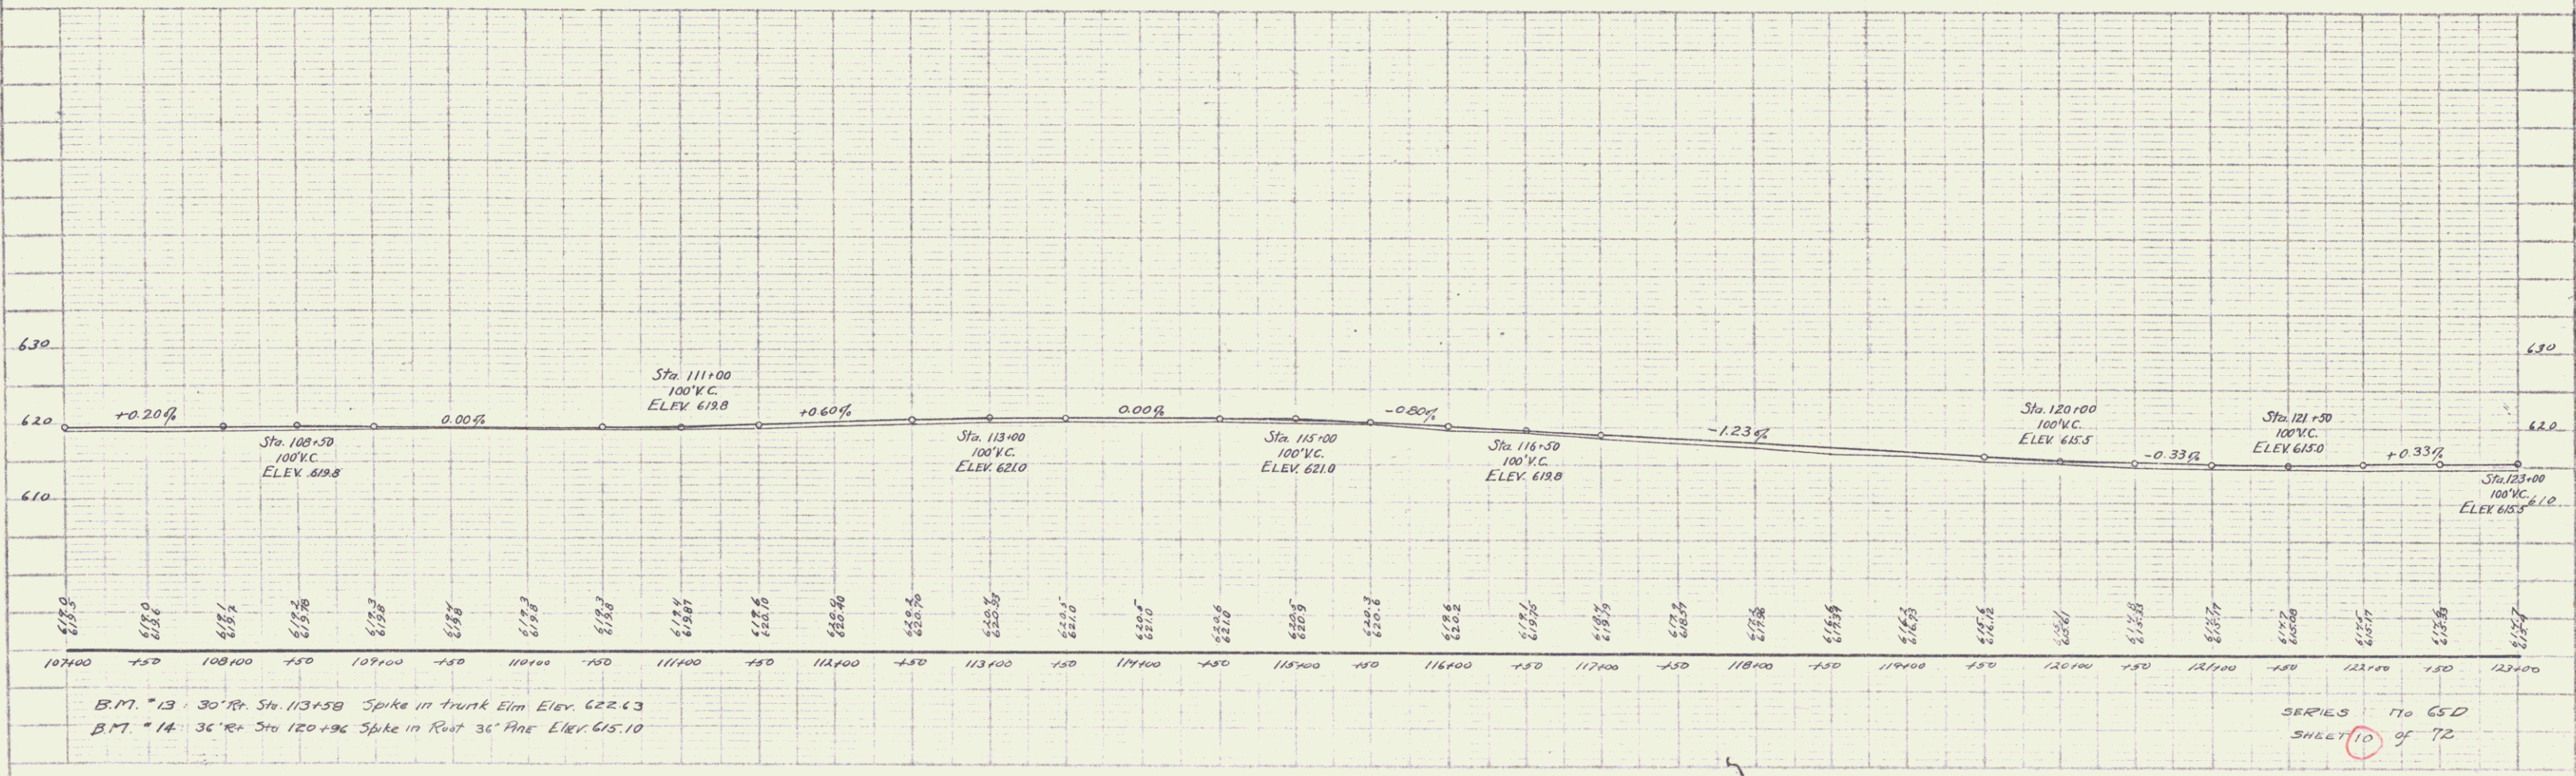


FED. ROAD DIST. NO.	STATE	FED. AID PROJ. NO.	FISCAL YEAR	SHEET NO.	TOTAL SHEETS
VI	45	1227	70	72	

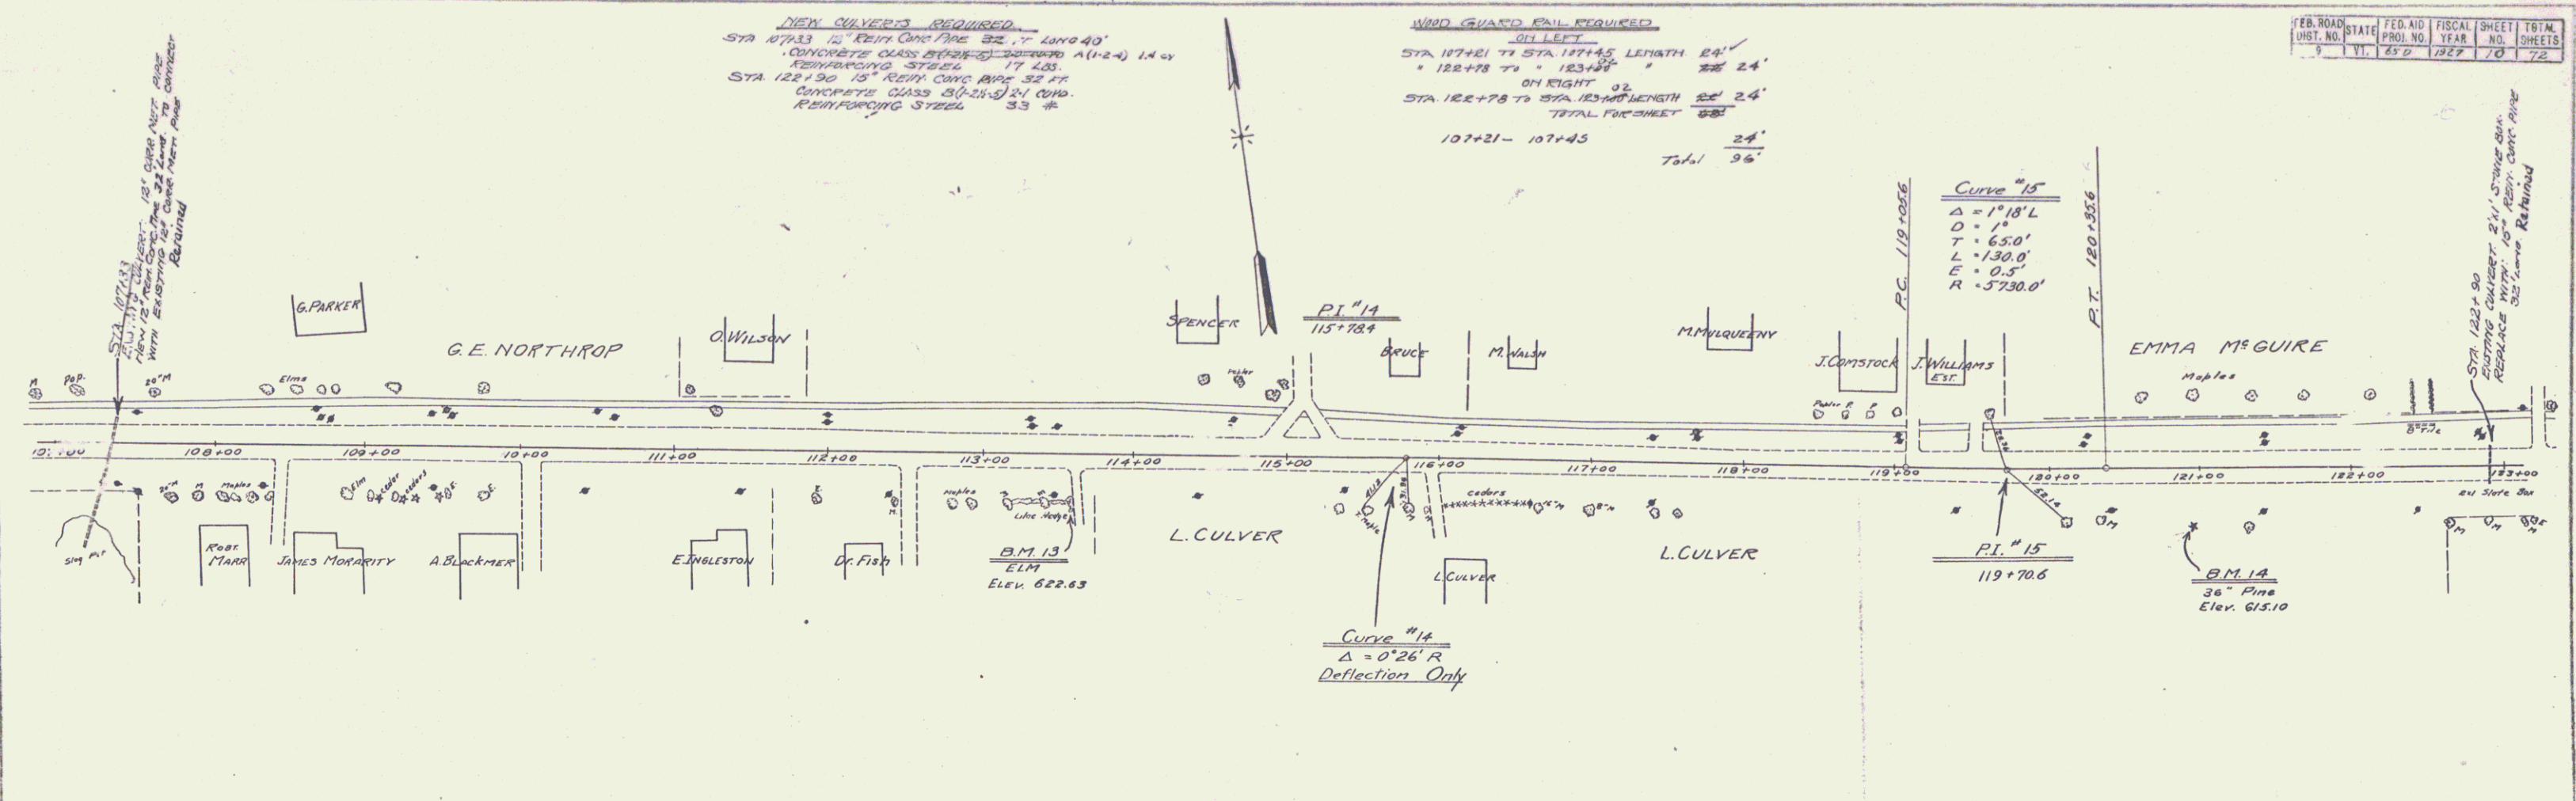

B.M. #13 30" R. Sta 113+58 Spike in trunk Elm Elev. 622.43
 B.M. #14 36" R. Sta 120+96 Spike in Rust 36" Pine Elev. 615.10

SERIES 170 65D
 SHEET 10 of 72