

WOOD GUARD RAIL REQUIRED ON LEFT

STATION	START	END	LENGTH	QTY
" 123+38 TO "	123+38	123+62	"	24'
" 135+70 TO "	135+70	135+94	"	24'

WOOD GUARD RAIL REQUIRED ON RIGHT



STATION	START	END	LENGTH	QTY
" 123+38 TO "	123+38	123+62	"	24'
" 135+70 TO "	135+70	135+94	"	24'

TOTAL PAGESHEET 96'

IRON CURBS REQUIRED

STA 129+50 - 15" REIN CONC PIPE	32 FT
CONCRETE CLASS B (1-24-5)	21 CY
REINFORCING STEEL	33 LBS
STA 135+82 - 15" REIN CONC PIPE	37 FT
CONCRETE CLASS B (1-24-5)	21 CY
REINFORCING STEEL	33 LBS

EST. NO.	STATE	FED. AID	FISCAL YEAR	SHEET NO.	TOTAL SHEETS
11	650	1927	11	12	

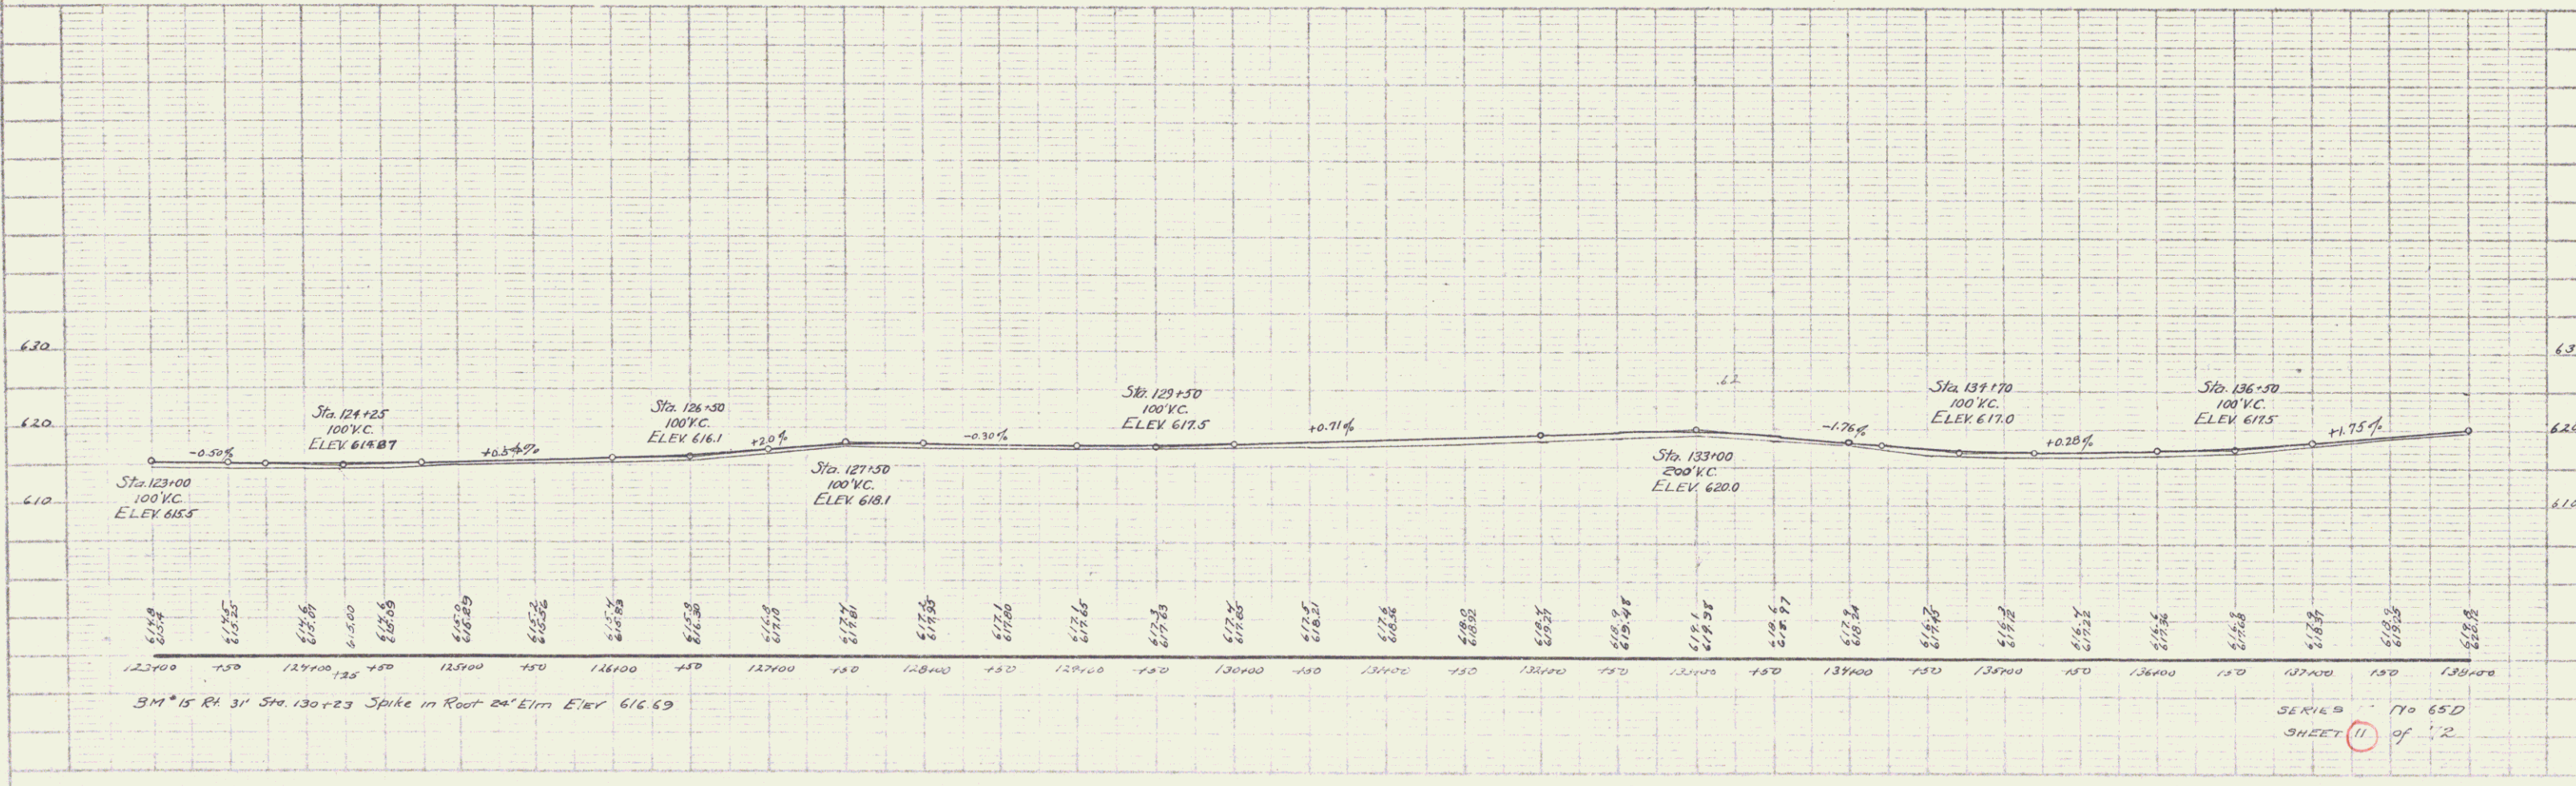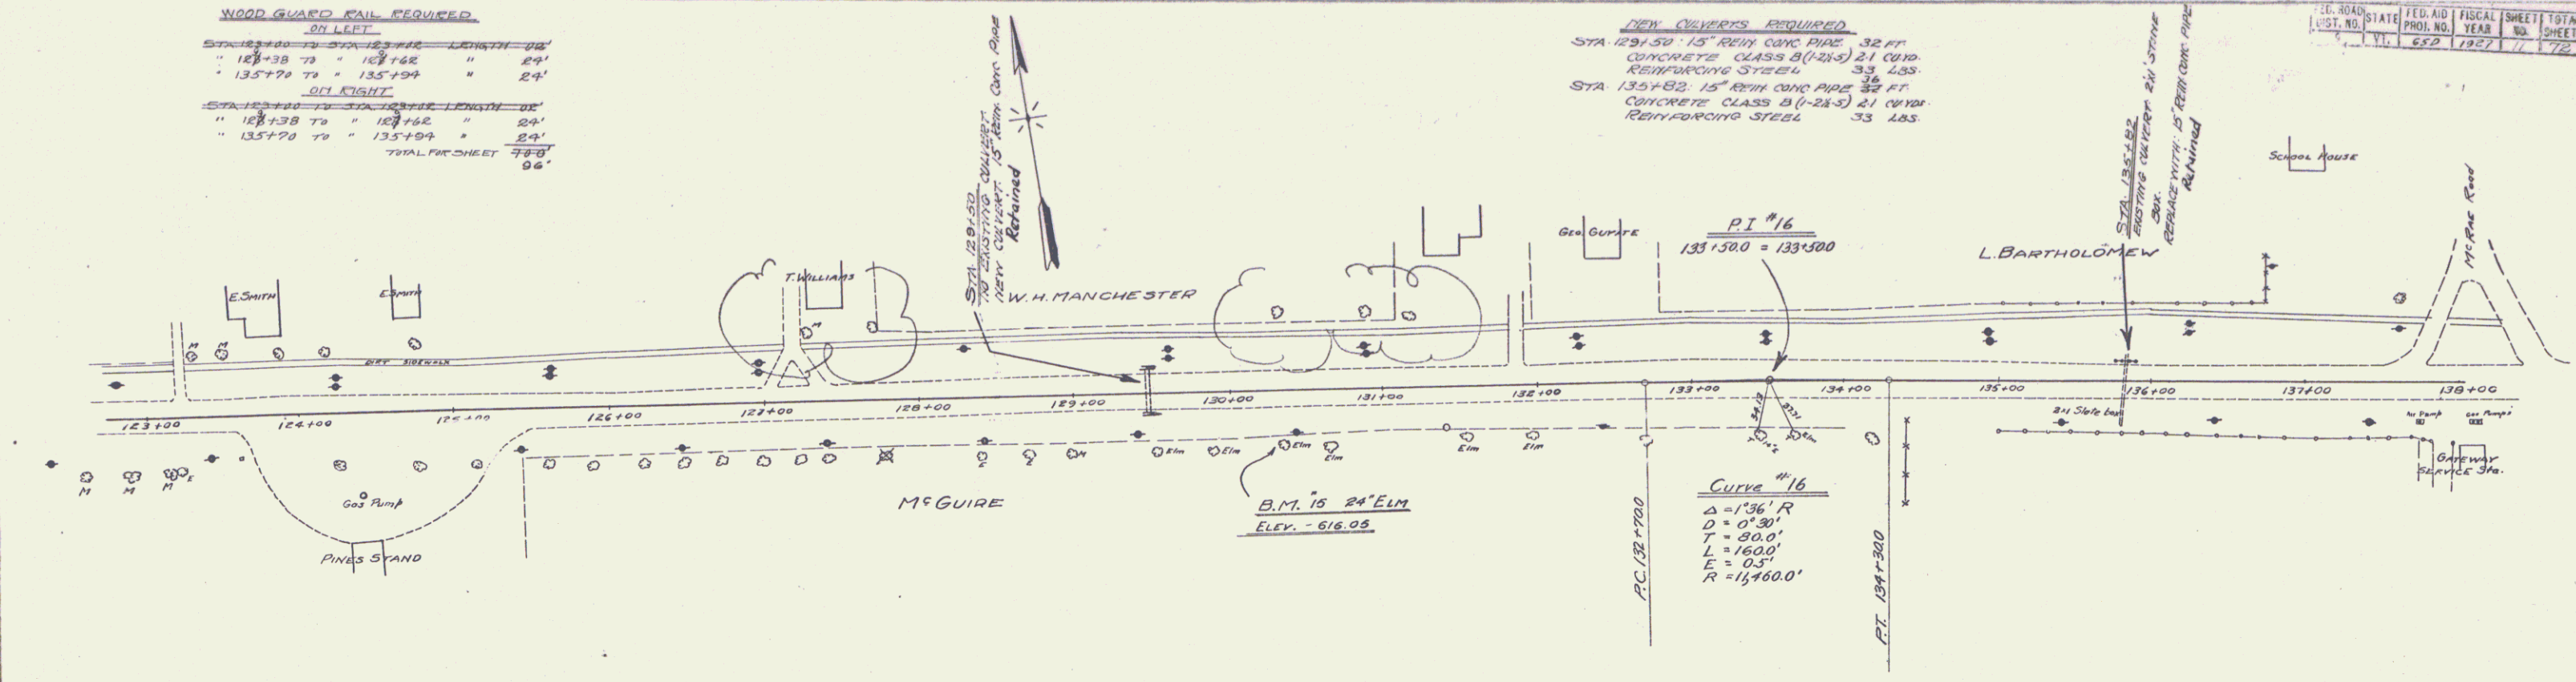

SERIES 770 650
SHEET 11 of 12