
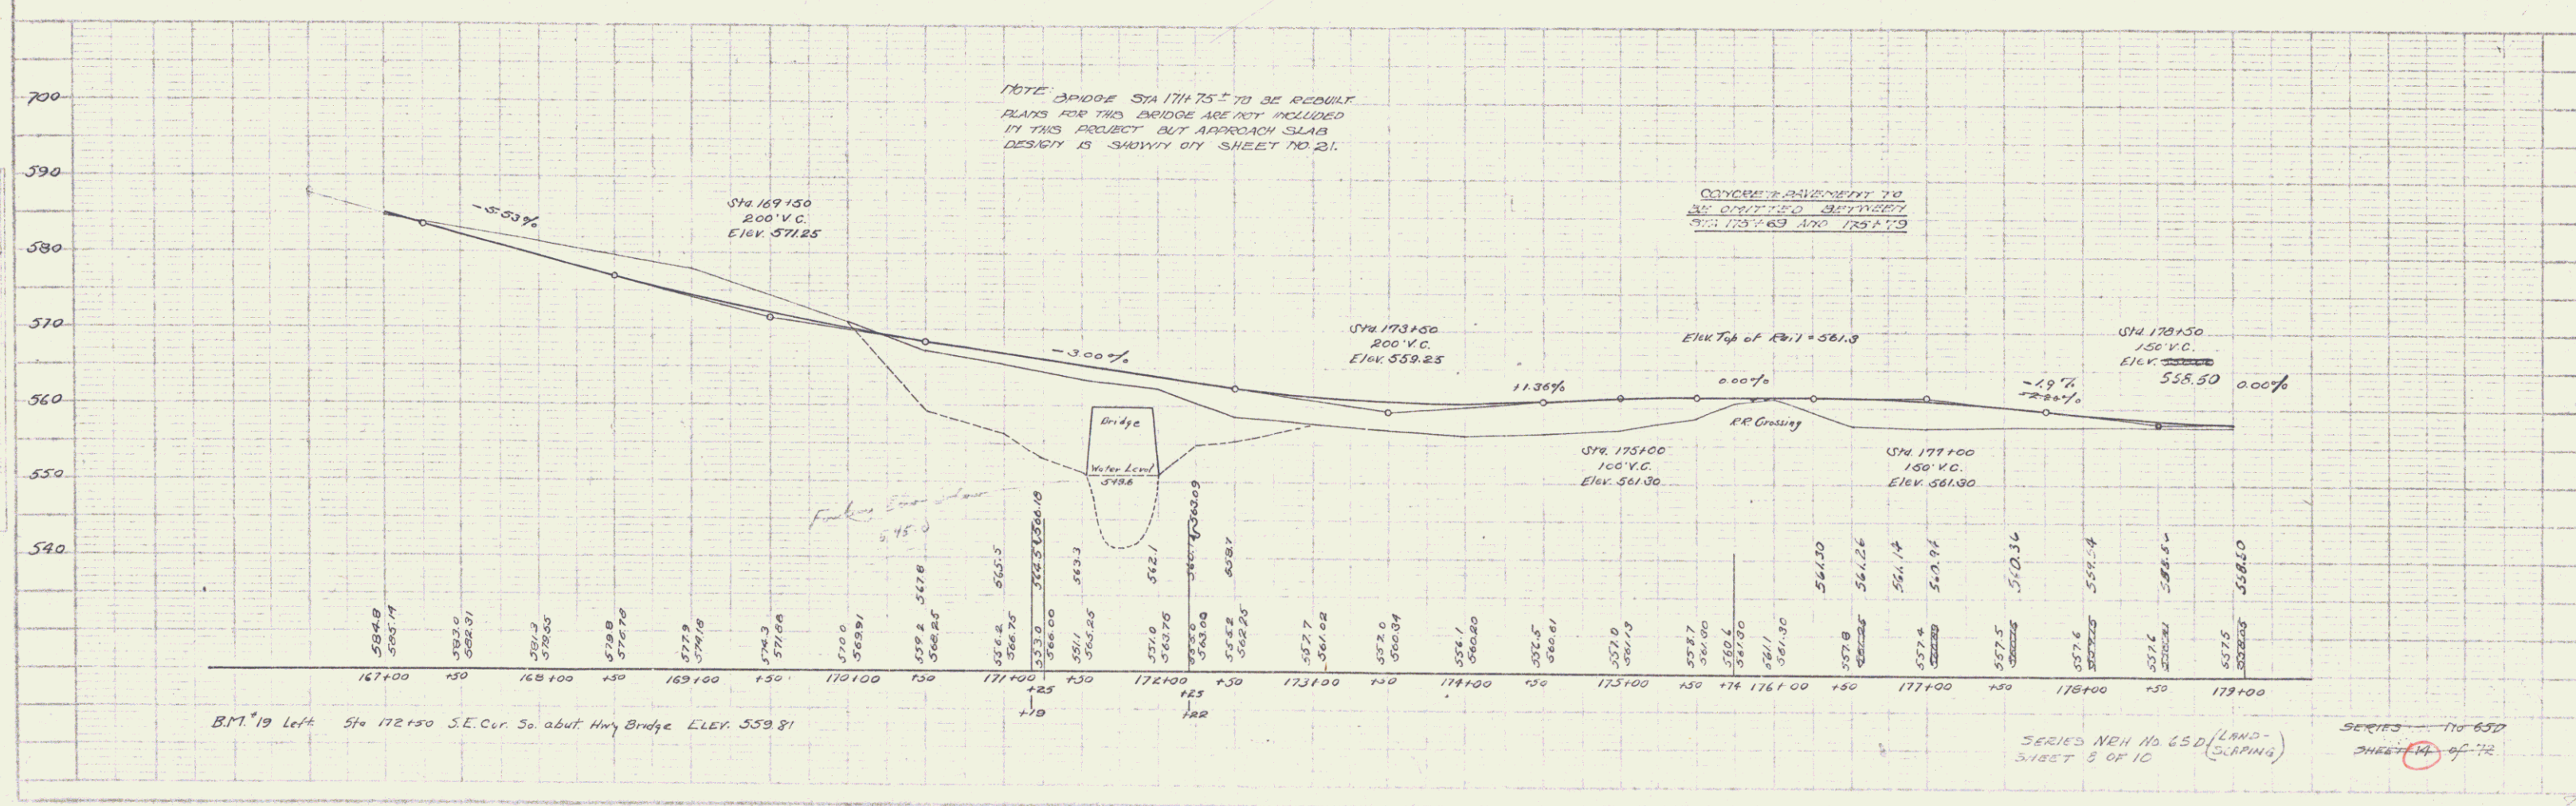


FED. ROAD DIST. NO.		STATE		FISCAL YEAR		SHEET NO.		TOTAL SHEETS	
1	11	67	1	1955	8	10			

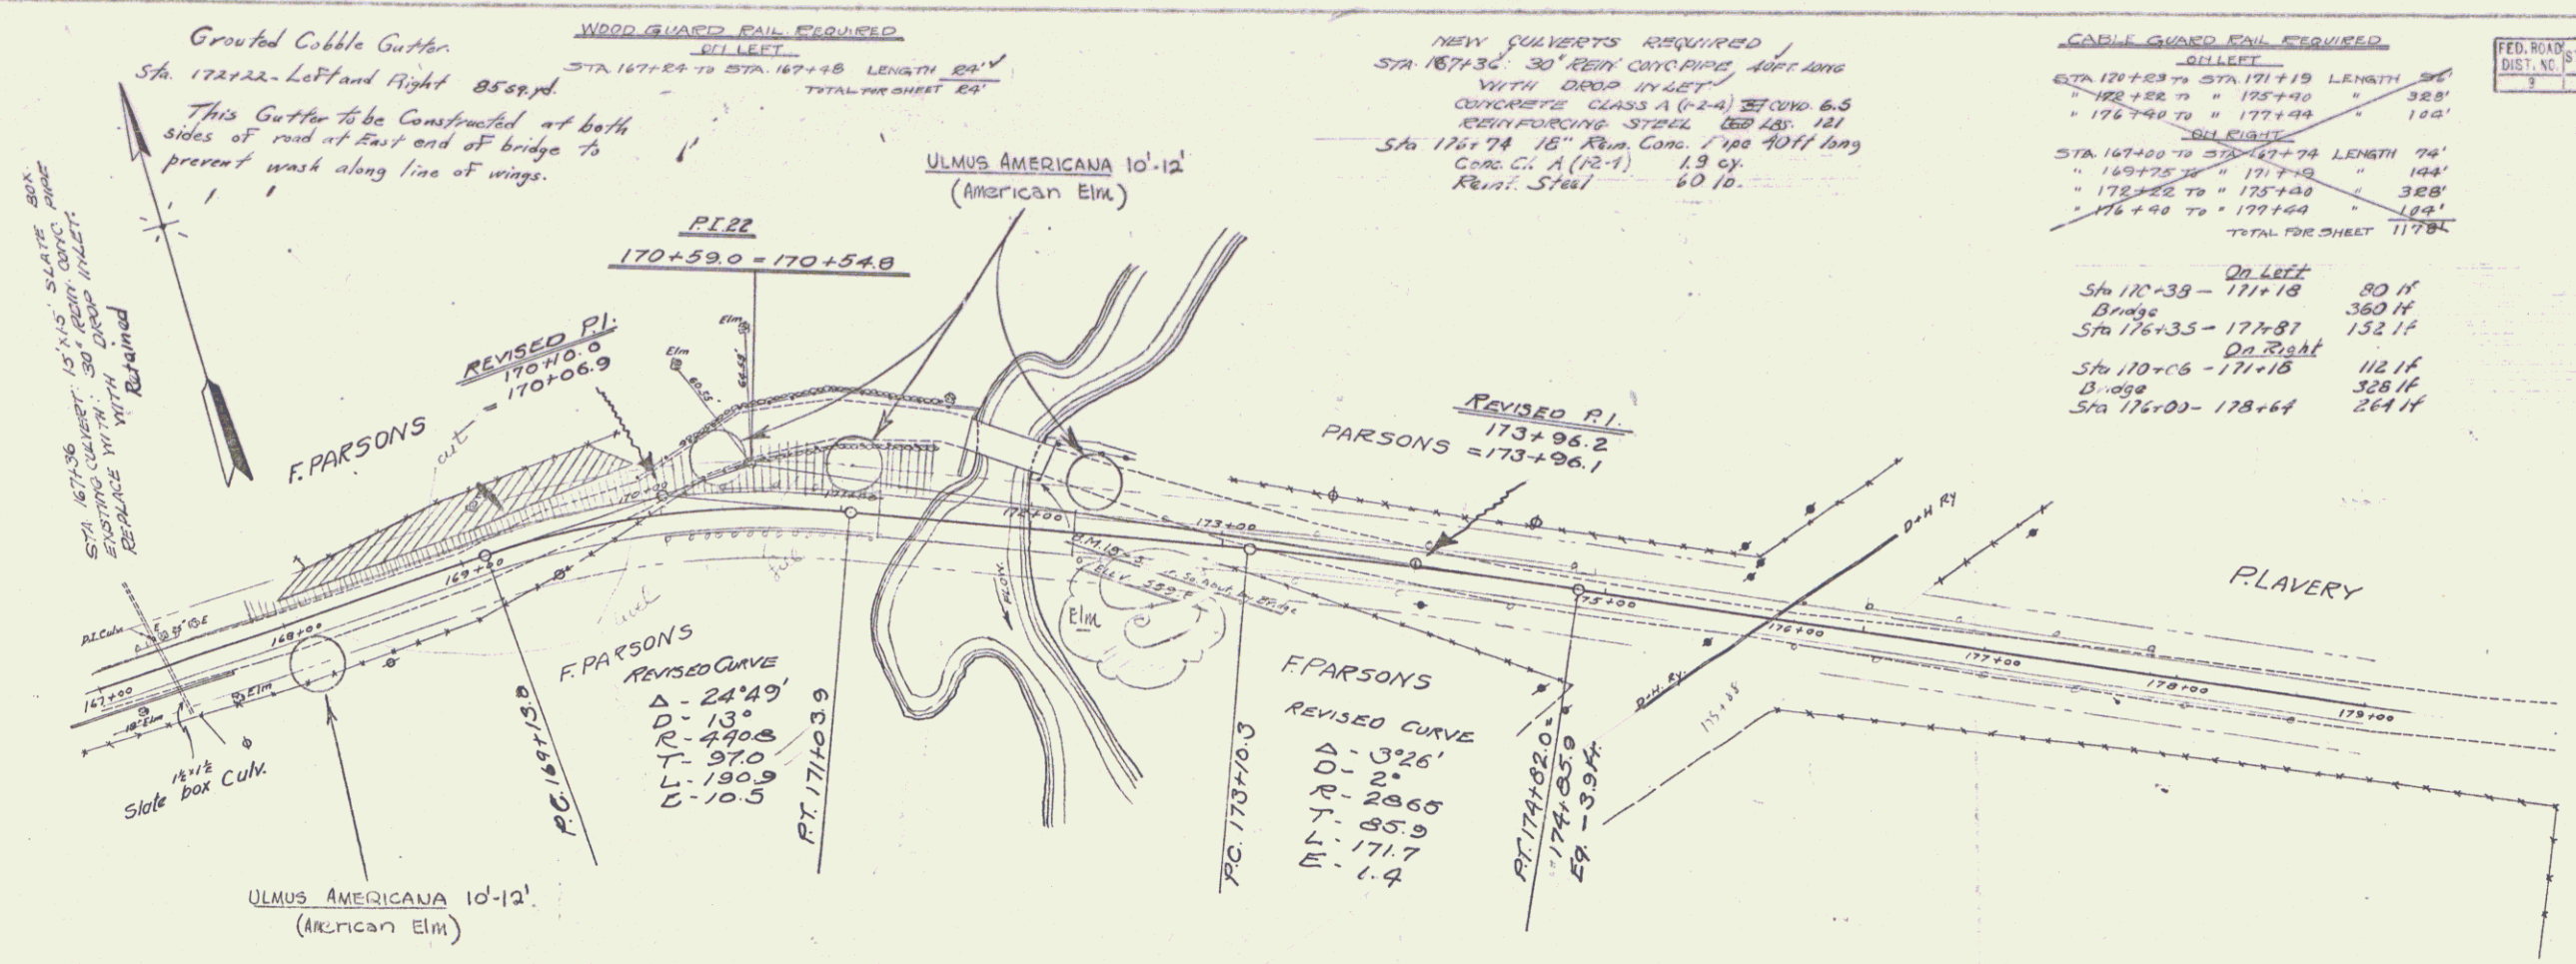

PLAN
DATE
BY
CHECKED
APPROVED

PROFILE
DATE
BY
CHECKED
APPROVED

SERIES NH No. 45-D (LAND-SCAPING)
SHEET 5 OF 10