


PLAN  
 DATE: 1935  
 DRAWN BY: [illegible]  
 CHECKED BY: [illegible]



NEH		SHEET TOTAL	
FD. ROAD	STATE	FED. AID	FISCAL YEAR
1	VT	65.0	1935
		NO.	SHEETS
		4	10
LANDSCAPING			

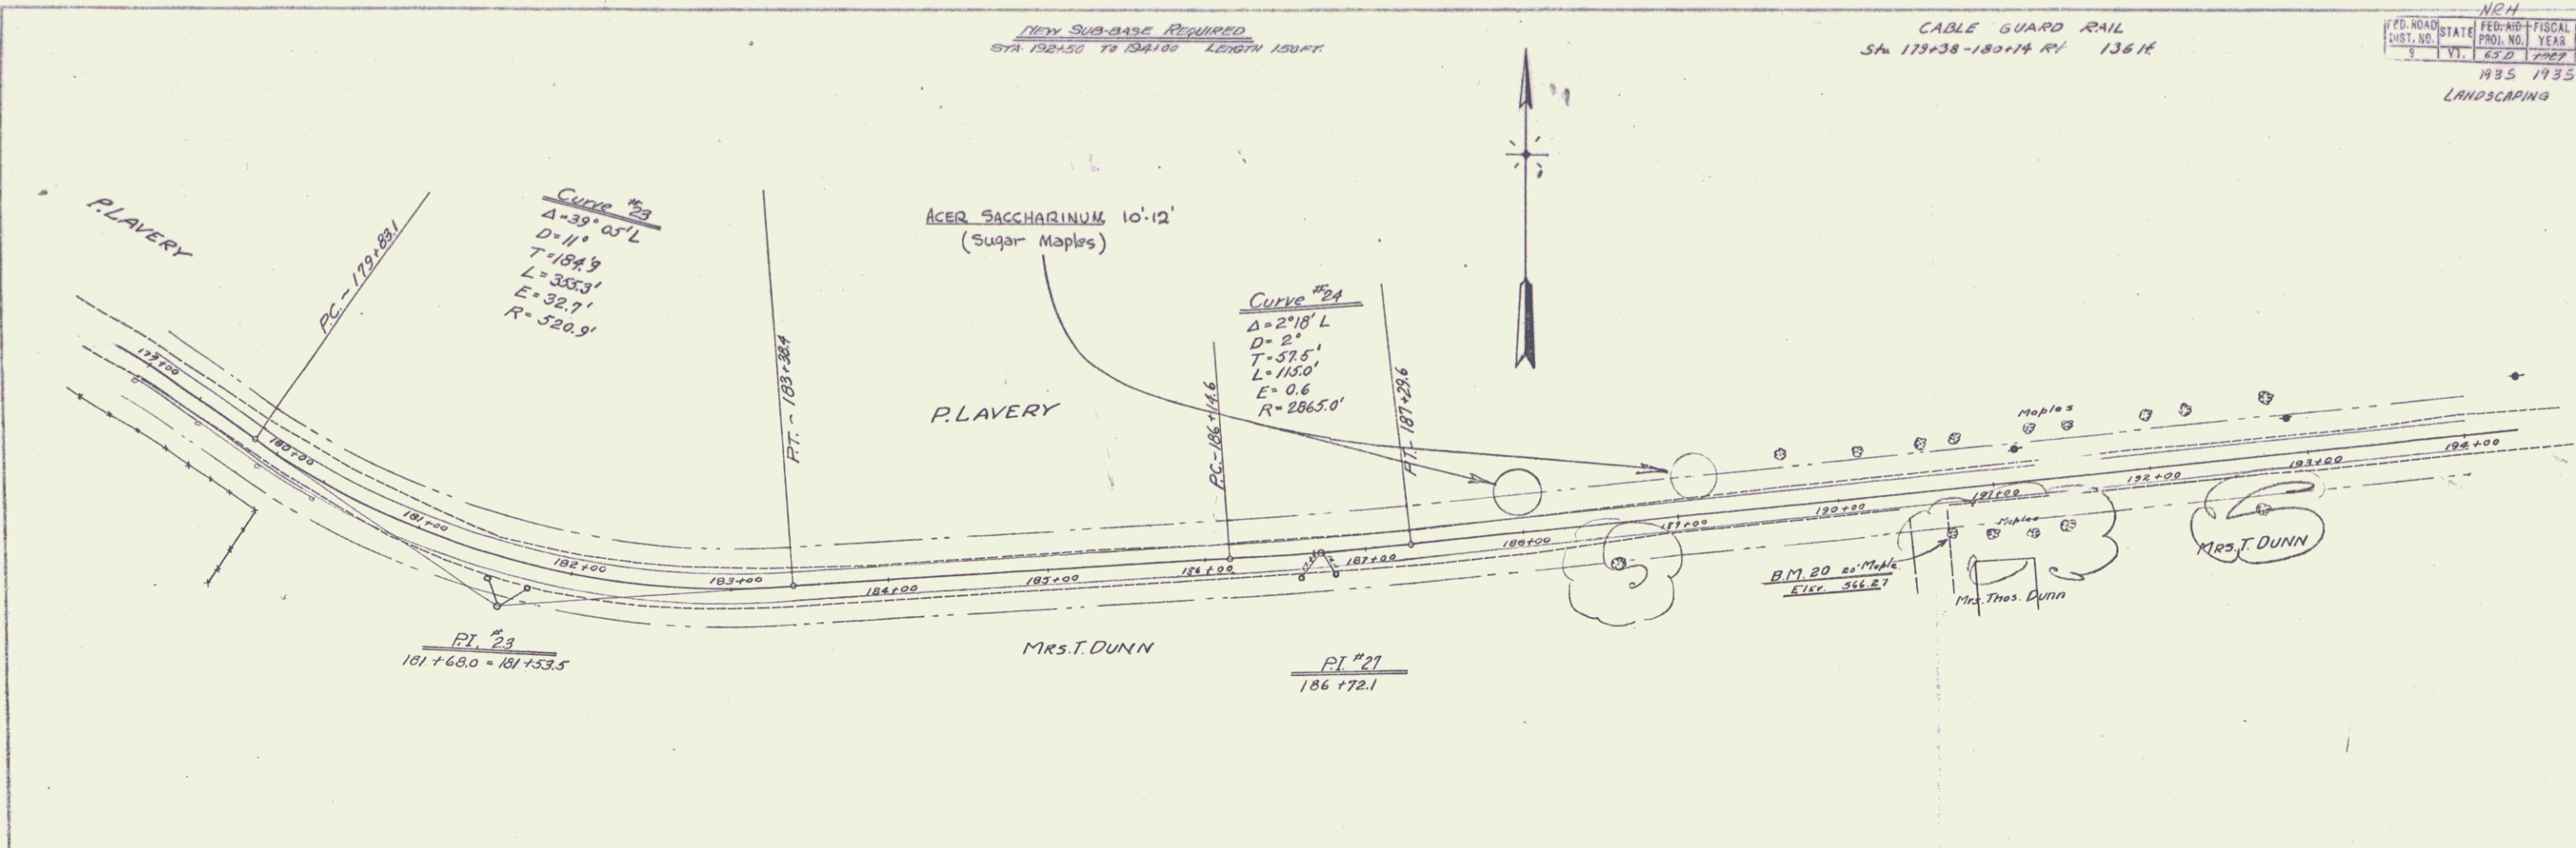