
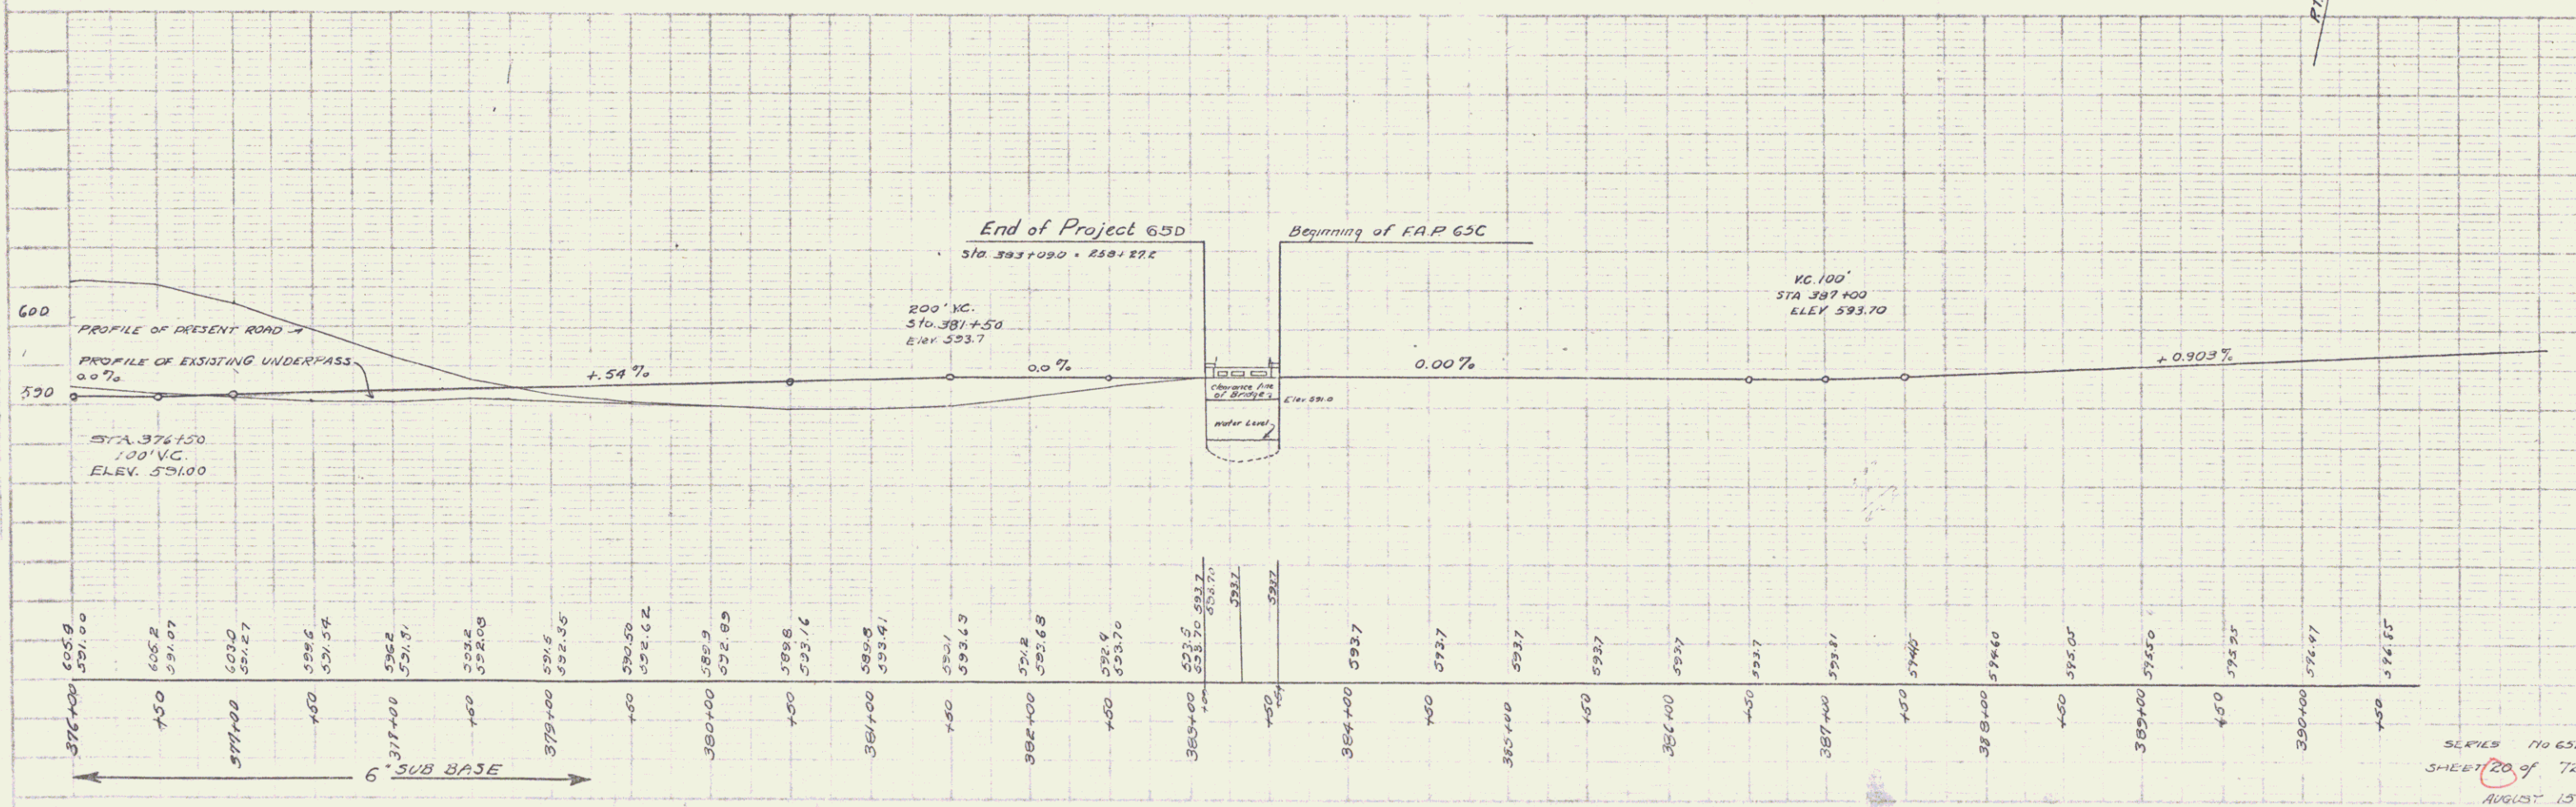


CABLE GUARD RAIL
 Sta 381+01 - 383+084.208 H
 Sta 378+00 - 377+22 Rt 128 H

REV. NO.	DATE	BY	CHKD.	SHEET NO.	TOTAL SHEETS
1	6-5-27	20	72

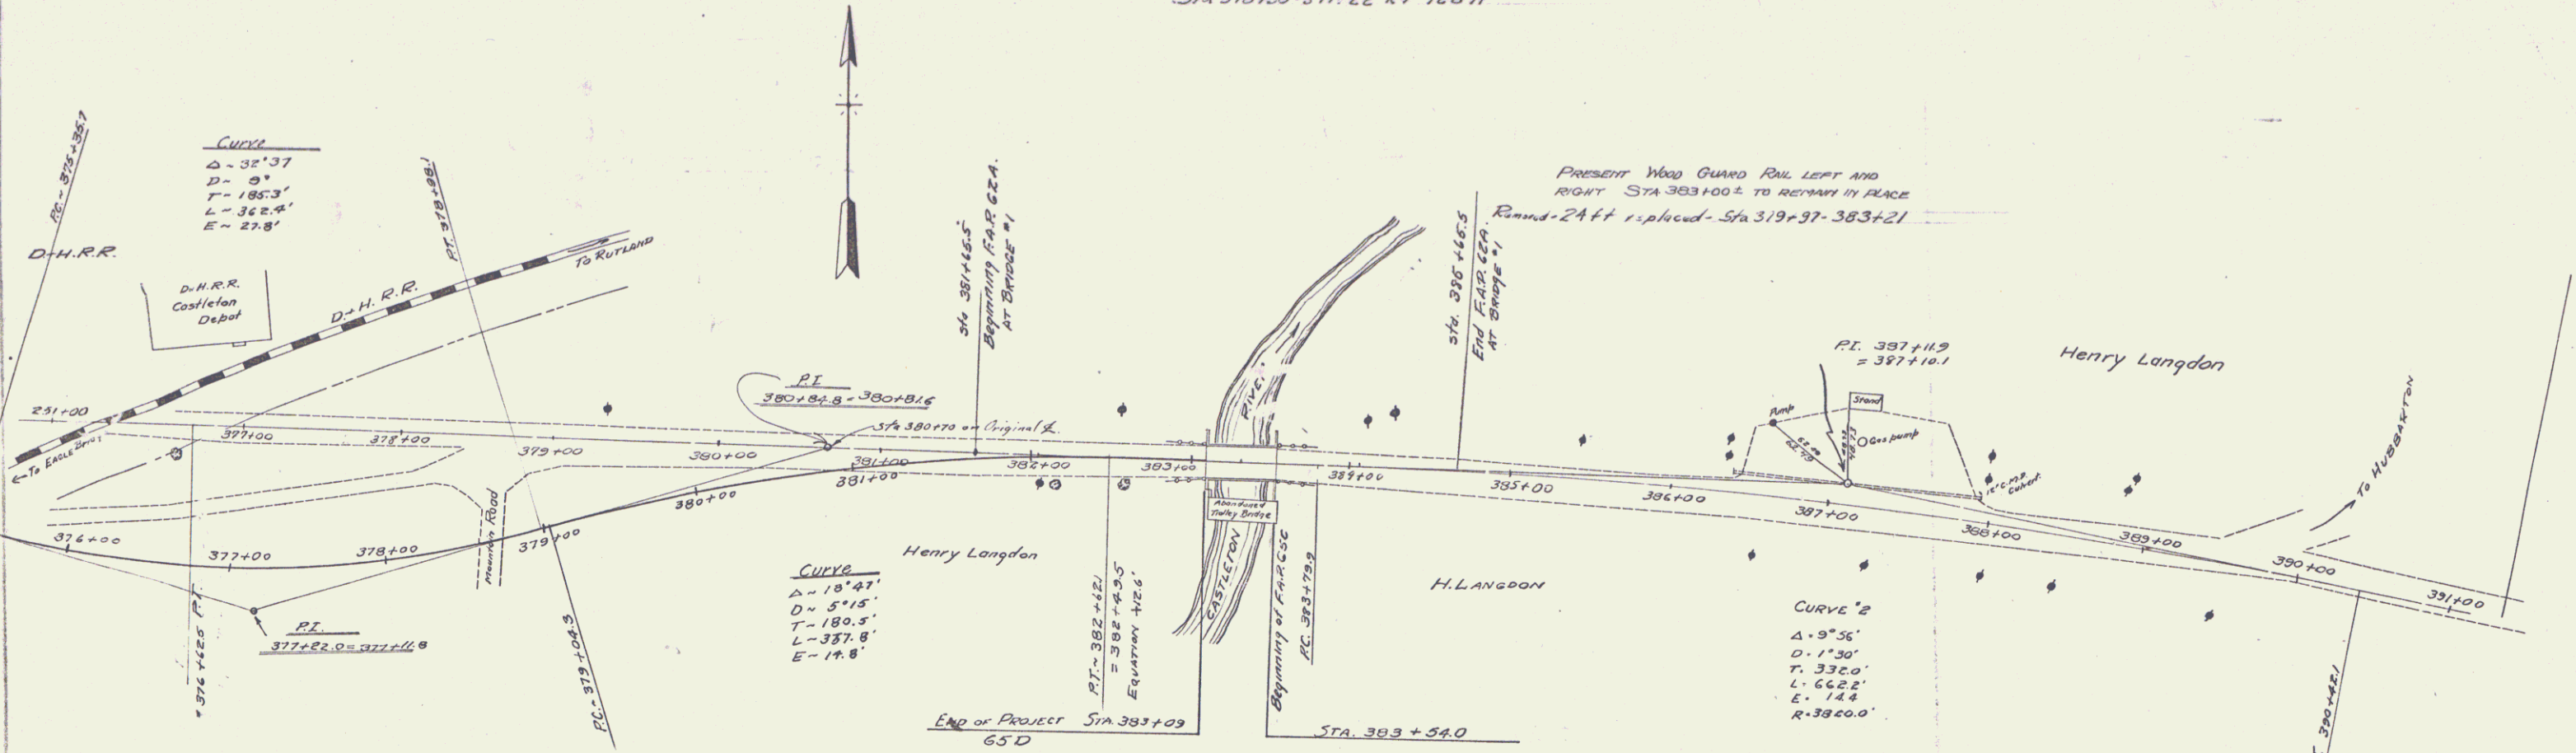

SERIES 710 65D
 SHEET 20 of 72
 AUGUST 15th 1927

A