
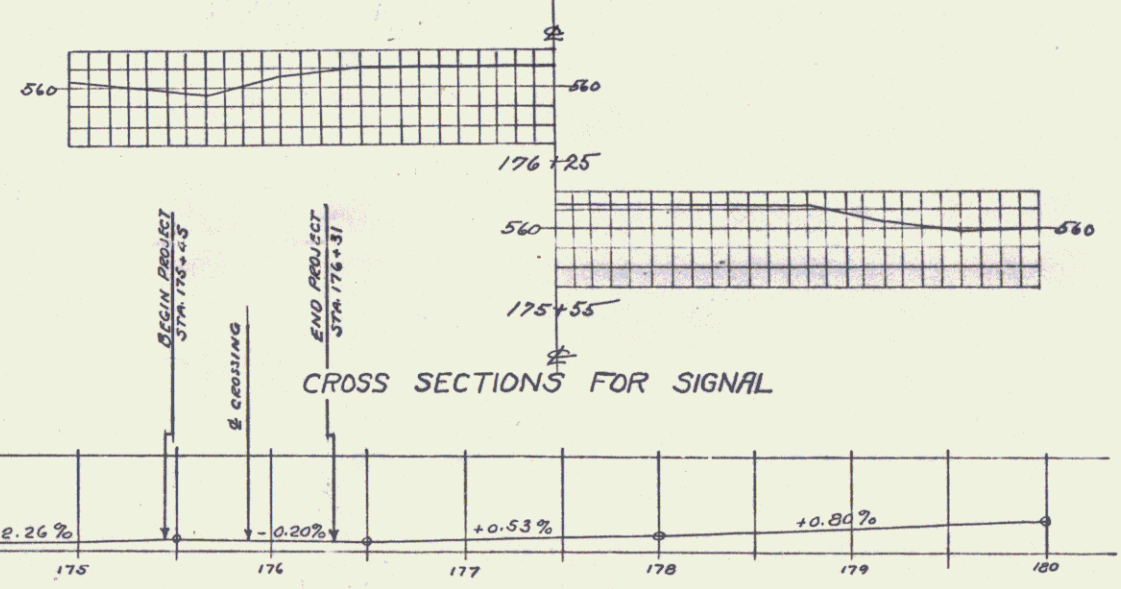


FED. ROAD DIST. NO.	STATE	W.P.G.H. PROJ. NO.	FISCAL YEAR	SHEET NO.	TOTAL SHEETS
65-D	VT.			2	5

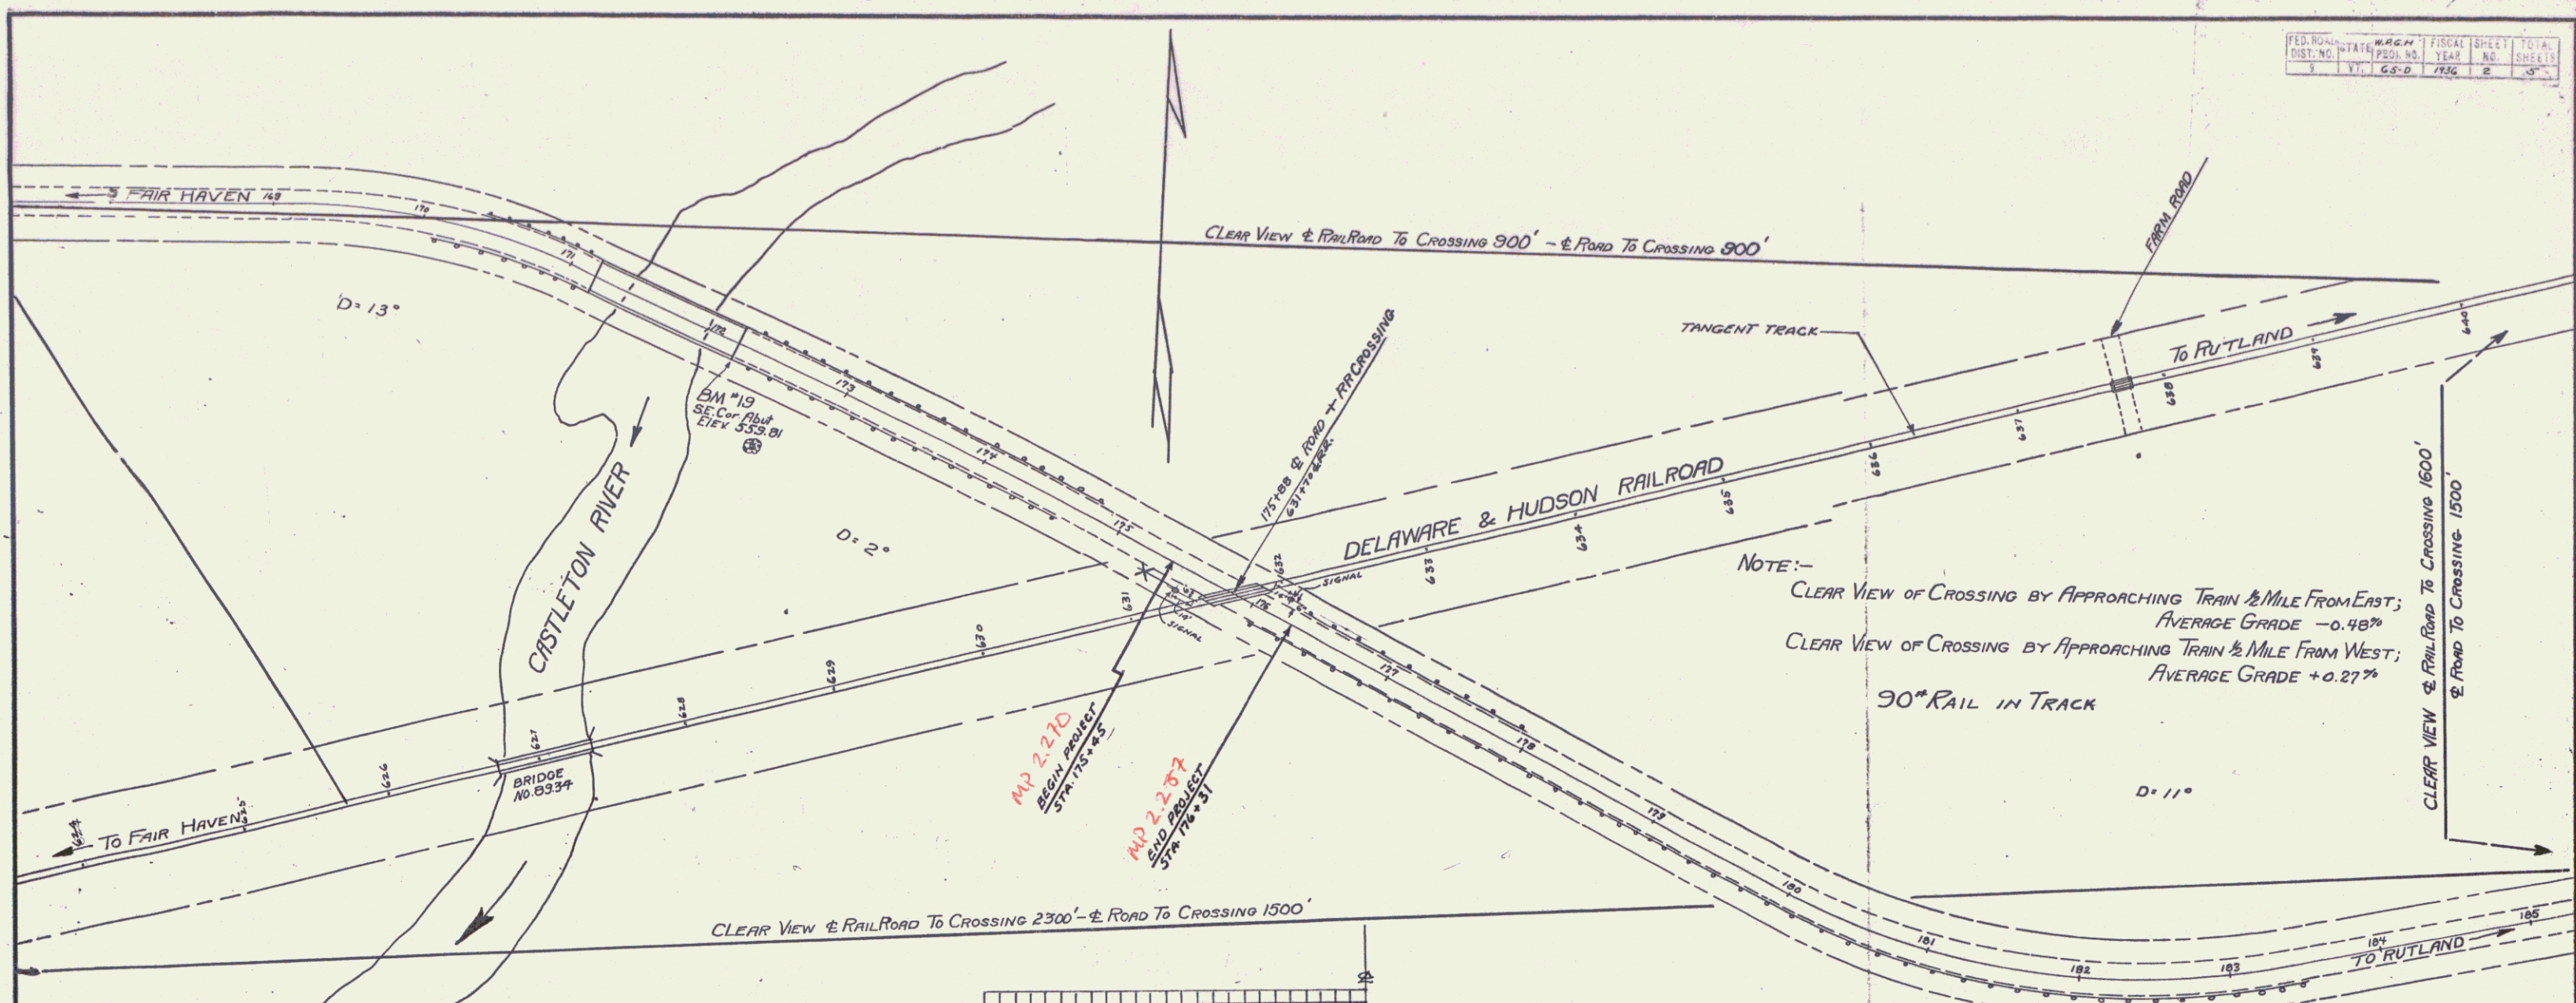

AUTOMATIC FLASH SIGNAL  
 GRADE CROSSING  
 OVER  
 DELAWARE & HUDSON RAILROAD  
 VT. W.P.G.H. 65-D CASTLETON, VT.  
 Scale 1"=50'

ROUTE U.S.4. STA. 175+88, FAP. 65-D

Surveyed by  
 Designed by  
 Drawn by R.W.H.  
 Traced by  
 Checked by  
 Series W.P.G.H. No. 65-D  
 Sheet 2 of 5 Sheets