

INDEX OF SHEETS

- 1. TITLE SHEET
- 2,3,3. TYPICAL CROSS SECTIONS
- 4. ITEM QUANTITY AND DRAINAGE SHEET
- 5. EARTH WORK SHEET
- 6. RIGHT OF WAY DETAIL SHEET
- 7,8,8. PLAN AND PROFILE SHEETS
- 9. DETAILS OF INTERSECTION
- 10. SIGN LOCATION SHEET
- 11. TRAFFIC SIGN AND DELINEATOR SUMMARY SHEET
- 12. TRAFFIC SIGNS - DESIGN AND CONSTRUCTION DETAILS
- 13. STANDARD SHEET A-60 DEC. 21, 1967 R.
- 14. STANDARD SHEET B-1 JULY 17, 1967 R.
- 15. STANDARD SHEET B-5 MAR. 10, 1965
- 16. STANDARD SHEET B-10 MAR. 10, 1965
- 17. STANDARD SHEET B-16 JULY 21, 1967 R.
- 18. STANDARD SHEET C-1 MAY 10, 1968 R.
- 19. STANDARD SHEET D-2 JULY 25, 1967 R.
- 20. STANDARD SHEET D-3 JULY 19, 1967 R.
- 21. STANDARD SHEET D-4 AUG. 1, 1966 R.
- 22. STANDARD SHEET D-6 DEC. 23, 1966
- 23. STANDARD SHEET D-11 MAR. 21, 1967 R.
- 24. STANDARD SHEET E-12 AUG. 28, 1964 R.
- 25. STANDARD SHEET E-15 AUG. 12, 1963 R.
- 26. STANDARD SHEET E-16 DEC. 18, 1964 R.
- 27. STANDARD SHEET E-22 FEB. 18, 1968
- 28. STANDARD SHEET E-23 FEB. 23, 1968
- 29. STANDARD SHEET E-25 FEB. 6, 1968
- 30. STANDARD SHEET E-26 FEB. 6, 1968
- 31. STANDARD SHEET E-31 AUG. 21, 1967 R.
- 32. STANDARD SHEET E-32 JAN. 6, 1967
- 33. STANDARD SHEET G-4 DEC. 30, 1965
- 34. STANDARD SHEET G-5 OCT. 4, 1967 R.
- 35. STANDARD SHEET J-1 MAR. 10, 1965
- 37-44. CROSS SECTION SHEETS
- \* 26-A STANDARD SHEET E-18 DEC. 18, 1964 R.

STATE OF VERMONT  
DEPARTMENT OF HIGHWAYS

PROPOSED IMPROVEMENT

TOWN OF CASTLETON

COUNTY OF RUTLAND


VT ROUTE 4A

CASTLETON-RUTLAND ROAD


BEGINNING AT A POINT 2.993 MILES WESTERLY OF THE CASTLETON-IRA TOWN LINE AND EXTENDING EASTERLY 0.208 MILE

LENGTH OF PROJECT 11000 FEET-0.208 MILE

1968 ADT = 1600  
1968 ADT = 2700  
1968 DHV = 380  
D = 58%  
T = 8%  
V = 80

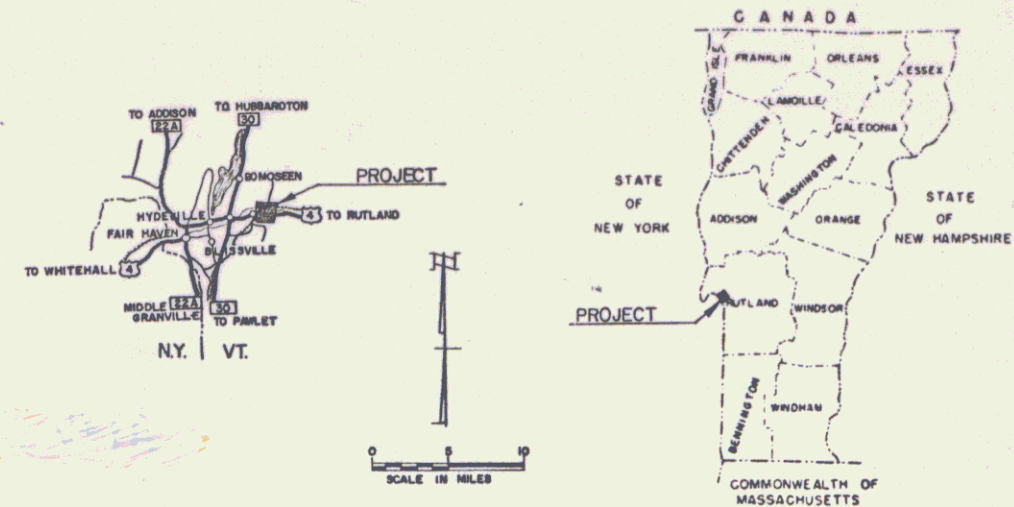

RIGHT-OF-WAY DIVISION  
TOWN FILE  
PERPETUAL  
Rte. of VT 4A  
Town of CASTLETON  
(To Be Returned To R.O.W. Division)

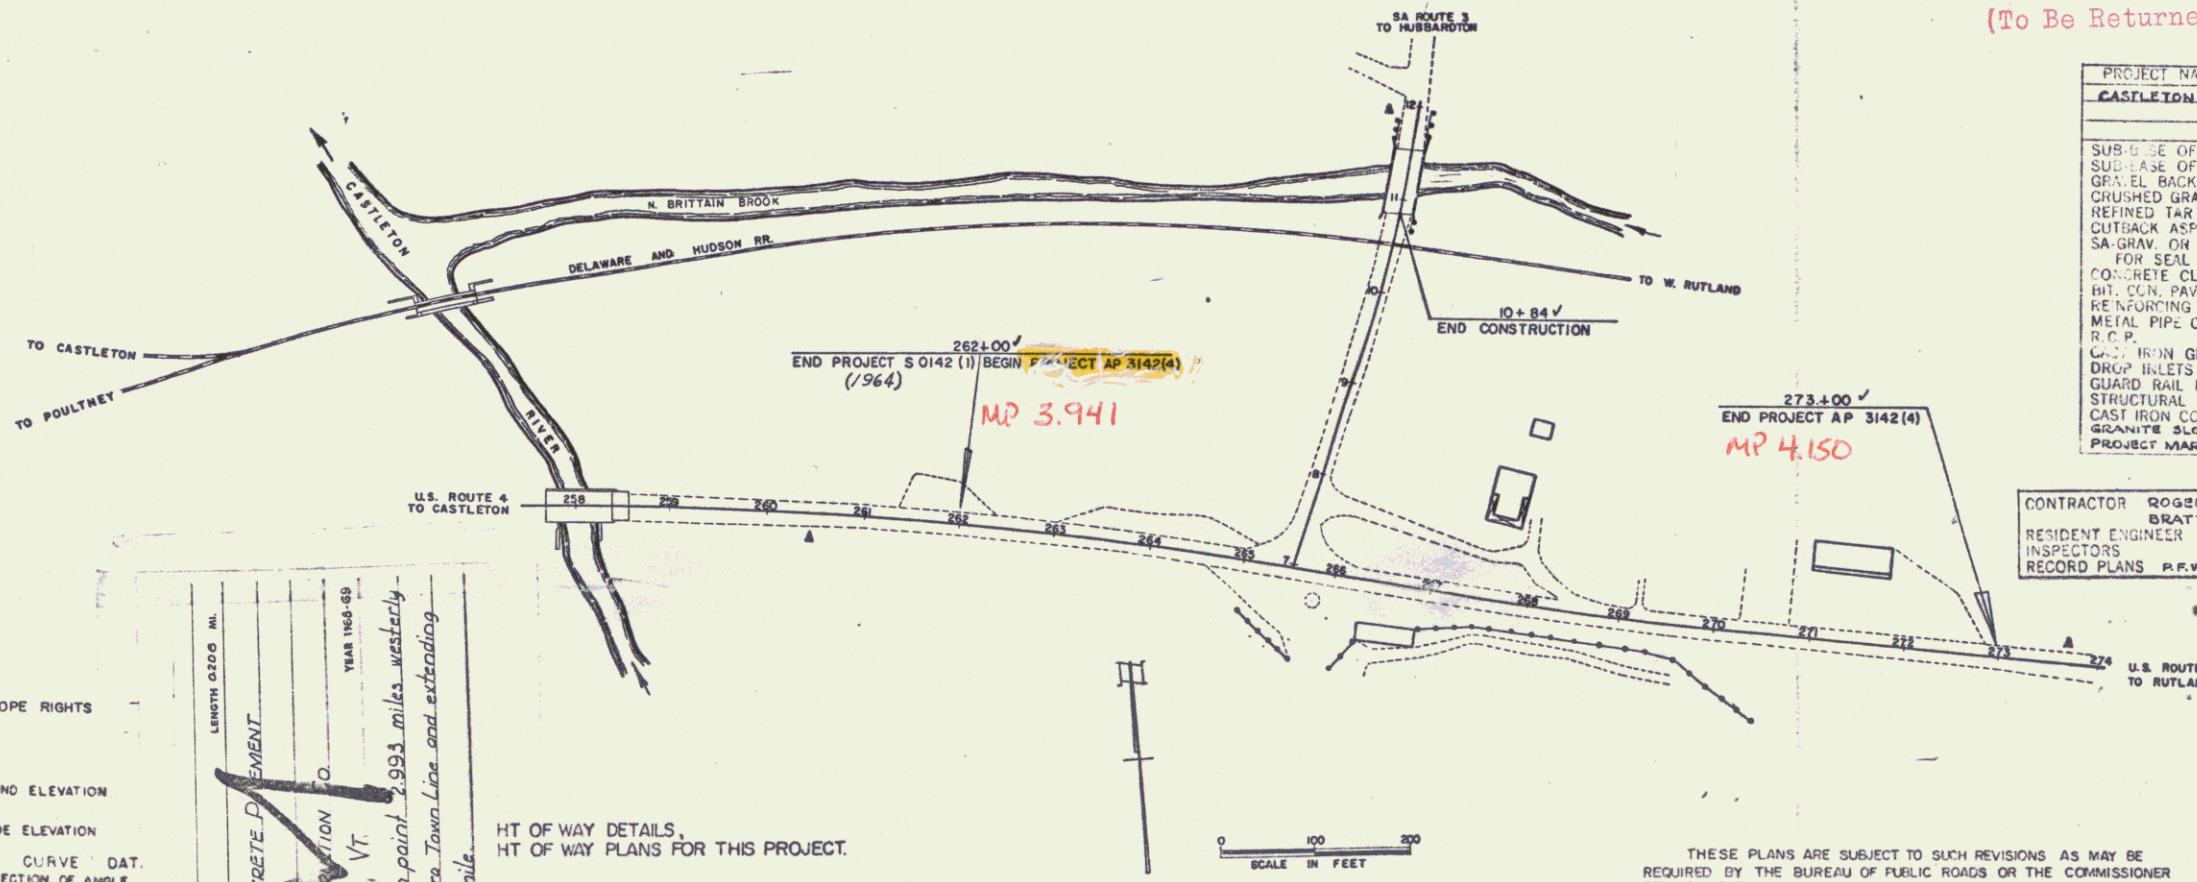

PROJECT NAME & NUMBER	TYPE PAVEMENT	AREA SQ.
CASTLETON AP 3142(4)	BITUMINOUS CONCRETE	52,800
RECORD PLANS		
MATERIALS		
SUB-BASE OF GRAVEL - CAROLINA PIT, CASTLETON, VT.		
SUB-BASE OF SAND - NONE USED		
GRAVEL BACKFILL - CRUSHED GRAVEL		
REFINED TAR		
OUTBACK ASPHALT - ALLSTATES ASPHALT, INC., SANDERLAND, MASS.		
S.A. GRAV. OR PEASTONE		
FOR SEAL		
CONCRETE CLASS		
BIT. CON. PAVEMENT - VERMONT PAVING CORP., WALLINGFORD, VT.		
REINFORCING STEEL - J.P. CARROLL PLANT, CLARENDON, VT.		
METAL PIPE CULVERT - NORTHEASTERN CULV. CORP., R.F.P.		
C.I. IRON GRATE		
DRAIN INLETS		
GUARD RAIL, ETC. IS S.T. GRISWOLD & CO., INC., WILLISTON, VT.		
STRUCTURAL STEEL		
CAST IRON COVER FOR F.B. - NONE USED		
GRANITE SLOPE BUSHING - BARKETTS GRANITE CORP., MILFORD, N.H. (GRISWOLD)		
PROJECT MARKERS - HUME PIPE OF N.E., INC., WINDSOR, VT.		

CONTRACTOR	ROGERS CONSTRUCTION CO.	CONTRACT DATED	OCT. 19, 1968
RESIDENT ENGINEER	BRATTLEBORO, VT.	STARTED	OCT. 18, 1968
INSPECTORS	E.M. GIBSON	COMPLETED	JUNE 6, 1969
RECORD PLANS	R.F.W. 10/18/68	ACCEPTED	JUNE 6, 1969

CONVENTIONAL SIGNS

POINT OF ACCESS	X
LIMITS OF ACCESS	---
COUNTY LINE	---
TOWN LINE	---
FENCE LINE	---
STONE WALL	---
UNFENCED PROPERTY	---
GUARD RAIL	---
TRAVELED WAY	---
RAILROAD	---
RETAINING WALL	---
CENTER LINE	---
SURVEY LINE	---
CULVERT	---
DROP INLET	---
TROLLEY POLE	---
POWER POLE	---
TELEPHONE POLE	---
TREES	---
HEDGE	---
F.A. CONSTRUCTION IDENTIFICATION SIGNS	A

SLOPE RIGHTS

GROUND ELEVATION

GRADE ELEVATION

CURVE DAT.

DEFLECTION OF ANGLE

DEGREE OF CURVE

RADIUS OF CURVE

TANGENT DISTANCE

LENGTH OF CURVE

EXTERNAL DISTANCE

POINT OF INTERSECTION

POINT OF CURVE

POINT OF TANGENT


POINT ON TANGENT

POINT ON SUB-TANGENT

ROW LIMITS

PROJECT: CASTLETON  
NUMBER: AP 3142(4)  
TYPE: BITUMINOUS CONCRETE PAVEMENT  
YEAR: 1968-69  
CONTRACTOR: ROGERS CONSTRUCTION CO.  
LOCATION: BRATTLEBORO, VT.  
LOCATION: Beginning at a point 2.993 miles westerly of the Castleton-Ira Town Line and extending easterly 0.208 mile.

HT OF WAY DETAILS  
HT OF WAY PLANS FOR THIS PROJECT.

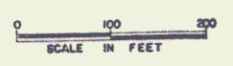

THESE PLANS ARE SUBJECT TO SUCH REVISIONS AS MAY BE REQUIRED BY THE BUREAU OF PUBLIC ROADS OR THE COMMISSIONER OF HIGHWAYS.

CONSTRUCTION IS TO BE CARRIED ON IN ACCORDANCE WITH THESE PLANS AND THE STANDARD SPECIFICATIONS FOR HIGHWAY AND BRIDGE CONSTRUCTION DATED APRIL 1964, AS APPROVED BY THE BUREAU OF PUBLIC ROADS ON OCTOBER 12, 1964, INCLUDING ALL SUBSEQUENT APPROVED REVISIONS AND SUCH REVISED SPECIFICATIONS AND SPECIAL PROVISIONS AS ARE INCORPORATED IN THESE PLANS.

NOTE: ANY FURTHER INFORMATION CONCERNING FINAL QUANTITIES, AMOUNTS OR OTHER DETAILS RELATIVE TO THIS PROJECT MAY BE FOUND IN EITHER THE FIELD BOOKS OR THE ESTIMATE FILE.

DEPARTMENT OF TRANSPORTATION  
BUREAU OF PUBLIC ROADS

APPROVED	J. A. Nuske	APPROVED	R. J. Hunt	APPROVED	BRIDGE ENGINEER	APPROVED	L. M. Lane	APPROVED	E. W. Stebbins	APPROVED	R. J. C. [Signature]
DATE	7/7/67	DATE	7/6/67	DATE		DATE	7/6/67	DATE	7/7/67	DATE	7/7/67

APPROVED

DIVISION ENGINEER DATE

PROJECT AP NO 3142(4)

SHEET 1 OF 44 SHEETS