

STATE OF VERMONT  
AGENCY OF TRANSPORTATION



R.O.W. PLANS



DETAIL

PROPOSED IMPROVEMENT

TOWN OF BURKE  
COUNTY OF CALEDONIA  
VT. RTE. 5A

CRITICAL AREA TREATMENT  
NORTHERN VERMONT R C & D

PARCEL NO.	GRANTOR	BEGINNING STATION	ENDING STATION	TAKING	REM.	RIGHTS	FILE TAKEN	DATE	TOWN OR CITY RECORDED	BK	PG.	REMARKS
1	TOWN OF BURKE	BL10+52 LT BL10+68 LT	BL13+98 LT BL13+98 LT			CONST. EASE (T) (0.14 A) CHANNEL (P) (0.18 A)	0.02	7-16-94	BURKE	45	205	
2	MCDOWELL, DALE & NANCY	BL13+98 LT BL13+98 LT	BL15+88 LT BL15+88 LT			CONST. EASE (T) (0.10 A) CHANNEL (P) (0.09 A)	OPTION	9-12-94	BURKE	45	400-02	(4000 S.F.)
3	VILLAGE OF LYNDON ELECTRIC DEPT.											UTILITY
4	NEW ENGLAND TELEPHONE & TELEGRAPH CO.											UTILITY

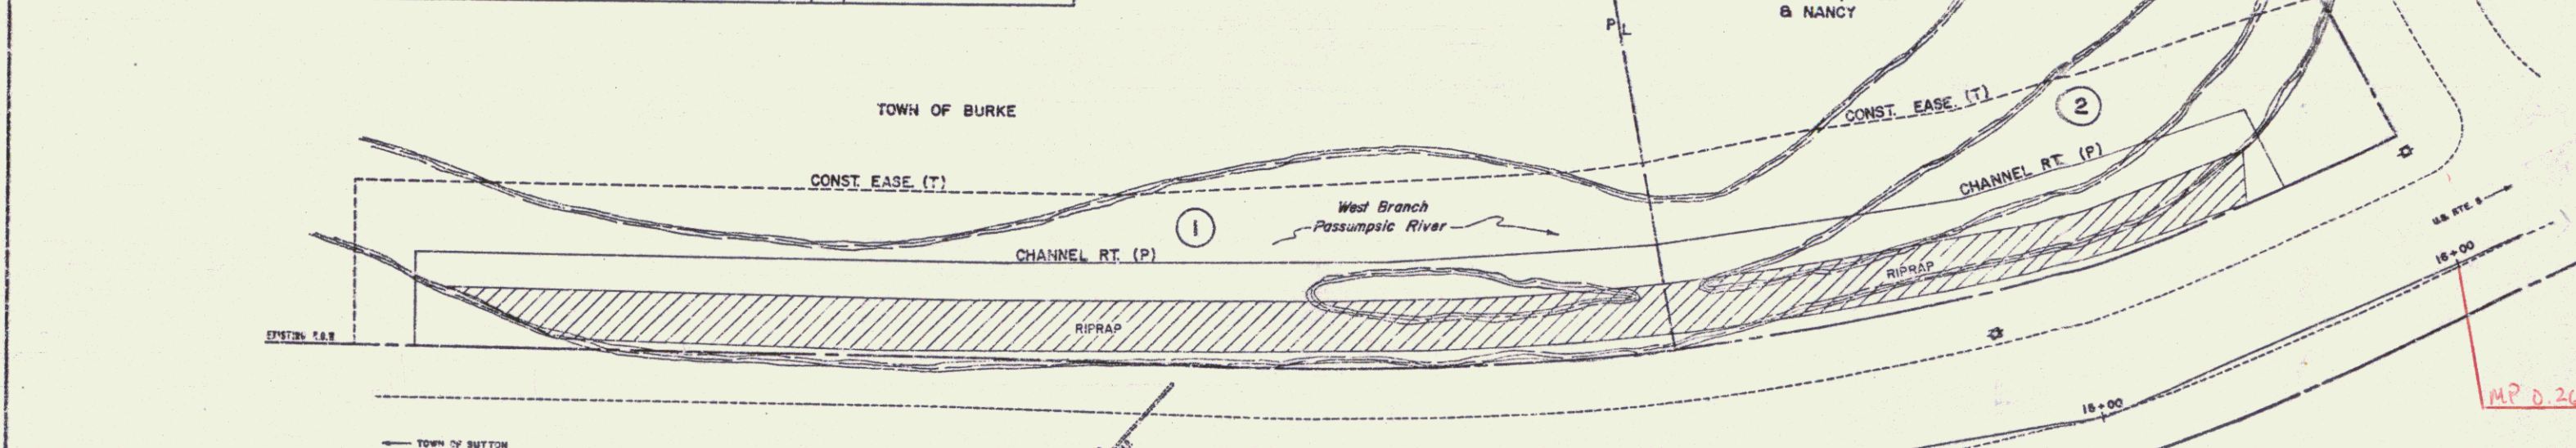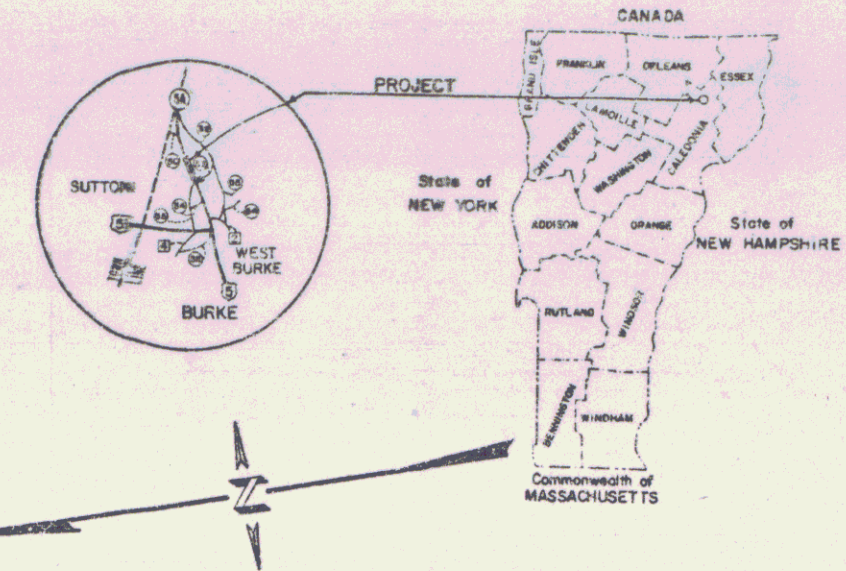


- CONVENTIONAL SIGNS
- COUNTY LINE
  - TOWN LINE
  - LIMITS OF ACCESS
  - POINT OF ACCESS
  - FENCE LINE
  - STONE WALL
  - TRAVELED HWY
  - GUARD RAIL
  - RAILROAD
  - SURVEY LINE
  - CULVERT
  - POWER POLE
  - TELEPHONE POLE
  - TREES
  - CONTROL OF ACCESS
  - PROPERTY LINE
  - ROW TAKING LINE
  - SLOPE RIGHTS
  - TOP OF CUT
  - TOE OF SLOPE

DATUM

VERTICAL \_\_\_\_\_

HORIZONTAL \_\_\_\_\_

NO.	REVISION DESCRIPTION	APPROVED

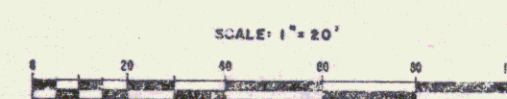

RIGHT-OF-WAY DIVISION  
TOWN FILE  
PERPETUAL

Town of \_\_\_\_\_  
(To Be Returned To R.O.W. Division)  
These plans are subject to such engineering changes as may be required by the Federal Highway Administration or the Director of Engineering and Construction.  
Construction is to be carried on in accordance with these plans and the Standard Specifications for Highway and Bridge Construction dated March, 1976, as approved by the Federal Highway Administration on October 27, 1976 for use on this project, including all subsequent revisions and such revised specifications and special provisions as are incorporated in these plans.

Pin # 99R754

VT. DEPARTMENT OF AGRICULTURE SOIL CONSERVATION SERVICE  
APPROVED \_\_\_\_\_ DATE 4-2-94  
TITLE: State Conservation Engineer  
SUBMITTED BY ORDER OF THE STATE TRANSPORTATION BOARD  
APPROVED S.J. GAGG PE DATE 4-2-94  
DIRECTOR OF ENGINEERING AND CONSTRUCTION  
SEP 23 1986  
APPROVED \_\_\_\_\_ DATE 1-2-77  
CHIEF PROPERTY ADMINISTRATION  
PROJECT WEST BURKE  
No. MA 3428  
SHEET 1 OF 1