


PLAN  
 DRAWN BY  
 CHECKED BY  
 DATE  
 1944

PROFILE  
 DRAWN BY  
 CHECKED BY  
 DATE

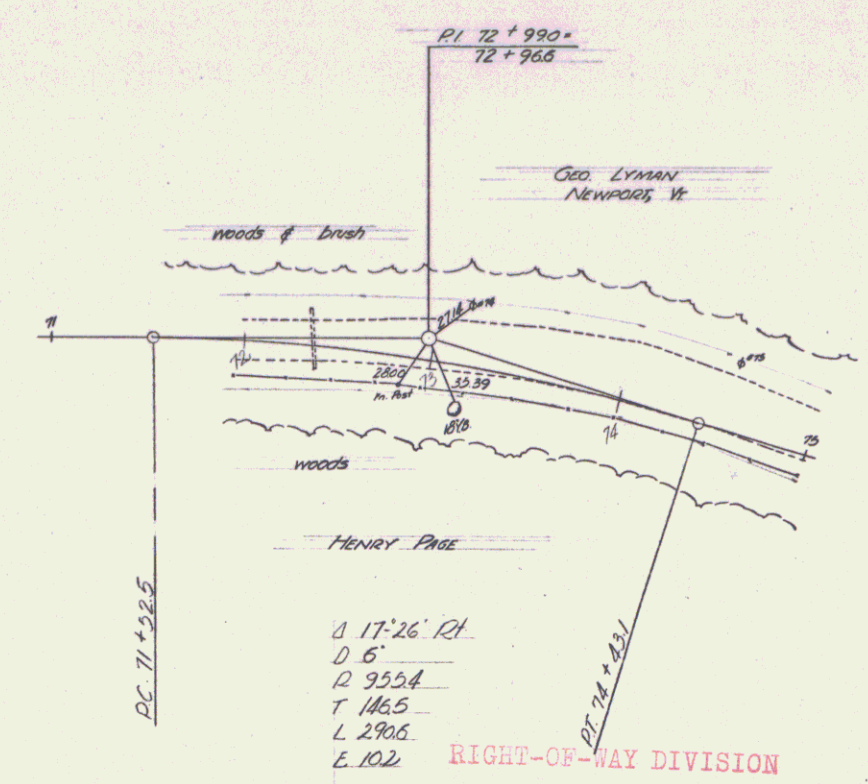

RIGHT-OF-WAY DIVISION  
 TOWN FILE  
 PERPETUAL  
 Town of UT 5A

(As Returned To R.O.W. Division)

SUTTON  
 SERIES 56-100 NO 95-111  
 SHEET 4 OF 5