
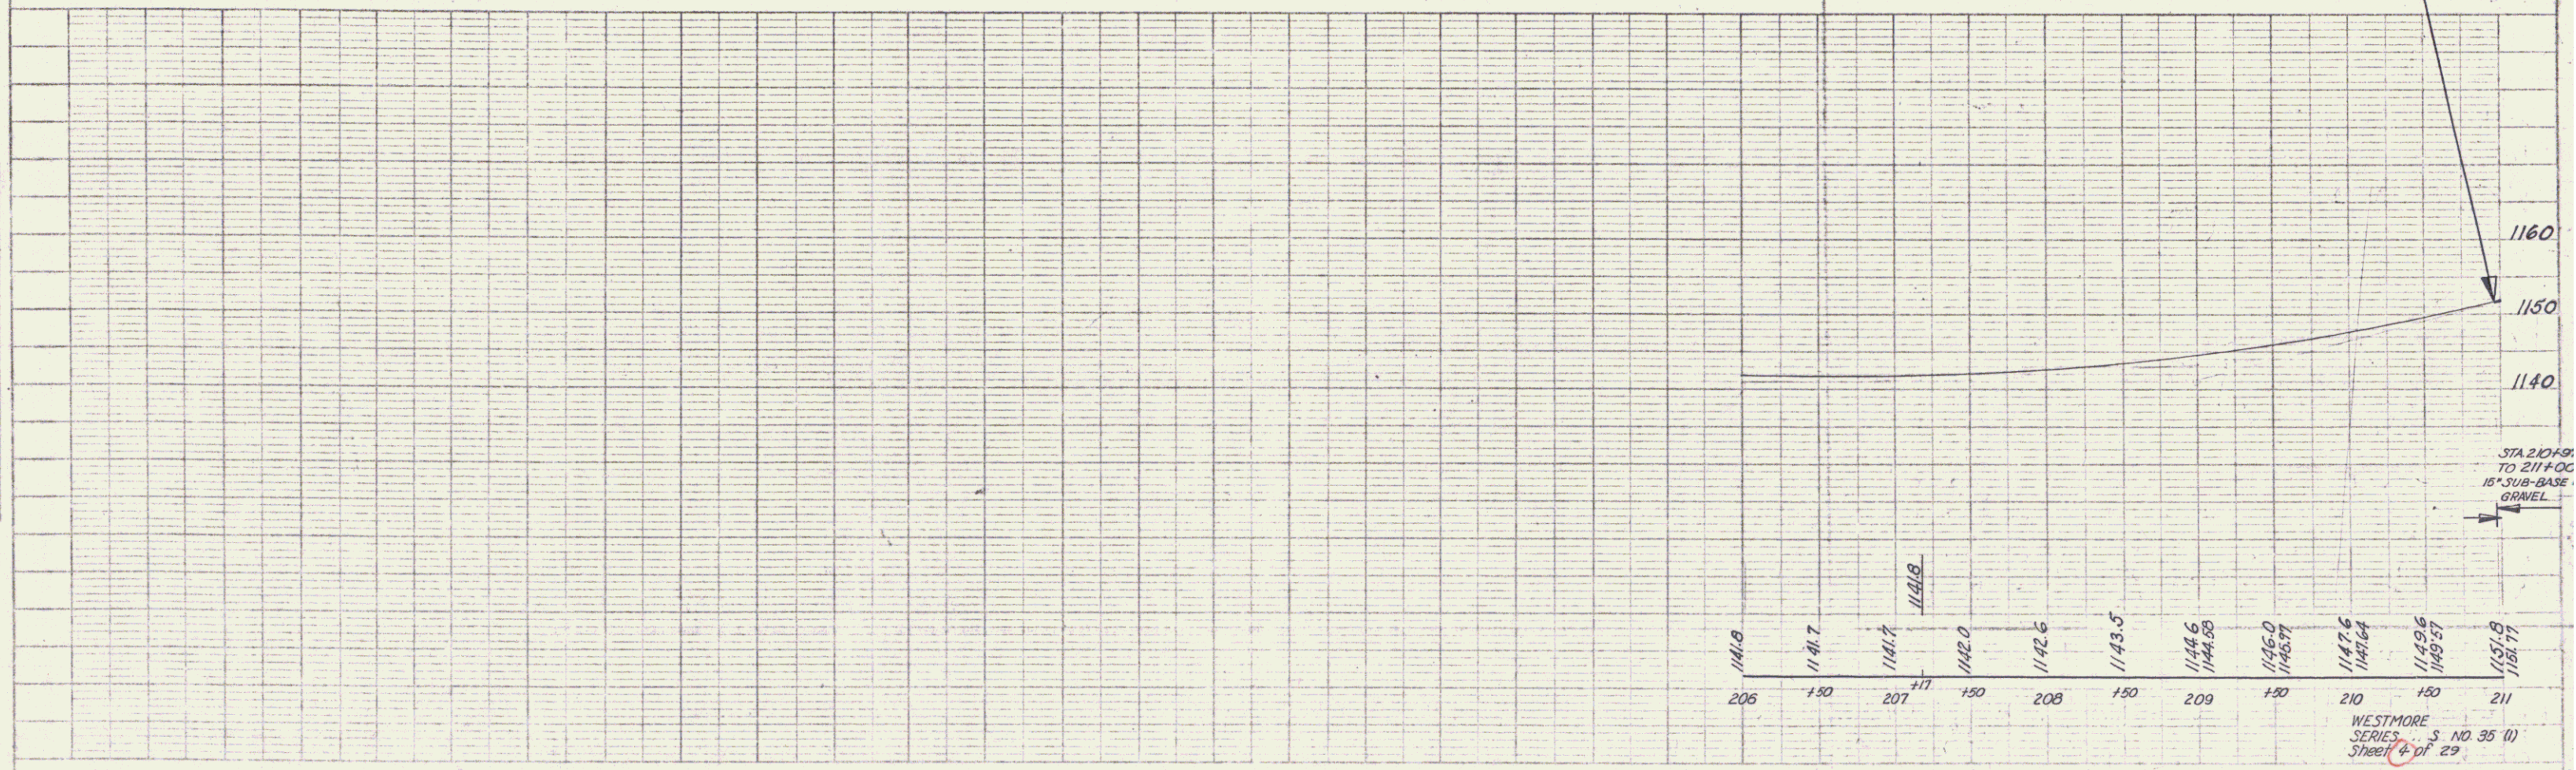


PLAN
 CLARK
 DATE BOOK
 NO.

PROFILE
 DATE BOOK
 NO.

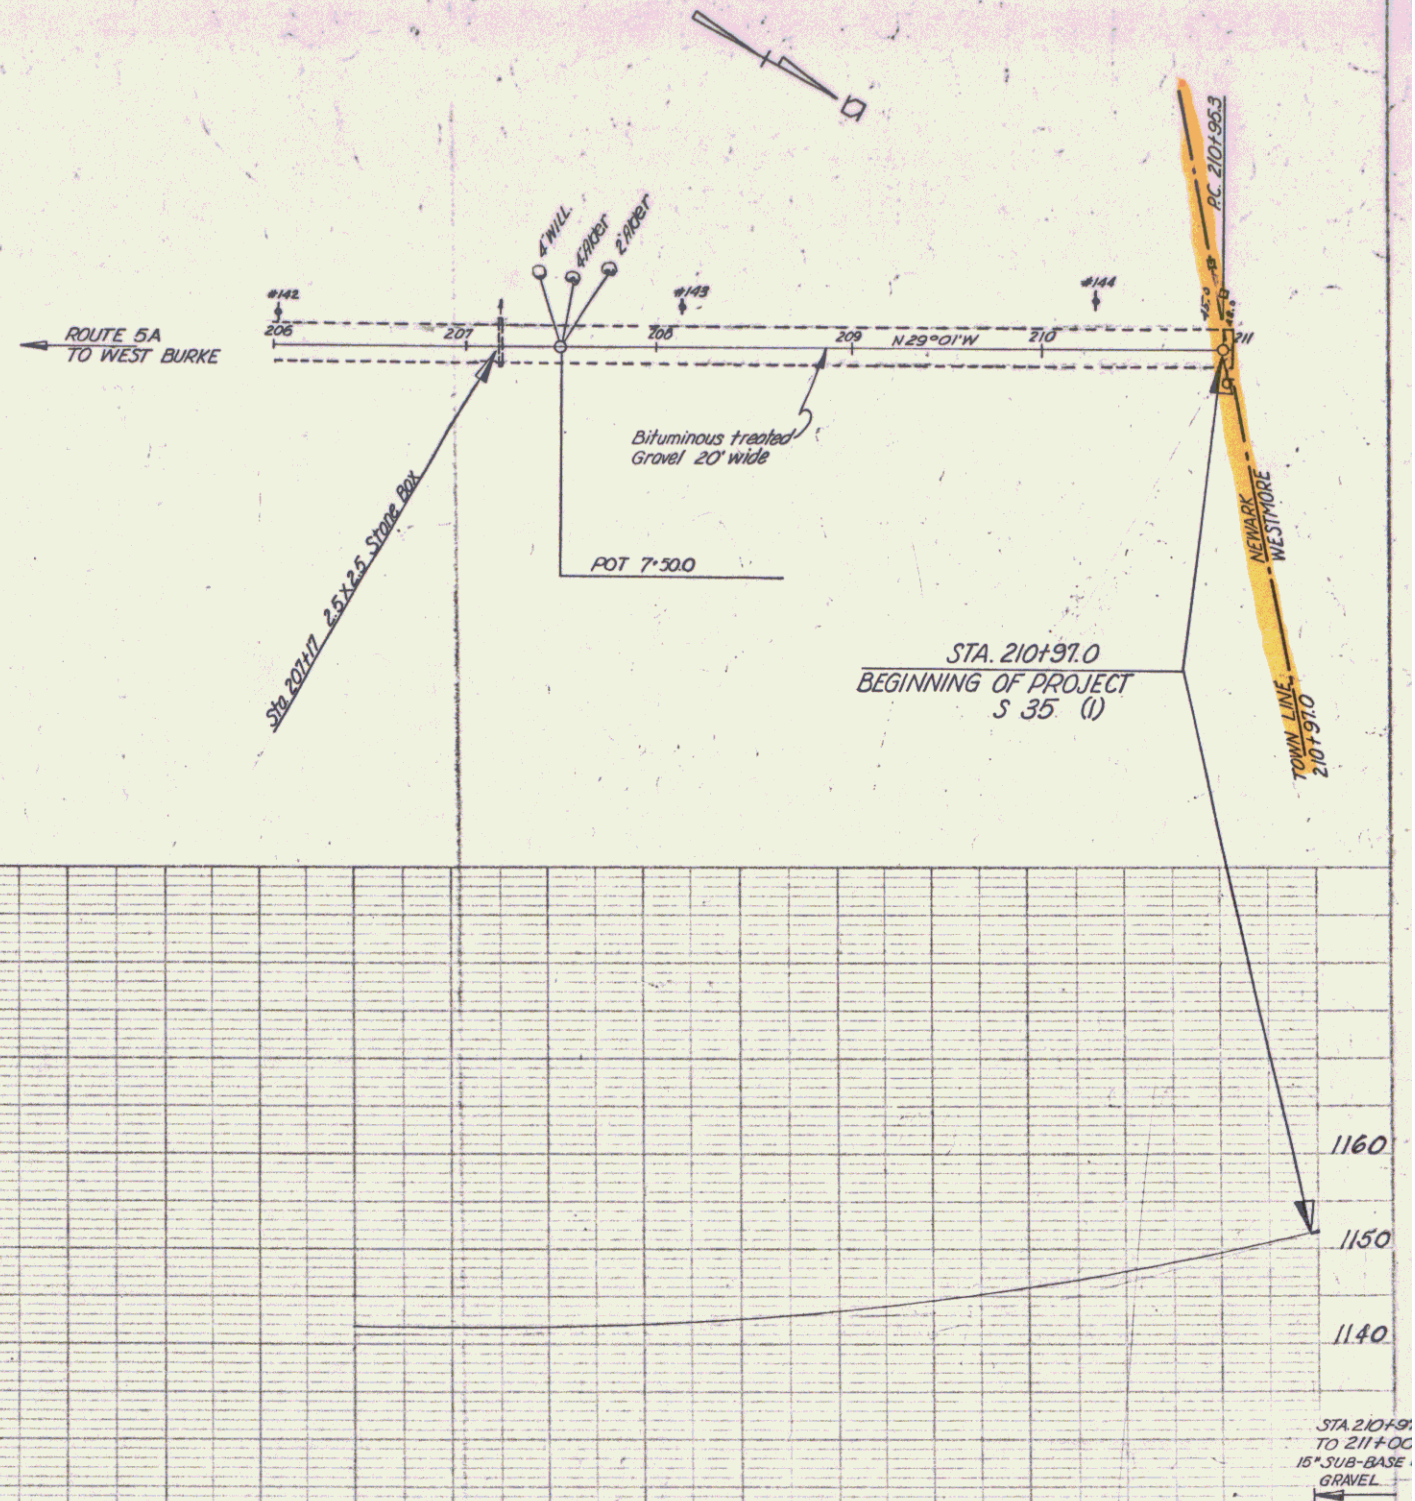

WESTMORE
 SERIES S NO. 35 (1)
 SHEET 4 OF 29