
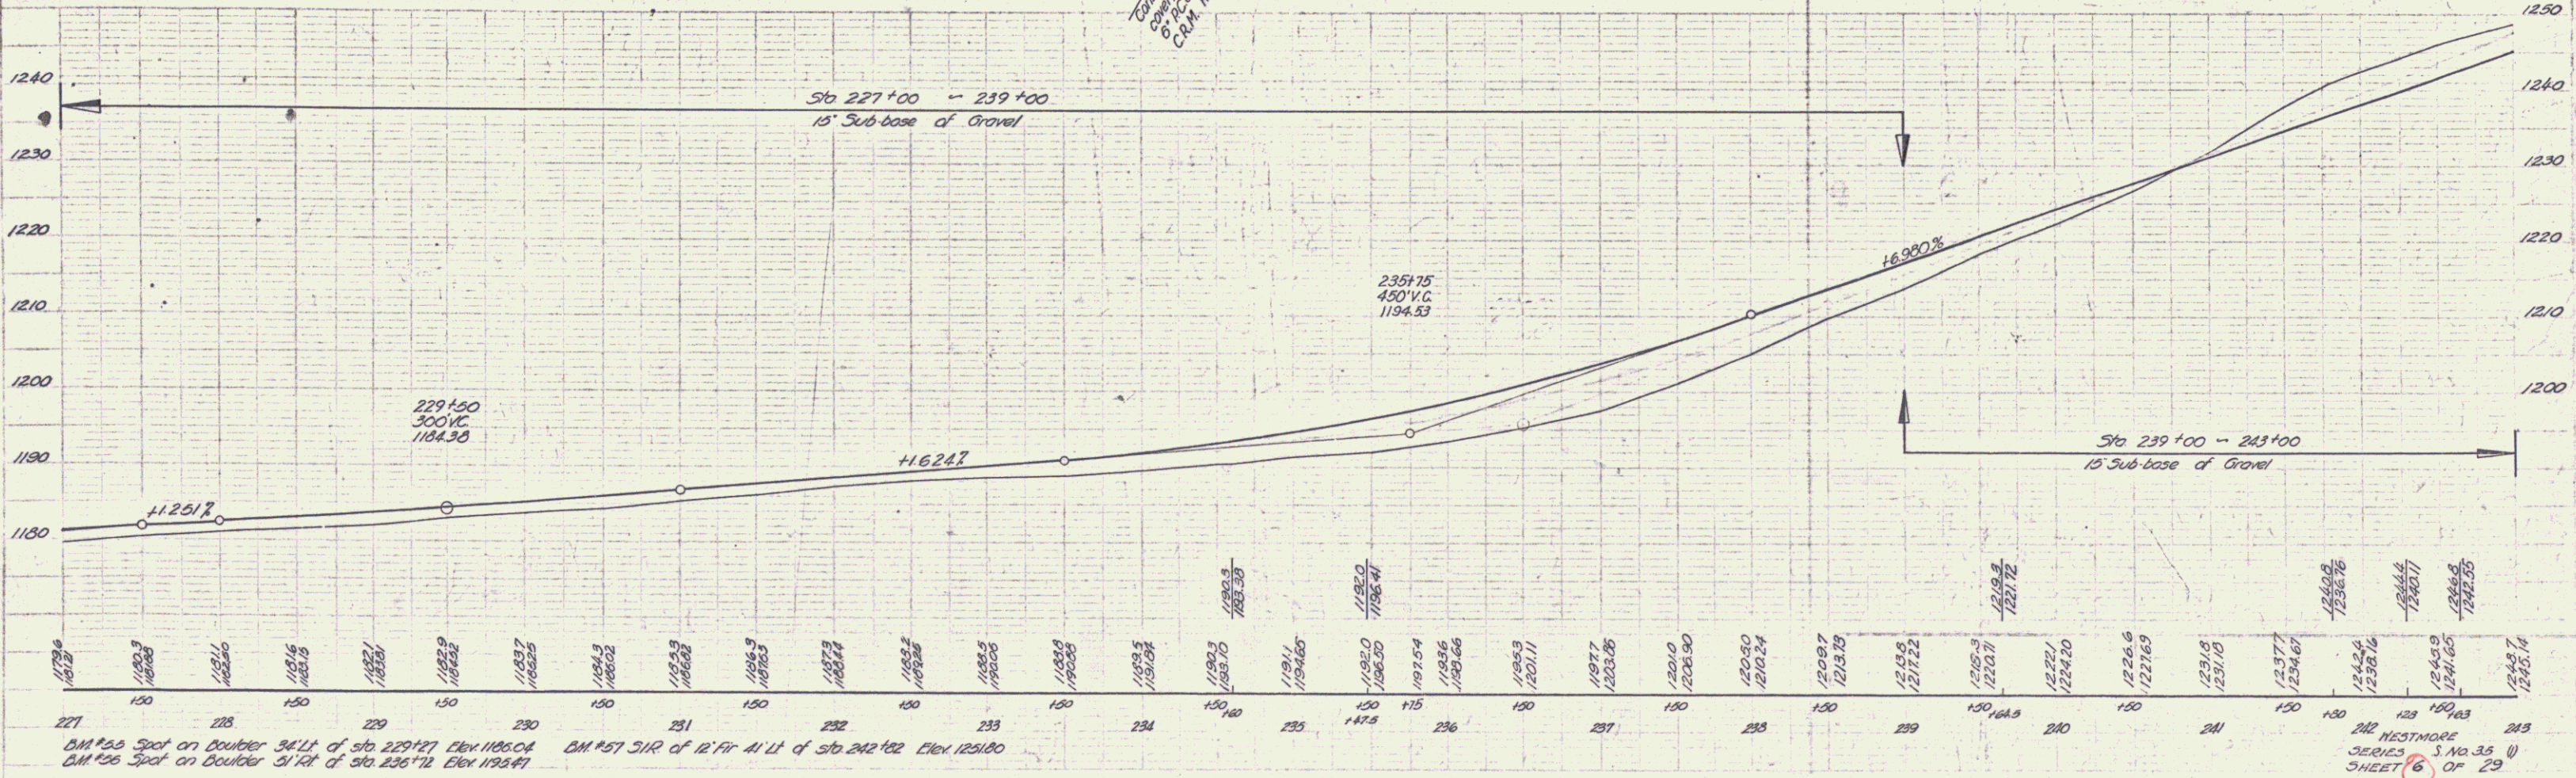


PARCEL	INITRUMENT	DATE	GRANTOR	GRANTEE	RECORDED	REMARKS
D.E.	W.D.O.E.	8-26-43	PEARLEY & DAISY GIBSON	ST OF VT	18	327-28-29 10-21-43
R	W.D.O.E.	8-26-43	FRANK & MYRTLE ALLARD	ST OF VT	18	330-31-32 10-21-43
A1B	"	5-25-46	VALEDIA MAGILL	"	18	425-426 7-18-46

NOTE: Sta 234+50 to 235+00: This slope Lt. covered with brush and ferns. Do not disturb.

FED. ROAD DIST. NO.	STATE	PROJECT NO.	YEAR	SHEET NO.	TOTAL SHEETS
9	VT	35	1946	6	29

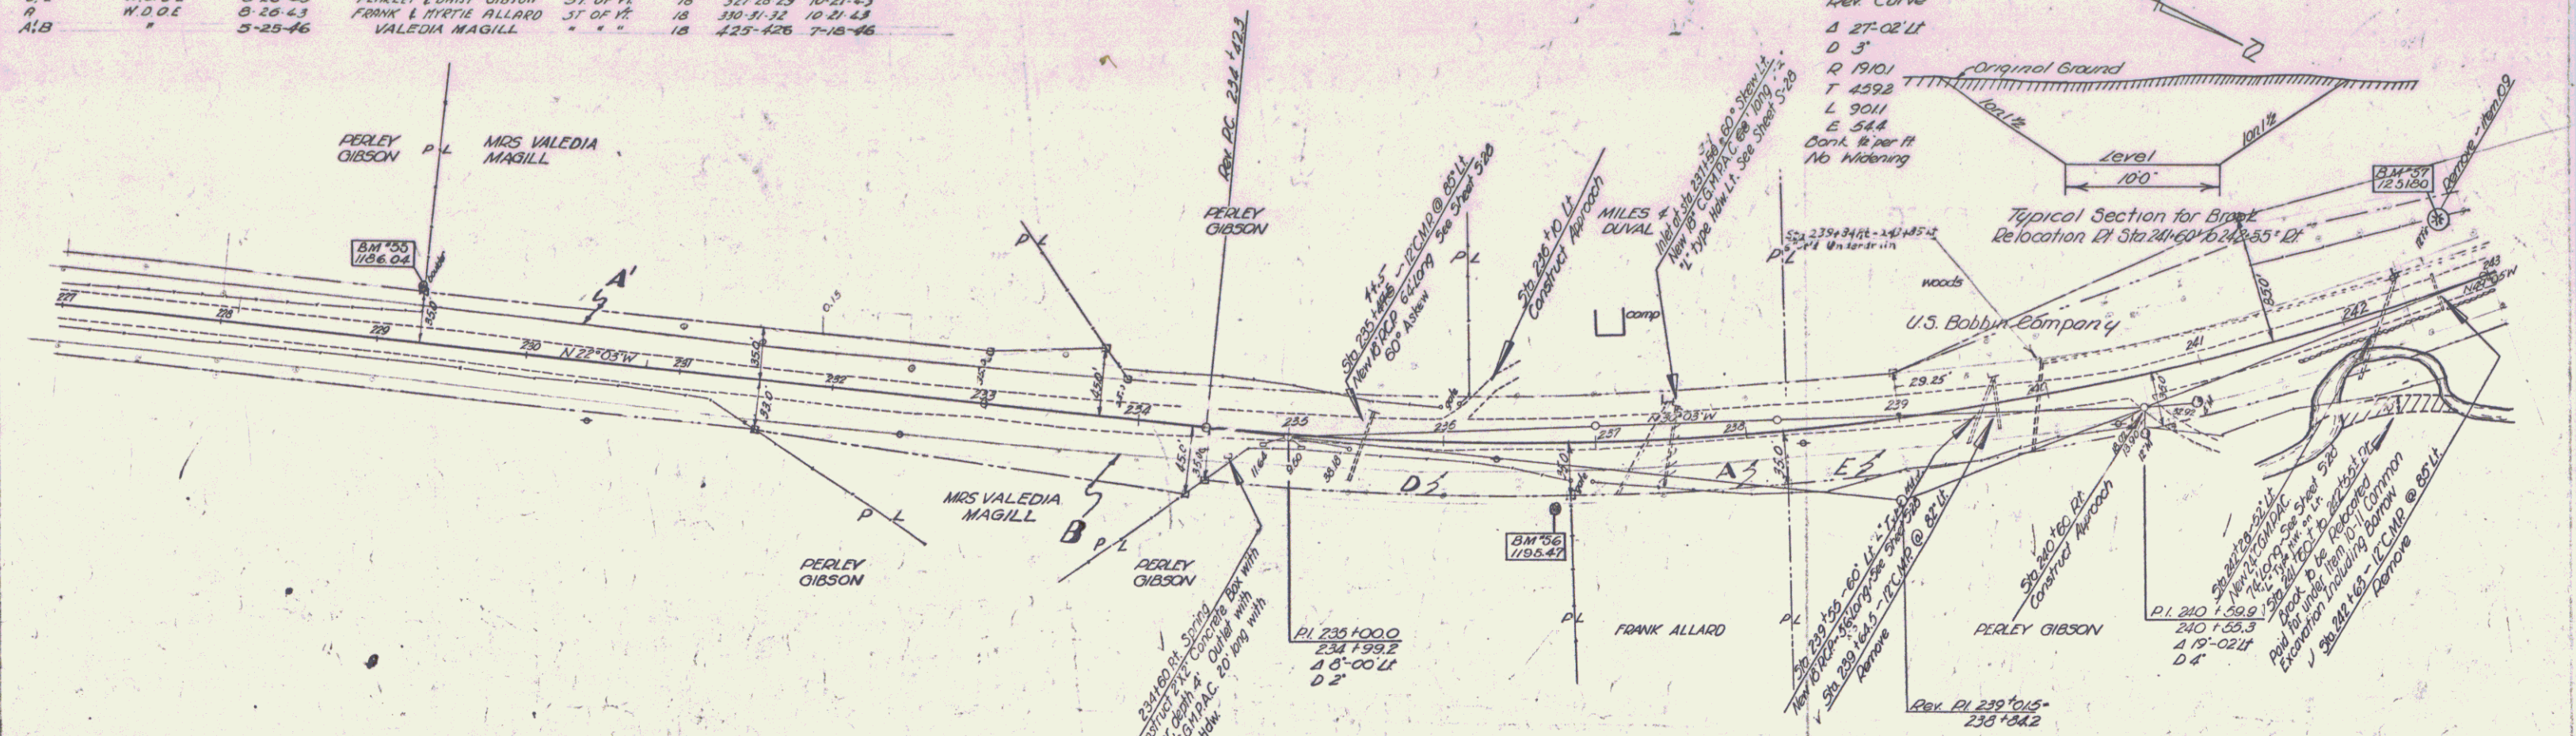

BM #26 Spot on Boulder 34' Lt of Sta 229+27 Elev 1185.04
 BM #27 51R of 12' Fir 41' Lt of Sta 242+02 Elev 1251.80

WESTMORE
 SERIES S. NO. 35
 SHEET 6 OF 29