


PLAN	DATE	BY
NOTE BOOK	NO. 1	DATE
NO. 1	DATE	BY

PROFILE	DATE	BY
NOTE BOOK	NO. 1	DATE
NO. 1	DATE	BY

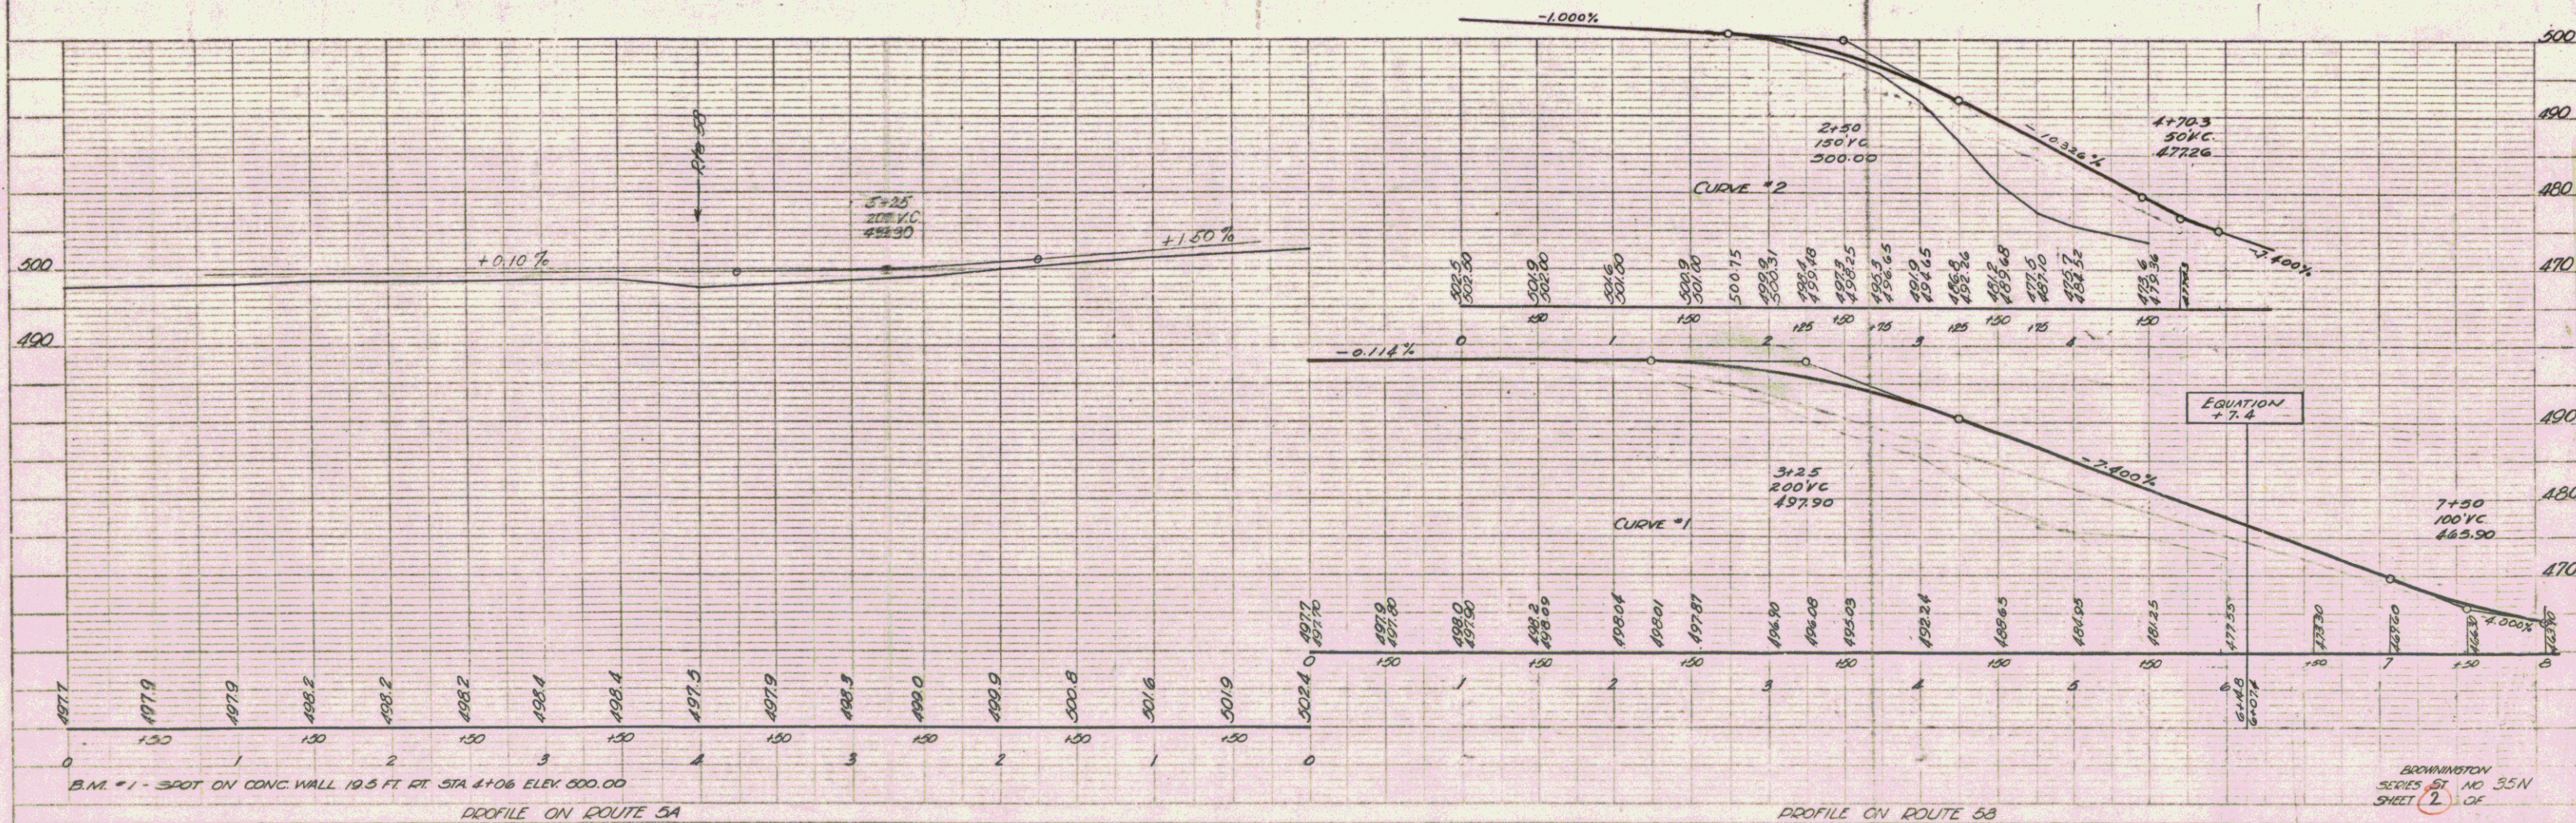

BROWNINGTON
SERIES 61 NO. 35N
SHEET 2 OF 2